SONIA HOUSE

REIGNWOOD PARK

LAMLUKKA, PATHUM THANI

***ผู้รับเหมาตรวจสอบแบบ AS BUILT จากโครงการ
และวัดระยะหน้างานอีกครั้งก่อนดำเนินการ

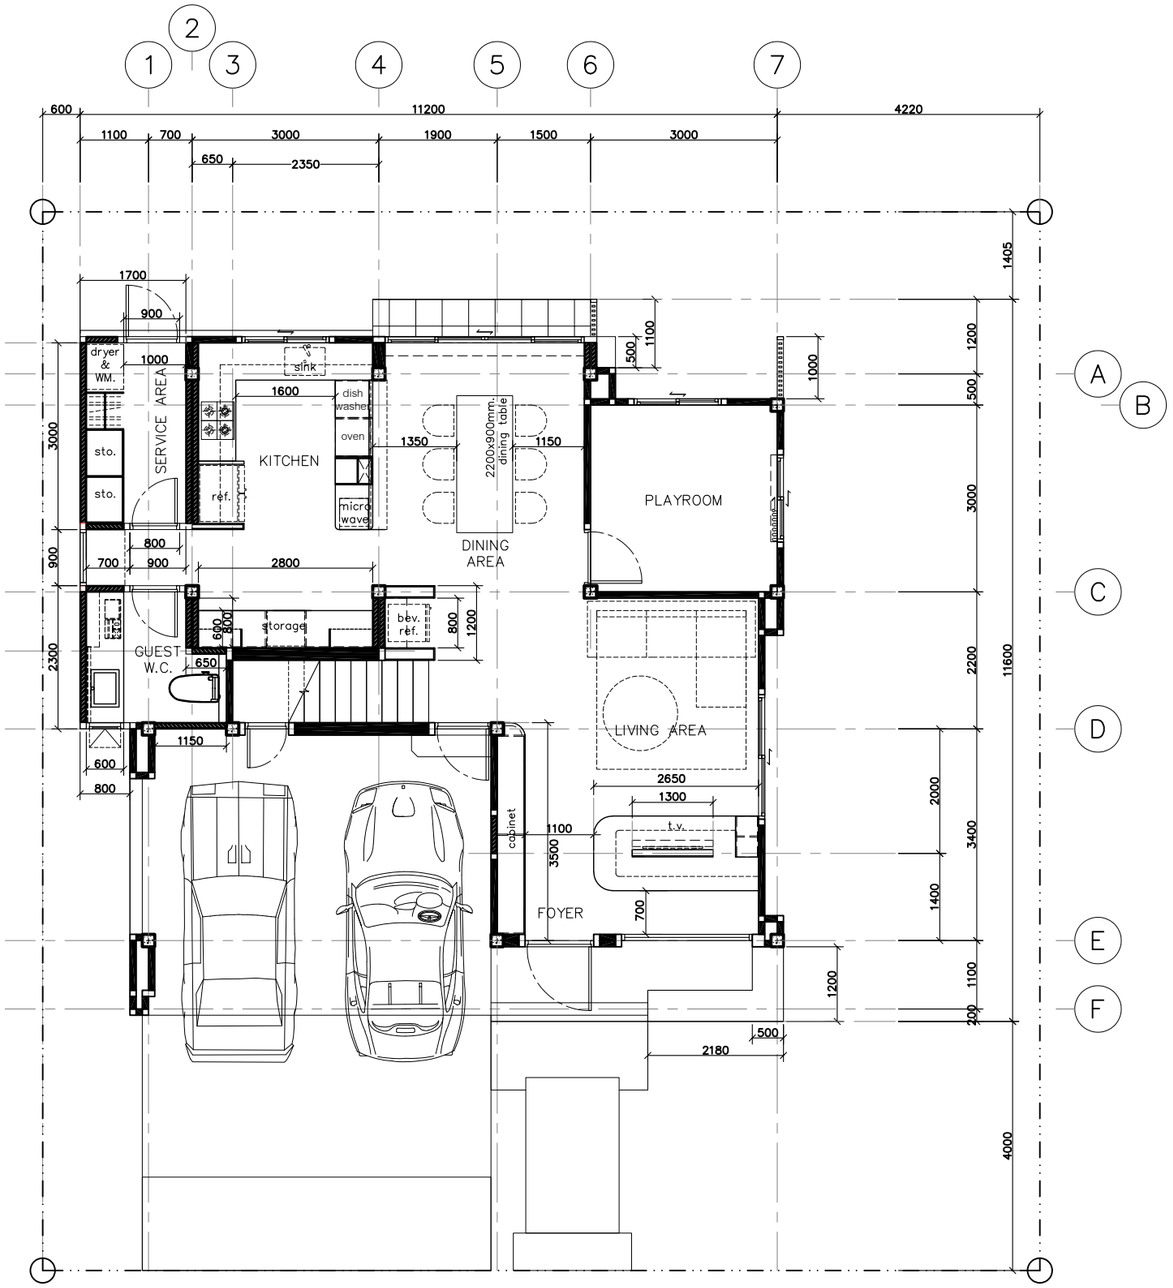

1st floor
LAYOUT PLAN

scale 1:100

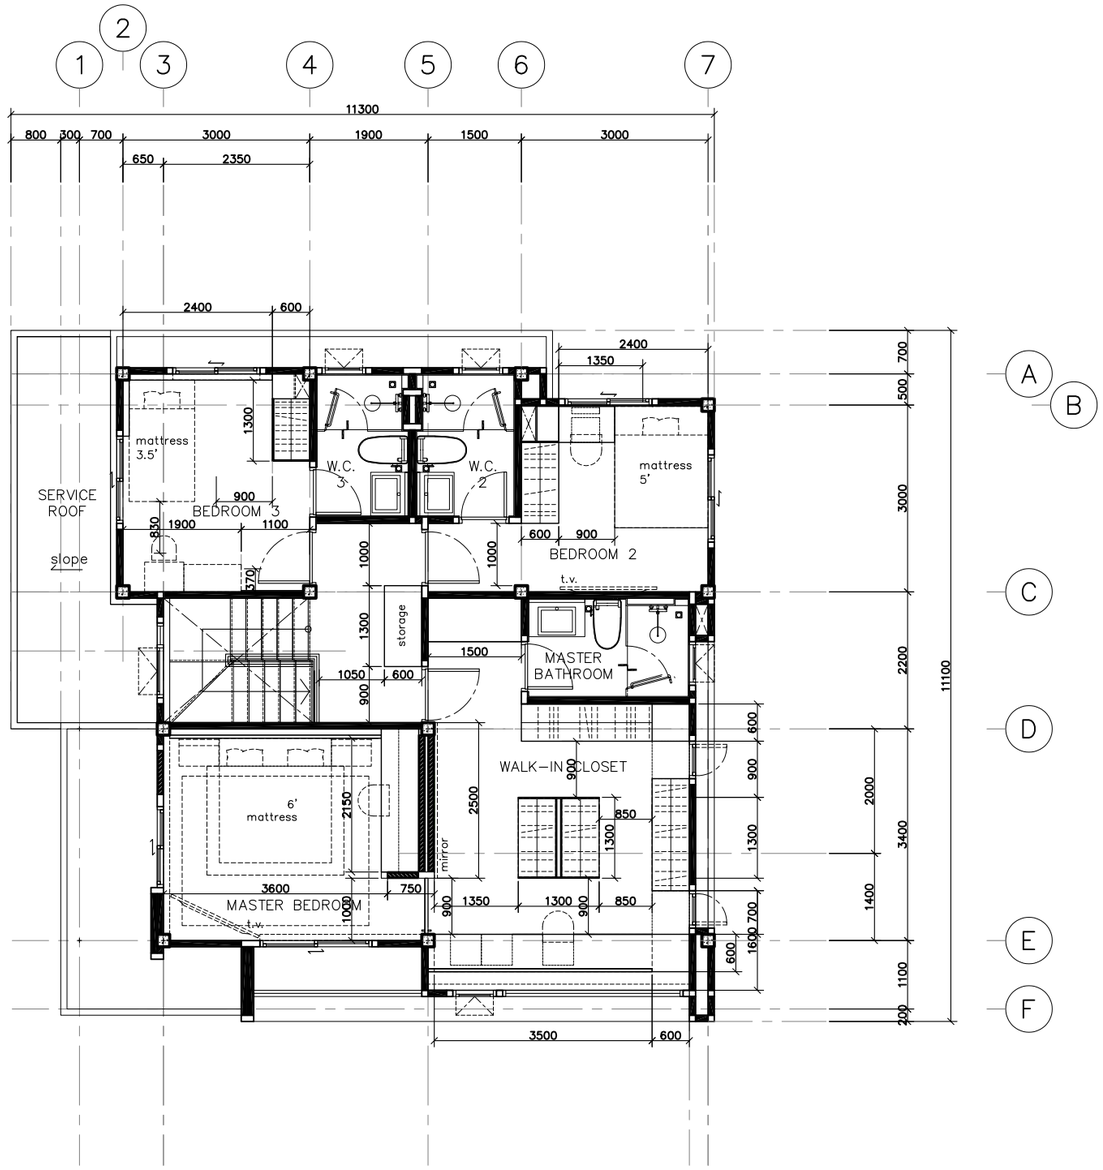

2nd floor
LAYOUT PLAN

scale 1:100

SPACEMAN

PROJECT: SONIA HOUSE

LOCATION: REIGNWOOD PARK
LAMLUKKA, PATHUM THANI

ARCHITECT:

INTERIOR DESIGNER: ปรัตถกร ประมุขกุล ภ-สน 1438

STRUCTURAL ENGINEER:

TITLE: LAYOUT PLAN

2025-12-16
ID1-01
1:100 @ A3

Note: SPACEMAN takes no responsibility for dimensions obtained by scaling from this drawing. If no dimension is shown the recipient must ascertain the dimension specifically from the architect or by site measurement and may not rely on the drawing. Supply of the drawing in digital form is solely for convenience and no reliance may be placed on any data in digital form. All data must be checked against hard copy. This drawing is issued for design intent only and should not be used for construction unless stated. This drawing is the property of SPACEMAN

***ผู้รับเหมาตรวจสอบแบบ AS BUILT จากโครงการ
และวัดระยะหน้างานอีกครั้งก่อนดำเนินการ

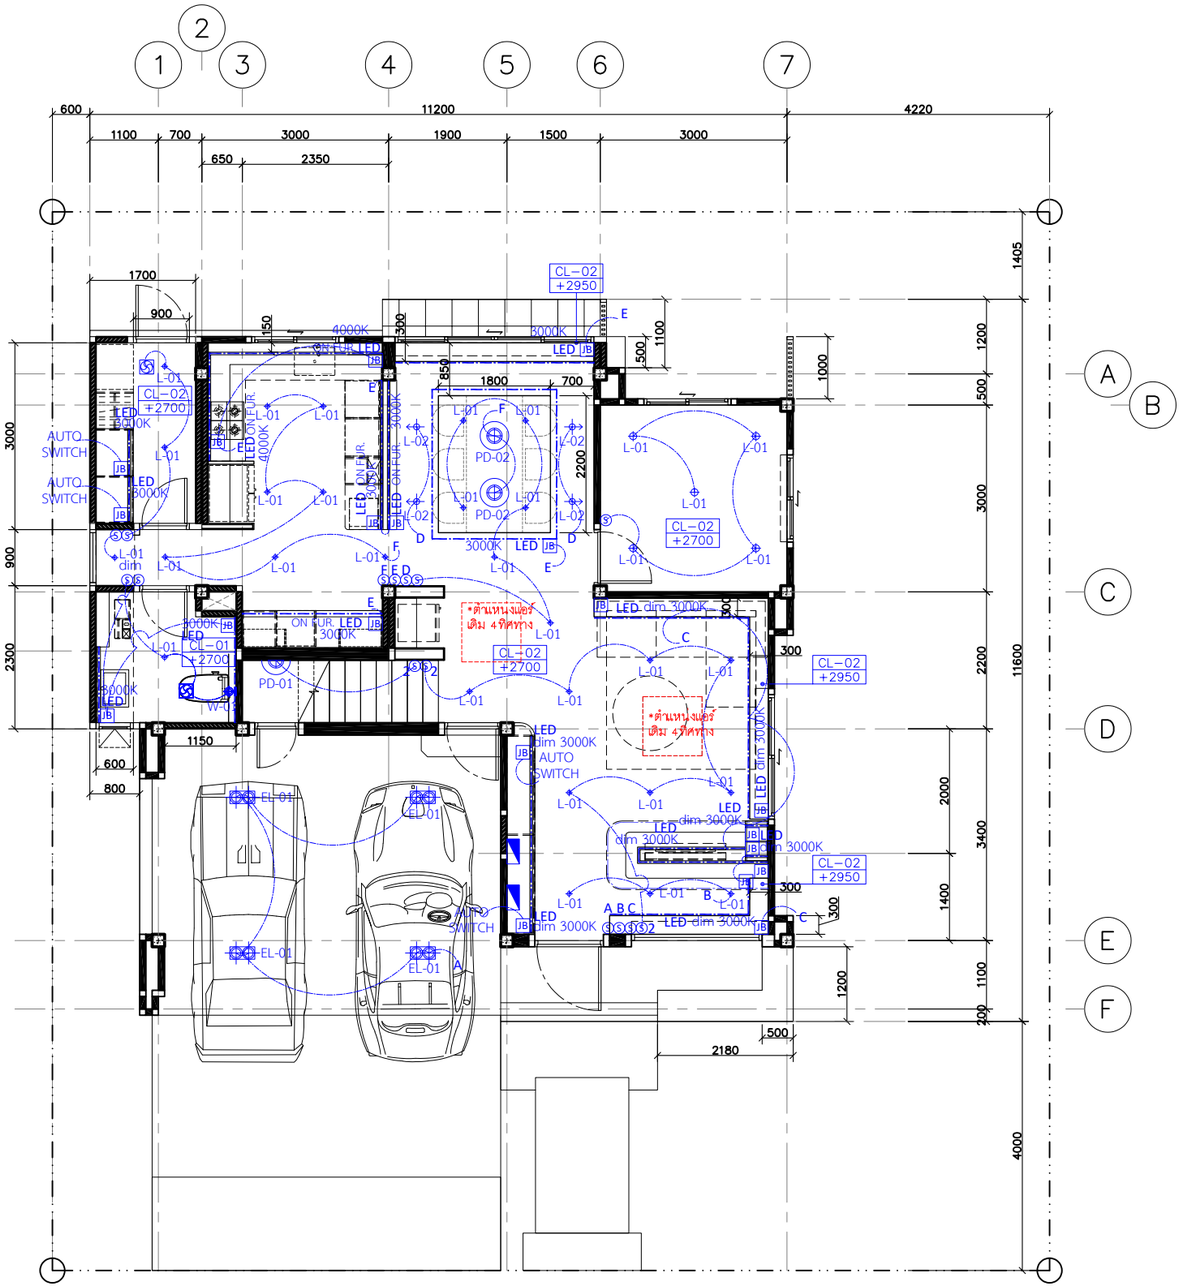

1st floor
LIGHTING PLAN

scale 1:100

REFLECTED CEILING LEGEND				
Symbol	Description			QTY.
XXX / 0000	ประเภทฝ้าเพดาน / ระดับความสูงฝ้าเพดาน			
CL 1	ฝ้า แผ่นยิปซัมบอร์ดล็อค ตราช้าง (ทนชื้น) ขอบลาด 9 มม 1200x2400 มม ทาสีขาว			
CL 2	ฝ้า Gypsum Board หนา 9 มม. ฉาบเรียบ ทาสีขาว			
L-01	โคมไฟดาวน์ไลท์ แบบฝังฝ้าเพดาน / โคมสีขาว / GU10(3000K)	By LAMPTITUDE	RONA-G-GU10-WW-FR	50
L-02	โคมไฟดาวน์ไลท์ แบบติดลอย / โคมสีขาว / GU10(3000K)	By LAMPTITUDE	XS-CEIL-ADJ-WW	4
LT-01	โคมไฟ Track Light แบบที่ 1 (ดำ) / อุณหภูมิ3000K	By LAMPTITUDE	ST-SXS05-1-BT-7W -3000K-BK	6
LT-02	โคมไฟ Track Light แบบที่ 2 (ดำ) / อุณหภูมิ3000K	By LAMPTITUDE	ST-SXZ11-BT-2W-3.0K-BK	2
W-01	โคมไฟติดผนัง รูปแบบที่ 1 /โคมสีขาว	By LAMP & LIGHT	WALL LAMP B268	1
W-02	โคมไฟติดผนัง รูปแบบที่ 2	By -		1
W-03	โคมไฟติดผนัง รูปแบบที่ 3 /โคมสีดำ	By LAMP & LIGHT	WALL LAMP LINEO B228	1
PD-01	โคมไฟห้อยเพดาน รูปแบบที่ 1	By -		1
PD-02	โคมไฟห้อยเพดาน รูปแบบที่ 2	By -		2
EL-01	โคมไฟดาวน์ไลท์ แบบฝังฝ้าเพดาน / โคมสีขาว / GU10(3000K)	By LAMPTITUDE	SONA-2-WW+GU10	4
TR-01	ราง Magnetic Track Light (สีดำ) / รางยาว 1.00 เมตร จำนวน 8 ราง	By LAMPTITUDE		
TR-02	ราง Magnetic Track Light (สีดำ) / เข้ามุม จำนวน 4 ชุด			
LED	LED Strip light (ไฟซ่อนตามเฟอร์นิเจอร์ หรือหลืบฝ้าเพดาน)	By LAMPTITUDE	ALP-D	
Ⓢ	สวิตช์ไฟทางเดียว			
Ⓓ	สวิตช์ไฟหรี่ (Dimmer)			
Ⓢ2	สวิตช์ไฟสองทาง			

Remark :
- ตำแหน่งการติดตั้งสวิตช์และเต้ารับต่างๆให้ดูในแบบรูปด้าน หากตำแหน่งการติดตั้งในแบบกับหน้างานมีความขัดแย้งกันให้ผู้รับจ้างติดต่อกับผู้ออกแบบเพื่อหาข้อสรุป
- การติดตั้งและการเชื่อมต่อให้อ้างอิงกับแบบงานระบบหากแบบมีความขัดแย้งกับหน้างานให้ผู้รับจ้างแจ้งกับผู้ออกแบบเพื่อดำเนินการแก้ไข

SPACEMAN

PROJECT: SONIA HOUSE
LOCATION: REIGNWOOD PARK LAMLUKKA, PATHUM THANI
ARCHITECT:
INTERIOR DESIGNER: ปรัตถกร ประมุขกุล ภ–สน 1438
STRUCTURAL ENGINEER:
TITLE: 1st FLOOR LIGHTING PLAN

2025–12–17
ID1–02
1:100 @ A3

Note: SPACEMAN takes no responsibility for dimensions obtained by scaling from this drawing. If no dimension is shown the recipient must ascertain the dimension specifically from the architect or by site measurement and may not rely on the drawing. Supply of the drawing in digital form is solely for convenience and no reliance may be placed on any data in digital form. All data must be checked against hard copy. This drawing is issued for design intent only and should not be used for construction unless stated. This drawing is the property of SPACEMAN

***ผู้รับเหมาตรวจสอบแบบ AS BUILT จากโครงการ
และวัดระยะหน้างานอีกครั้งก่อนดำเนินการ

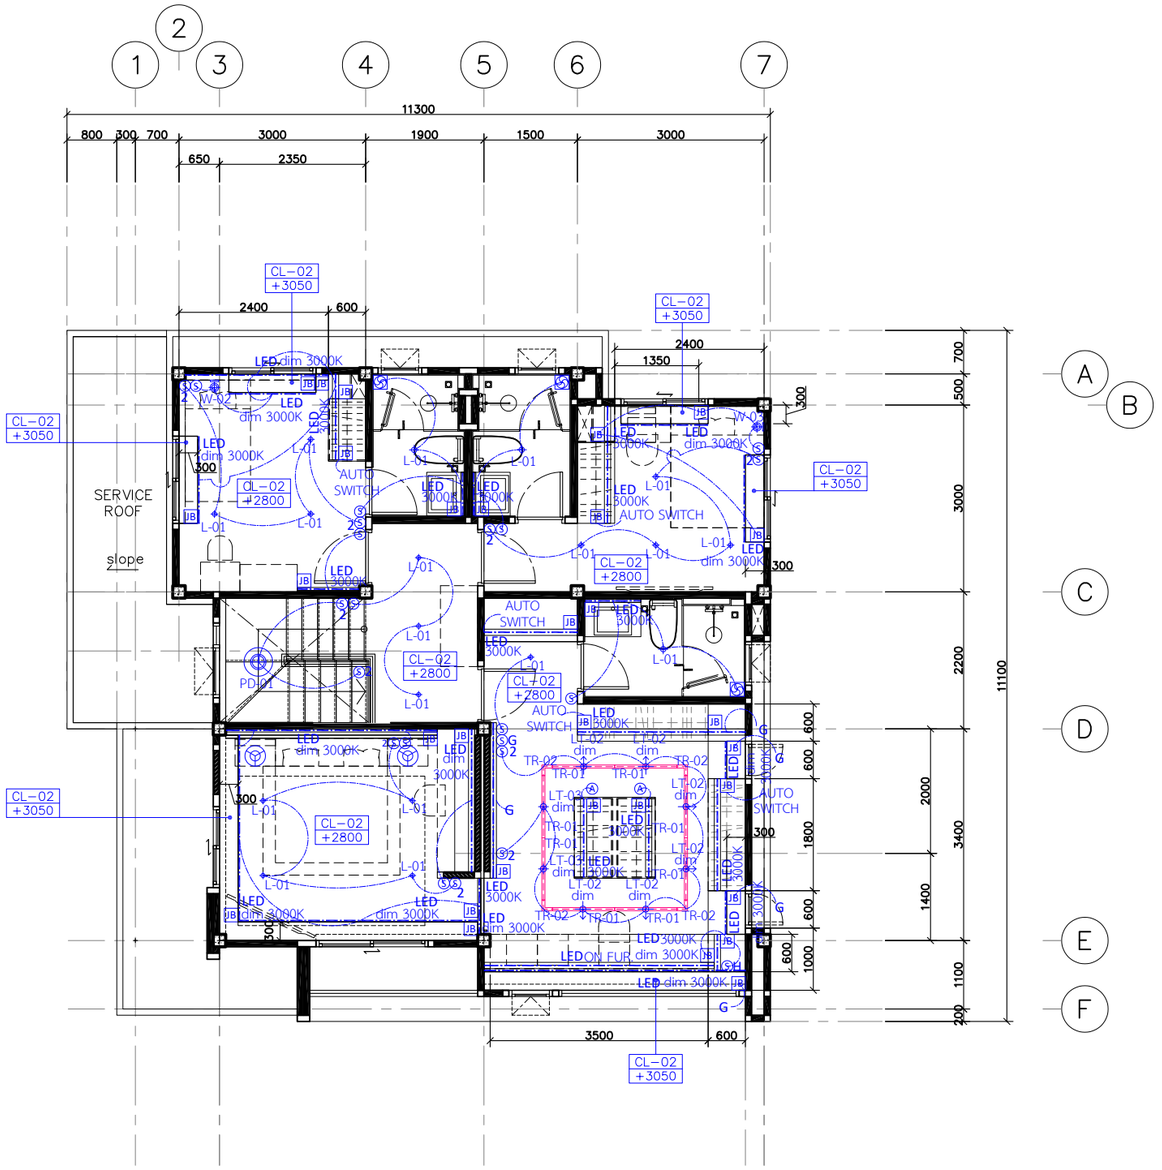

2nd floor
LIGHTING PLAN

scale 1:100

REFLECTED CEILING LEGEND				
Symbol	Description			QTY.
XXX 0000	ประเภทฝ้าเพดาน ระดับความสูงฝ้าเพดาน			
CL 1	ฝ้า แผ่นยิปซัมมอยส์บล็อค ตราช้าง (ทนชื้น) ขอบลาด 9 มม 1200x2400 มม ทาสีขาว			
CL 2	ฝ้า Gypsum Board หนา 9 มม. ฉาบเรียบ ทาสีขาว			
L-01	โคมไฟดาวน์ไลท์ แบบฝังฝ้าเพดาน / โคมสีขาว / GU10(3000K)	By LAMPTITUDE	RONA-G-GU10-WW-FR	50
L-02	โคมไฟดาวน์ไลท์ แบบติดลอย / โคมสีขาว / GU10(3000K)	By LAMPTITUDE	XS-CEIL-ADJ-WW	4
LT-01	โคมไฟ Track Light แบบที่ 1 (ดำ) / อุณหภูมิ3000K	By LAMPTITUDE	ST-SXS05-1-BT-7W -3000K-BK	6
LT-02	โคมไฟ Track Light แบบที่ 2 (ดำ) / อุณหภูมิ3000K	By LAMPTITUDE	ST-SXZ11-BT-2W-3.0K-BK	2
W-01	โคมไฟติดผนัง รูปแบบที่ 1 /โคมสีขาว	By LAMP & LIGHT	WALL LAMP B268	1
W-02	โคมไฟติดผนัง รูปแบบที่ 2	By -		1
W-03	โคมไฟติดผนัง รูปแบบที่ 3 /โคมสีดำ	By LAMP & LIGHT	WALL LAMP LINEO B228	1
PD-01	โคมไฟห้อยเพดาน รูปแบบที่ 1	By -		1
PD-02	โคมไฟห้อยเพดาน รูปแบบที่ 2	By -		2
EL-01	โคมไฟดาวน์ไลท์ แบบฝังฝ้าเพดาน / โคมสีขาว / GU10(3000K)	By LAMPTITUDE	SONA-2-WW+GU10	4
TR-01 TR-02	ราง Magnetic Track Light (สีดำ) / รางยาว 1.00 เมตร จำนวน 8 ราง ราง Magnetic Track Light (สีดำ) / เข้ามุม จำนวน 4 ชุด	By LAMPTITUDE		
LED	LED Strip light (ไฟซ่อนตามเฟอร์นิเจอร์ หรือหลืบฝ้าเพดาน)	By LAMPTITUDE	ALP-D	
Ⓢ	สวิตช์ไฟทางเดียว			
Ⓓ	สวิตช์ไฟหรี่ (Dimmer)			
Ⓢ2	สวิตช์ไฟสองทาง			

Remark :
- ตำแหน่งการติดตั้งสวิตช์และเต้ารับต่างๆให้ดูในแบบรูปด้าน หากตำแหน่งการติดตั้งในแบบกับหน้างานมีความขัดแย้งกันให้ผู้รับจ้างติดต่อกับผู้ออกแบบเพื่อหาข้อสรุป
- การติดตั้งและการเชื่อมต่อให้อ้างอิงกับแบบงานระบบหากแบบมีความขัดแย้งกับหน้างานให้ผู้รับจ้างแจ้งกับผู้ออกแบบเพื่อดำเนินการแก้ไข

SPACEMAN

PROJECT: SONIA HOUSE
LOCATION: REIGNWOOD PARK
LAMLUKKA, PATHUM THANI
ARCHITECT:
INTERIOR DESIGNER: ปรัตถกร ประมุขกุล ภ–สน 1438
STRUCTURAL ENGINEER:
TITLE: 2nd FLOOR
LIGHTING PLAN
2025–12–17
ID1–03
1:100 @ A3

Note: SPACEMAN takes no responsibility for dimensions obtained by scaling from this drawing. If no dimension is shown the recipient must ascertain the dimension specifically from the architect or by site measurement and may not rely on the drawing. Supply of the drawing in digital form is solely for convenience and no reliance may be placed on any data in digital form. All data must be checked against hard copy. This drawing is issued for design intent only and should not be used for construction unless stated. This drawing is the property of SPACEMAN

***ผู้รับเหมาตรวจสอบแบบ AS BUILT จากโครงการ
และวัดระยะหน้างานอีกครั้งก่อนดำเนินการ

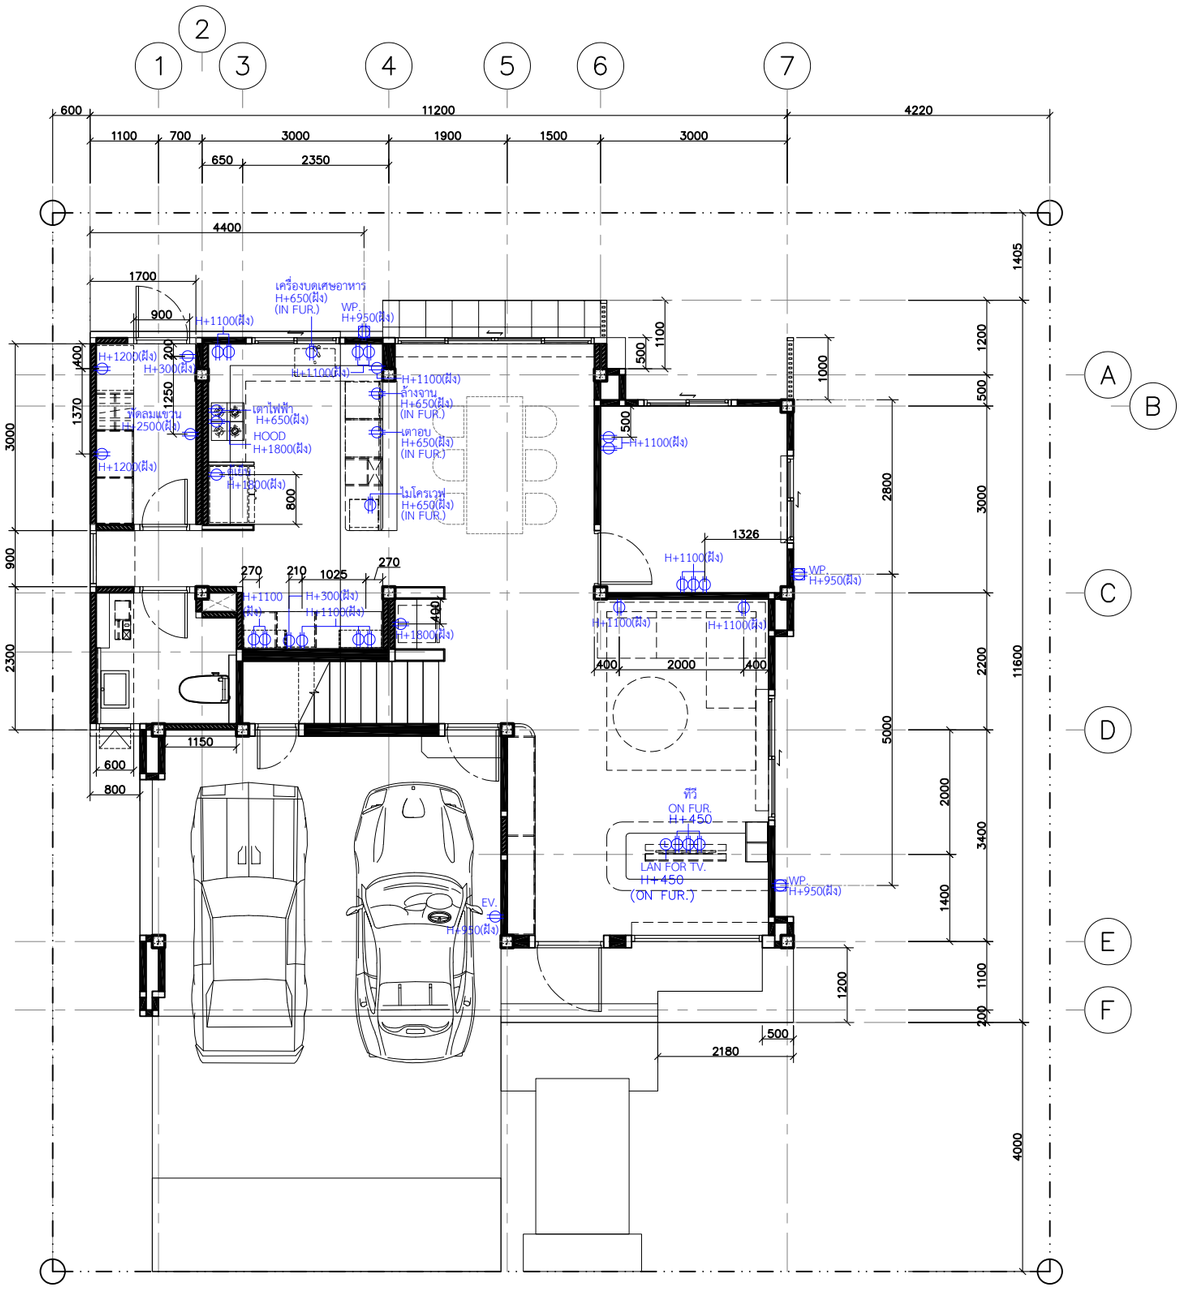

1st floor
OUTLET PLAN
scale 1:100

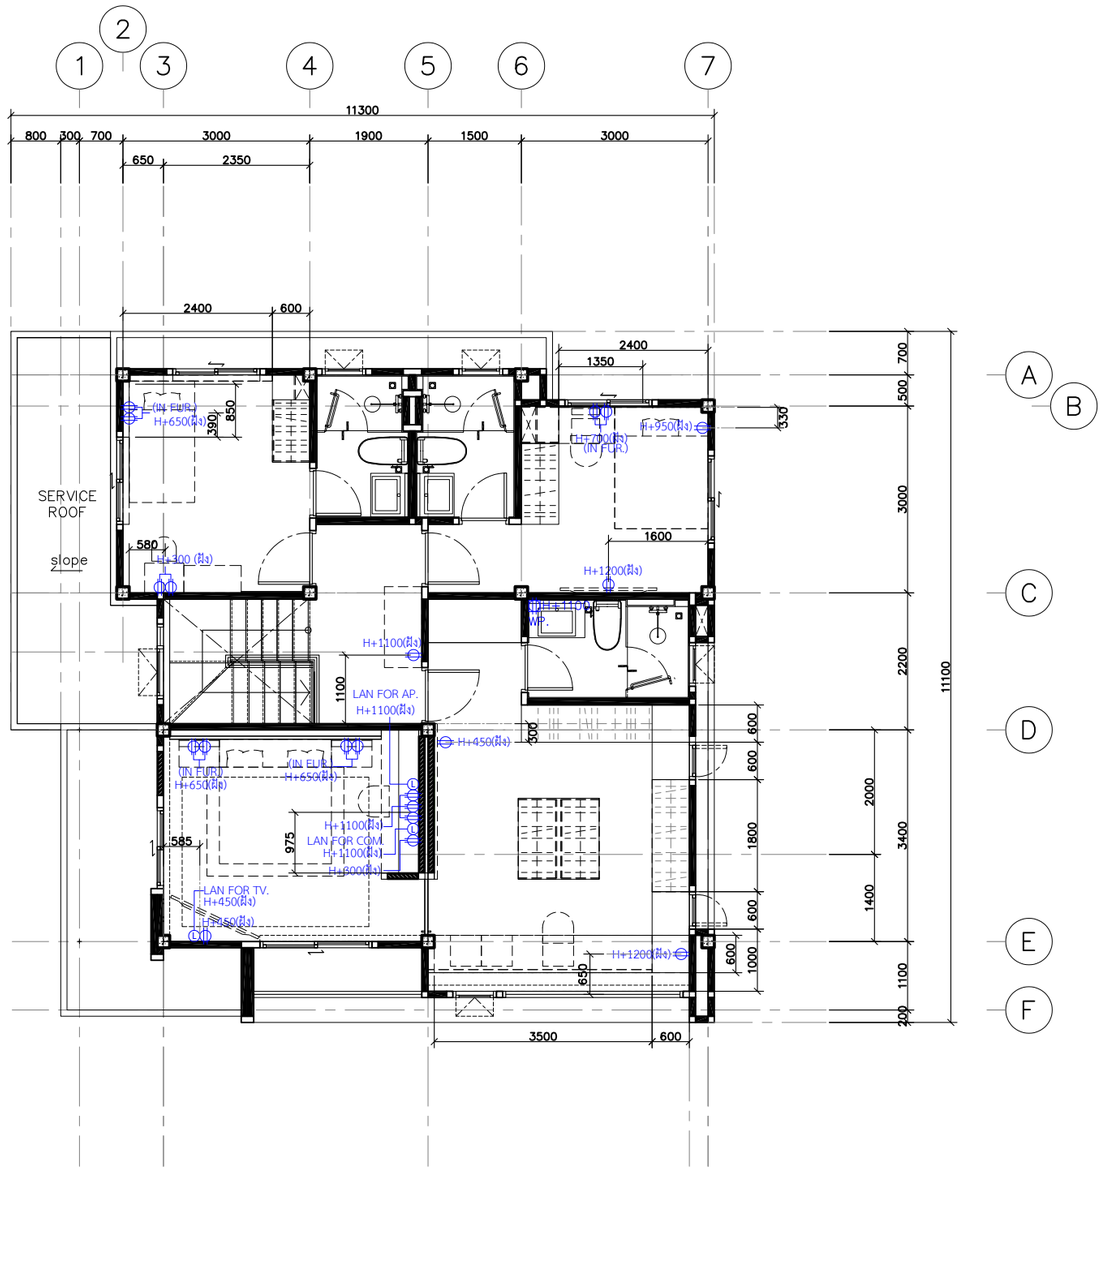

2nd floor
OUTLET PLAN
scale 1:100

SPACEMAN	PROJECT: SONIA HOUSE	LOCATION: REIGNWOOD PARK LAMLUKKA, PATHUM THANI	ARCHITECT	INTERIOR DESIGNER: ปรัตถกร ประมุขกุล ภ-สน 1438	STRUCTURAL ENGINEER	TITLE: OUTLET PLAN	2025-12-16 ID1-04 1:100 @ A3

Note: SPACEMAN takes no responsibility for dimensions obtained by scaling from this drawing. If no dimension is shown the recipient must ascertain the dimension specifically from the architect or by site measurement and may not rely on the drawing. Supply of the drawing in digital form is solely for convenience and no reliance may be placed on any data in digital form. All data must be checked against hard copy. This drawing is issued for design intent only and should not be used for construction unless stated. This drawing is the property of SPACEMAN

***ผู้รับเหมาตรวจสอบแบบ AS BUILT จากโครงการ
และวัดระยะหน้างานอีกครั้งก่อนดำเนินการ

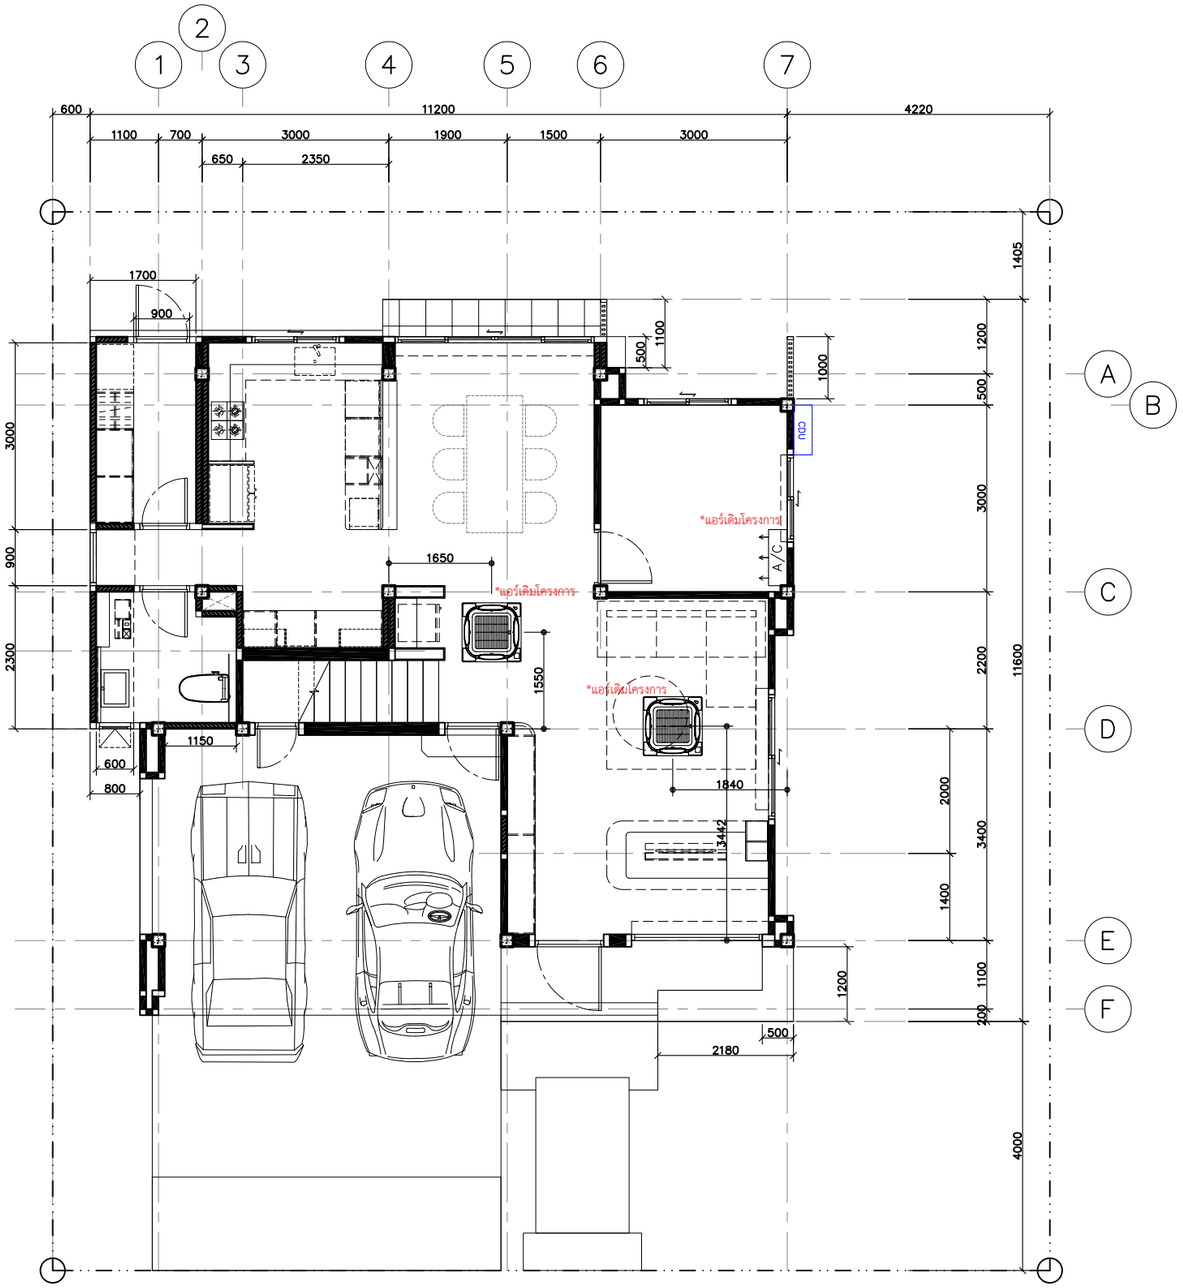

1st floor
AIR CONDITIONER LAY-OUT PLAN
scale 1:100

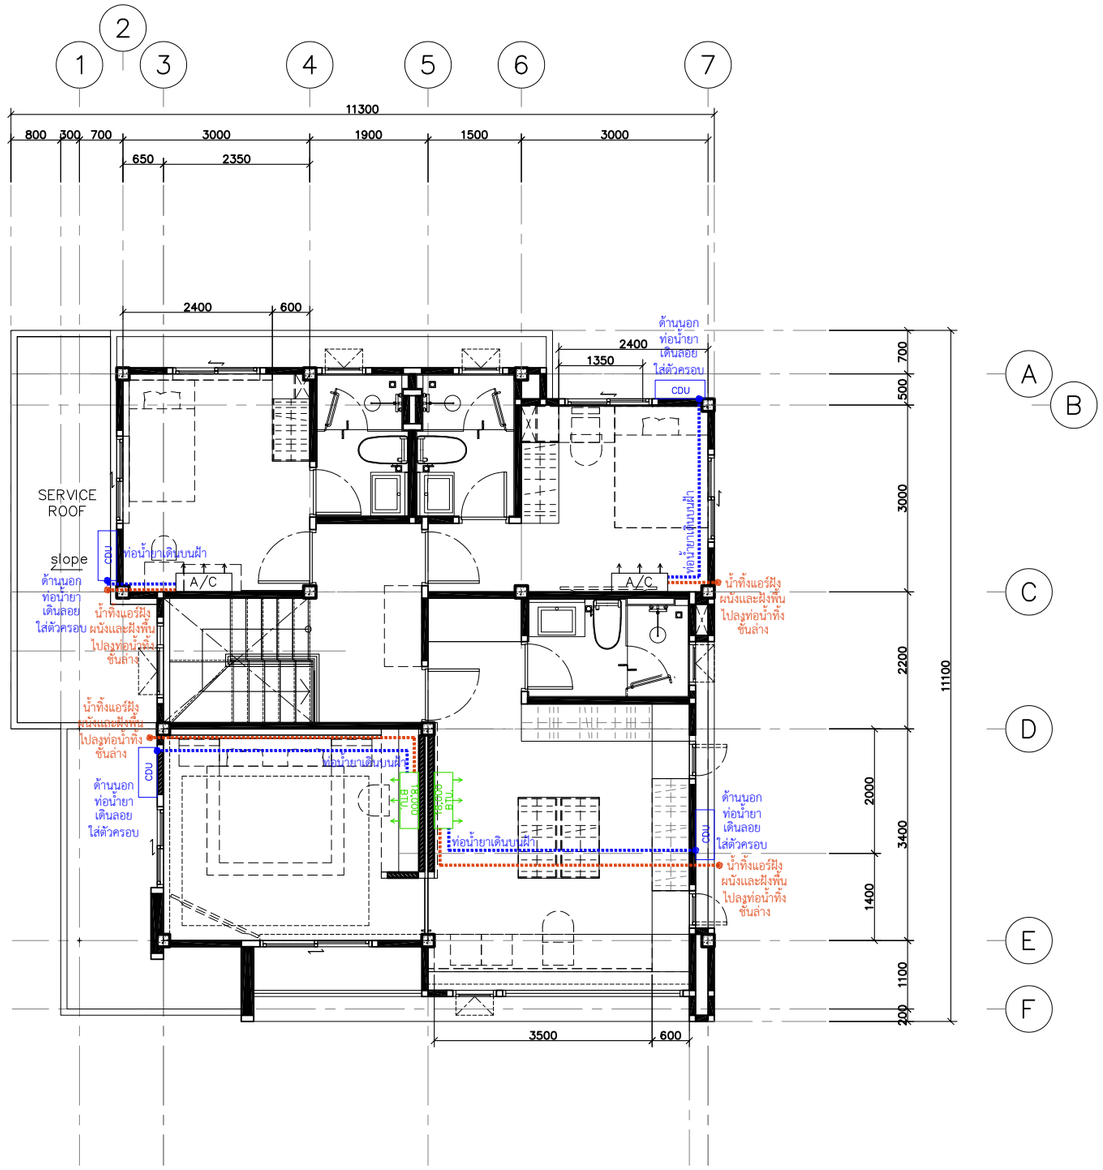

2nd floor
AIR CONDITIONER LAY-OUT PLAN
scale 1:100

SPACEMAN	PROJECT: SONIA HOUSE	LOCATION: REIGNWOOD PARK LAMLUKKA, PATHUM THANI	ARCHITECT:	INTERIOR DESIGNER: ปรัตถกร ประมุขกุล ภ-สน 1438	STRUCTURAL ENGINEER:	TITLE: AIR CONDITIONER LAY-OUT PLAN	2025-12-16 ID1-05 1:100 @ A3

Note: SPACEMAN takes no responsibility for dimensions obtained by scaling from this drawing. If no dimension is shown the recipient must ascertain the dimension specifically from the architect or by site measurement and may not rely on the drawing. Supply of the drawing in digital form is solely for convenience and no reliance may be placed on any data in digital form. All data must be checked against hard copy. This drawing is issued for design intent only and should not be used for construction unless stated. This drawing is the property of SPACEMAN

***ผู้รับเหมาตรวจสอบแบบ AS BUILT จากโครงการ
และวัดระยะหน้างานอีกครั้งก่อนดำเนินการ

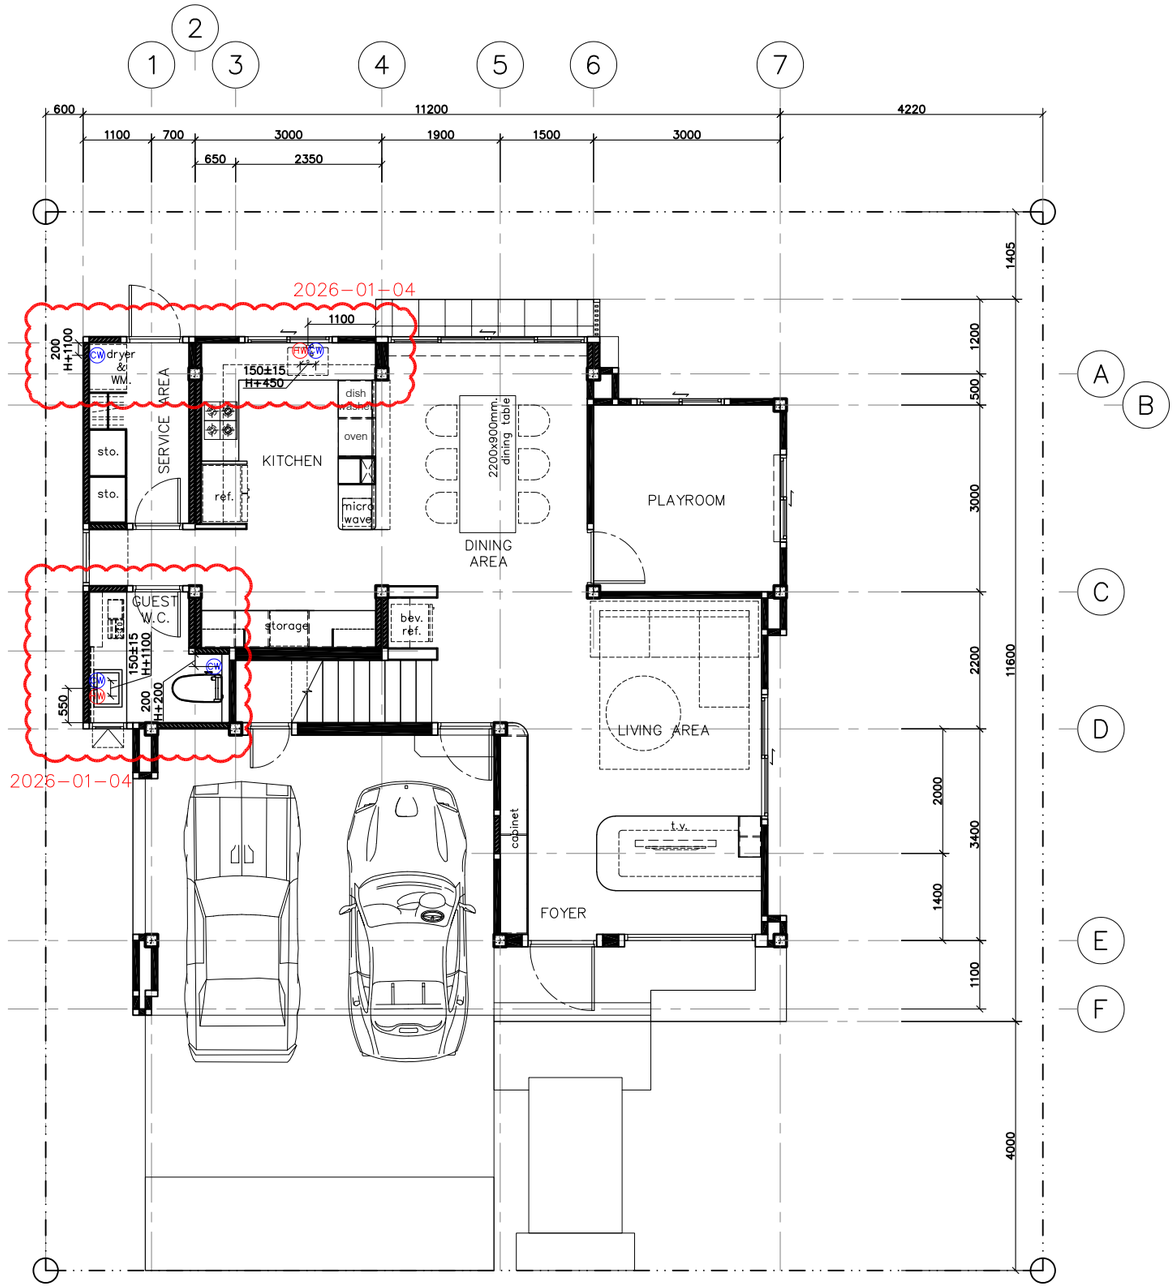

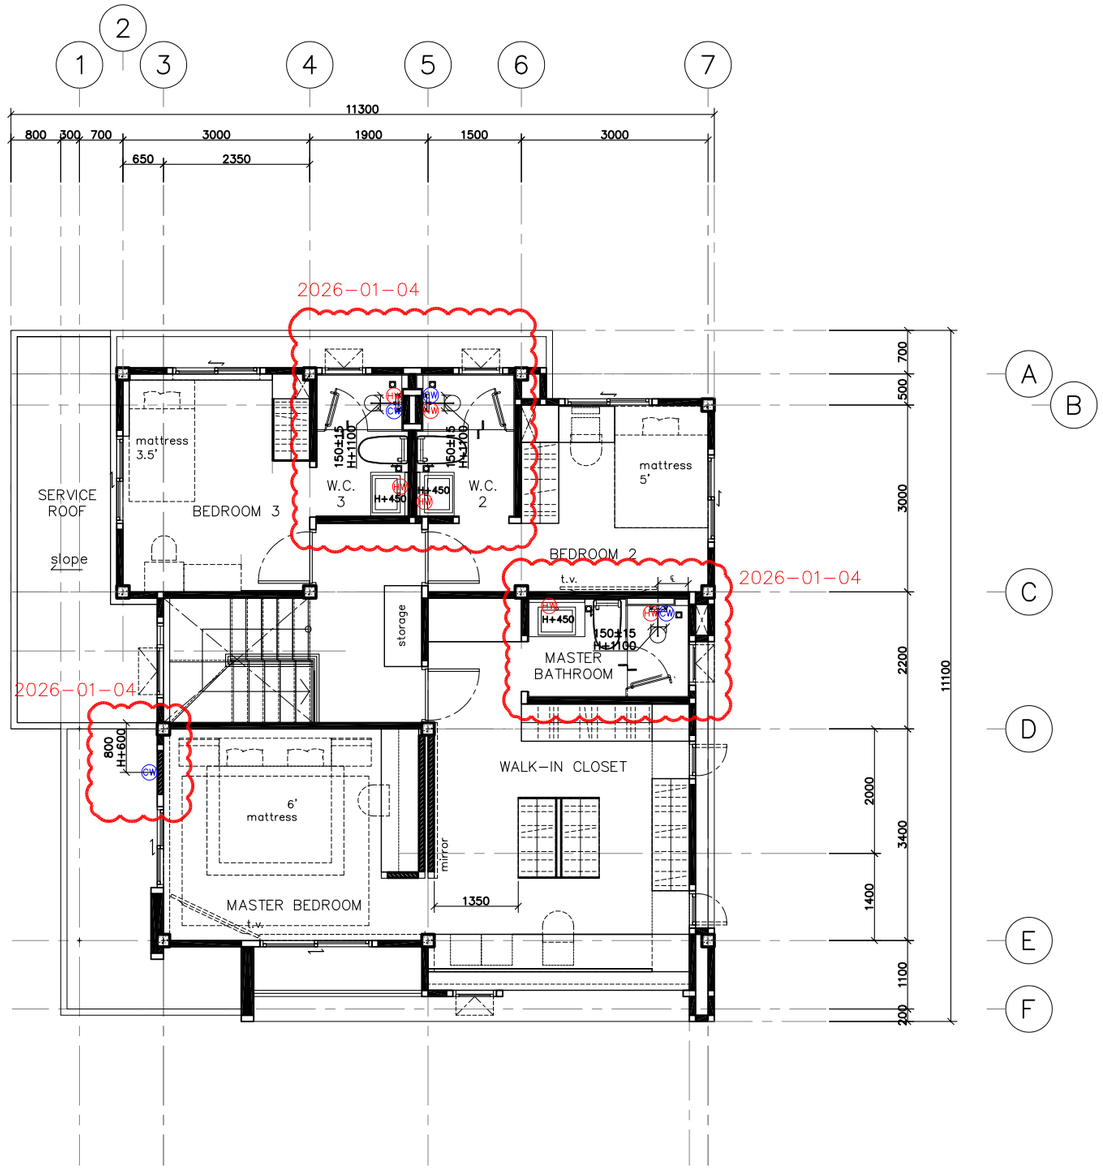

CW ตำแหน่งจ่ายน้ำเย็น (เพิ่มเติม)
HW ตำแหน่งจ่ายน้ำร้อน (เพิ่มเติม)

1st floor
HOT&COLD WATER LOCATION PLAN (ADD ON)
scale 1:100

2nd floor
HOT&COLD WATER LOCATION PLAN (ADD ON)
scale 1:100

SPACEMAN

PROJECT: SONIA HOUSE
LOCATION: REIGNWOOD PARK
LAMLUKKA, PATHUM THANI
ARCHITECT:
INTERIOR DESIGNER: ปรัตถกร ประมุขกุล ภ-สน 1438
STRUCTURAL ENGINEER:
TITLE: HOT&COLD WATER LOCATION PLAN (ADD ON)
2026-01-04
ID1-06
1:100 @ A3

Note: SPACEMAN takes no responsibility for dimensions obtained by scaling from this drawing. If no dimension is shown the recipient must ascertain the dimension specifically from the architect or by site measurement and may not rely on the drawing. Supply of the drawing in digital form is solely for convenience and no reliance may be placed on any data in digital form. All data must be checked against hard copy. This drawing is issued for design intent only and should not be used for construction unless stated. This drawing is the property of SPACEMAN

***ผู้รับเหมาตรวจสอบแบบ AS BUILT จากโครงการ
และวัดระยะหน้างานอีกครั้งก่อนดำเนินการ

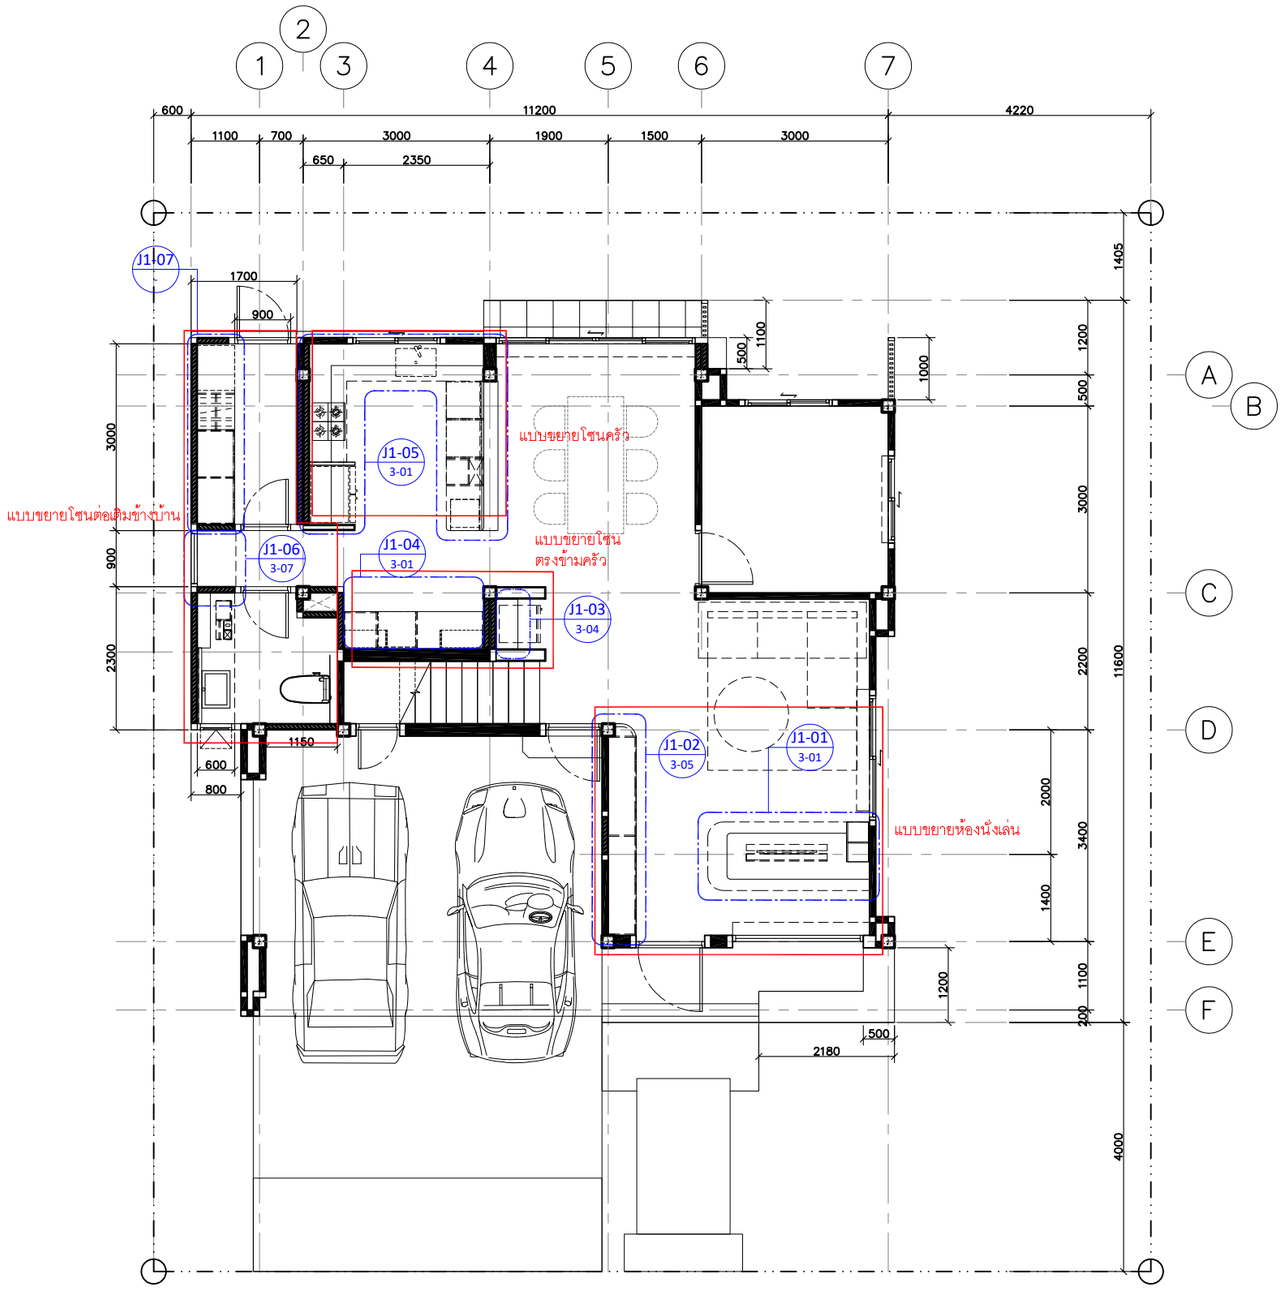

1st floor
JOINERY PLAN

scale 1:100

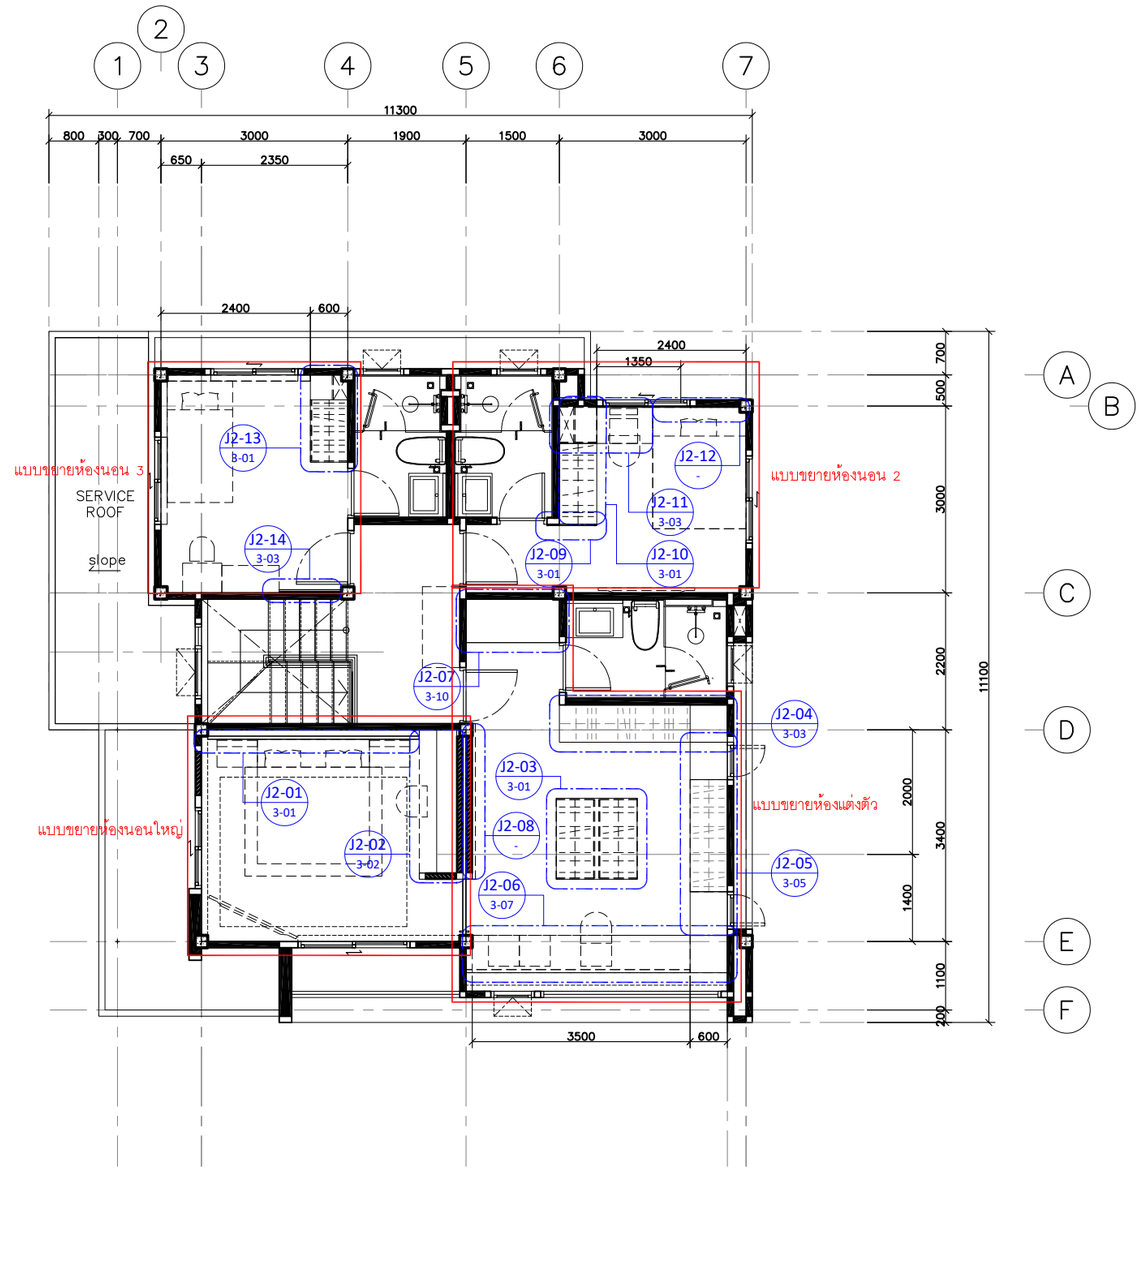

2nd floor
JOINERY PLAN

scale 1:100

SPACEMAN

PROJECT SONIA HOUSE

LOCATION REIGNWOOD PARK
LAMLUKKA, PATHUM THANI

ARCHITECT

INTERIOR DESIGNER ปรัตถกร ประมุขกุล ภ-สน 1438

STRUCTURAL ENGINEER

TITLE JOINERY PLAN

2025-12-16
ID1-07
1:100 @ A3

Note: SPACEMAN takes no responsibility for dimensions obtained by scaling from this drawing. If no dimension is shown the recipient must ascertain the dimension specifically from the architect or by site measurement and may not rely on the drawing. Supply of the drawing in digital form is solely for convenience and no reliance may be placed on any data in digital form. All data must be checked against hard copy. This drawing is issued for design intent only and should not be used for construction unless stated. This drawing is the property of SPACEMAN

SONIA HOUSE

REIGNWOOD PARK

LAMLUKKA, PATHUM THANI

แบบขยายส่วนห้องนั่งเล่น

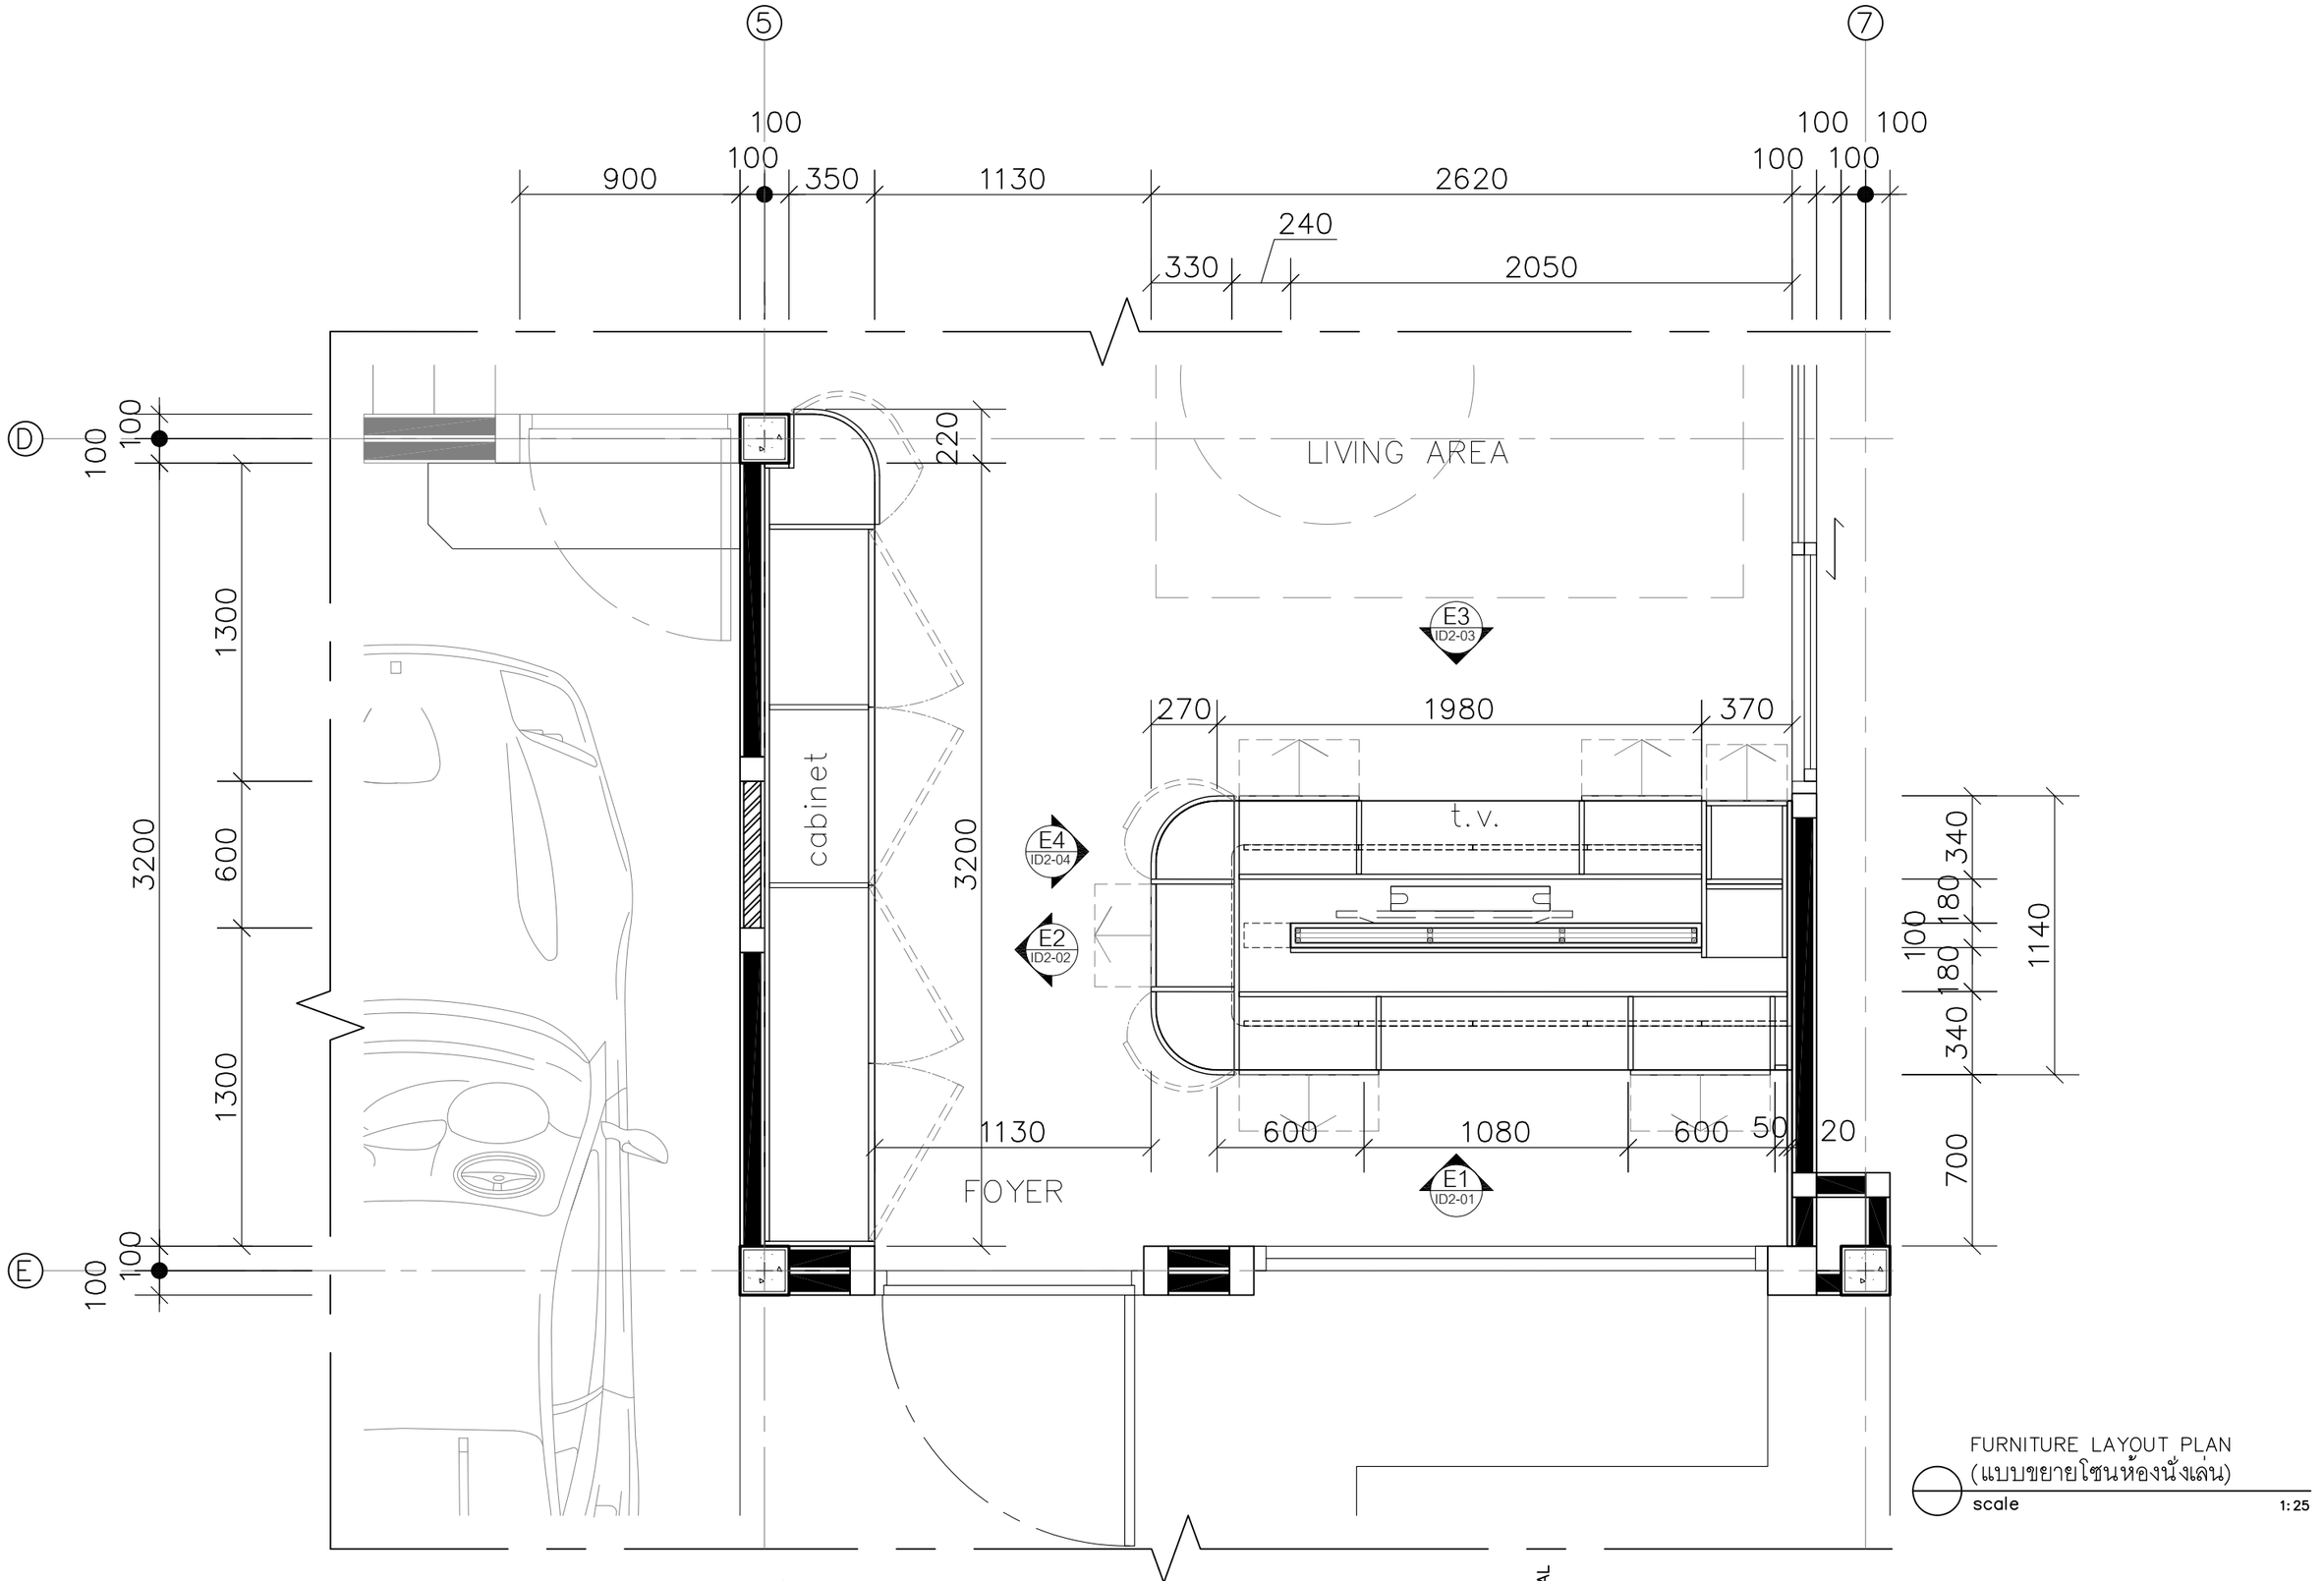

FURNITURE LAYOUT PLAN
(แบบขยายโซนห้องนั่งเล่น)
scale 1:25

SPACEMAN

PROJECT: SONIA HOUSE

LOCATION: REIGNWOOD PARK
LAMLUKKA, PATHUM THANI

ARCHITECT:

INTERIOR DESIGNER: ปรัตถกร ประมุขกุล ภ-สน 1438

STRUCTURAL ENGINEER:

TITLE: 1st FLOOR
FURNITURE LAYOUT PLAN
(แบบขยายบริเวณตรงข้ามครัว)

2026-02-04
ID1-01
1:25 @ A3

Note: SPACEMAN takes no responsibility for dimensions obtained by scaling from this drawing. If no dimension is shown the recipient must ascertain the dimension specifically from the architect or by site measurement and may not rely on the drawing. Supply of the drawing in digital form is solely for convenience and no reliance may be placed on any data in digital form. All data must be checked against hard copy. This drawing is issued for design intent only and should not be used for construction unless stated. This drawing is the property of SPACEMAN

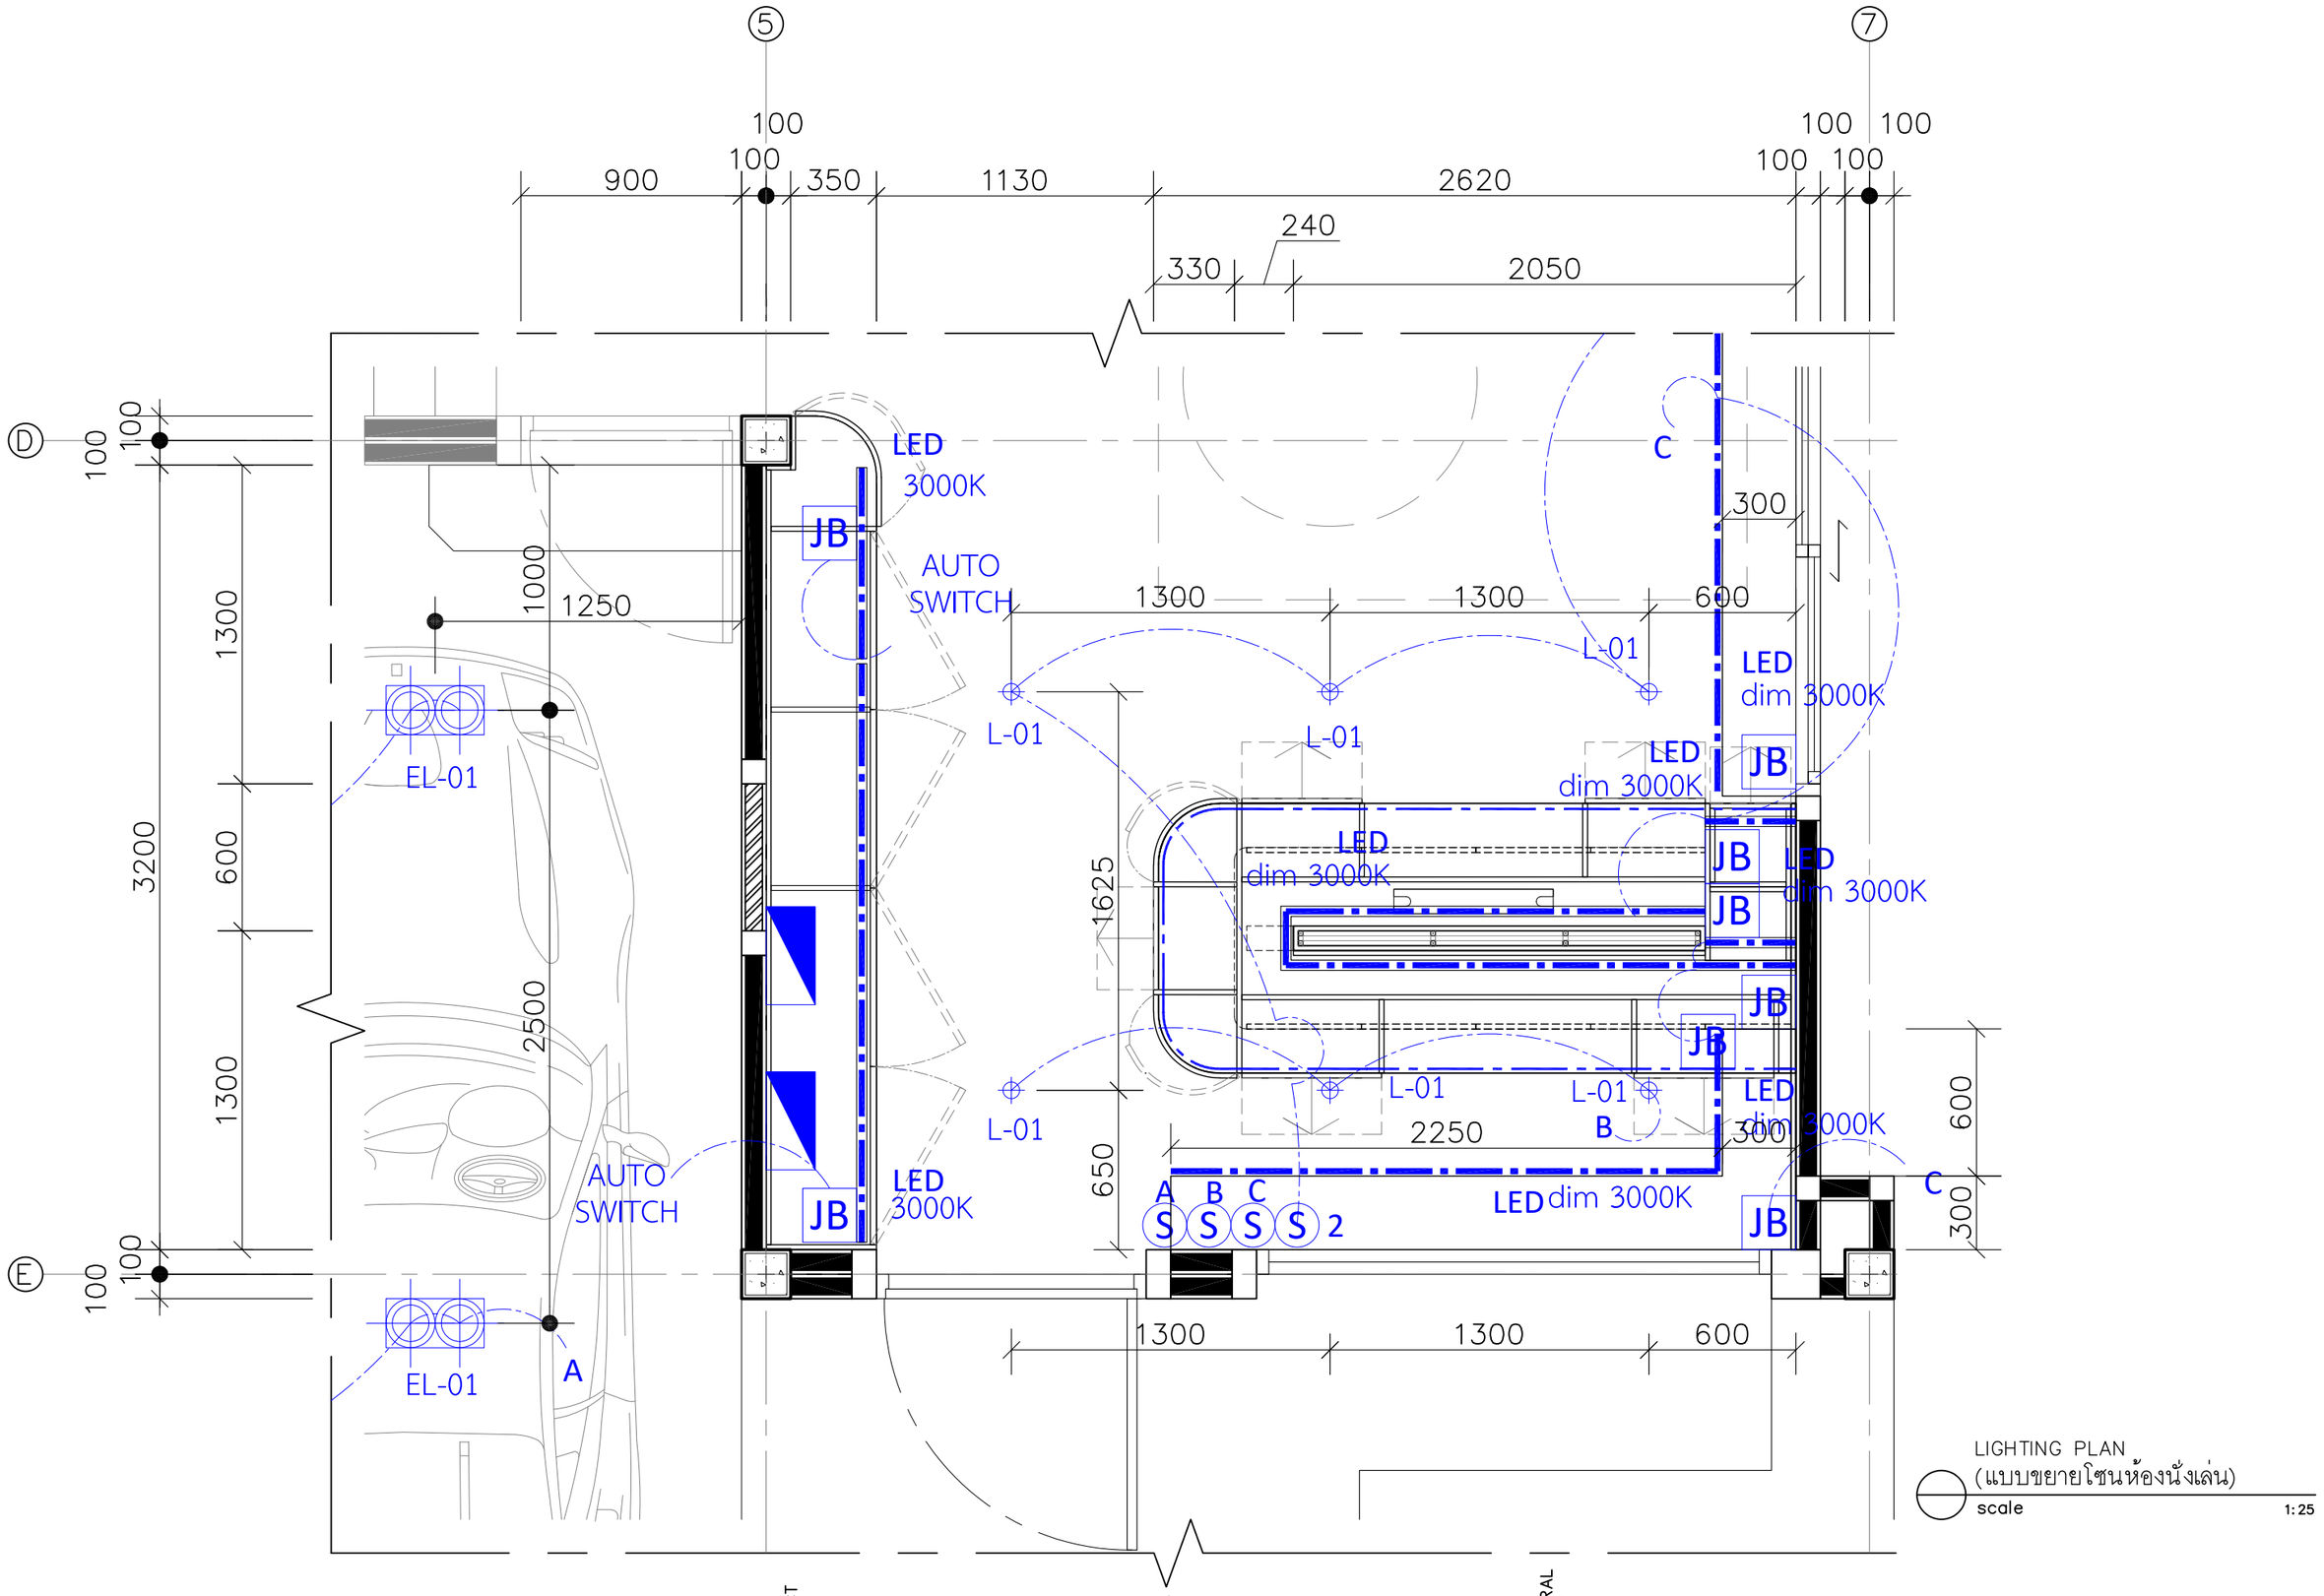

SPACEMAN

PROJECT: SONIA HOUSE

LOCATION: REIGNWOOD PARK
LAMLUKKA, PATHUM THANI

ARCHITECT:

INTERIOR DESIGNER: ปรัตถกร ประมุขกุล ภ-ศน 1438

STRUCTURAL ENGINEER:

TITLE: 1st FLOOR
LIGHTING PLAN
(แบบขยายบริเวณตรงข้ามครัว)

2026-02-04
ID1-02

1:25 @ A3

Note: SPACEMAN takes no responsibility for dimensions obtained by scaling from this drawing. If no dimension is shown the recipient must ascertain the dimension specifically from the architect or by site measurement and may not rely on the drawing. Supply of the drawing in digital form is solely for convenience and no reliance may be placed on any data in digital form. All data must be checked against hard copy. This drawing is issued for design intent only and should not be used for construction unless stated. This drawing is the property of SPACEMAN

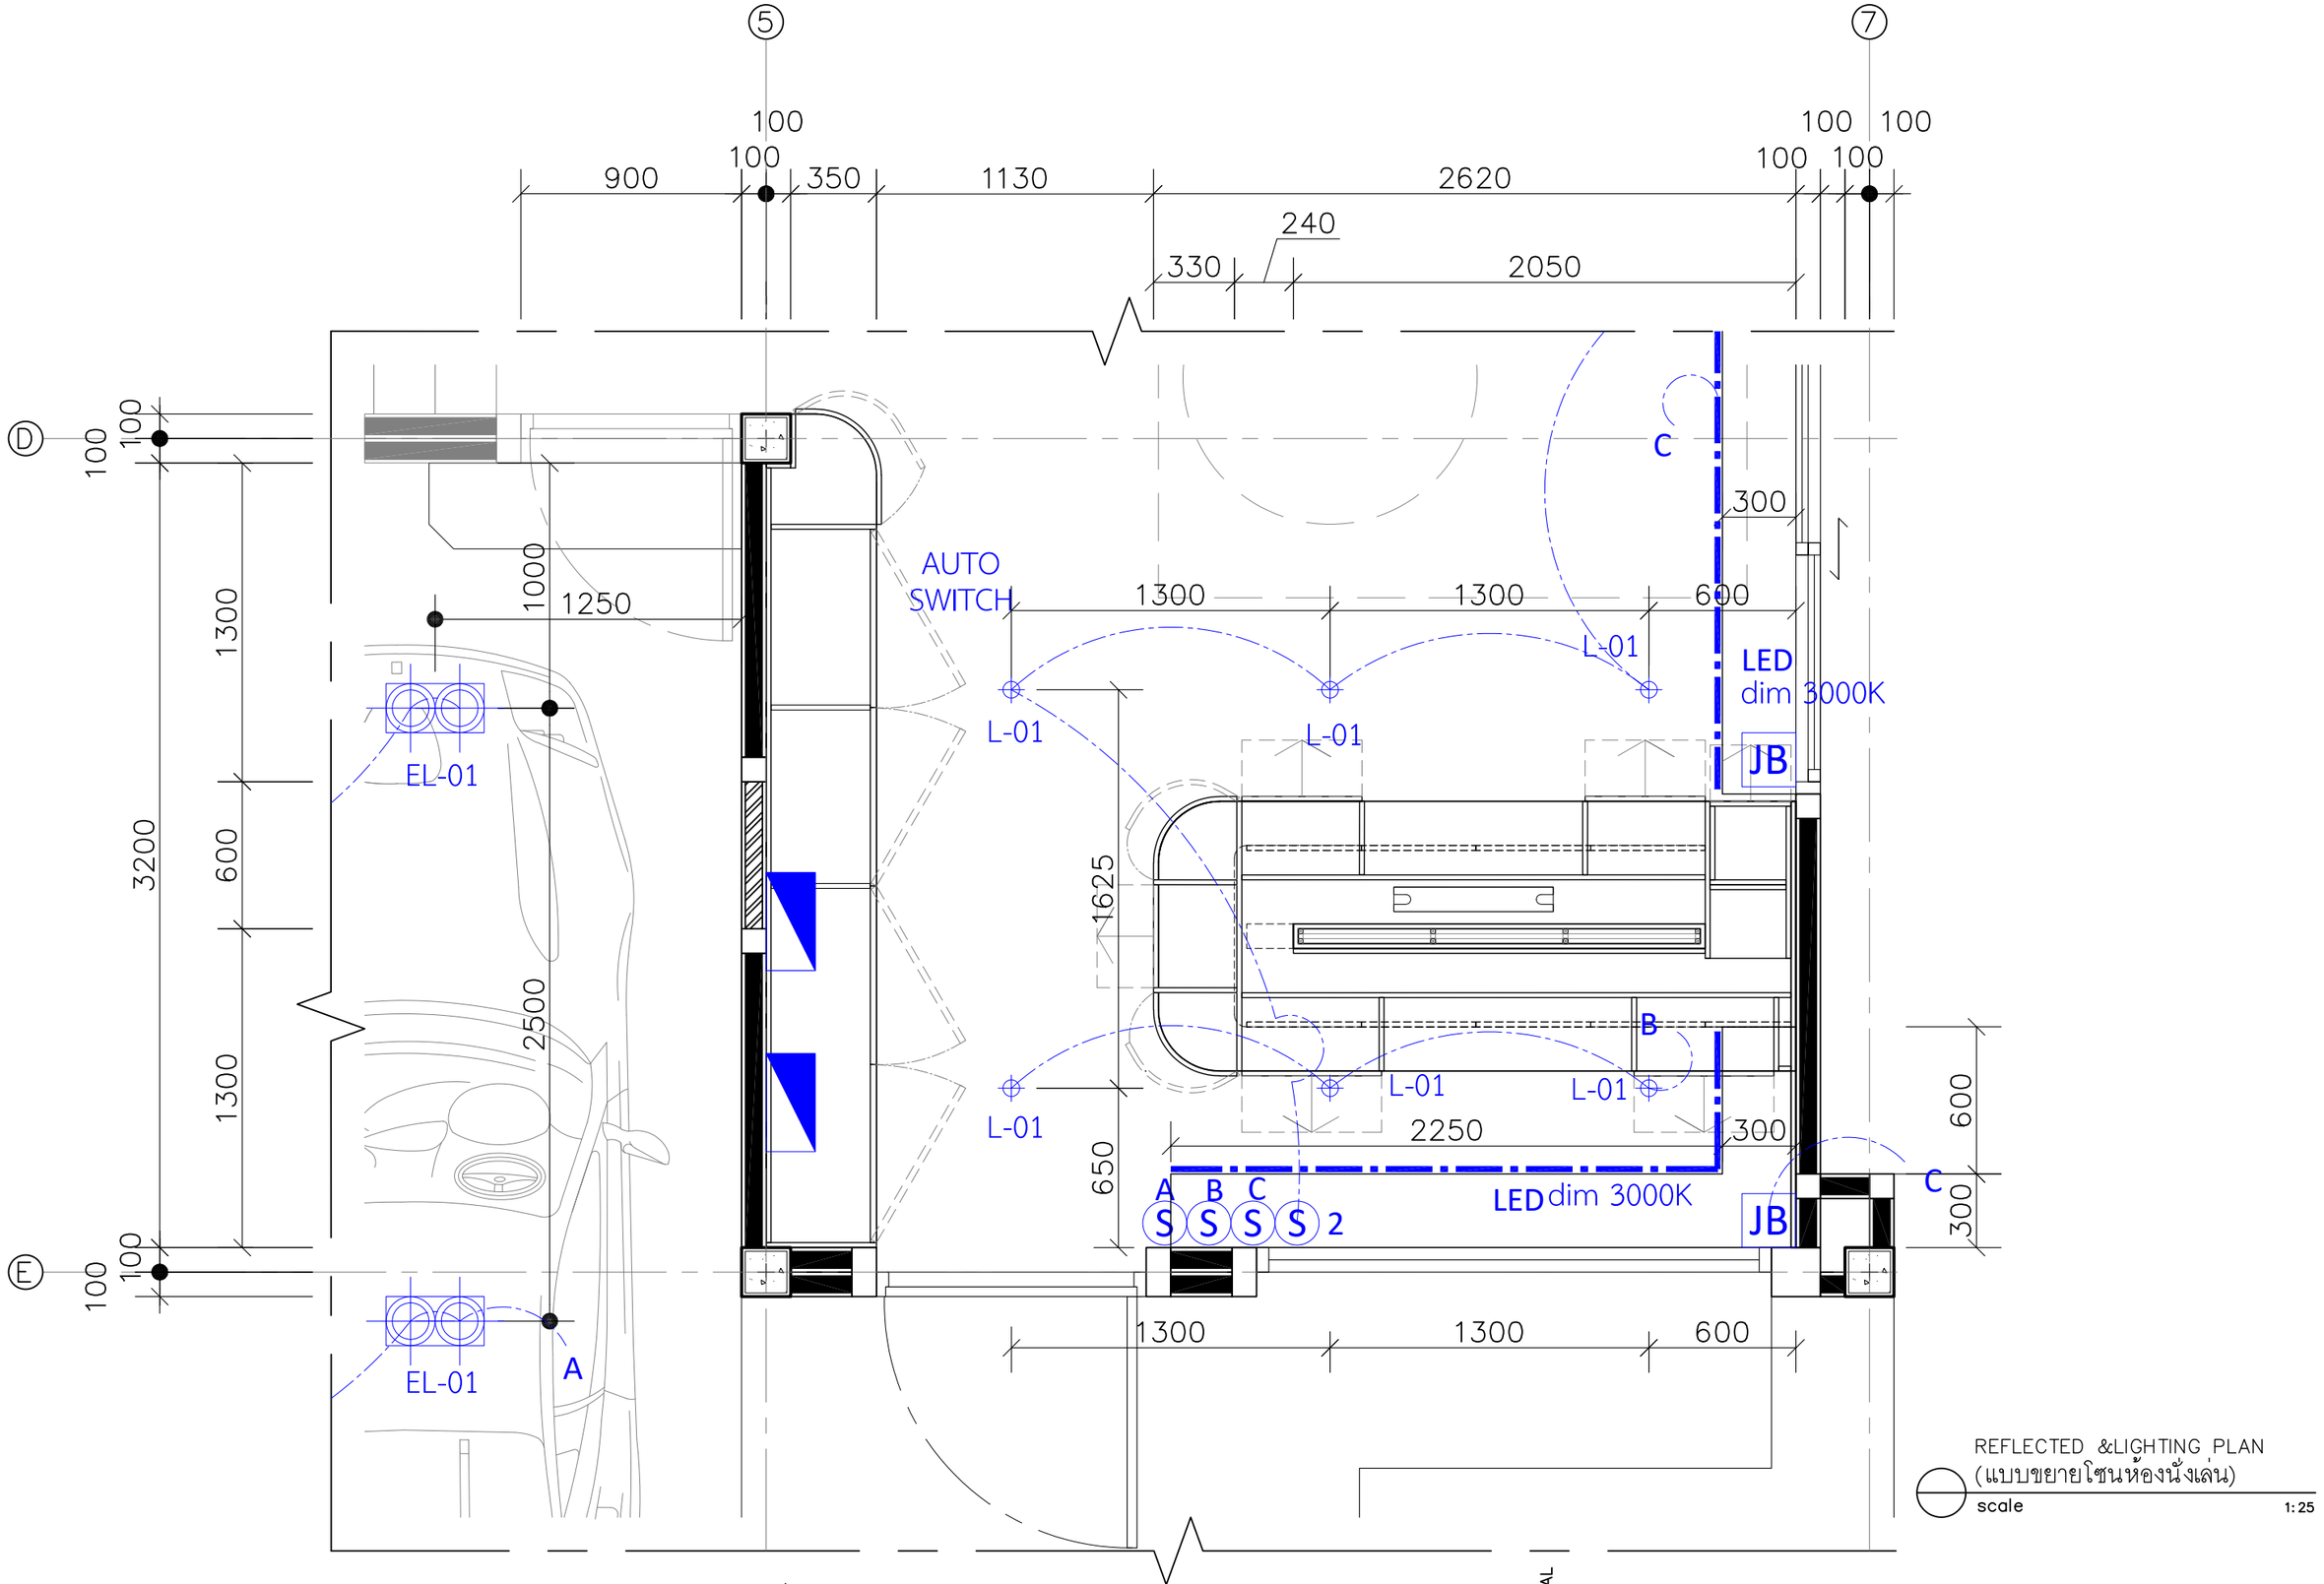

REFLECTED &LIGHTING PLAN
(แบบขยายโซนห้องนั่งเล่น)
scale 1:25

SPACEMAN

PROJECT | SONIA HOUSE

LOCATION | REIGNWOOD PARK
LAMLUKKA, PATHUM THANI

ARCHITECT

INTERIOR DESIGNER | ปรัตถกร ประมุขกุล ภ-สน 1438

STRUCTURAL ENGINEER

TITLE | 1st FLOOR
LIGHTING PLAN
(แบบขยายบริเวณตรงข้ามครัว)

2026-02-04
ID1-02
1:25 @ A3

Note: SPACEMAN takes no responsibility for dimensions obtained by scaling from this drawing. If no dimension is shown the recipient must ascertain the dimension specifically from the architect or by site measurement and may not rely on the drawing. Supply of the drawing in digital form is solely for convenience and no reliance may be placed on any data in digital form. All data must be checked against hard copy. This drawing is issued for design intent only and should not be used for construction unless stated. This drawing is the property of SPACEMAN

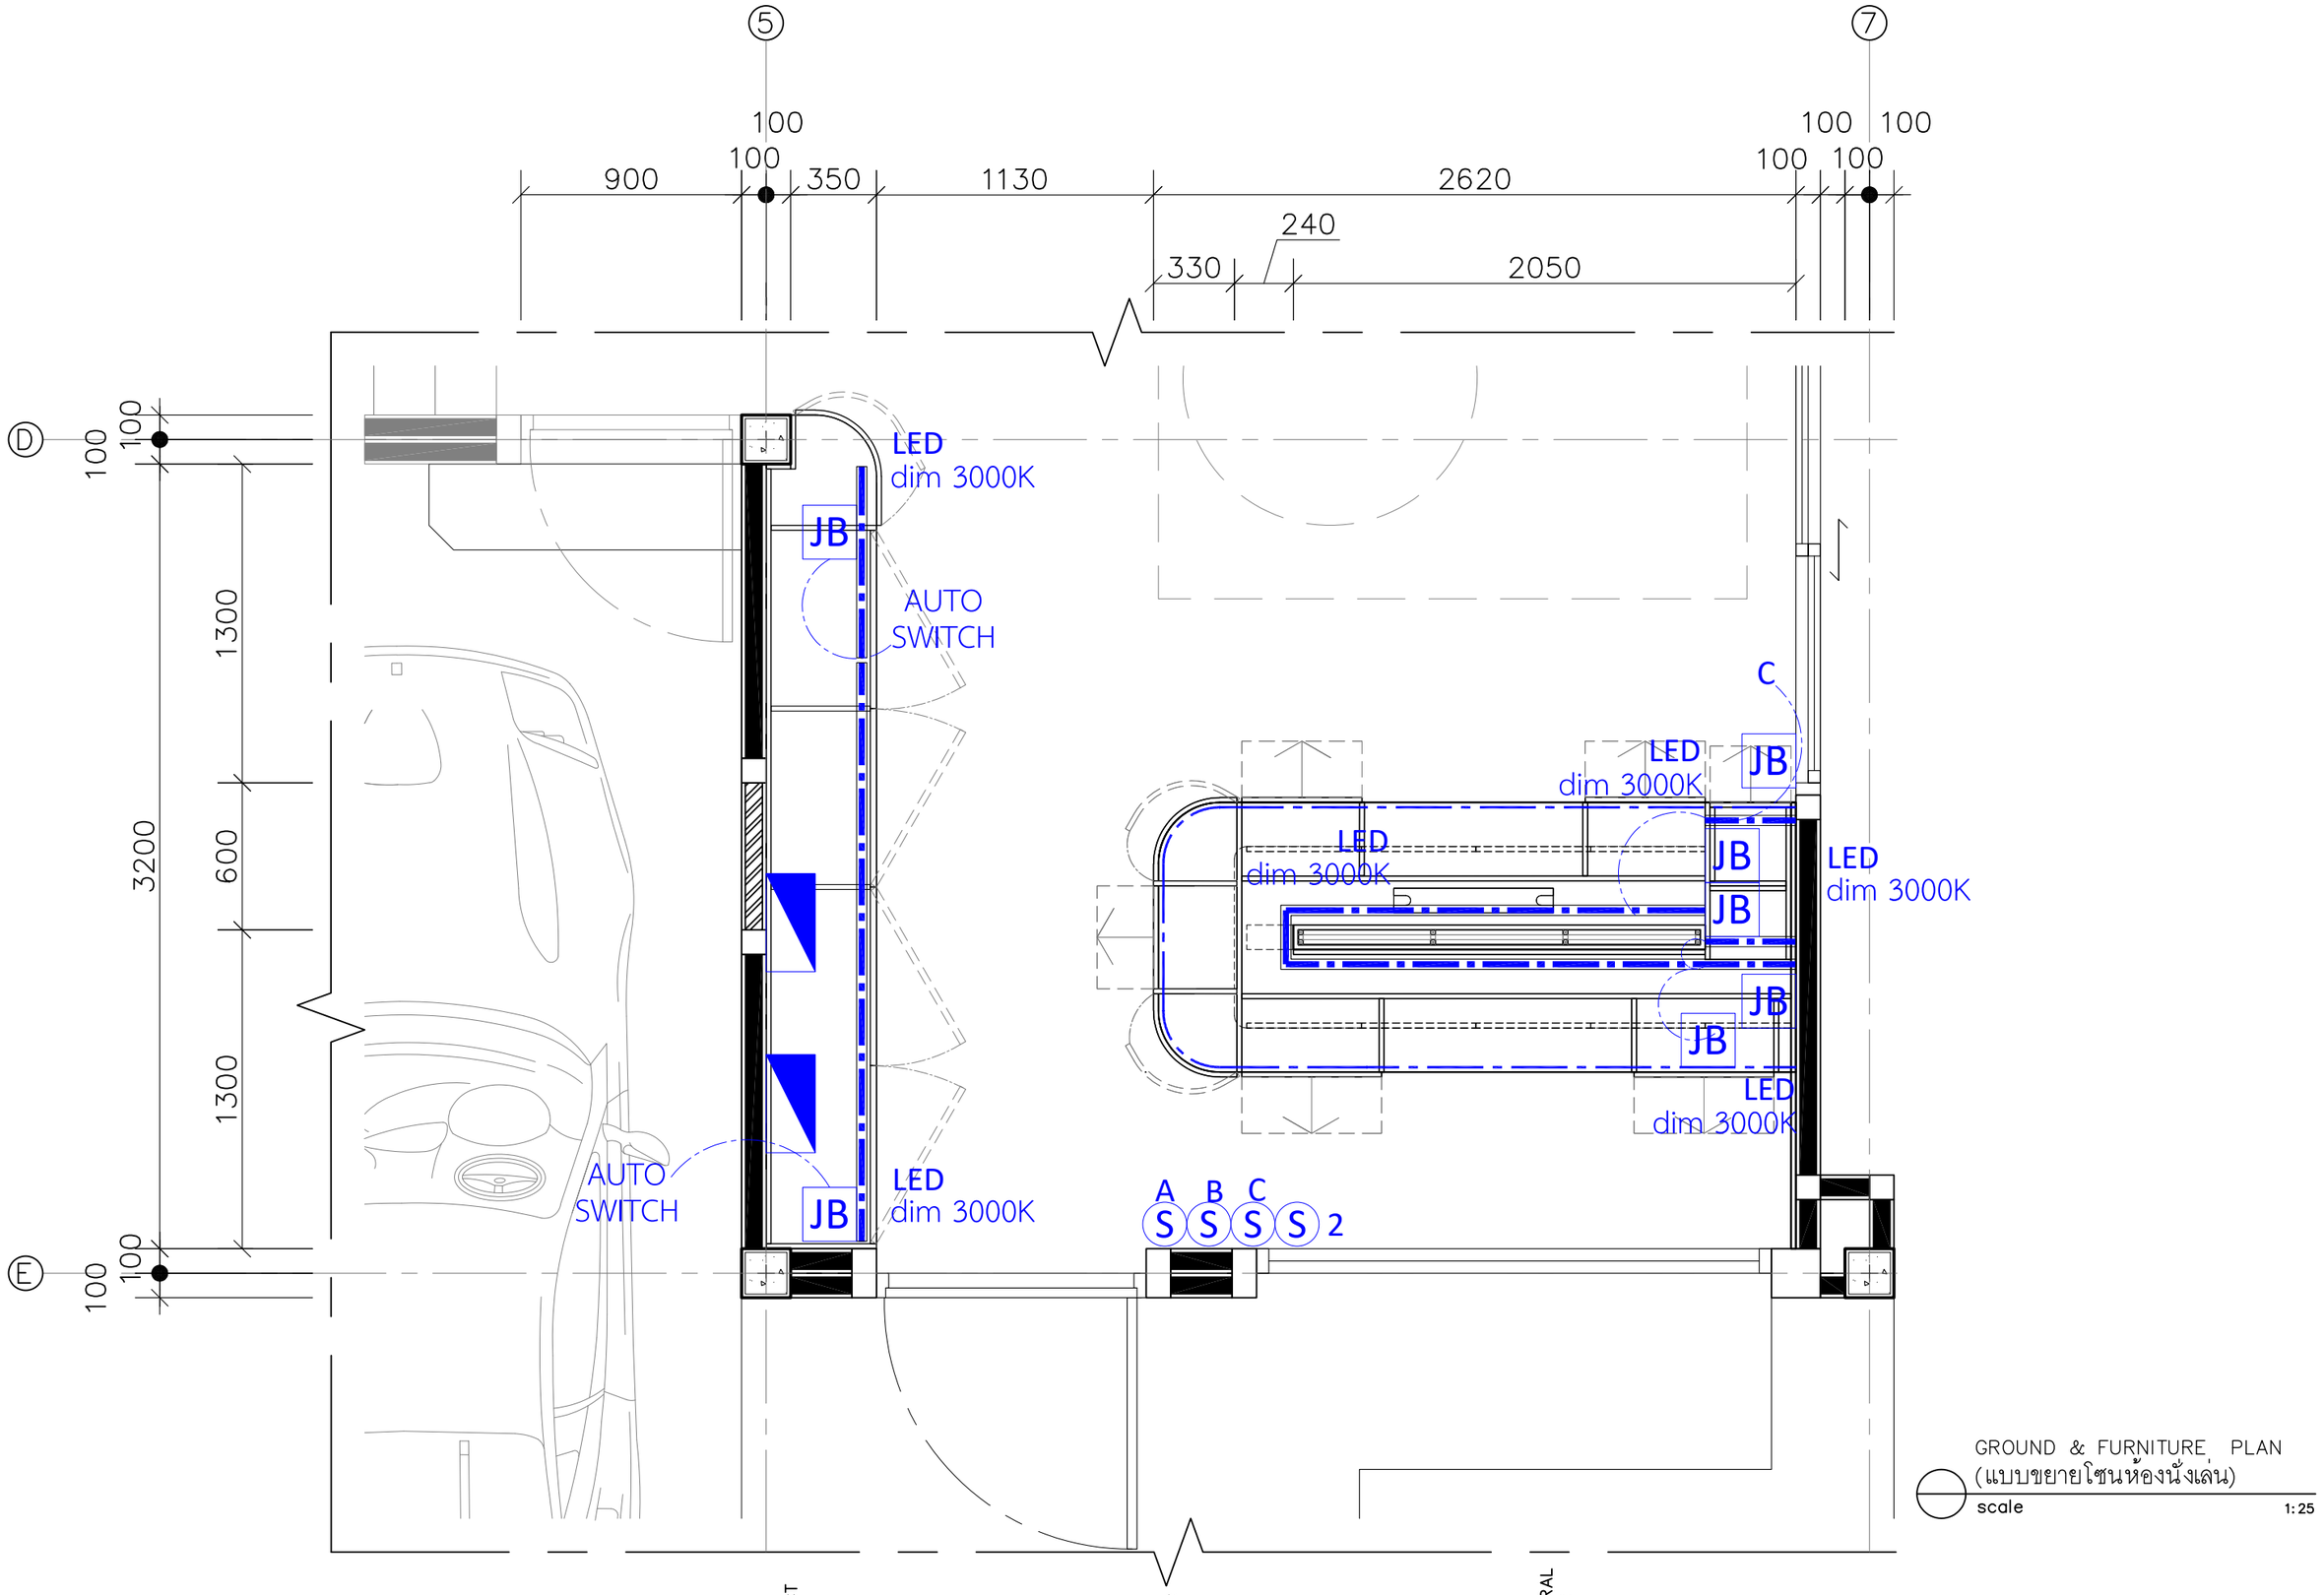

GROUND & FURNITURE PLAN
(แบบขยายโซนห้องนั่งเล่น)
scale 1:25

SPACEMAN

PROJECT | SONIA HOUSE

LOCATION | REIGNWOOD PARK
LAMLUKKA, PATHUM THANI

ARCHITECT

INTERIOR DESIGNER | ปรัตถกร ประมุขกุล ภ-สน 1438

STRUCTURAL ENGINEER

TITLE | 1st FLOOR
LIGHTING PLAN
(แบบขยายบริเวณตรงข้ามครัว)

2026-02-04
ID1-02
1:25 @ A3

Note: SPACEMAN takes no responsibility for dimensions obtained by scaling from this drawing. If no dimension is shown the recipient must ascertain the dimension specifically from the architect or by site measurement and may not rely on the drawing. Supply of the drawing in digital form is solely for convenience and no reliance may be placed on any data in digital form. All data must be checked against hard copy. This drawing is issued for design intent only and should not be used for construction unless stated. This drawing is the property of SPACEMAN

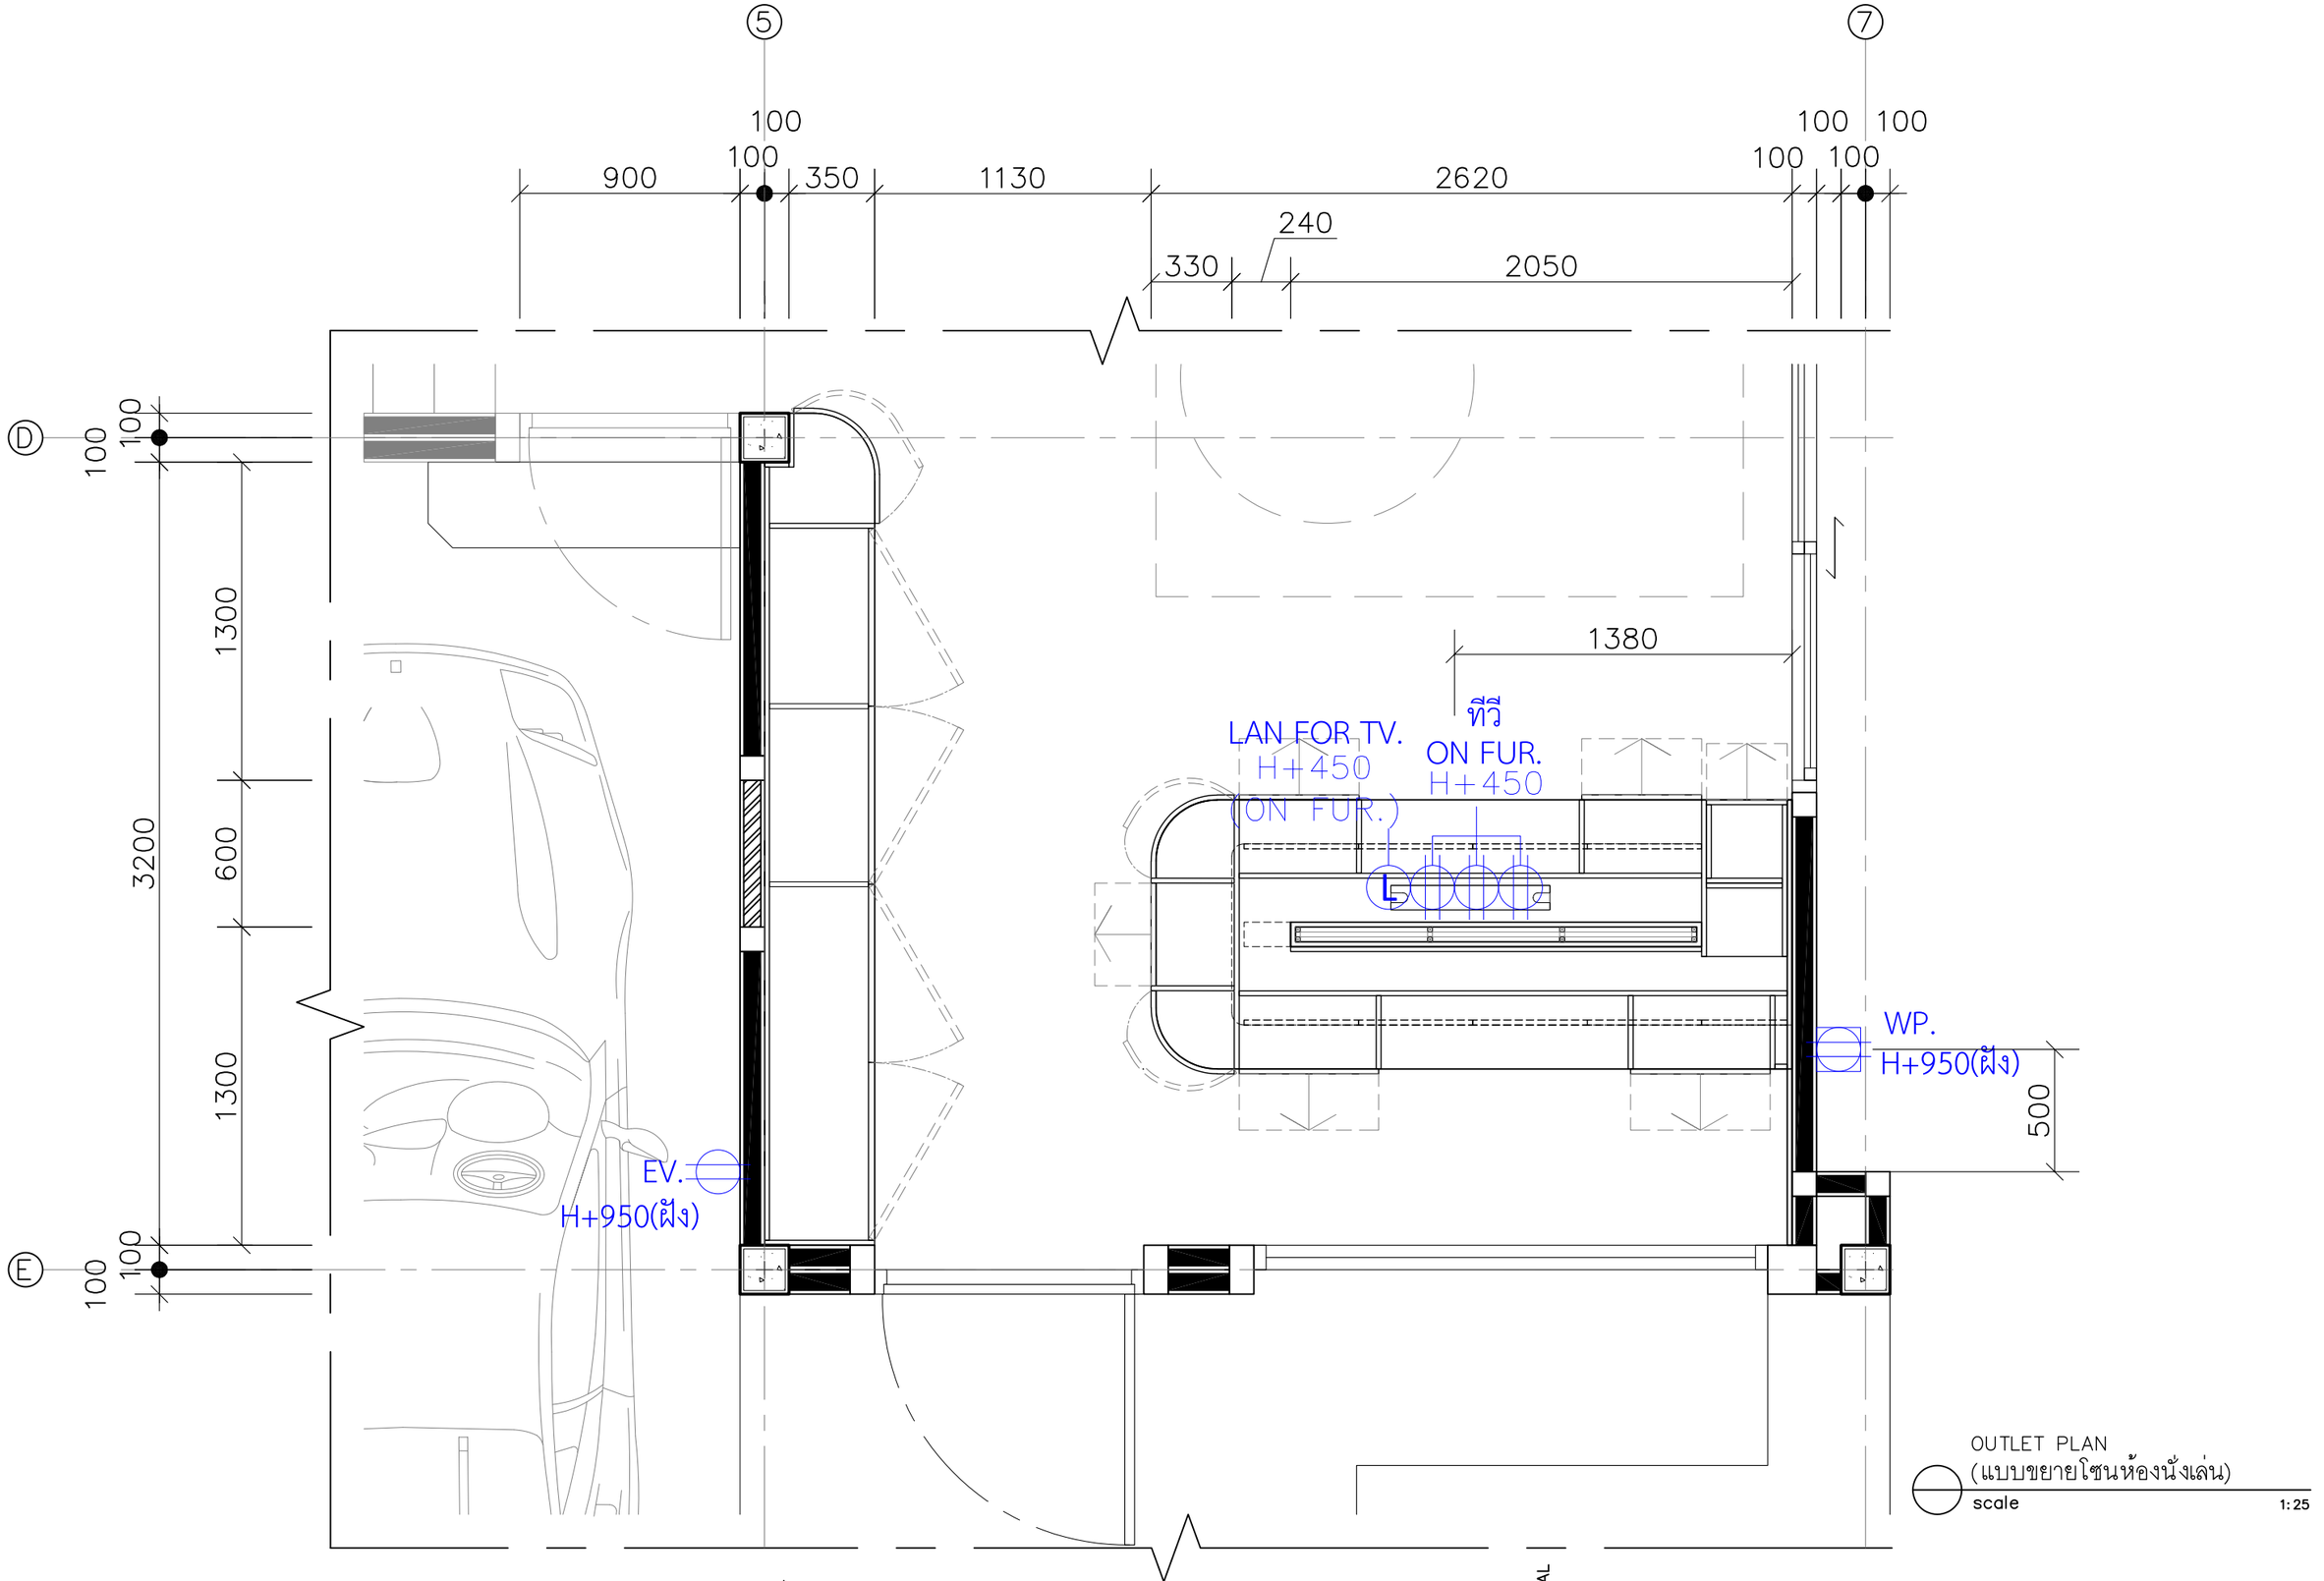

OUTLET PLAN
(แบบขยายโซนห้องนั่งเล่น)
scale 1:25

SPACEMAN	
PROJECT	SONIA HOUSE
LOCATION	REIGNWOOD PARK LAMLUKKA, PATHUM THANI
ARCHITECT	
INTERIOR DESIGNER	ปรัตถกร ประมุขกุล ภ-สน 1438
STRUCTURAL ENGINEER	
TITLE	1st FLOOR OUTLET PLAN (แบบขยายบริเวณตรงข้ามครัว)
	2026-02-04 ID1-03 1:25 @ A3

Note: SPACEMAN takes no responsibility for dimensions obtained by scaling from this drawing. If no dimension is shown the recipient must ascertain the dimension specifically from the architect or by site measurement and may not rely on the drawing. Supply of the drawing in digital form is solely for convenience and no reliance may be placed on any data in digital form. All data must be checked against hard copy. This drawing is issued for design intent only and should not be used for construction unless stated. This drawing is the property of SPACEMAN

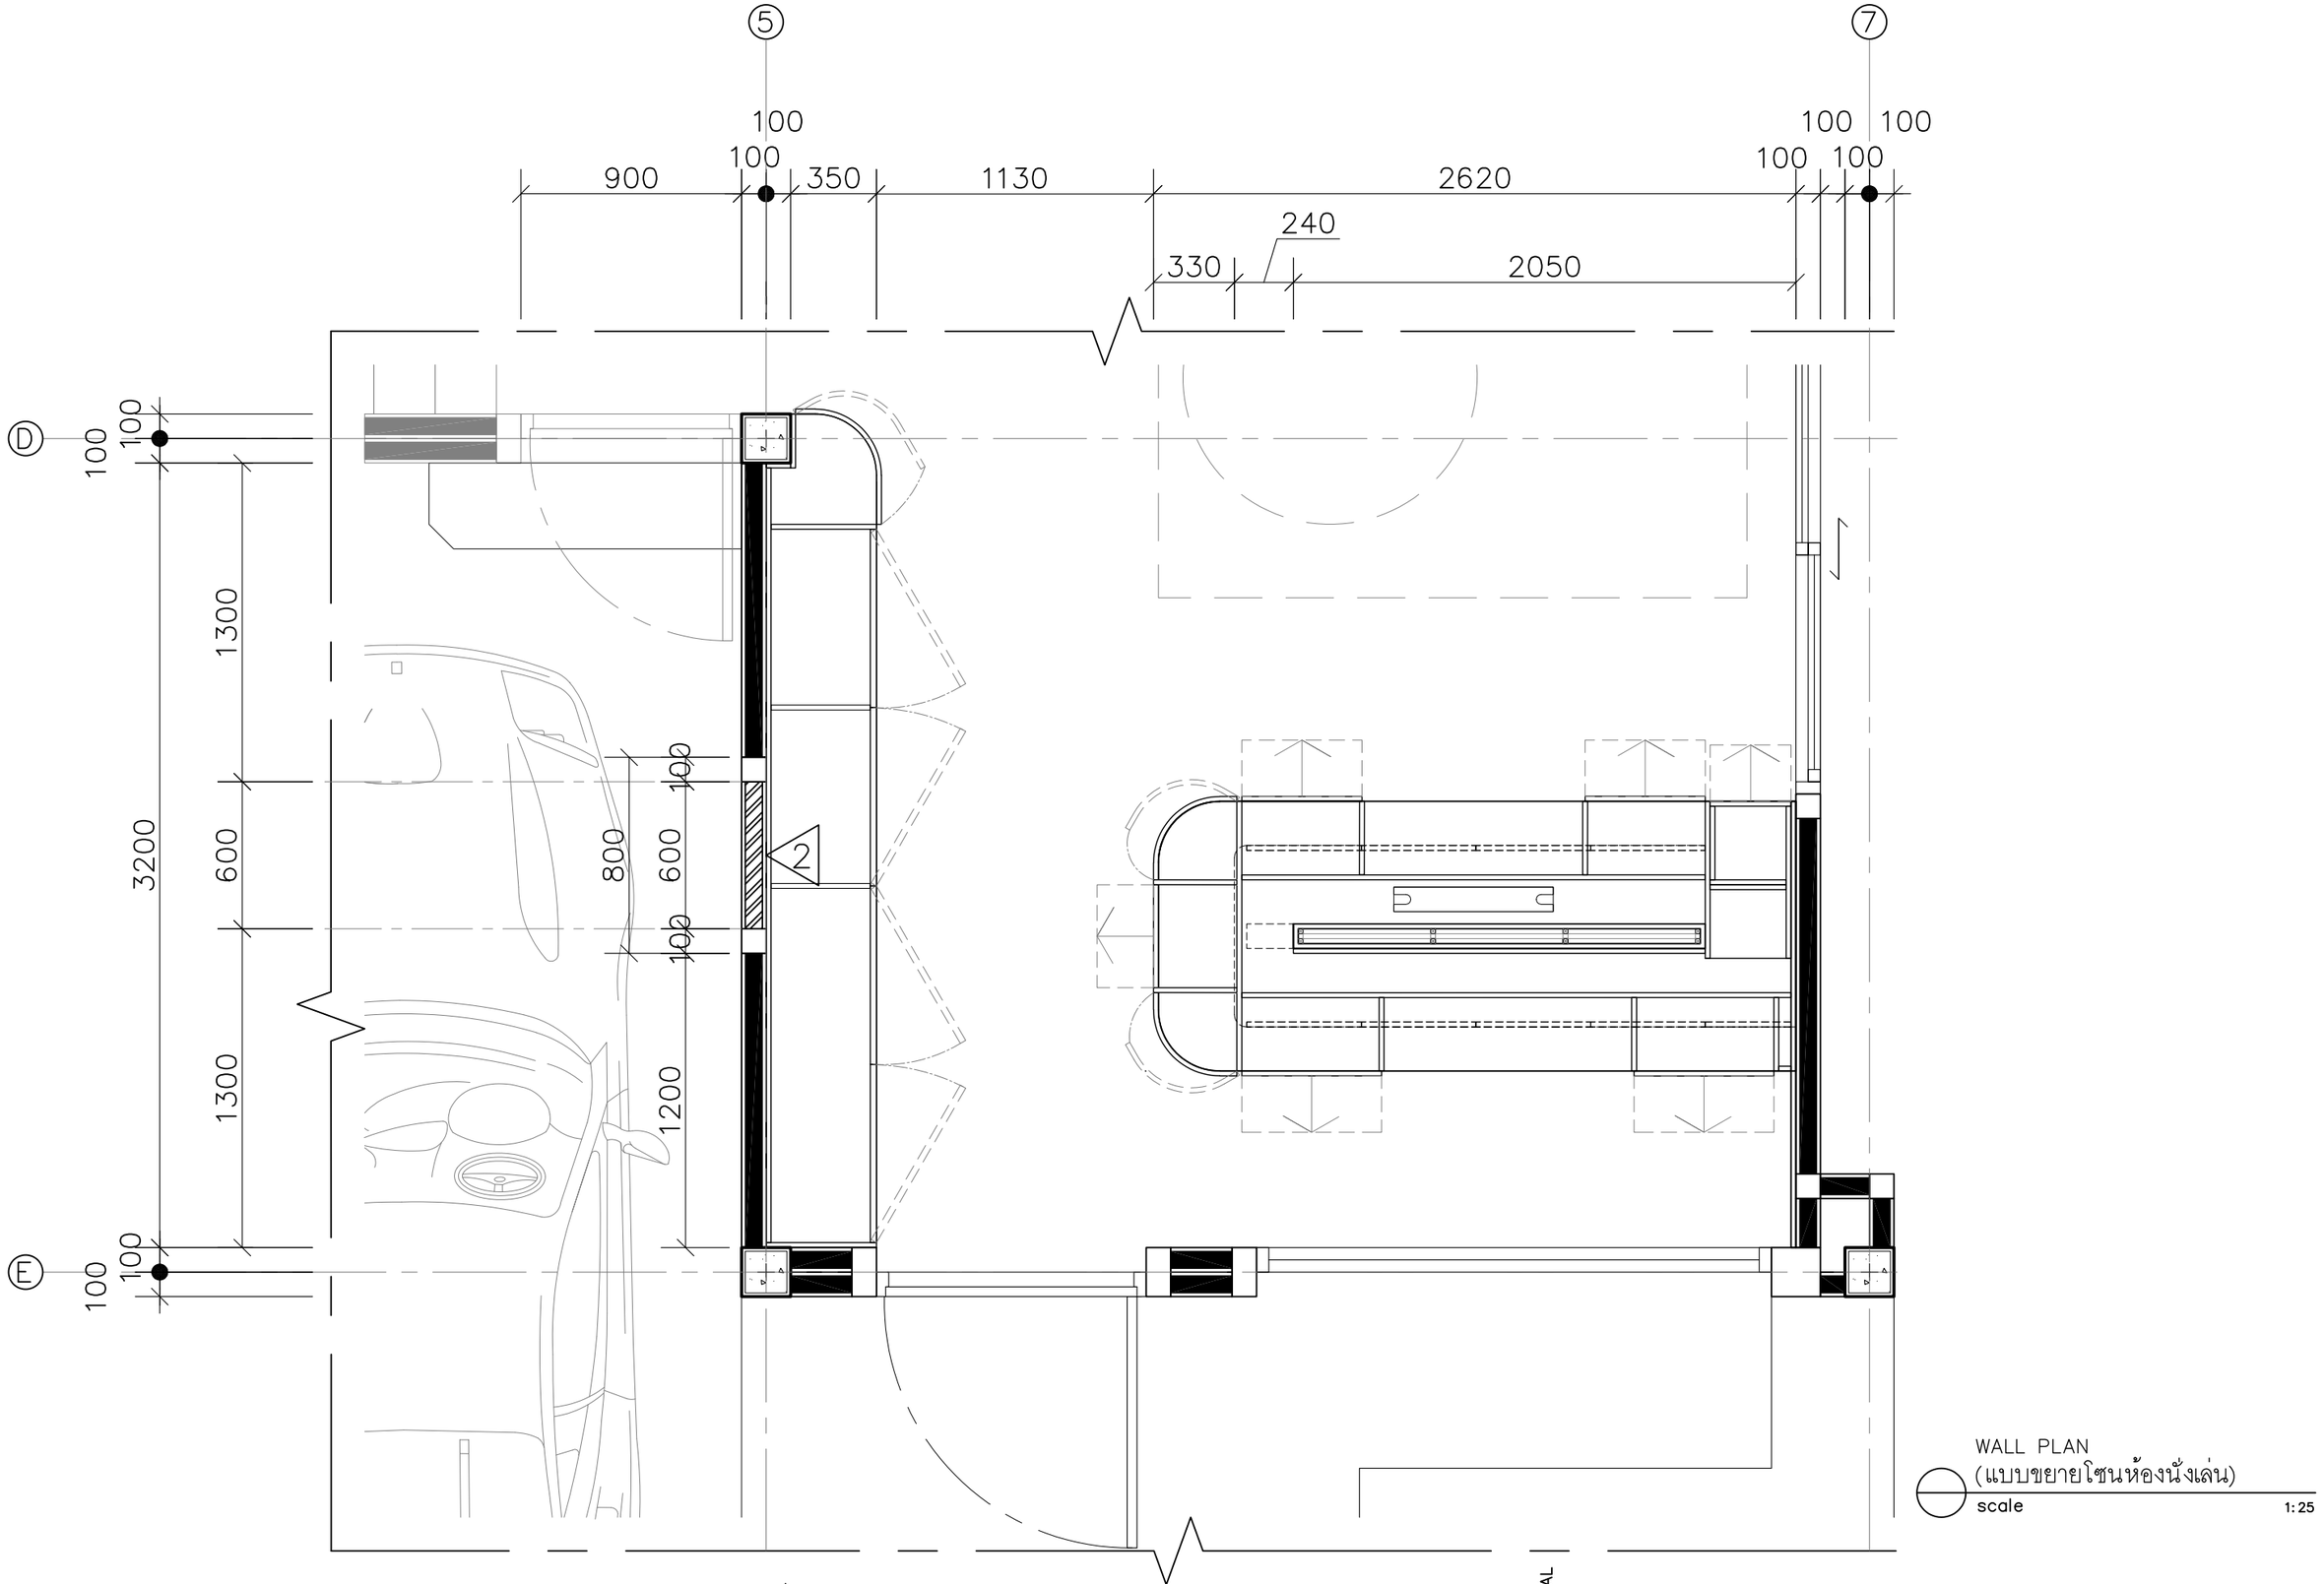

WALL PLAN
(แบบขยายโซนห้องนั่งเล่น)
scale 1:25

SPACEMAN

PROJECT | SONIA HOUSE

LOCATION | REIGNWOOD PARK
LAMLUKKA, PATHUM THANI

ARCHITECT |

INTERIOR DESIGNER | ปรัตถกร ประมุขกุล ภ-สน 1438

STRUCTURAL ENGINEER |

TITLE | 1st FLOOR
WALL PLAN
(แบบขยายบริเวณตรงข้ามครัว)

2026-02-04
ID1-04

1:25 @ A3

Note: SPACEMAN takes no responsibility for dimensions obtained by scaling from this drawing. If no dimension is shown the recipient must ascertain the dimension specifically from the architect or by site measurement and may not rely on the drawing. Supply of the drawing in digital form is solely for convenience and no reliance may be placed on any data in digital form. All data must be checked against hard copy. This drawing is issued for design intent only and should not be used for construction unless stated. This drawing is the property of SPACEMAN

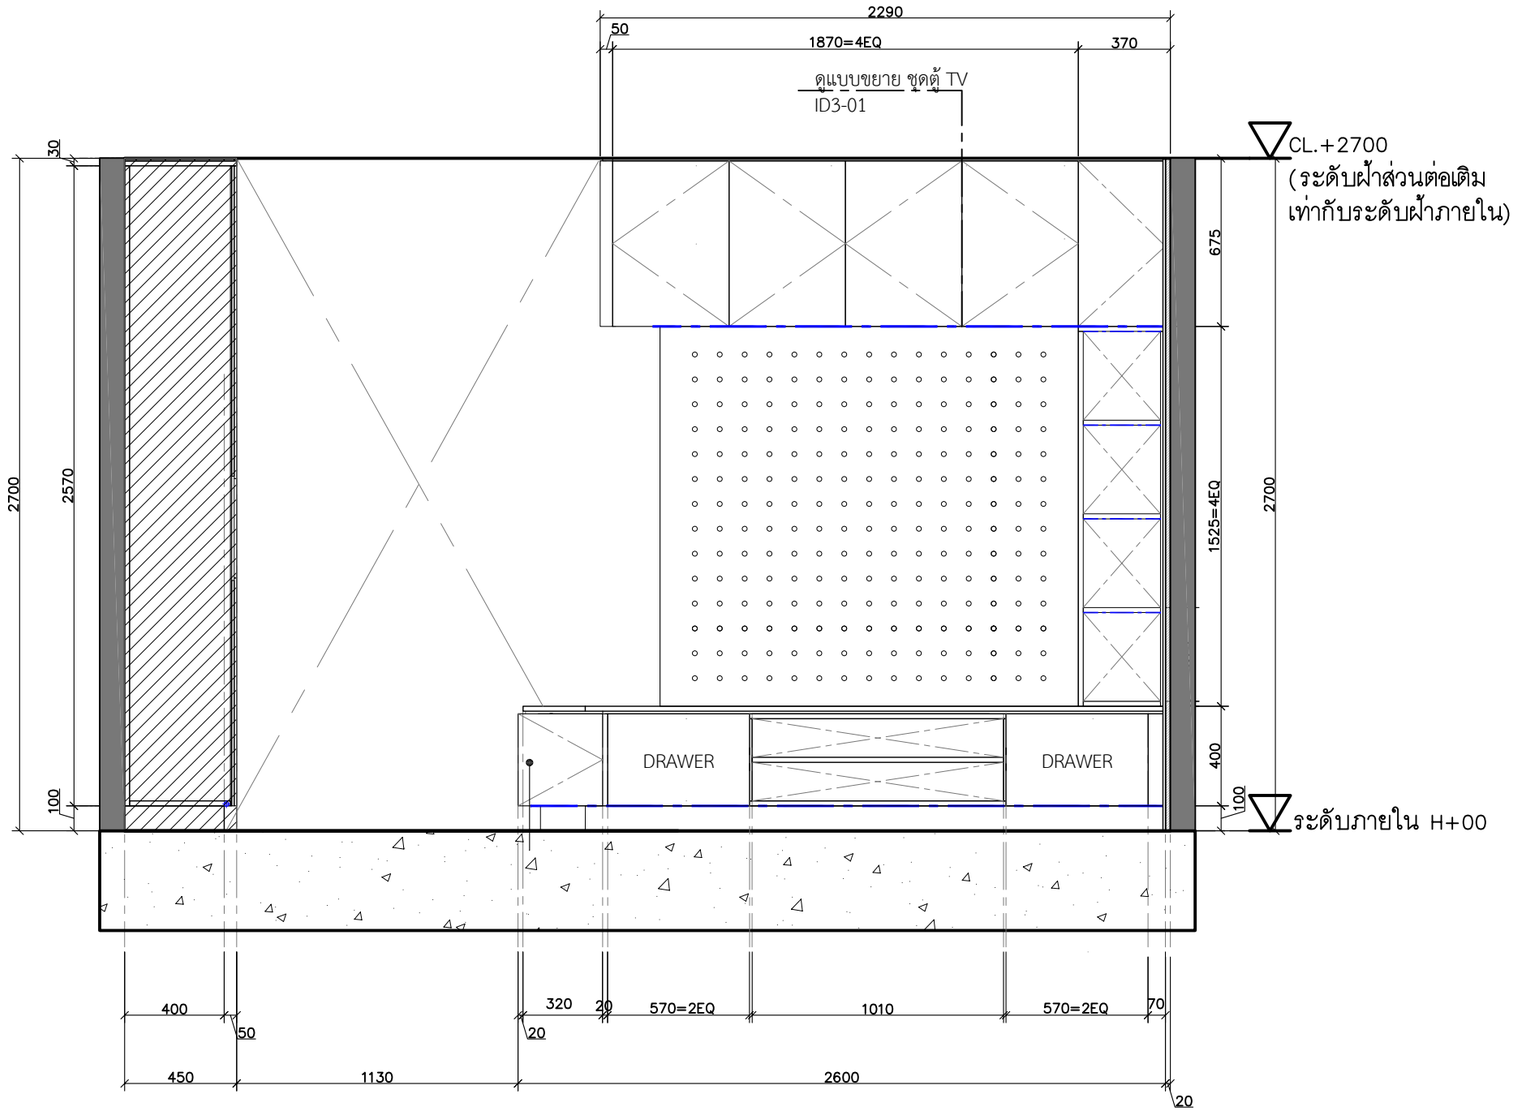

บริเวณตรงประตูทางเข้า– ห้องนั่งเล่น
ELEVATION 1

scale 1:25

Note: SPACEMAN takes no responsibility for dimensions obtained by scaling from this drawing. If no dimension is shown the recipient must ascertain the dimension specifically from the architect or by site measurement and may not rely on the drawing. Supply of the drawing in digital form is solely for convenience and no reliance may be placed on any data in digital form. All data must be checked against hard copy. This drawing is issued for design intent only and should not be used for construction unless stated. This drawing is the property of SPACEMAN

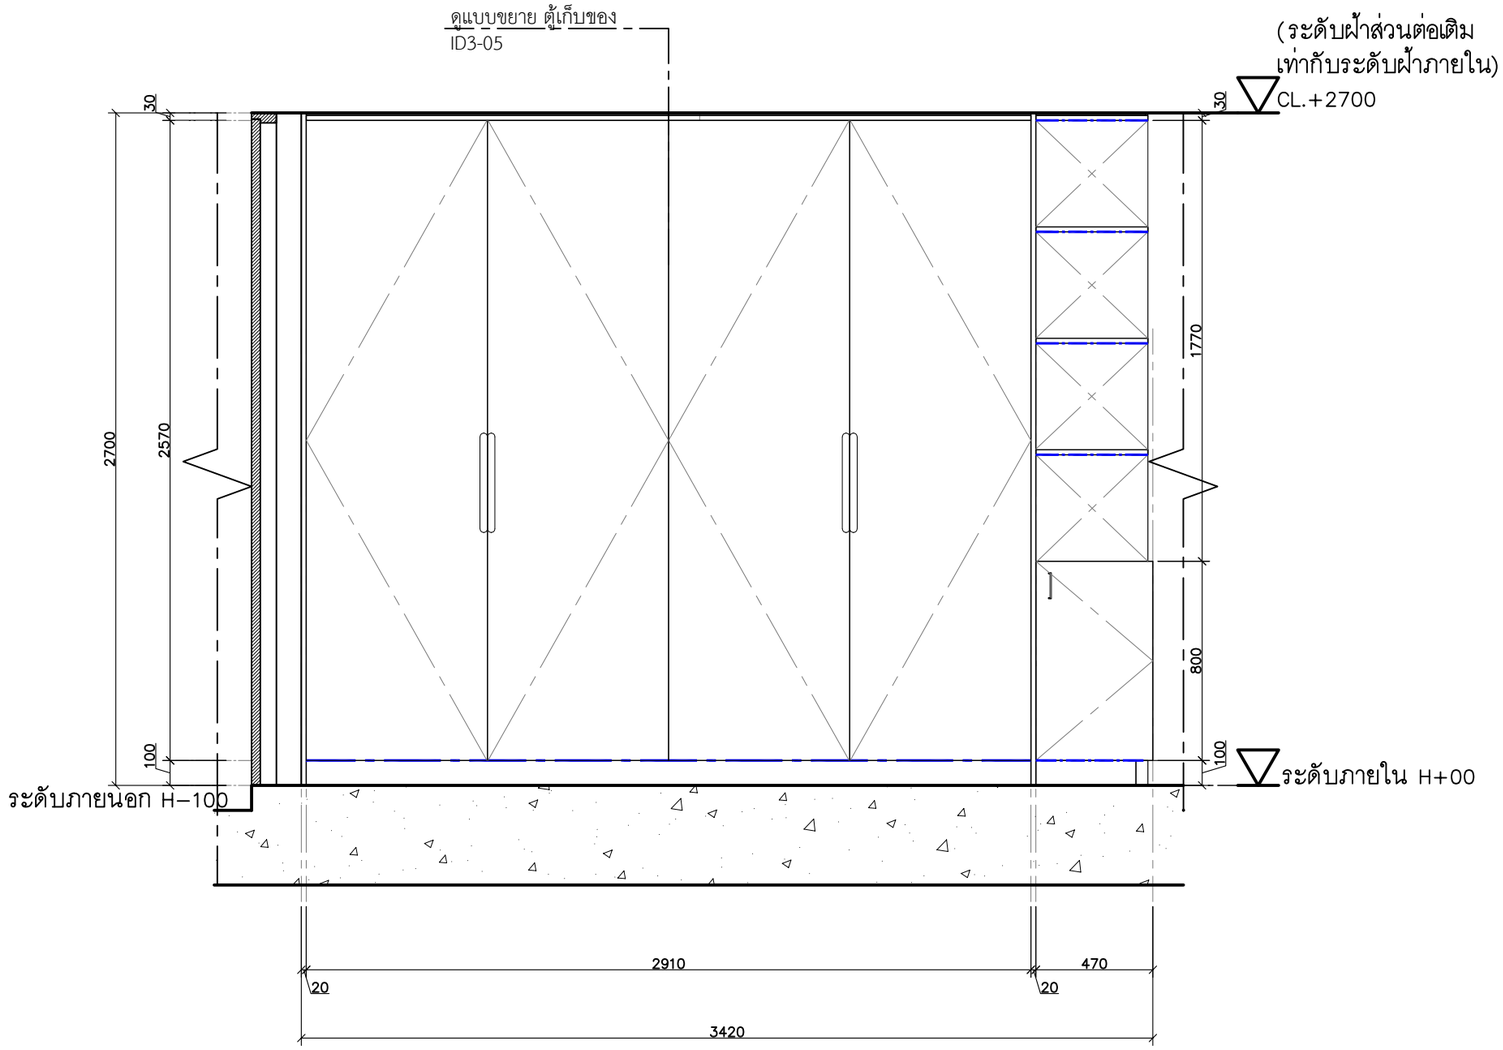

บริเวณตรงประตูทางเข้า– ห้องนั่งเล่น
ELEVATION 2

scale 1:25

SPACEMAN

PROJECT | SONIA HOUSE

LOCATION | REIGNWOOD PARK
LAMLUKKA, PATHUM THANI

ARCHITECT

INTERIOR DESIGNER | ปรัตถกร ประมุขกุล ภ–สน 1438

STRUCTURAL ENGINEER

TITLE | 1st FLOOR
ELEVATION
(แบบขยายส่วนห้องนั่งเล่น)

2026–06–18
ID2–02

1:25 @ A3

Note: SPACEMAN takes no responsibility for dimensions obtained by scaling from this drawing. If no dimension is shown the recipient must ascertain the dimension specifically from the architect or by site measurement and may not rely on the drawing. Supply of the drawing in digital form is solely for convenience and no reliance may be placed on any data in digital form. All data must be checked against hard copy. This drawing is issued for design intent only and should not be used for construction unless stated. This drawing is the property of SPACEMAN

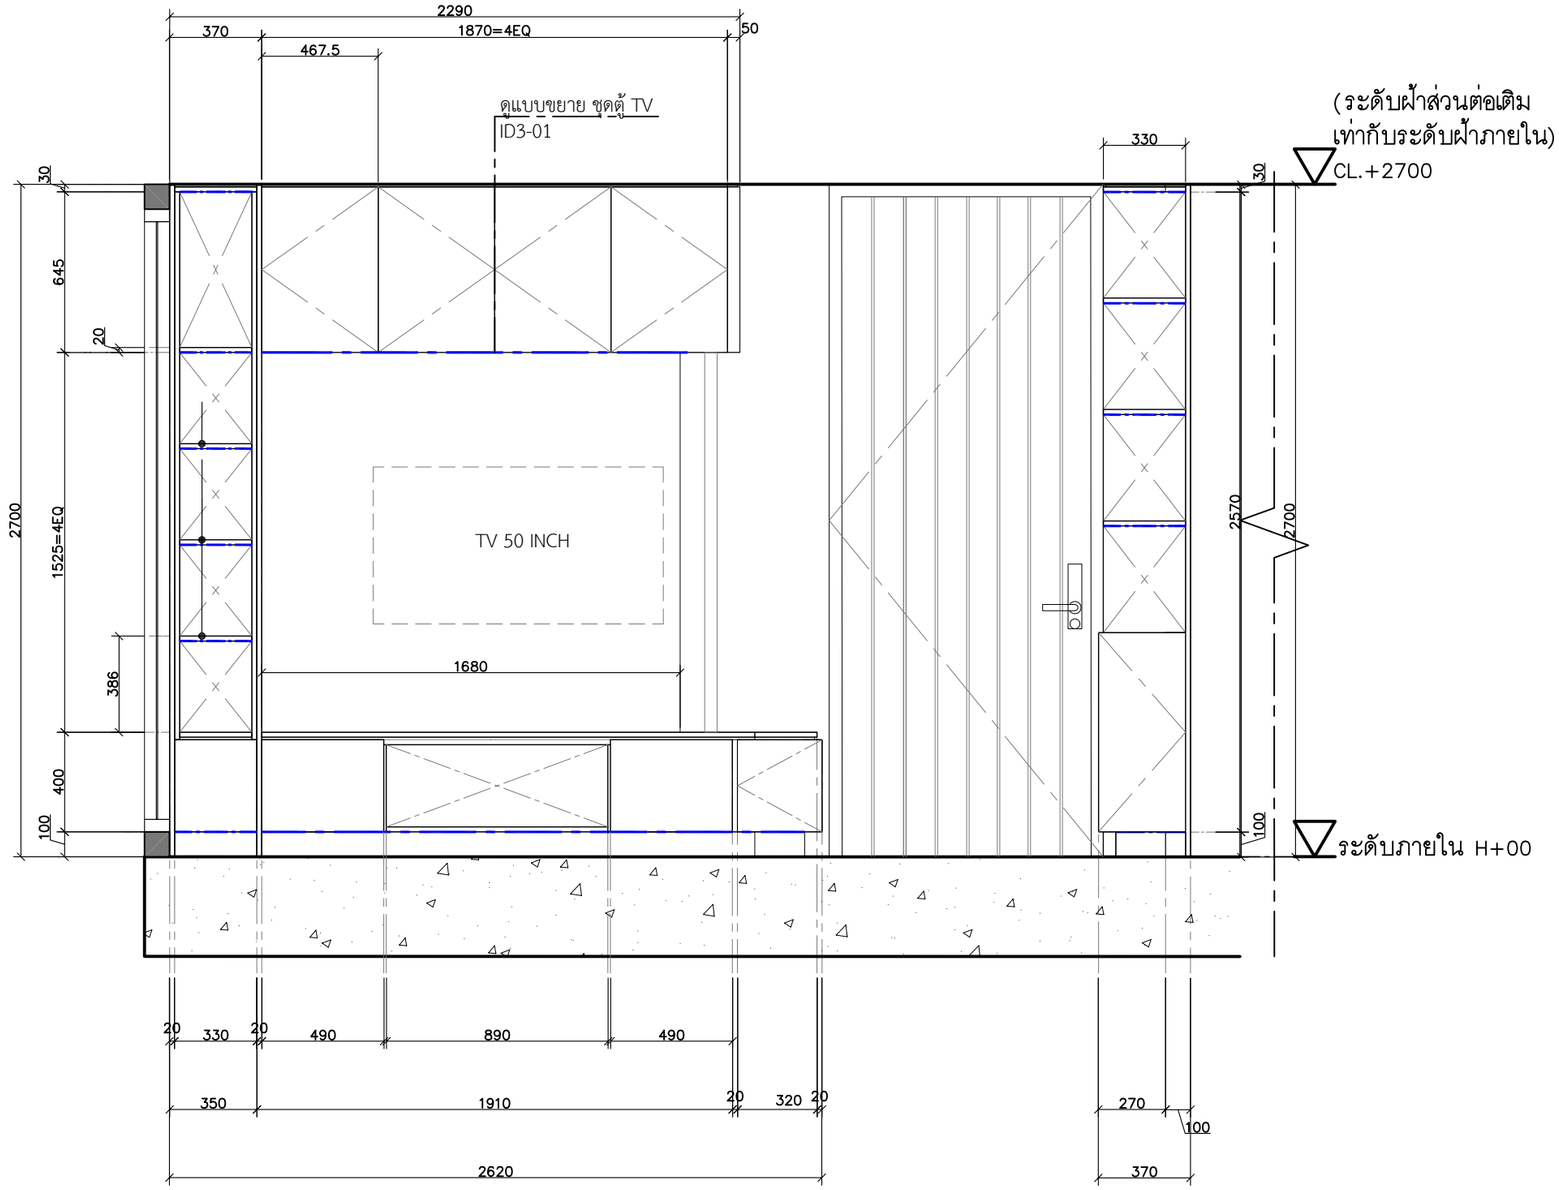

บริเวณตรงประตูทางเข้า– ห้องนั่งเล่น
ELEVATION 3

scale 1:25

SPACEMAN

PROJECT | SONIA HOUSE

LOCATION | REIGNWOOD PARK
LAMLUKKA, PATHUM THANI

ARCHITECT |

INTERIOR DESIGNER | ปรัตถกร ประมุขกุล ภ–สน 1438

STRUCTURAL ENGINEER |

TITLE | 1st FLOOR
ELEVATION
(แบบขยายส่วนห้องนั่งเล่น)

2026–06–18
ID2–03
1:25 @ A3

Note: SPACEMAN takes no responsibility for dimensions obtained by scaling from this drawing. If no dimension is shown the recipient must ascertain the dimension specifically from the architect or by site measurement and may not rely on the drawing. Supply of the drawing in digital form is solely for convenience and no reliance may be placed on any data in digital form. All data must be checked against hard copy. This drawing is issued for design intent only and should not be used for construction unless stated. This drawing is the property of SPACEMAN

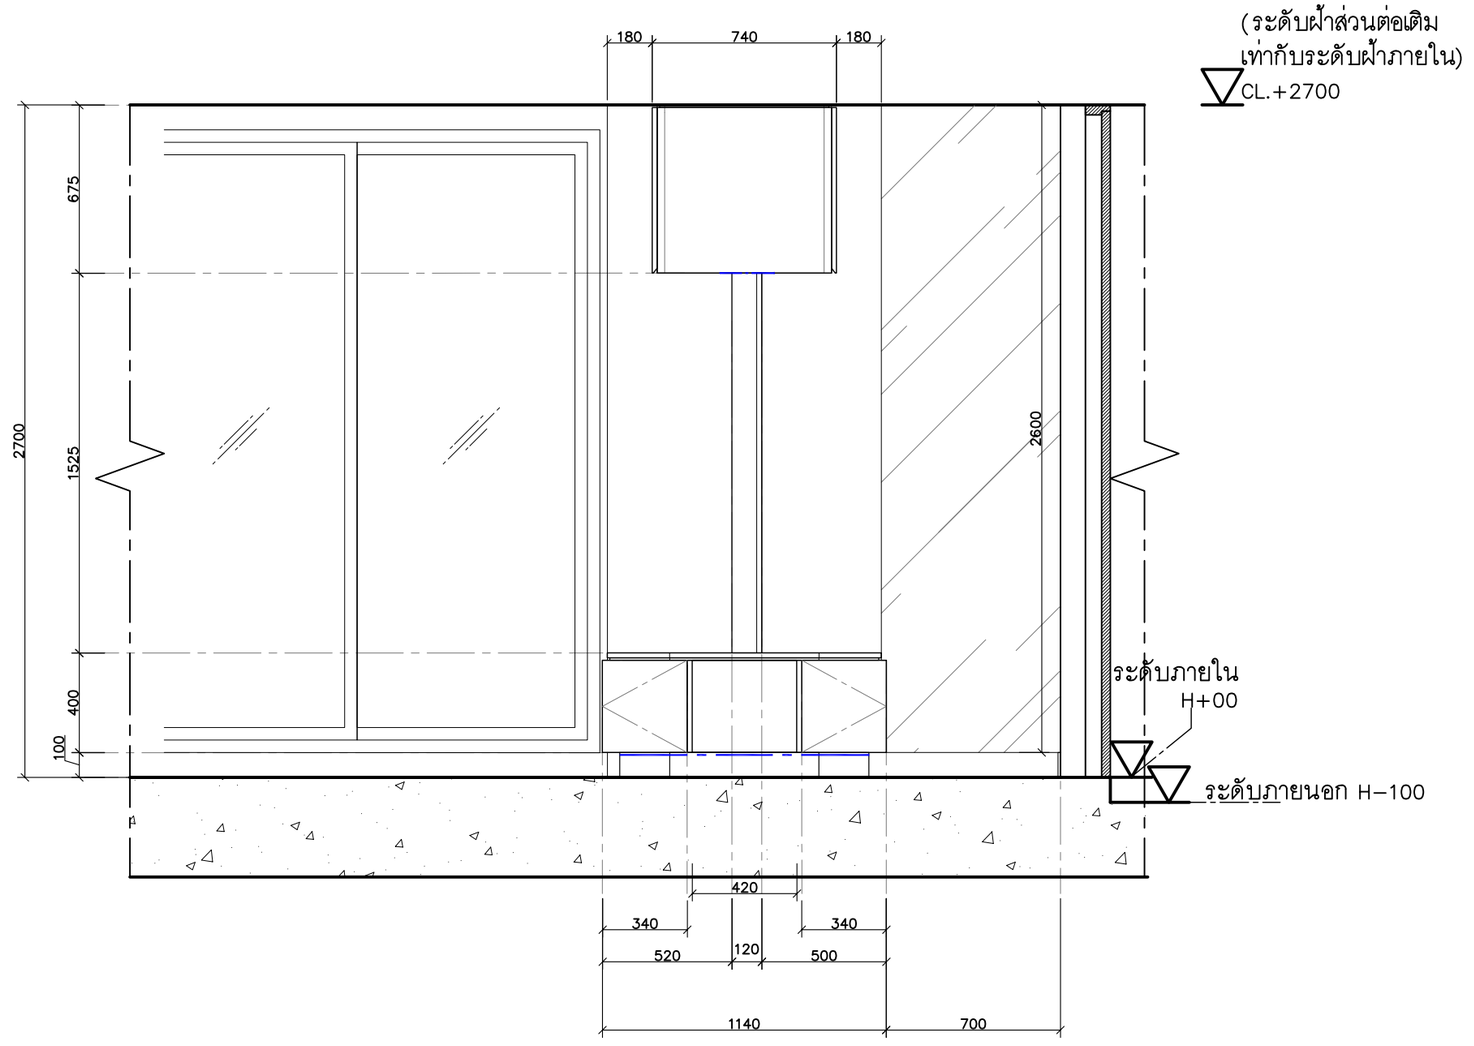

บริเวณตรงประตูทางเข้า- ห้องนั่งเล่น
ELEVATION 4

scale 1:25

SPACEMAN	PROJECT: SONIA HOUSE	LOCATION: REIGNWOOD PARK LAMLUKKA, PATHUM THANI	ARCHITECT	INTERIOR DESIGNER: ปรัตถกร ประมุขกุล ภ-สน 1438	STRUCTURAL ENGINEER	TITLE: 1st FLOOR ELEVATION (แบบขยายส่วนห้องนั่งเล่น)	2026-06-18 ID2-04

Note: SPACEMAN takes no responsibility for dimensions obtained by scaling from this drawing. If no dimension is shown the recipient must ascertain the dimension specifically from the architect or by site measurement and may not rely on the drawing. Supply of the drawing in digital form is solely for convenience and no reliance may be placed on any data in digital form. All data must be checked against hard copy. This drawing is issued for design intent only and should not be used for construction unless stated. This drawing is the property of SPACEMAN

1:25 @ A3

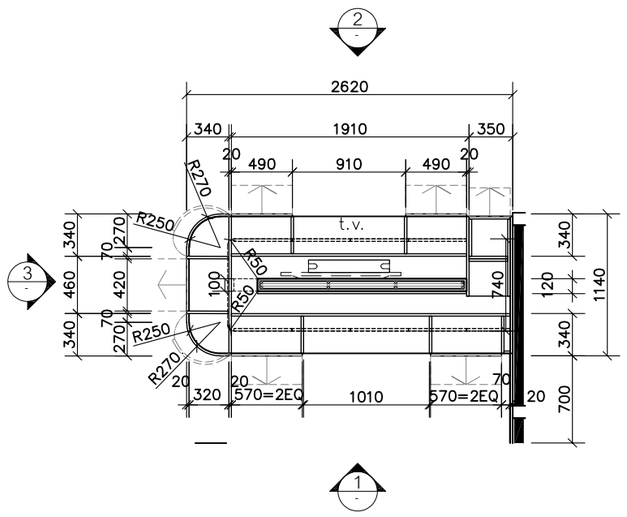

แบบขยาย ตู้หน้า,TV (ภายใน)
บริเวณ โซนห้องนั่งเล่น
PLAN

SCALE 1:50

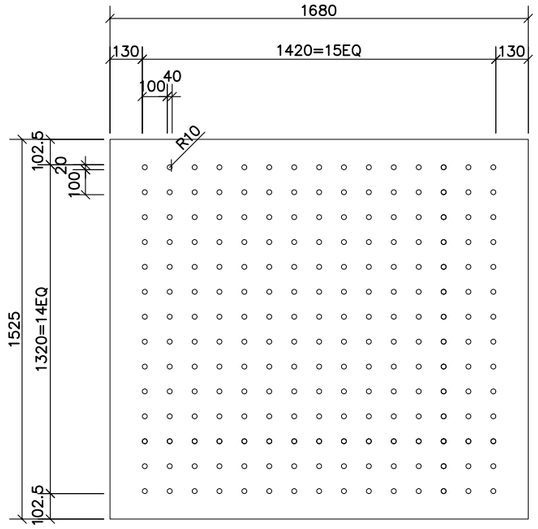

แบบขยาย ตู้หน้า,TV (ภายใน)
บริเวณ โซนห้องนั่งเล่น
ELEVATION DETAIL1

SCALE 1:25

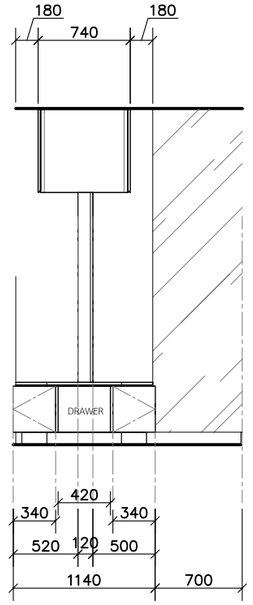

แบบขยาย ตู้หน้า,TV (ภายใน)
บริเวณ โซนห้องนั่งเล่น
ELEVATION 02

SCALE 1:50

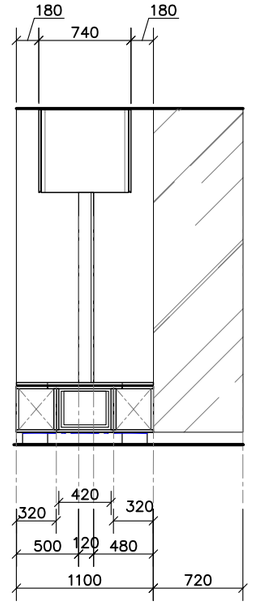

แบบขยาย ตู้หน้า,TV (ภายใน)
บริเวณ โซนห้องนั่งเล่น
ELEVATION 02

SCALE 1:50

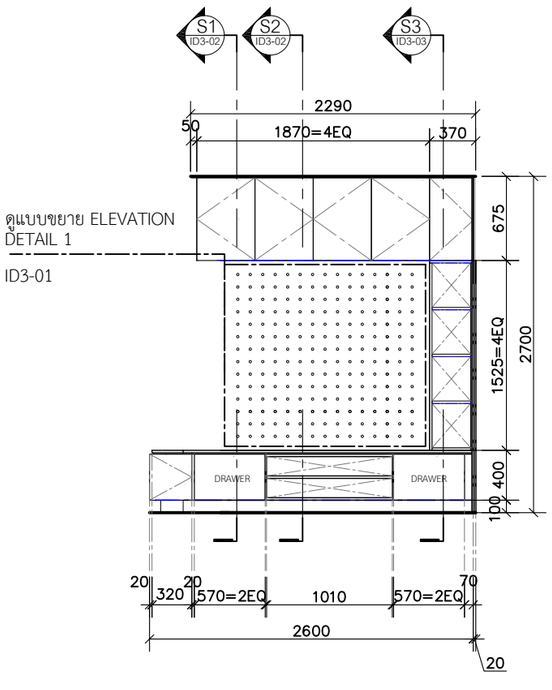

แบบขยาย ตู้หน้า,TV (ภายใน)
บริเวณ โซนห้องนั่งเล่น
ELEVATION 02

SCALE 1:50

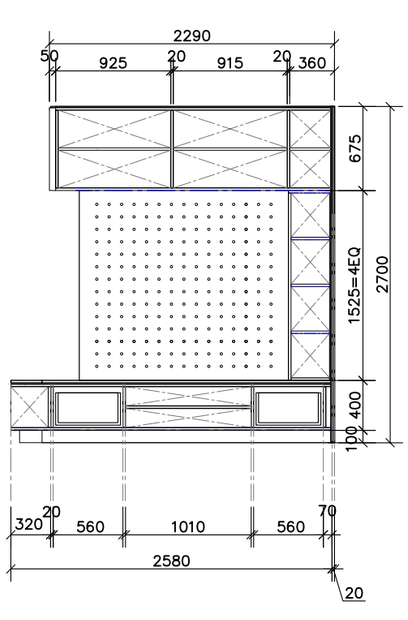

แบบขยาย ตู้หน้า,TV (ภายใน)
บริเวณ โซนห้องนั่งเล่น
ELEVATION 02

SCALE 1:50

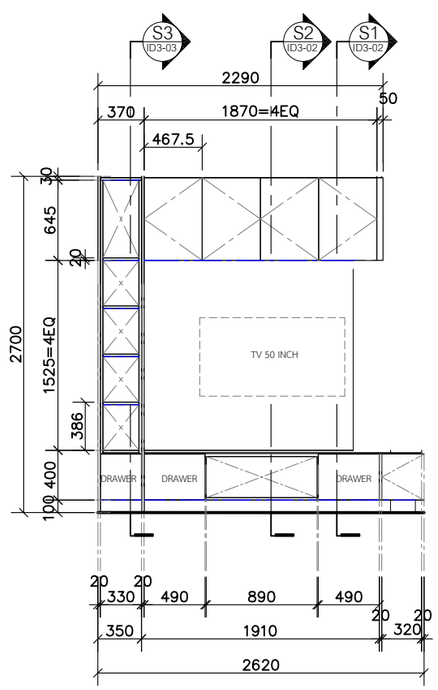

แบบขยาย ตู้หน้า,TV (ภายใน)
บริเวณ โซนห้องนั่งเล่น
ELEVATION 02

SCALE 1:50

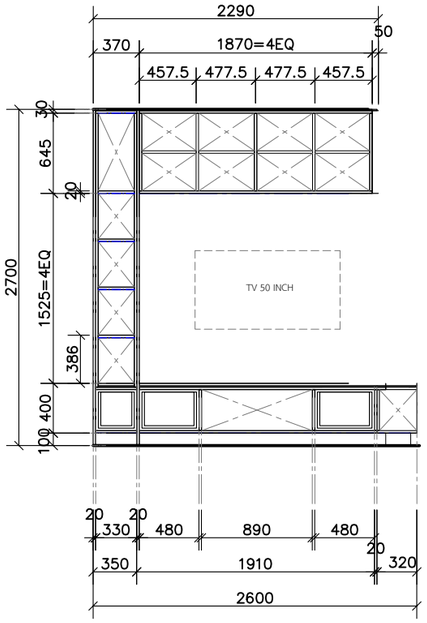

แบบขยาย ตู้หน้า,TV (ภายใน)
บริเวณ โซนห้องนั่งเล่น
ELEVATION 02

SCALE 1:50

SPACEMAN

PROJECT: SONIA HOUSE

LOCATION: REIGNWOOD PARK
LAMLUKKA, PATHUM THANI

ARCHITECT:

INTERIOR DESIGNER: ปรัตถกร ประมุขกุล ภ-สน 1438

STRUCTURAL ENGINEER:

TITLE: 1st FLOOR
แบบขยาย ตู้หน้า TV
PLAN ,ELEVATION

2026-03-13
ID3-01
1:50 @ A3

Note: SPACEMAN takes no responsibility for dimensions obtained by scaling from this drawing. If no dimension is shown the recipient must ascertain the dimension specifically from the architect or by site measurement and may not rely on the drawing. Supply of the drawing in digital form is solely for convenience and no reliance may be placed on any data in digital form. All data must be checked against hard copy. This drawing is issued for design intent only and should not be used for construction unless stated. This drawing is the property of SPACEMAN

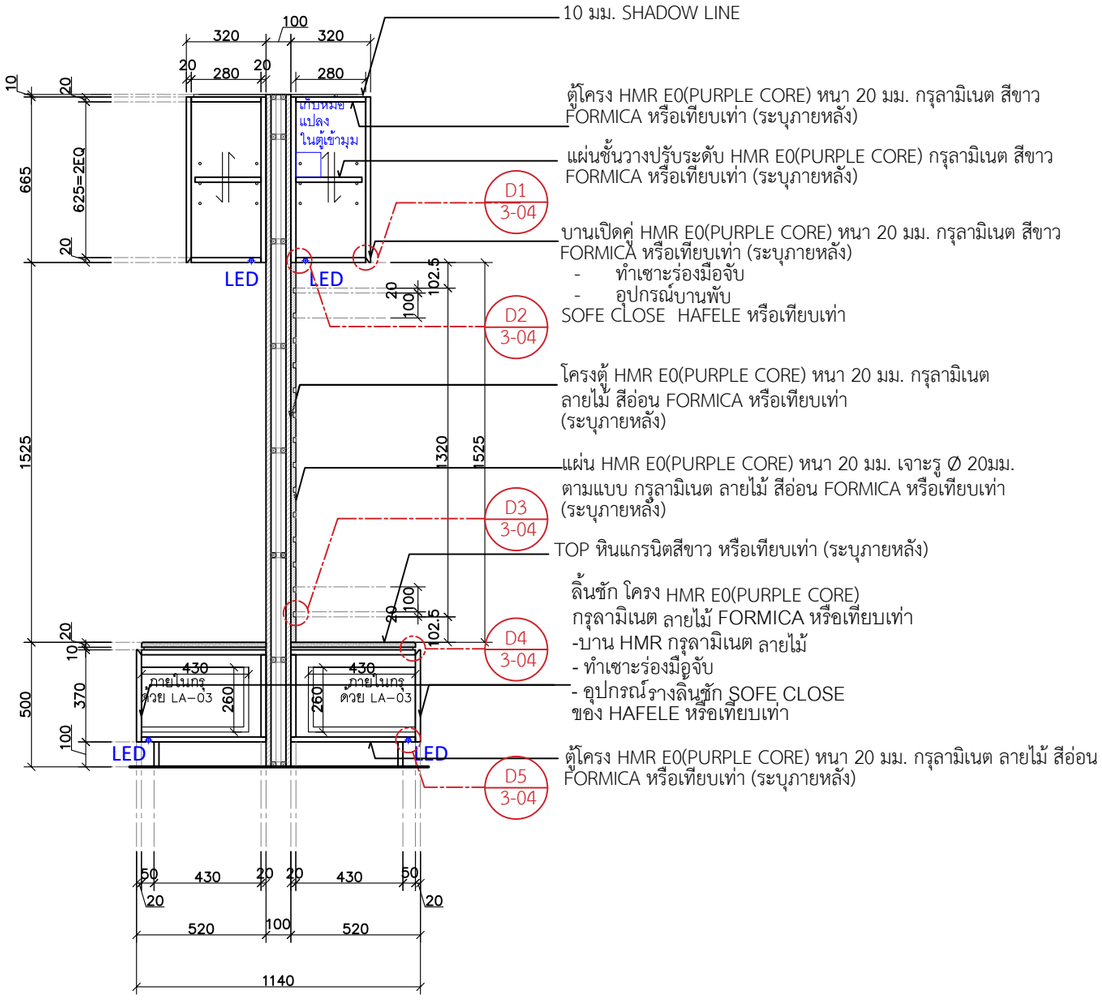

แบบขยาย ตู้หน้า TV (ภายใน)
บริเวณโซนห้องนั่งเล่น
SECTION 1
scale 1:25

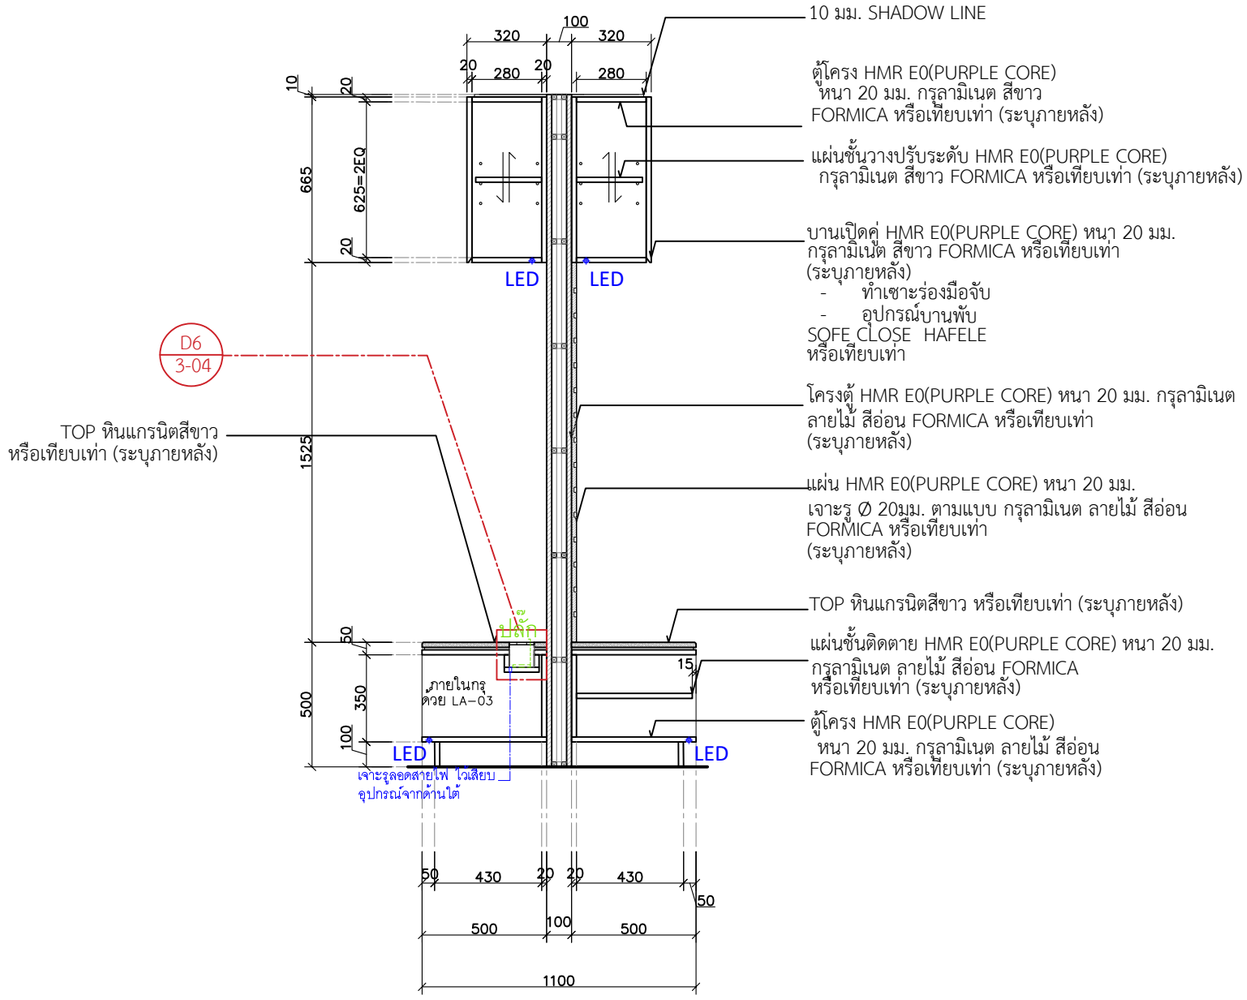

แบบขยาย ตู้หน้า TV (ภายใน)
บริเวณโซนห้องนั่งเล่น
SECTION 2
scale 1:25

SPACEMAN

PROJECT: SONIA HOUSE
LOCATION: REIGNWOOD PARK LAMLUKKA, PATHUM THANI
ARCHITECT:
INTERIOR DESIGNER: ปรัตถกร ประมุขกุล ภ-สน 1438
STRUCTURAL ENGINEER:
TITLE: 1st FLOOR แบบขยาย ตู้หน้า TV ELEVATION
2026-06-18
ID3-02
1:25 @ A3

Note: SPACEMAN takes no responsibility for dimensions obtained by scaling from this drawing. If no dimension is shown the recipient must ascertain the dimension specifically from the architect or by site measurement and may not rely on the drawing. Supply of the drawing in digital form is solely for convenience and no reliance may be placed on any data in digital form. All data must be checked against hard copy. This drawing is issued for design intent only and should not be used for construction unless stated. This drawing is the property of SPACEMAN

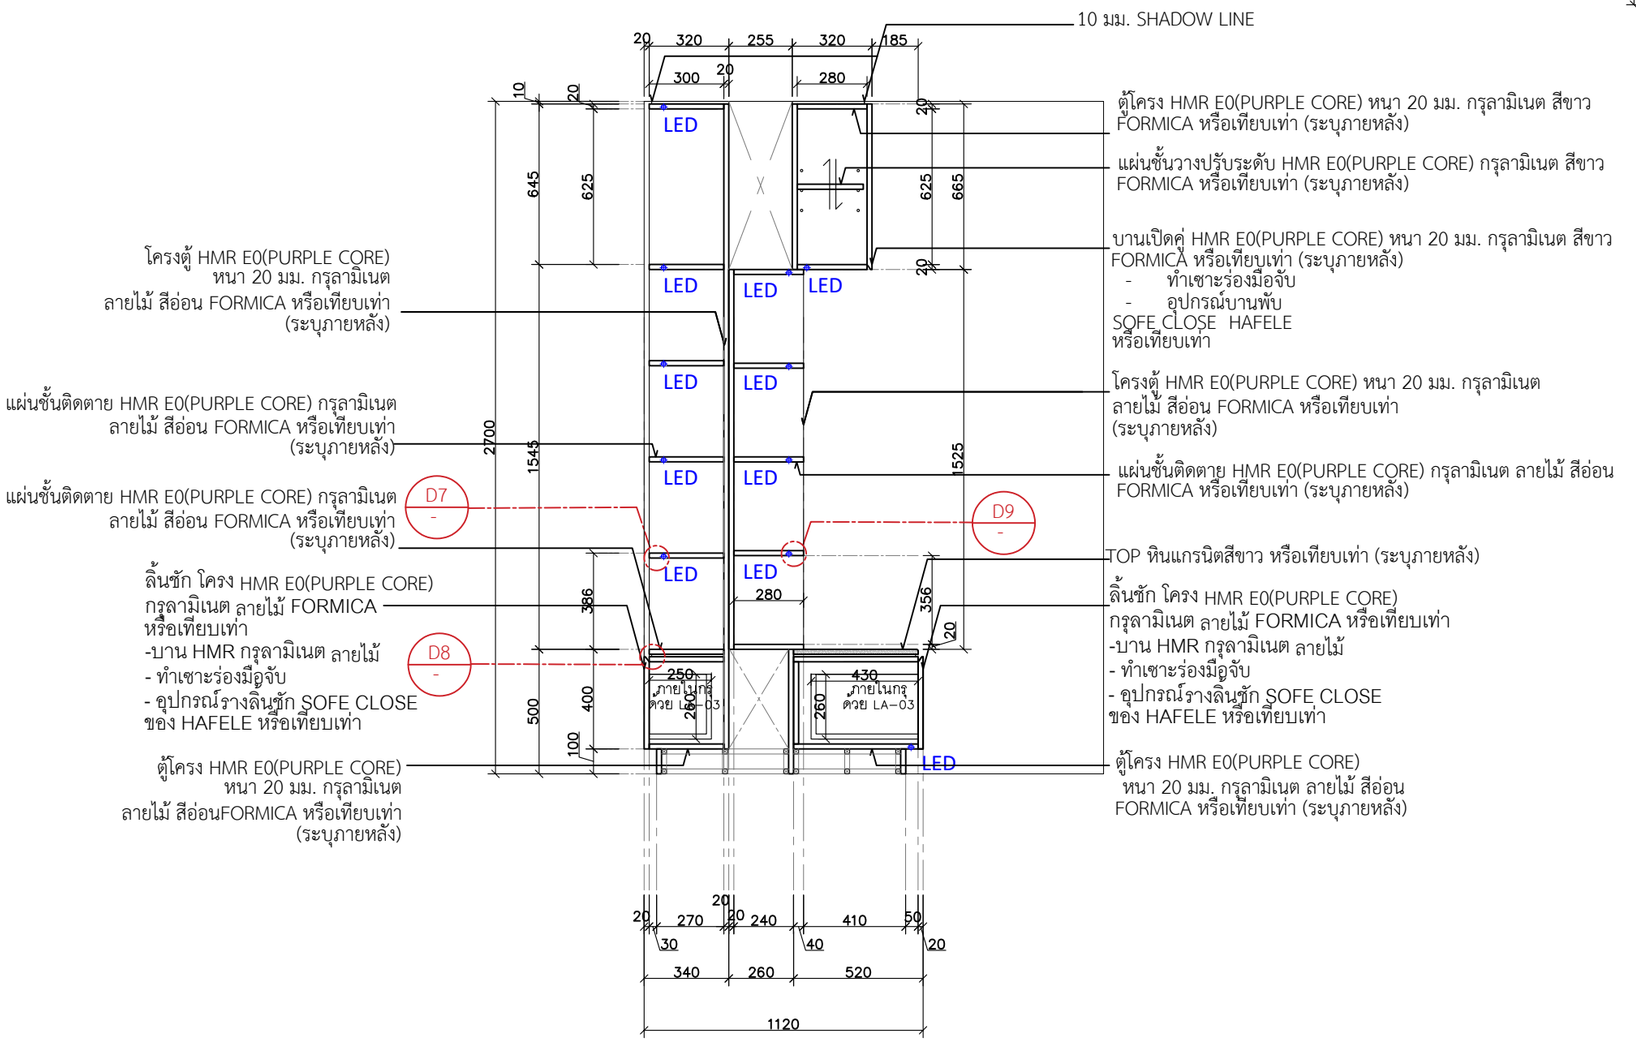

แบบขยาย ตู้หน้า TV (ภายใน)
บริเวณโซนห้องนั่งเล่น
SECTION 3
scale 1:25

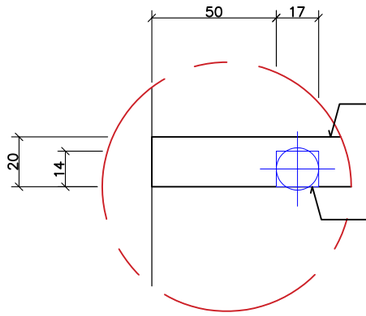

DETAIL 7
scale 1:2.5

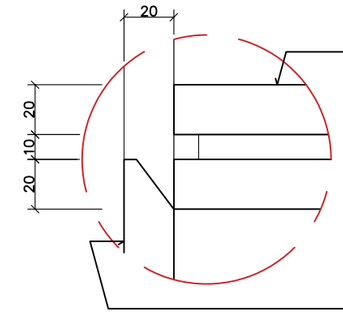

DETAIL 8
scale 1:2.5

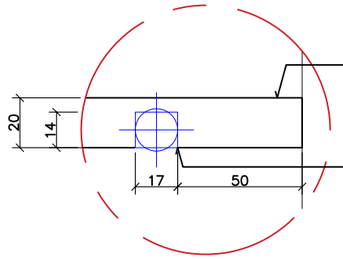

DETAIL 9
scale 1:2.5

SPACEMAN

PROJECT: SONIA HOUSE
LOCATION: REIGNWOOD PARK LAMLUKKA, PATHUM THANI
ARCHITECT:
INTERIOR DESIGNER: ปรัตถกร ประมุขกุล ภ-สน 1438
STRUCTURAL ENGINEER:
TITLE: 1st FLOOR แบบขยาย ตู้หน้า TV ELEVATION
2026-06-18
ID3-03
1:25 @ A3

Note: SPACEMAN takes no responsibility for dimensions obtained by scaling from this drawing. If no dimension is shown the recipient must ascertain the dimension specifically from the architect or by site measurement and may not rely on the drawing. Supply of the drawing in digital form is solely for convenience and no reliance may be placed on any data in digital form. All data must be checked against hard copy. This drawing is issued for design intent only and should not be used for construction unless stated. This drawing is the property of SPACEMAN

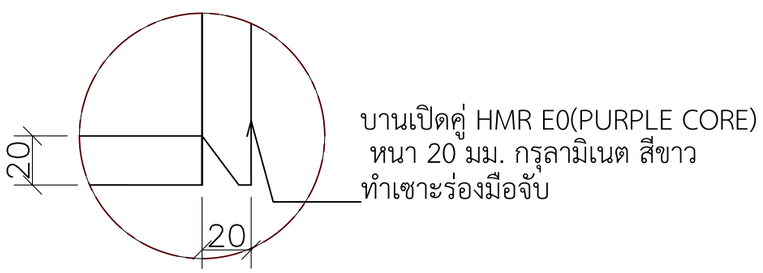

DETAIL 1
IN SCALE 1:2.5

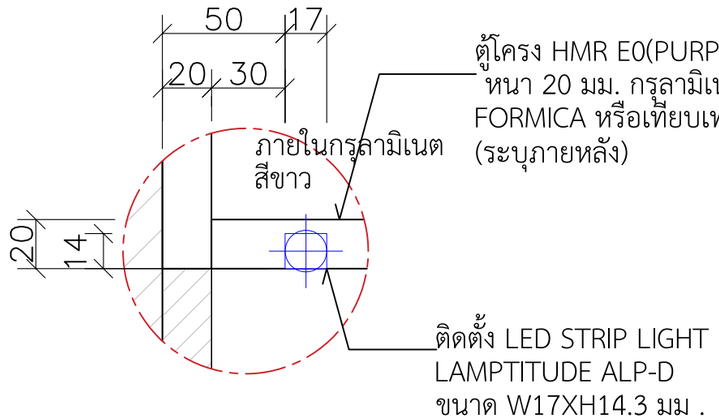

DETAIL 2
IN SCALE 1:2.5

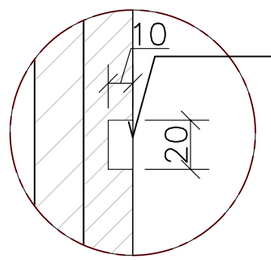

DETAIL 3
IN SCALE 1:2.5

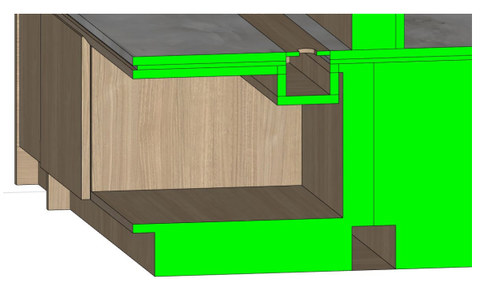

รูปภาพประกอบ สำหรับ DETAIL 6

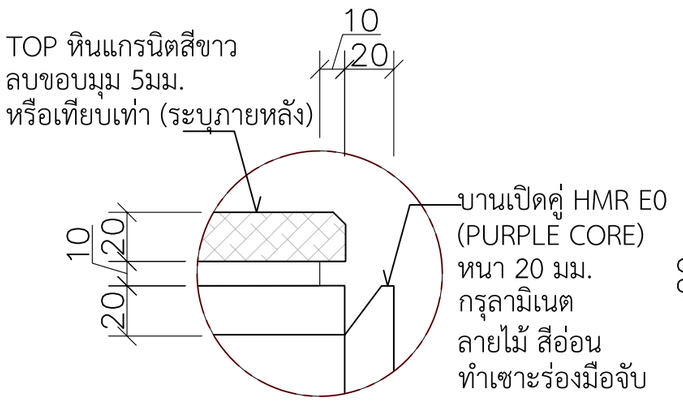

DETAIL 4
IN SCALE 1:2.5

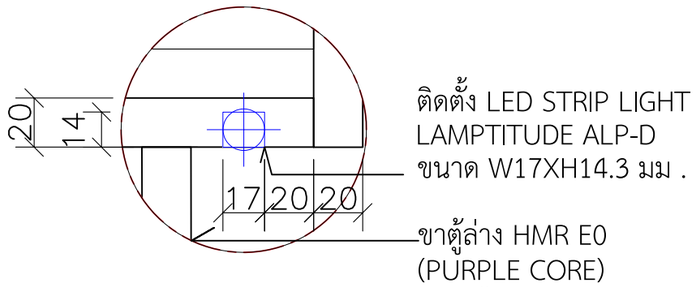

DETAIL 5
IN SCALE 1:2.5

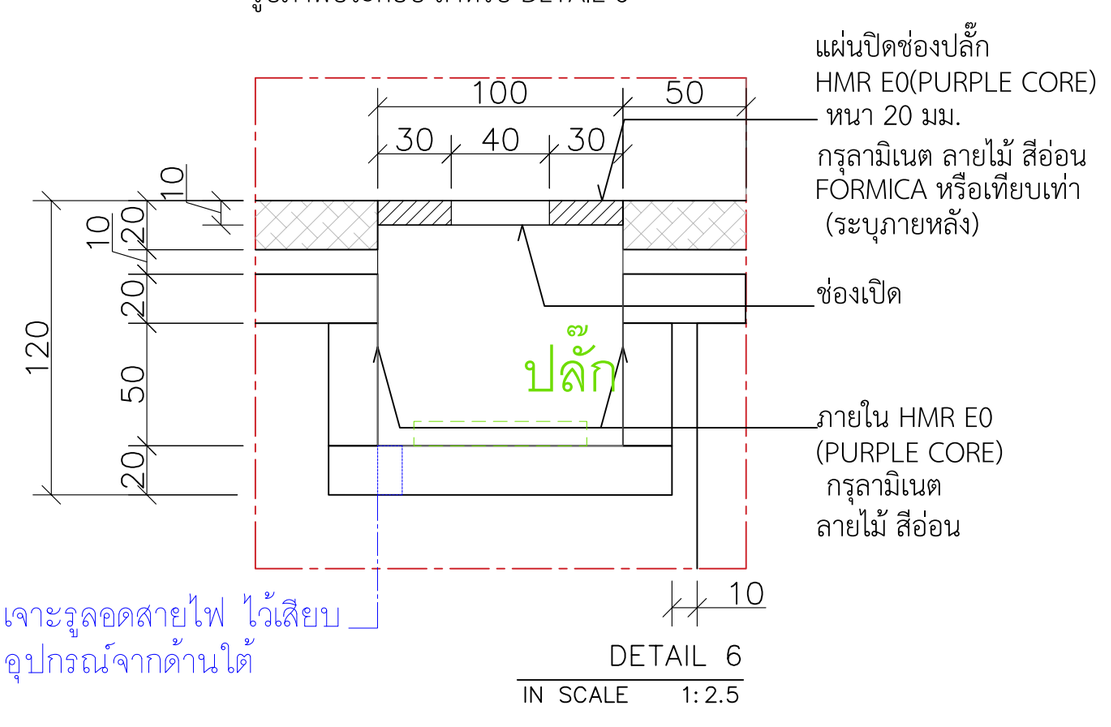

DETAIL 6
IN SCALE 1:2.5

SPACEMAN

PROJECT: SONIA HOUSE
LOCATION:
ARCHITECT:
INTERIOR DESIGNER: ปรัตถกร ประมุขกุล ภ-สน 1438
STRUCTURAL ENGINEER:
TITLE: 1st FLOOR แบบขยาย ตู้หน้า TV DETAIL

2026-05-26
ID3-04
1:10 @ A3

Note: SPACEMAN takes no responsibility for dimensions obtained by scaling from this drawing. If no dimension is shown the recipient must ascertain the dimension specifically from the architect or by site measurement and may not rely on the drawing. Supply of the drawing in digital form is solely for convenience and no reliance may be placed on any data in digital form. All data must be checked against hard copy. This drawing is issued for design intent only and should not be used for construction unless stated. This drawing is the property of SPACEMAN

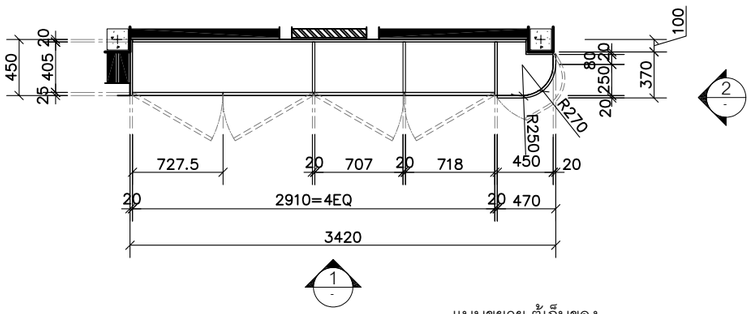

แบบขยาย ตู้เก็บของ
บริเวณ โซนห้องนั่งเล่น
PLAN
SCALE 1:50

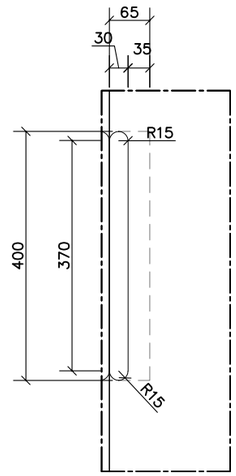

บริเวณ โซนห้องนั่งเล่น
ELEVATION DETAIL 01
SCALE 1:10

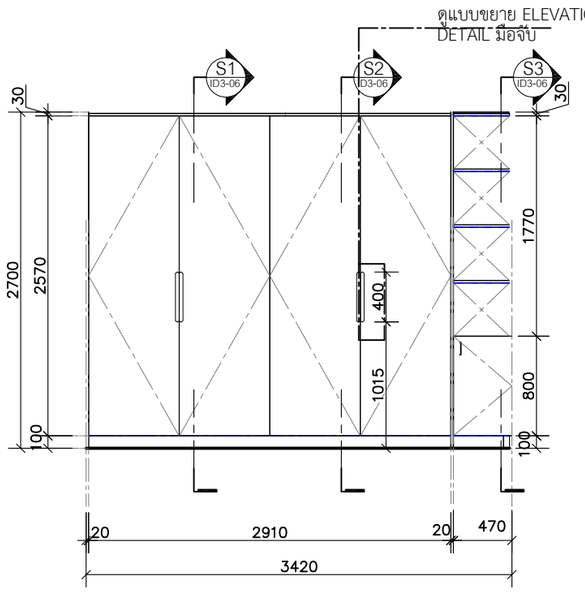

แบบขยาย ตู้เก็บของ
บริเวณ โซนห้องนั่งเล่น
ELEVATION 01
SCALE 1:50

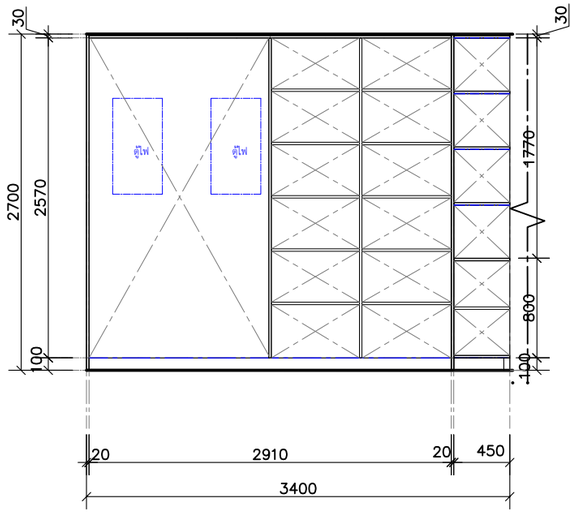

แบบขยาย ตู้เก็บของ (ภายใน)
บริเวณ โซนห้องนั่งเล่น
ELEVATION 01
SCALE 1:50

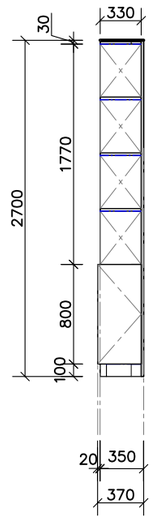

แบบขยาย ตู้เก็บของ
บริเวณ โซนห้องนั่งเล่น
ELEVATION 02
SCALE 1:50

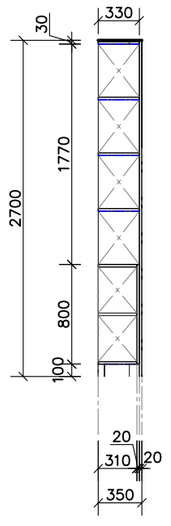

แบบขยาย ตู้เก็บของ (ภายใน)
บริเวณ โซนห้องนั่งเล่น
ELEVATION 02
SCALE 1:50

SPACEMAN

PROJECT: SONIA HOUSE

LOCATION: REIGNWOOD PARK
LAMLUKKA, PATHUM THANI

ARCHITECT:

INTERIOR DESIGNER: ปรัตถกร ประมุขกุล ภ-สน 1438

STRUCTURAL ENGINEER:

TITLE: 1st FLOOR
แบบขยาย ตู้เก็บของ
PLAN ,ELEVATION

2026-03-13
ID3-05
1:50 @ A3

Note: SPACEMAN takes no responsibility for dimensions obtained by scaling from this drawing. If no dimension is shown the recipient must ascertain the dimension specifically from the architect or by site measurement and may not rely on the drawing. Supply of the drawing in digital form is solely for convenience and no reliance may be placed on any data in digital form. All data must be checked against hard copy. This drawing is issued for design intent only and should not be used for construction unless stated. This drawing is the property of SPACEMAN

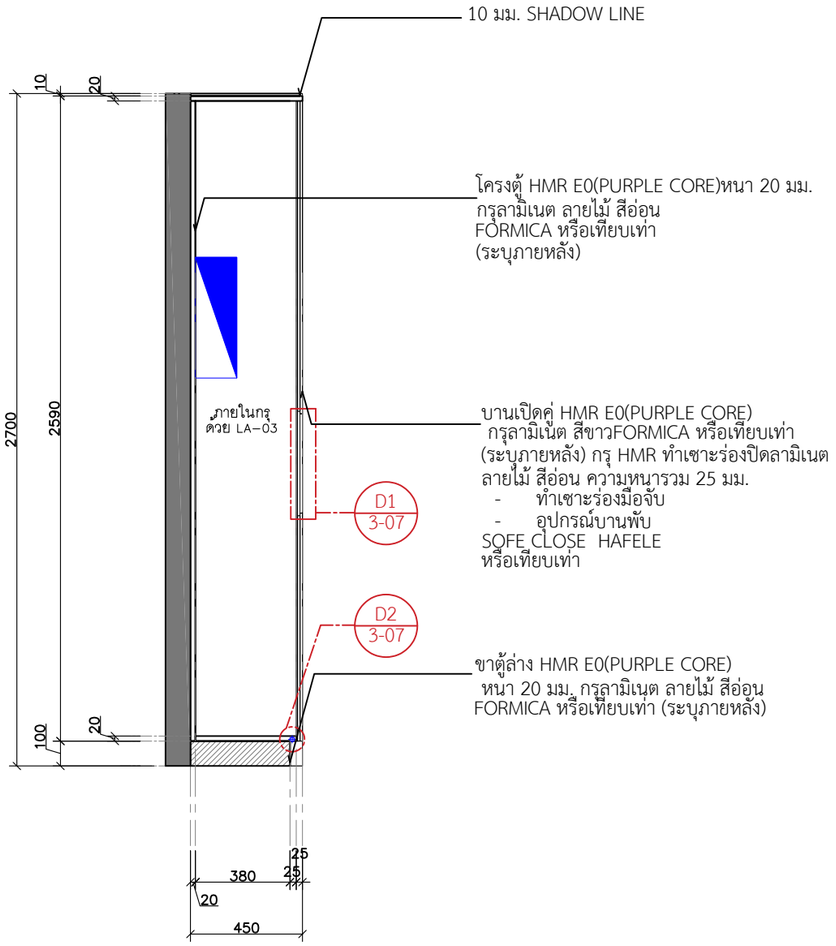

แบบขยาย ตู้เก็บของ
บริเวณโซนห้องนั่งเล่น
SECTION 1

scale 1:25

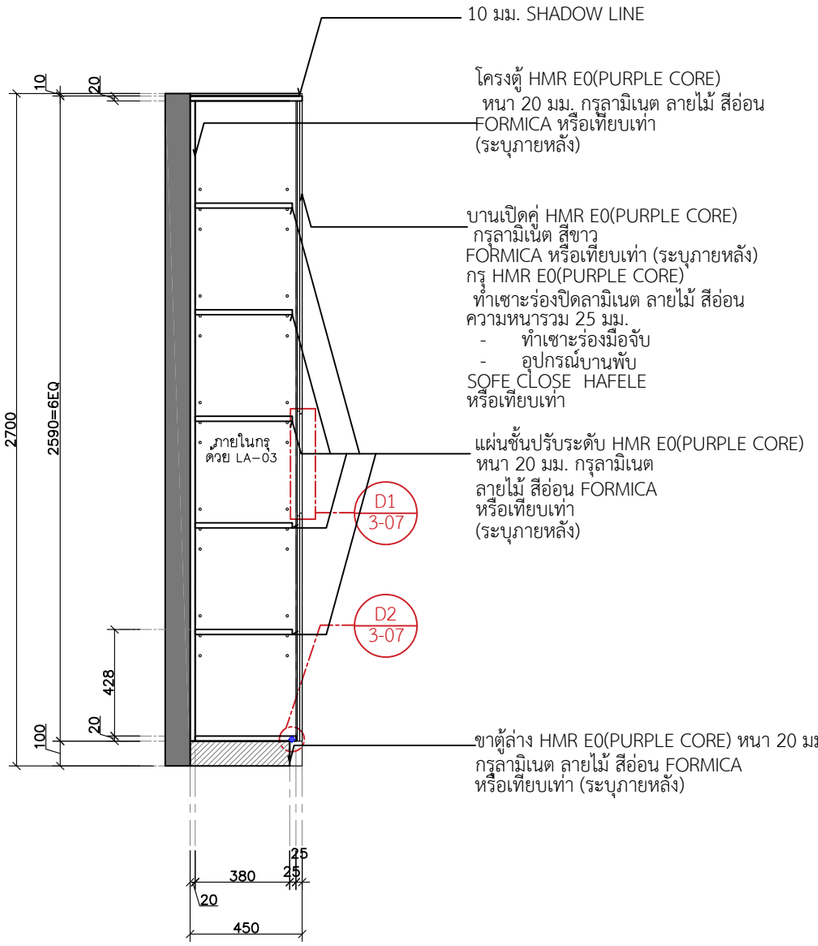

แบบขยาย ตู้เก็บของ
บริเวณโซนห้องนั่งเล่น
SECTION 2

scale 1:25

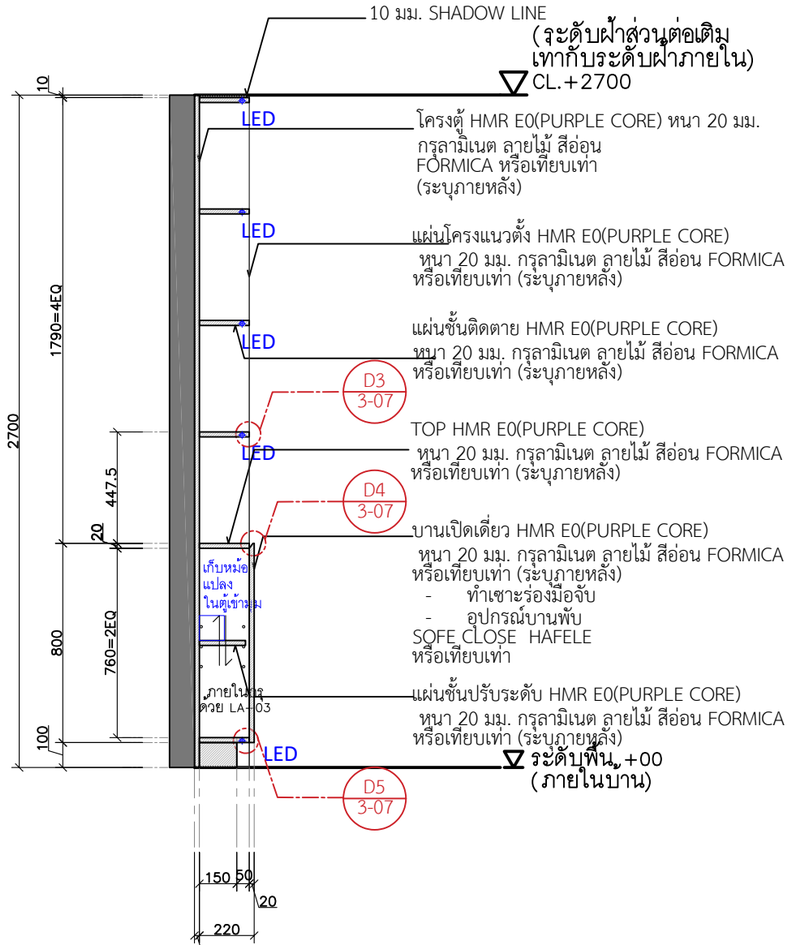

แบบขยาย ตู้เก็บของ
บริเวณโซนห้องนั่งเล่น
SECTION 3

scale 1:25

SPACEMAN	PROJECT SONIA HOUSE	LOCATION REIGNWOOD PARK LAMLUKKA, PATHUM THANI	ARCHITECT	INTERIOR DESIGNER ปรัตถกร ประมุขกุล ภ-สน 1438	STRUCTURAL ENGINEER	TITLE 1st FLOOR ELEVATION แบบขยายตู้เก็บของ	2026-06-18 ID3-06

Note: SPACEMAN takes no responsibility for dimensions obtained by scaling from this drawing. If no dimension is shown the recipient must ascertain the dimension specifically from the architect or by site measurement and may not rely on the drawing. Supply of the drawing in digital form is solely for convenience and no reliance may be placed on any data in digital form. All data must be checked against hard copy. This drawing is issued for design intent only and should not be used for construction unless stated. This drawing is the property of SPACEMAN

1:25 @ A3

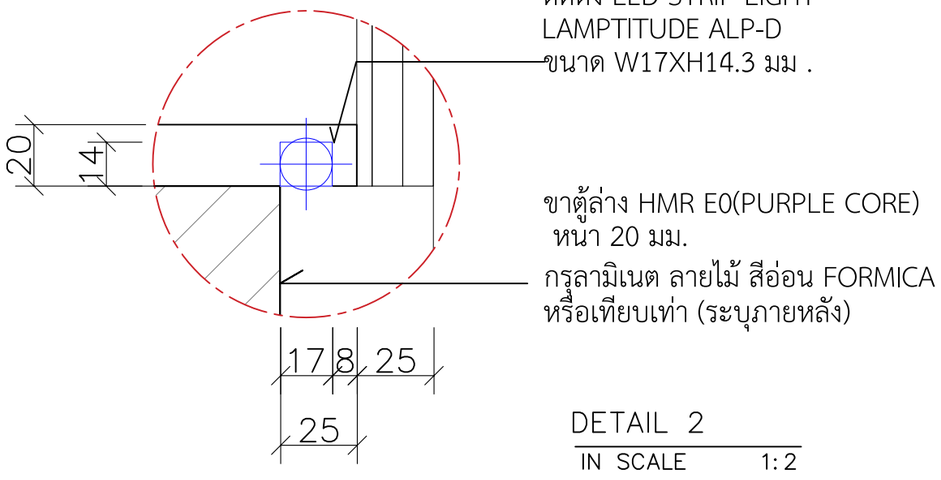

DETAIL 2
IN SCALE 1:2

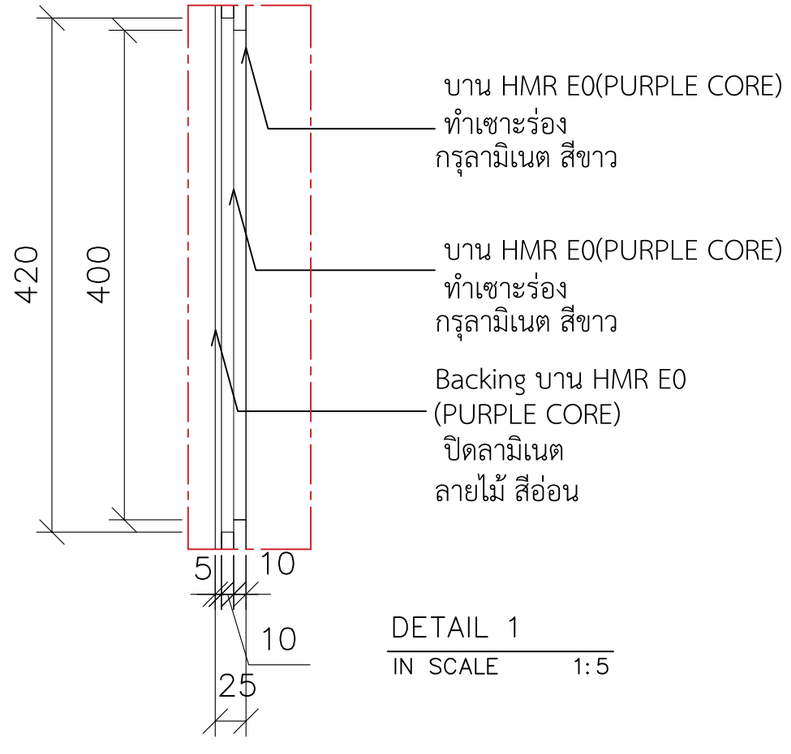

DETAIL 1
IN SCALE 1:5

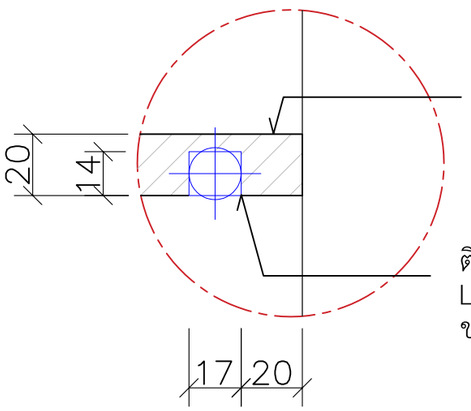

DETAIL 3
IN SCALE 1:2

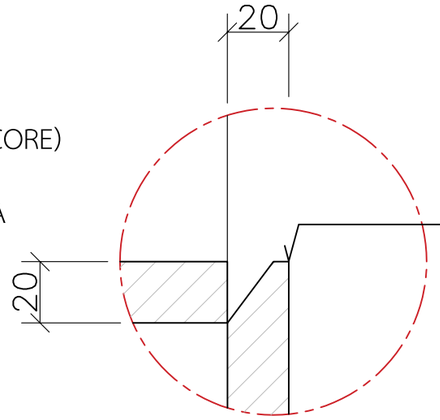

DETAIL 4
IN SCALE 1:2

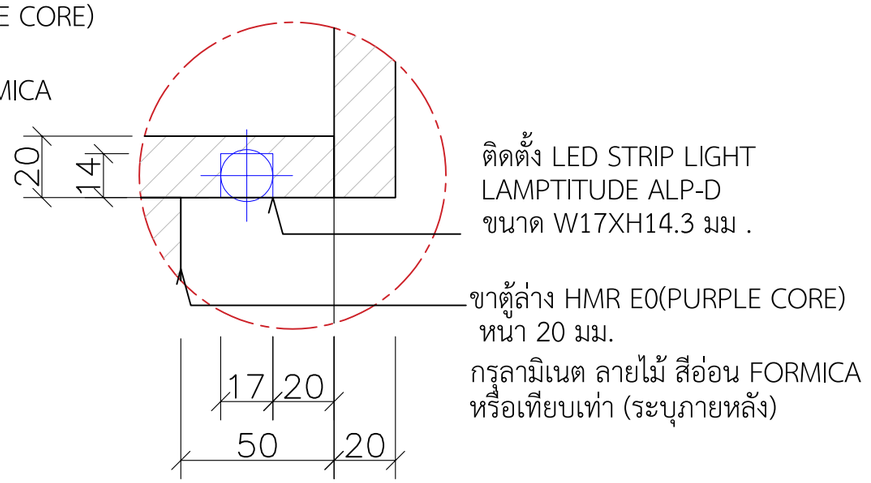

DETAIL 5
IN SCALE 1:2

SPACEMAN

PROJECT: SONIA HOUSE
LOCATION: LAMLUKKA, PATHUM THANI
ARCHITECT:
INTERIOR DESIGNER: ปรัตถกร ประมุขกุล ภ-สน 1438
STRUCTURAL ENGINEER:
TITLE: 1st FLOOR แบบขยาย ตู้เก็บของ DETAIL
2026-05-26
ID3-07
1:10 @ A3

Note: SPACEMAN takes no responsibility for dimensions obtained by scaling from this drawing. If no dimension is shown the recipient must ascertain the dimension specifically from the architect or by site measurement and may not rely on the drawing. Supply of the drawing in digital form is solely for convenience and no reliance may be placed on any data in digital form. All data must be checked against hard copy. This drawing is issued for design intent only and should not be used for construction unless stated. This drawing is the property of SPACEMAN

SONIA HOUSE

REIGNWOOD PARK

LAMLUKKA, PATHUM THANI

แบบขยายส่วนครัว

ELECTRICAL SPEC

Symbol	Description	QTY.
E1-01	เตาไฟฟ้า/ELECTROLUX เตาฝังอินดักชั่น ELECTROLUX LIB60420CK 60 ซม./ขนาด W590XD520xH48 มม./ By ELECTROLUX	1
E1-02	เครื่องดูดควัน/ ELECTROLUX ECF6214X 60 ซม./ขนาด W600XD480XH90 / By ELECTROLUX	1

KITCHEN SPEC

Symbol	Description	QTY.
K1-01	อ่างล้างจานฝัง 1 หลุม AXIA รุ่น MIDNIGHT 6050 ขนาด 60 ซม. สีดำ/ขนาด W600XD500 มม. / By ไทวัสดุ	1

REFLECTED CEILING LEGEND

Symbol	Description	
XXX 0000	ประเภทฝ้าเพดาน ระดับความสูงฝ้าเพดาน	
CL 1	แผ่นยิปซัมมอยส์บล็อค ตราช้าง (ทนชื้น) ขอบลาด 9 มม 1200x2400 มม	RONA-G-GU10 -WW-FR
LT-01	โคมไฟดาวน์ไลท์ แบบฝังฝ้าเพดาน / โคมสีขาว /ติดตั้งบนฝ้าเพดาน By LAMPTITUDE ติดต่อ: -	
LED	LED Strip light (ไฟซ่อน) By LAMPTITUDE ติดต่อ: -	ALP-D 3M
S	สวิตซ์ไฟทางเดียว	

Remark :

• ตำแหน่งการติดตั้งสวิตช์และเต้ารับต่างๆให้ดูในแบบรูปด้าน หากตำแหน่งการติดตั้ง
ในแบบกับหน้างานมีความขัดแย้งกันให้ผู้รับจ้างติดต่อกับผู้ออกแบบเพื่อหาข้อสรุป

• การติดตั้งและการเชื่อมต่อให้อ้างอิงกับแบบงานระบบหากแบบมีความขัดแย้งกับ
หน้างานให้ผู้รับจ้างแจ้งกับผู้ออกแบบเพื่อดำเนินการแก้ไข

LAMINATE

CODE		Description
LA-01	ประเภท	ลามิเนต
	รหัส	*ระบุสเปคสีภายหลัง
	สี / ขนาด	ขาว
	ผู้ผลิต	FORMICA ติดต่อ: -
LA-02	ประเภท	ลามิเนต
	รหัส	*ระบุสเปคสีภายหลัง
	สี / ขนาด	ลายไม้
	ผู้ผลิต	FORMICA ติดต่อ: -

PAINT / SPRAY PAINT

CODE		Description
PT-02	ประเภท	สีทาภายใน
	รหัส	-
	สี / ขนาด	ทาสีซุปเปอร์ชิลด์ สีน้ำอะคริลิกชนิดกึ่งเงา สีขาว (ระบุเฉดสีภายหลัง)
	ผู้ผลิต	TOA ติดต่อ: -

STONE / MABLE

CODE		Description
ST-01	ประเภท	หินอ่อน
	รหัส	หินอ่อน/SILATAK CHOMPU PHRAN KATIA (หรือเทียบเท่า)
	สี / ขนาด	สีเทาชมพู
	ผู้ผลิต	Siamtak ติดต่อ: -

SKIRTING

CODE		Description
SK-01	ประเภท	บัวผนัง
	รหัส	-
	สี / ขนาด	สีขาว
	ผู้ผลิต	Contractor ติดต่อ: -

SPACEMAN

PROJECT: SONIA HOUSE

LOCATION: REIGNWOOD PARK LAMLUKKA, PATHUM THANI

ARCHITECT:

INTERIOR DESIGNER: ปรัตถกร ประมุขกุล ภ-สน 1438

STRUCTURAL ENGINEER:

TITLE: 1st floor LEGEND DESCRIPTION / LIST OF MATERIALS (แบบขยายครัว)

2026-05-06
ID0-00

Note: SPACEMAN takes no responsibility for dimensions obtained by scaling from this drawing. If no dimension is shown the recipient must ascertain the dimension specifically from the architect or by site measurement and may not rely on the drawing. Supply of the drawing in digital form is solely for convenience and no reliance may be placed on any data in digital form. All data must be checked against hard copy. This drawing is issued for design intent only and should not be used for construction unless stated. This drawing is the property of SPACEMAN

1:25 @ A3

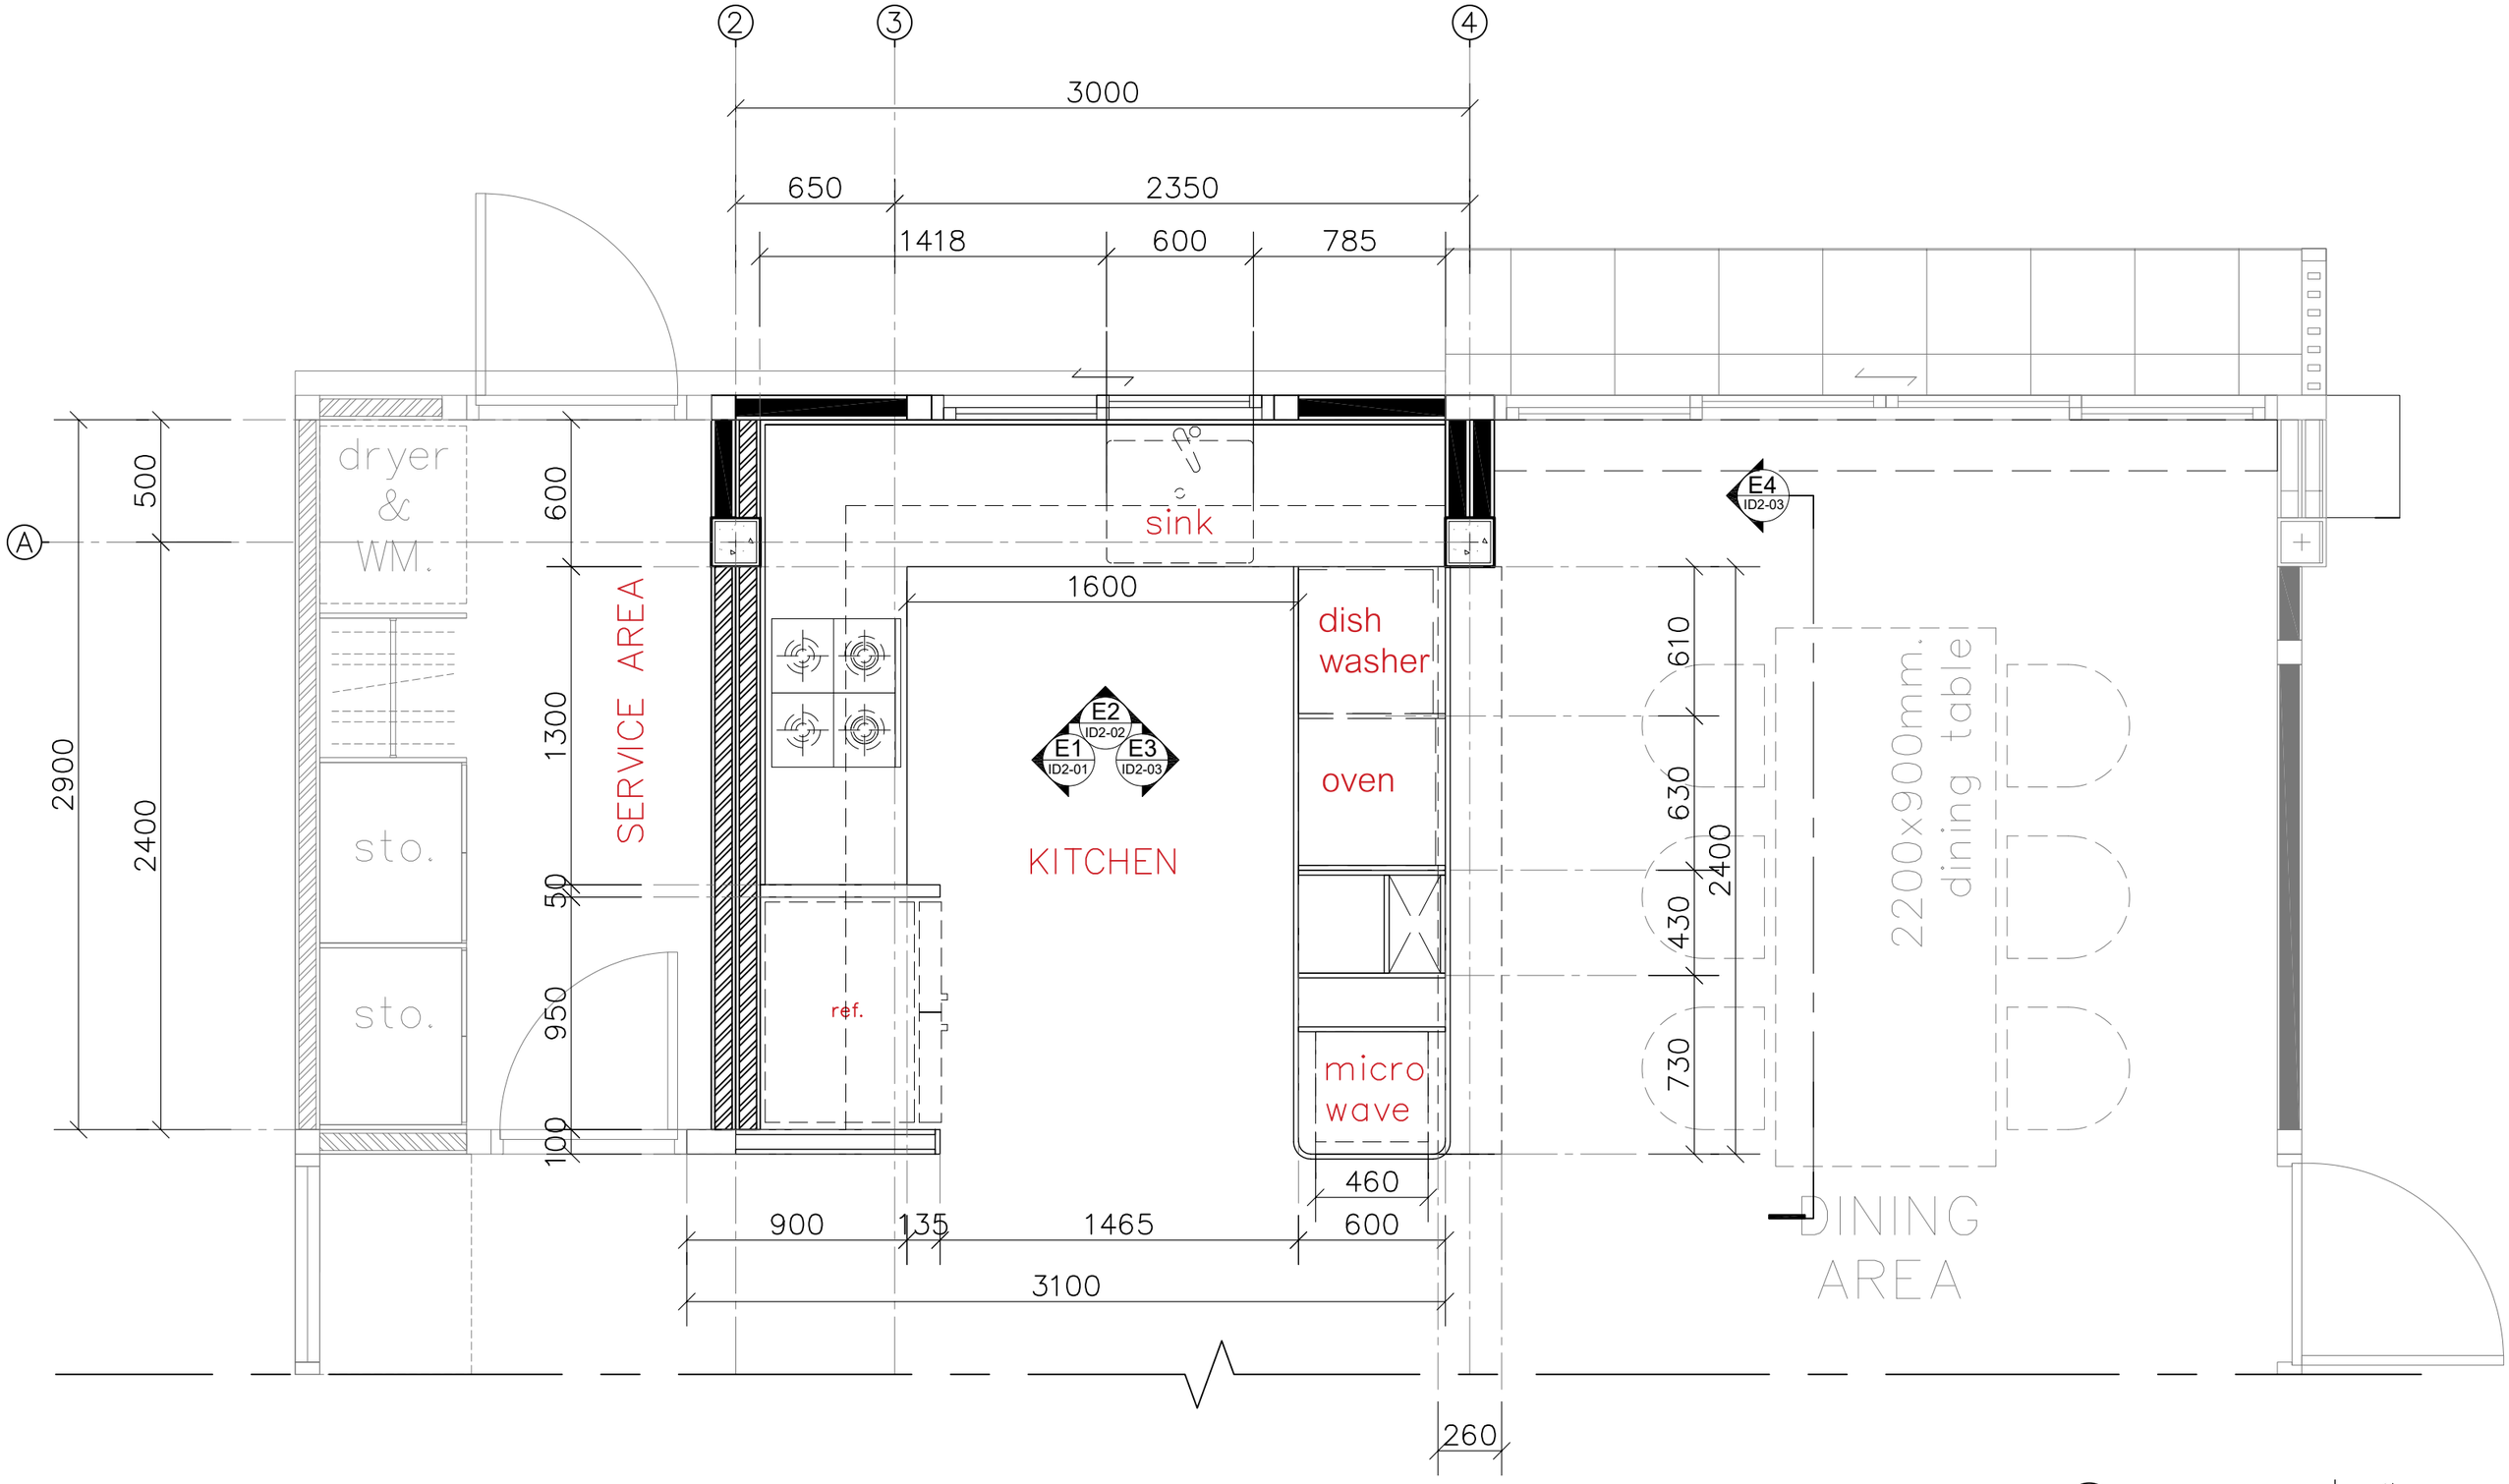

KEYPLAN (แบบขยายส่วนครัว)
scale 1:25

SPACEMAN

PROJECT | SONIA HOUSE

LOCATION | REIGNWOOD PARK
LAMLUKKA, PATHUM THANI

ARCHITECT

INTERIOR DESIGNER | ปรัตถกร ประมุขกุล ภ-ศน 1438

STRUCTURAL ENGINEER

TITLE | 1st FLOOR
KEY PLAN
(แบบขยายครัว)

2026-05-06
ID1-01

1:25 @ A3

Note: SPACEMAN takes no responsibility for dimensions obtained by scaling from this drawing. If no dimension is shown the recipient must ascertain the dimension specifically from the architect or by site measurement and may not rely on the drawing. Supply of the drawing in digital form is solely for convenience and no reliance may be placed on any data in digital form. All data must be checked against hard copy. This drawing is issued for design intent only and should not be used for construction unless stated. This drawing is the property of SPACEMAN

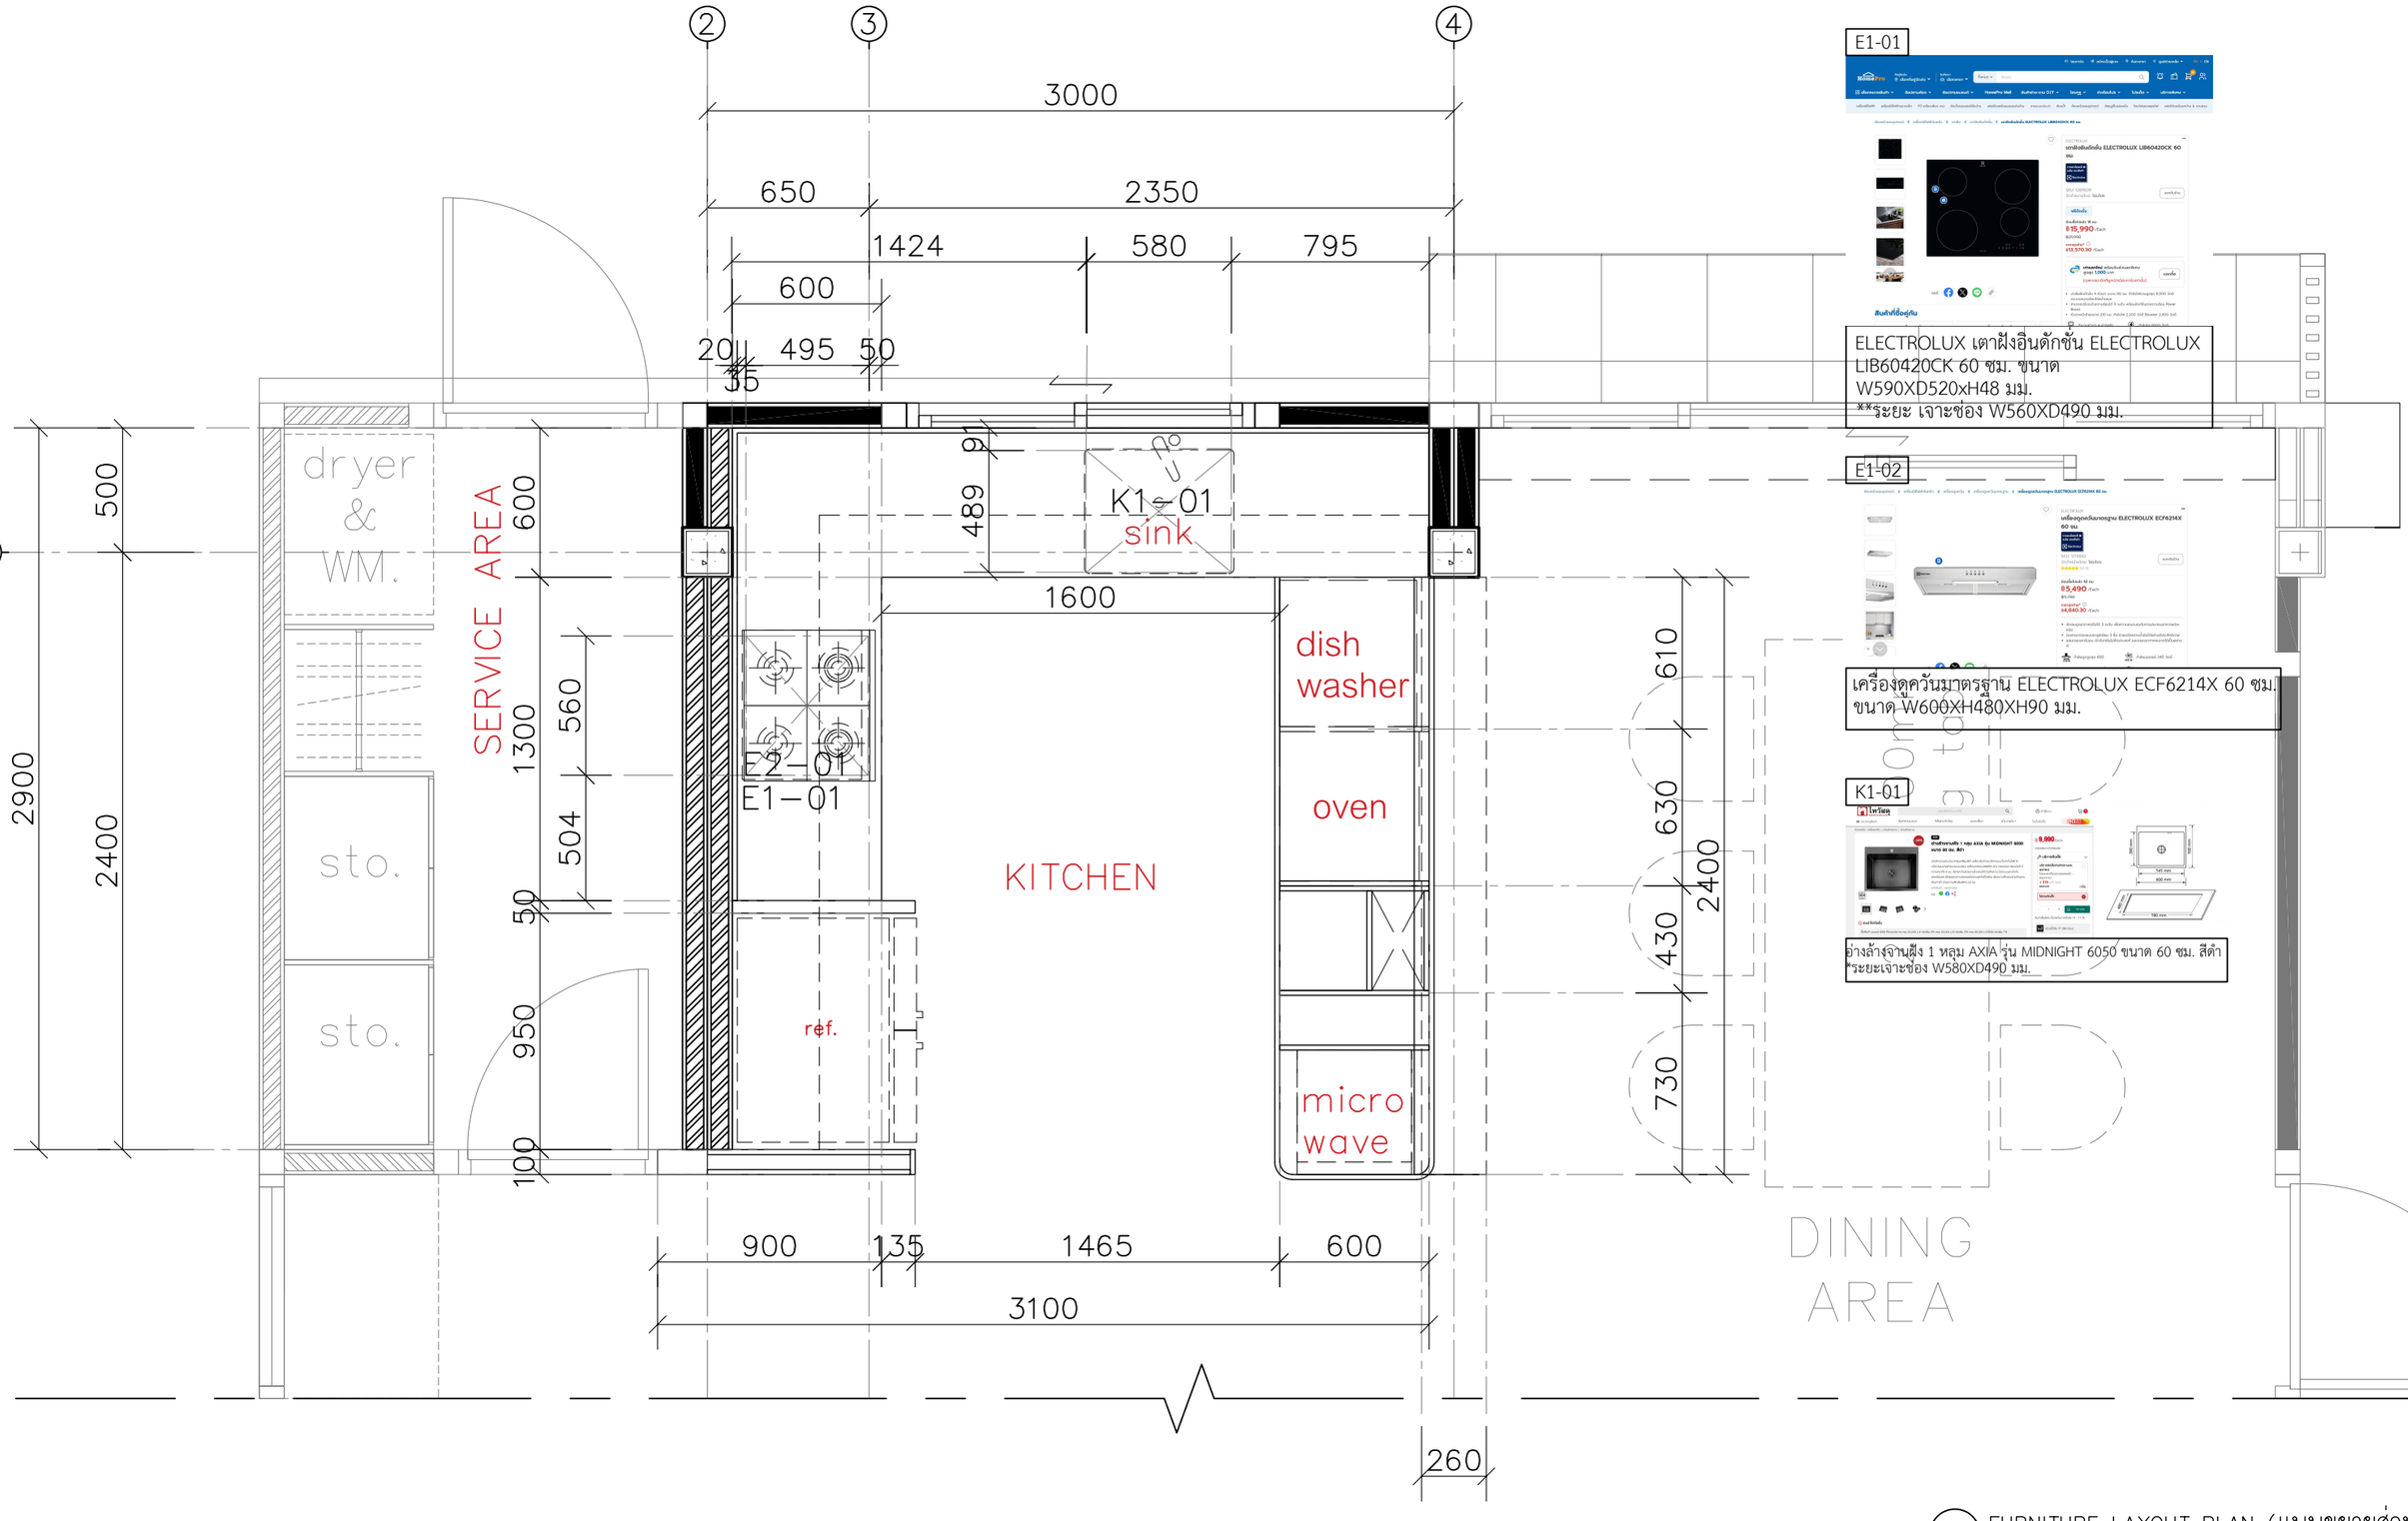

E1-01

ELECTROLUX เตาฝังอินดักชั่น ELECTROLUX LIB60420CK 60 ซม. ขนาด W590XD520xH48 มม.
**ระยะ เจาะช่อง W560XD490 มม.

E1-02

เครื่องดูดควันมาตรฐาน ELECTROLUX ECF6214X 60 ซม. ขนาด W600XH480XH90 มม.

K1-01

อ่างล้างจานตั้ง 1 หลุม AXIA รุ่น MIDNIGHT 6050 ขนาด 60 ซม. สีดำ
*ระยะเจาะช่อง W580XD490 มม.

FURNITURE LAYOUT PLAN (แบบขยายส่วนครัว)
scale 1:25

SPACEMAN	PROJECT: SONIA HOUSE	LOCATION: REIGNWOOD PARK LAMLUKKA, PATHUM THANI	ARCHITECT	INTERIOR DESIGNER: ปรัตถกร ประมุขกุล ภ-สน 1438	STRUCTURAL ENGINEER	TITLE: 1st FLOOR FURNITURE LAYOUT PLAN (แบบขยายครัว)	2026-05-06 ID1-02

Note: SPACEMAN takes no responsibility for dimensions obtained by scaling from this drawing. If no dimension is shown the recipient must ascertain the dimension specifically from the architect or by site measurement and may not rely on the drawing. Supply of the drawing in digital form is solely for convenience and no reliance may be placed on any data in digital form. All data must be checked against hard copy. This drawing is issued for design intent only and should not be used for construction unless stated. This drawing is the property of SPACEMAN

1:25 @ A3

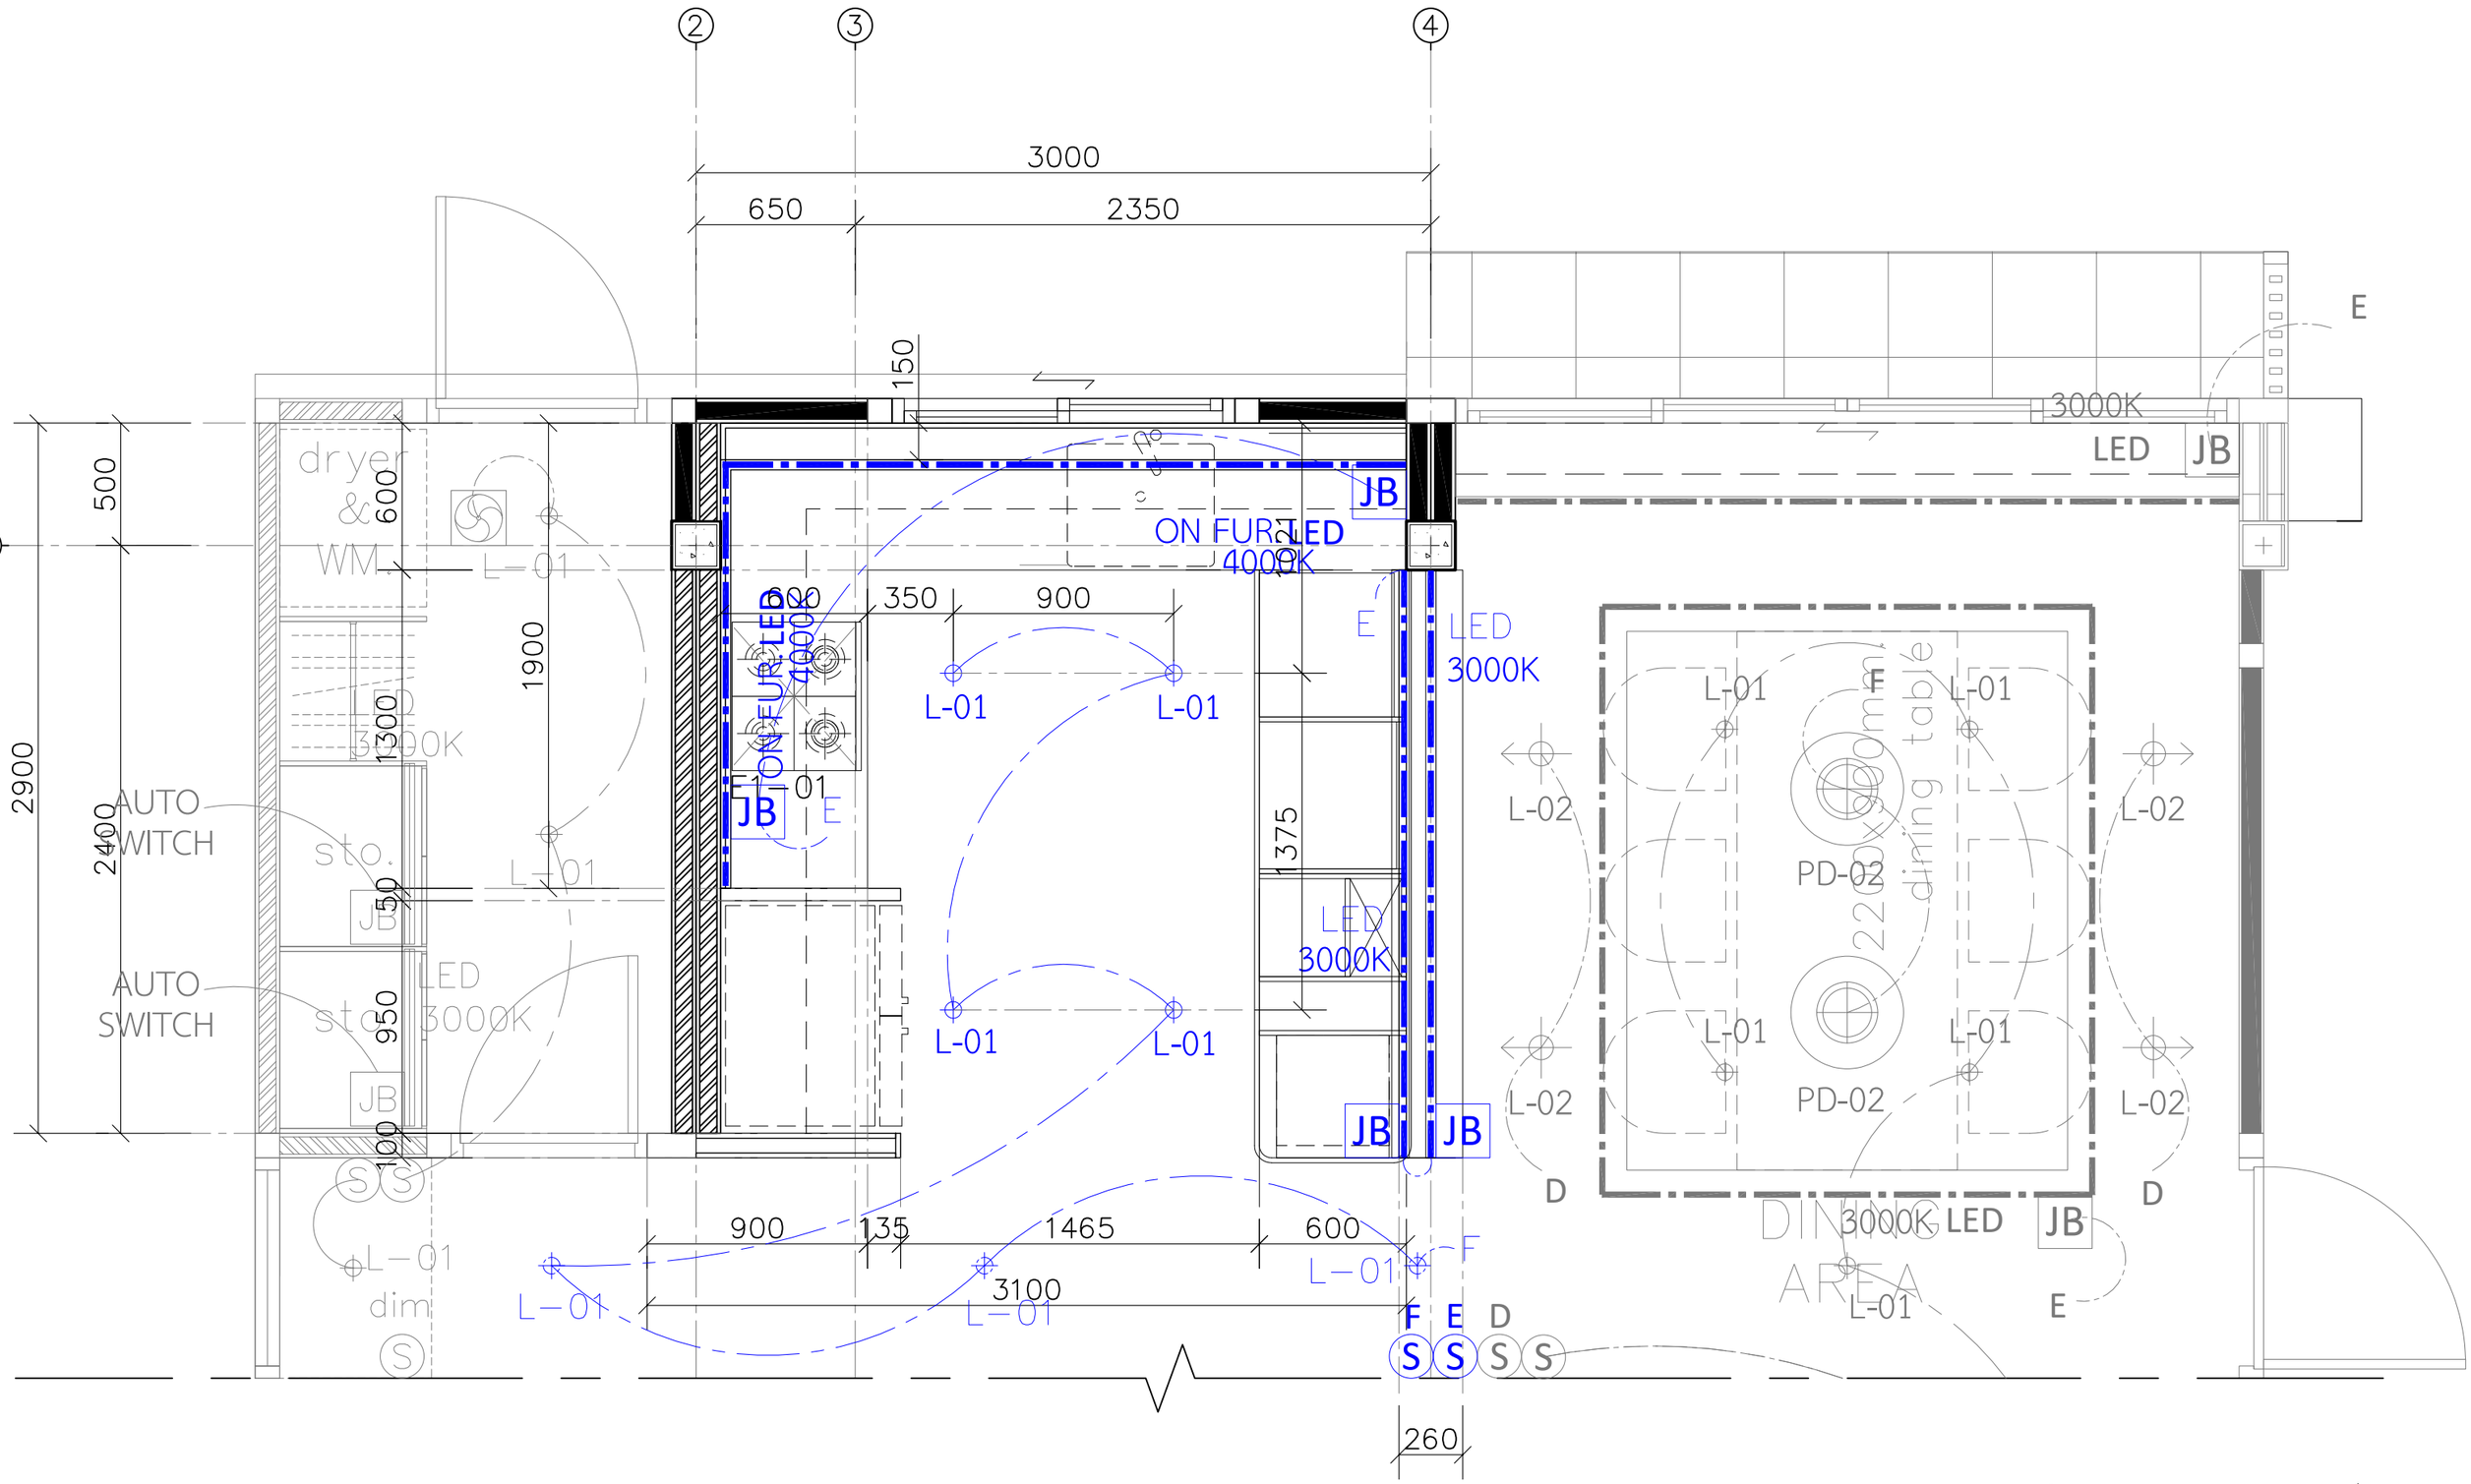

LIGHTING PLAN (แบบขยายส่วนครัว)
scale 1:25

SPACEMAN

PROJECT: SONIA HOUSE

LOCATION: REIGNWOOD PARK
LAMLUKKA, PATHUM THANI

ARCHITECT:

INTERIOR DESIGNER: ปรัตถกร ประมุขกุล ภ-สน 1438

STRUCTURAL ENGINEER:

TITLE: 1st FLOOR
LIGHTING PLAN
(แบบขยายครัว)

2026-05-06
ID1-03

1:25 @ A3

Note: SPACEMAN takes no responsibility for dimensions obtained by scaling from this drawing. If no dimension is shown the recipient must ascertain the dimension specifically from the architect or by site measurement and may not rely on the drawing. Supply of the drawing in digital form is solely for convenience and no reliance may be placed on any data in digital form. All data must be checked against hard copy. This drawing is issued for design intent only and should not be used for construction unless stated. This drawing is the property of SPACEMAN

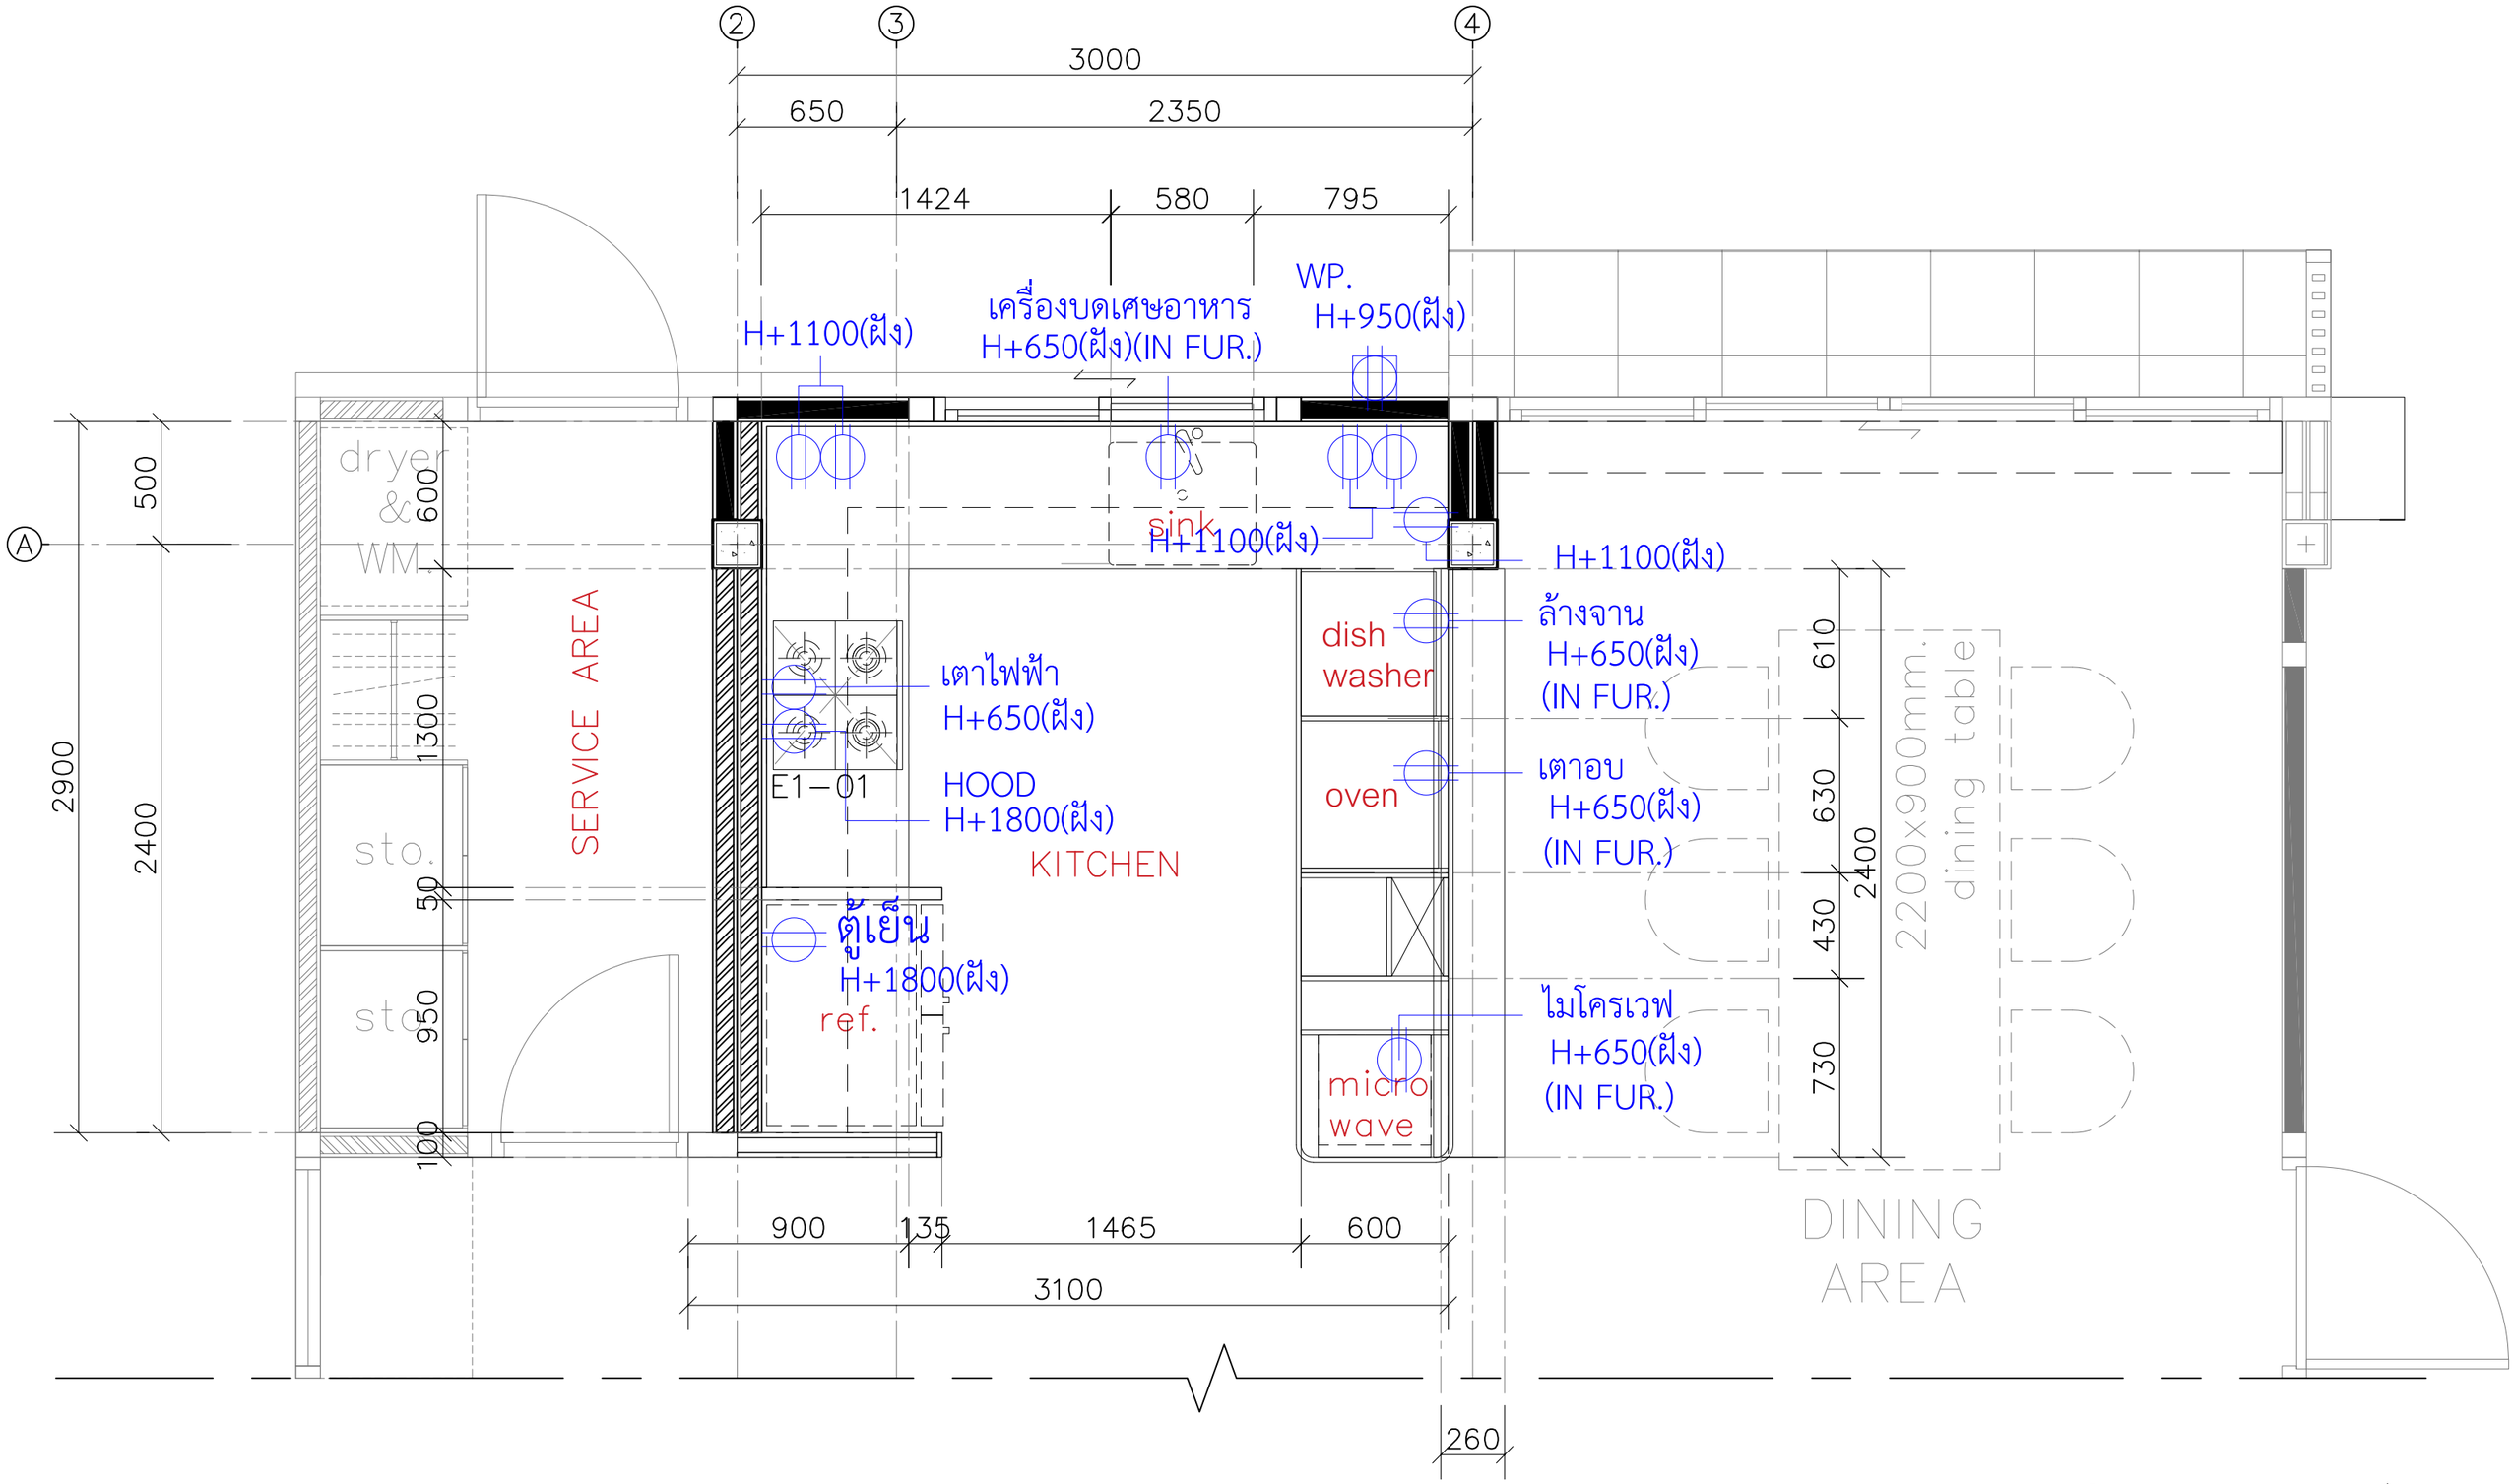

OUTLET PLAN (แบบขยายส่วนครัว)
scale 1:25

SPACEMAN	PROJECT: SONIA HOUSE	LOCATION: REIGNWOOD PARK, LAMLUKKA, PATHUM THANI	ARCHITECT	INTERIOR DESIGNER: ปรัตถกร ประมุขกุล ภ-สน 1438	STRUCTURAL ENGINEER	TITLE: 1st FLOOR OUTLET PLAN (แบบขยายครัว)	2026-05-06 ID1-04

Note: SPACEMAN takes no responsibility for dimensions obtained by scaling from this drawing. If no dimension is shown the recipient must ascertain the dimension specifically from the architect or by site measurement and may not rely on the drawing. Supply of the drawing in digital form is solely for convenience and no reliance may be placed on any data in digital form. All data must be checked against hard copy. This drawing is issued for design intent only and should not be used for construction unless stated. This drawing is the property of SPACEMAN

1:25 @ A3

WALL LIST

2 ผนังก่ออิฐฉาบปูน ทาสีซุปเปอร์ชิลด์ สีน้ำอะคริลิก ชนิดกึ่งเงา สีขาว (ระบุเฉดสีภายหลัง)

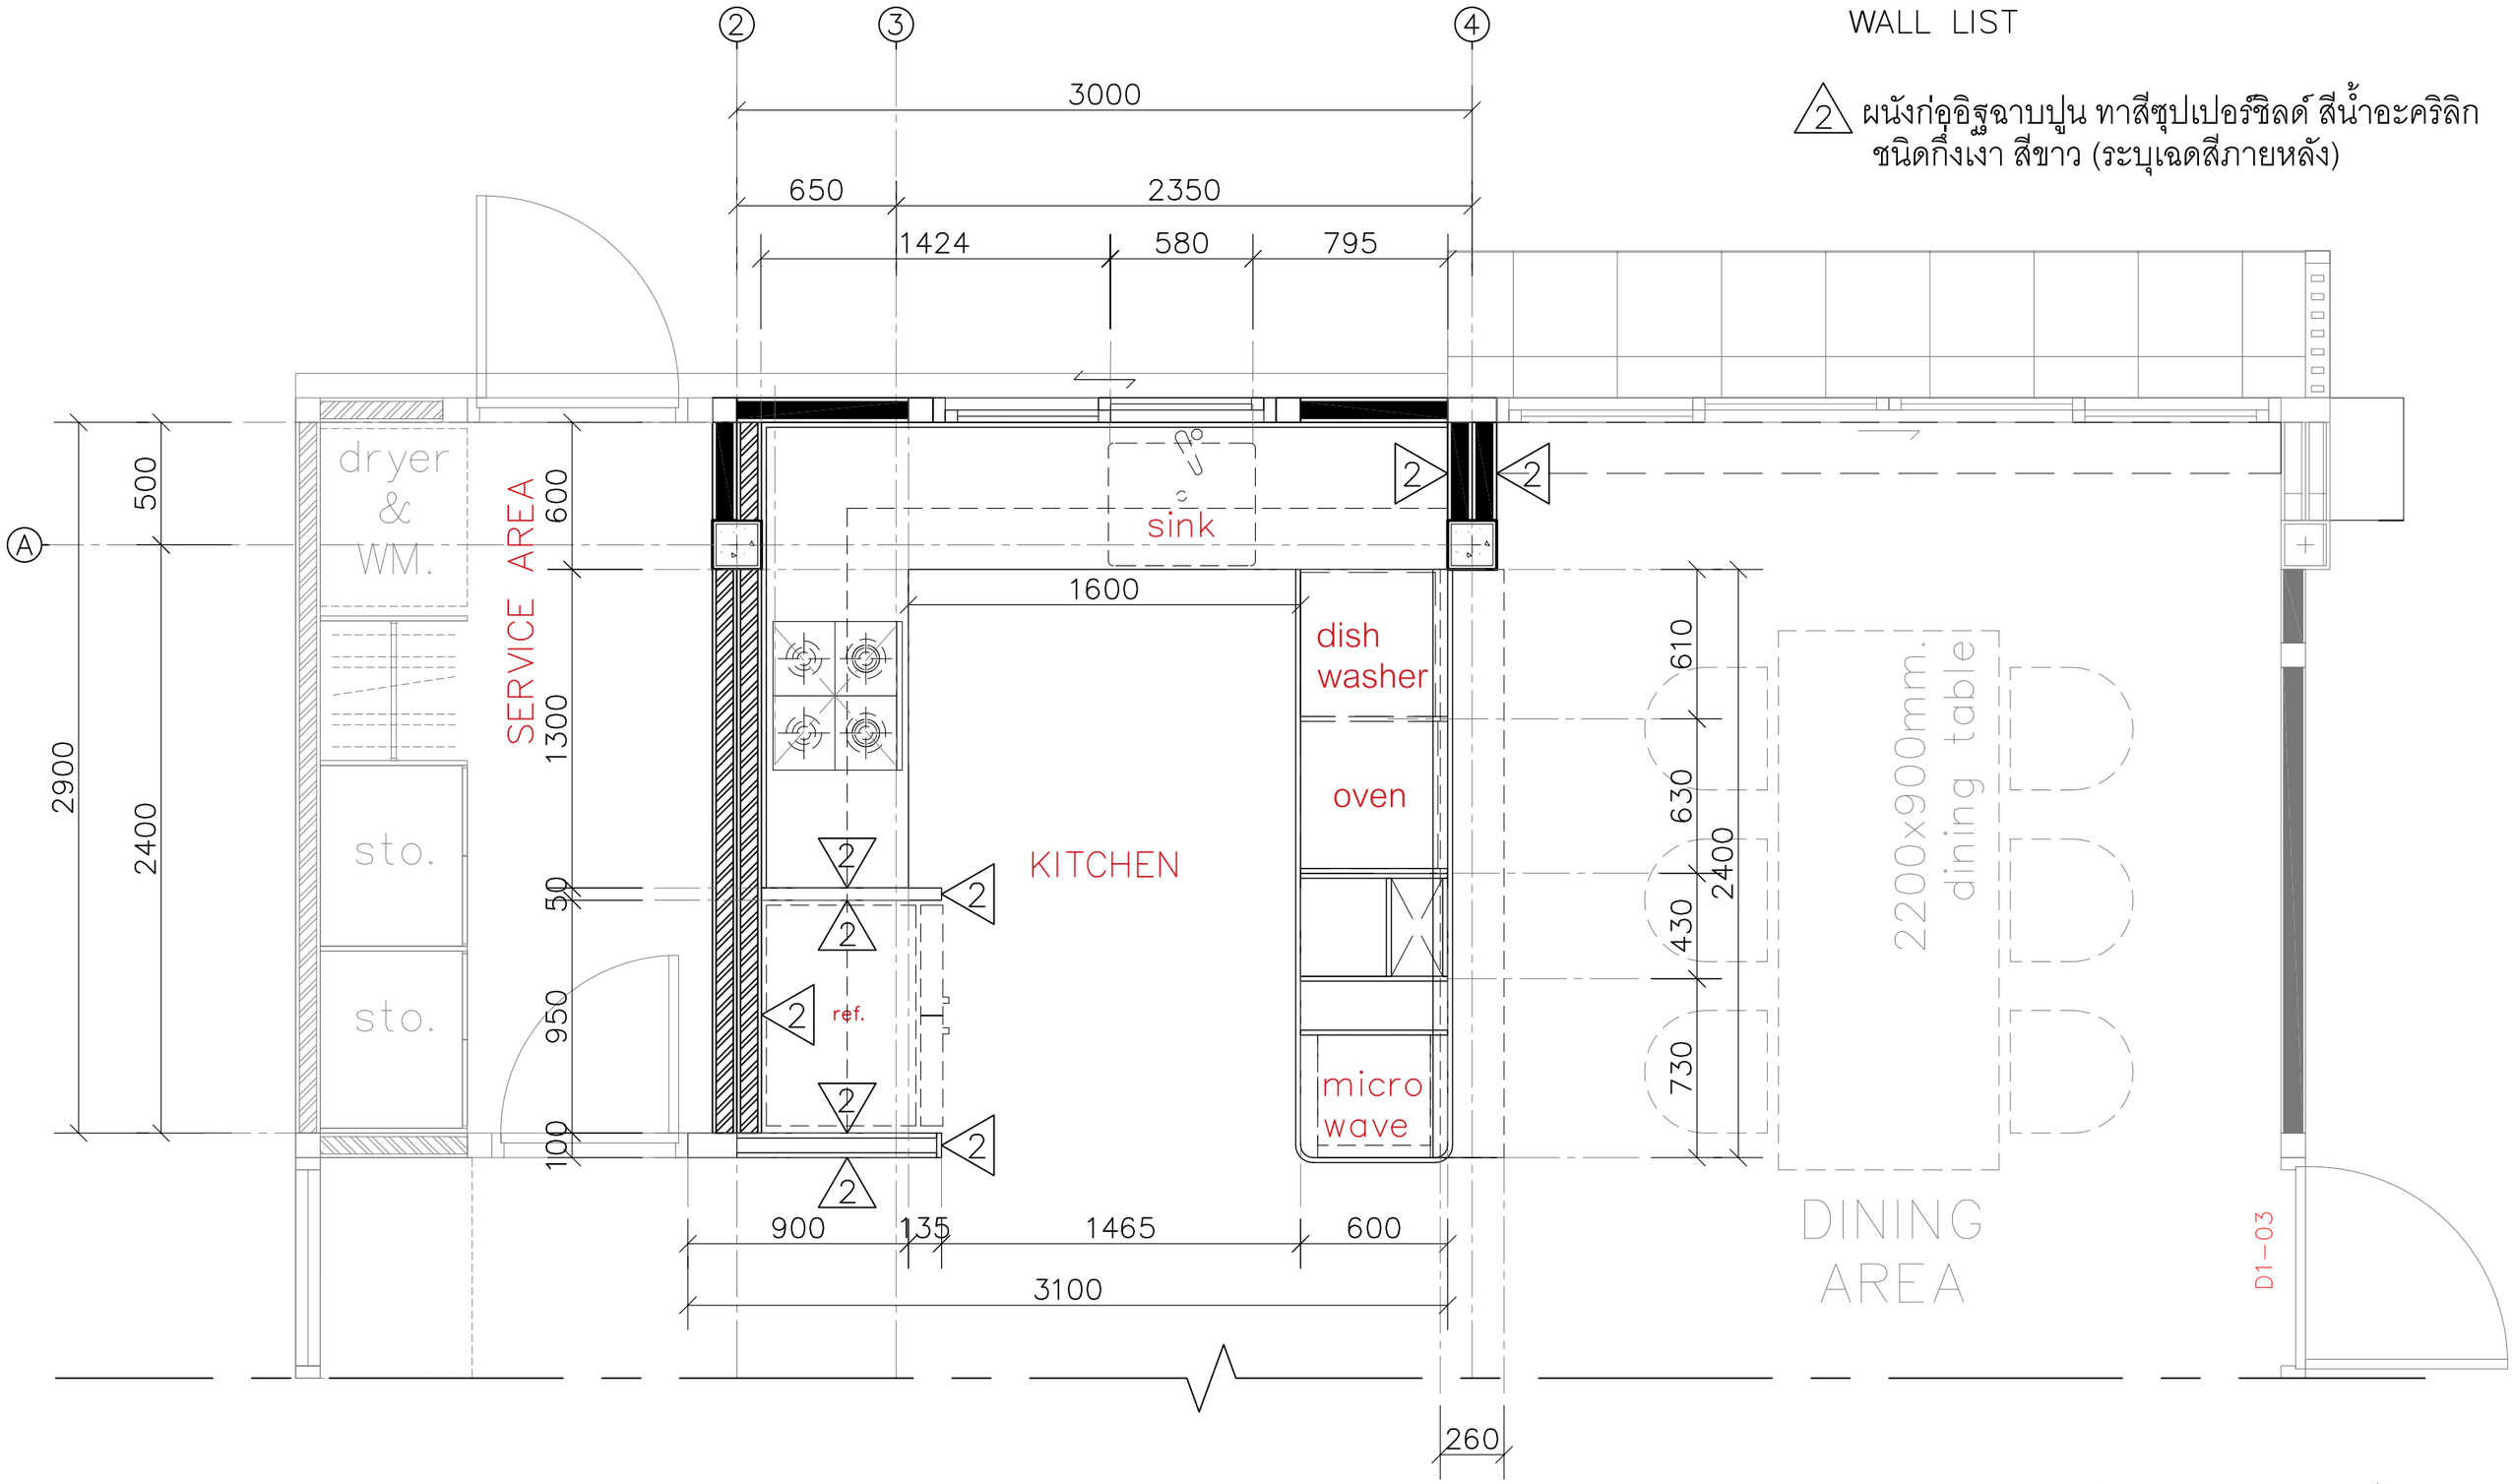

WALL PLAN (แบบขยายส่วนครัว)
scale 1:25

SPACEMAN

PROJECT: SONIA HOUSE

LOCATION: REIGNWOOD PARK
LAMLUKKA, PATHUM THANI

ARCHITECT:

INTERIOR DESIGNER: ปรัตถกร ประมุขกุล ภ-ศน 1438

STRUCTURAL ENGINEER:

TITLE: 1st FLOOR WALL PLAN (แบบขยายครัว)

2026-05-06
ID1-05

1:25 @ A3

Note: SPACEMAN takes no responsibility for dimensions obtained by scaling from this drawing. If no dimension is shown the recipient must ascertain the dimension specifically from the architect or by site measurement and may not rely on the drawing. Supply of the drawing in digital form is solely for convenience and no reliance may be placed on any data in digital form. All data must be checked against hard copy. This drawing is issued for design intent only and should not be used for construction unless stated. This drawing is the property of SPACEMAN

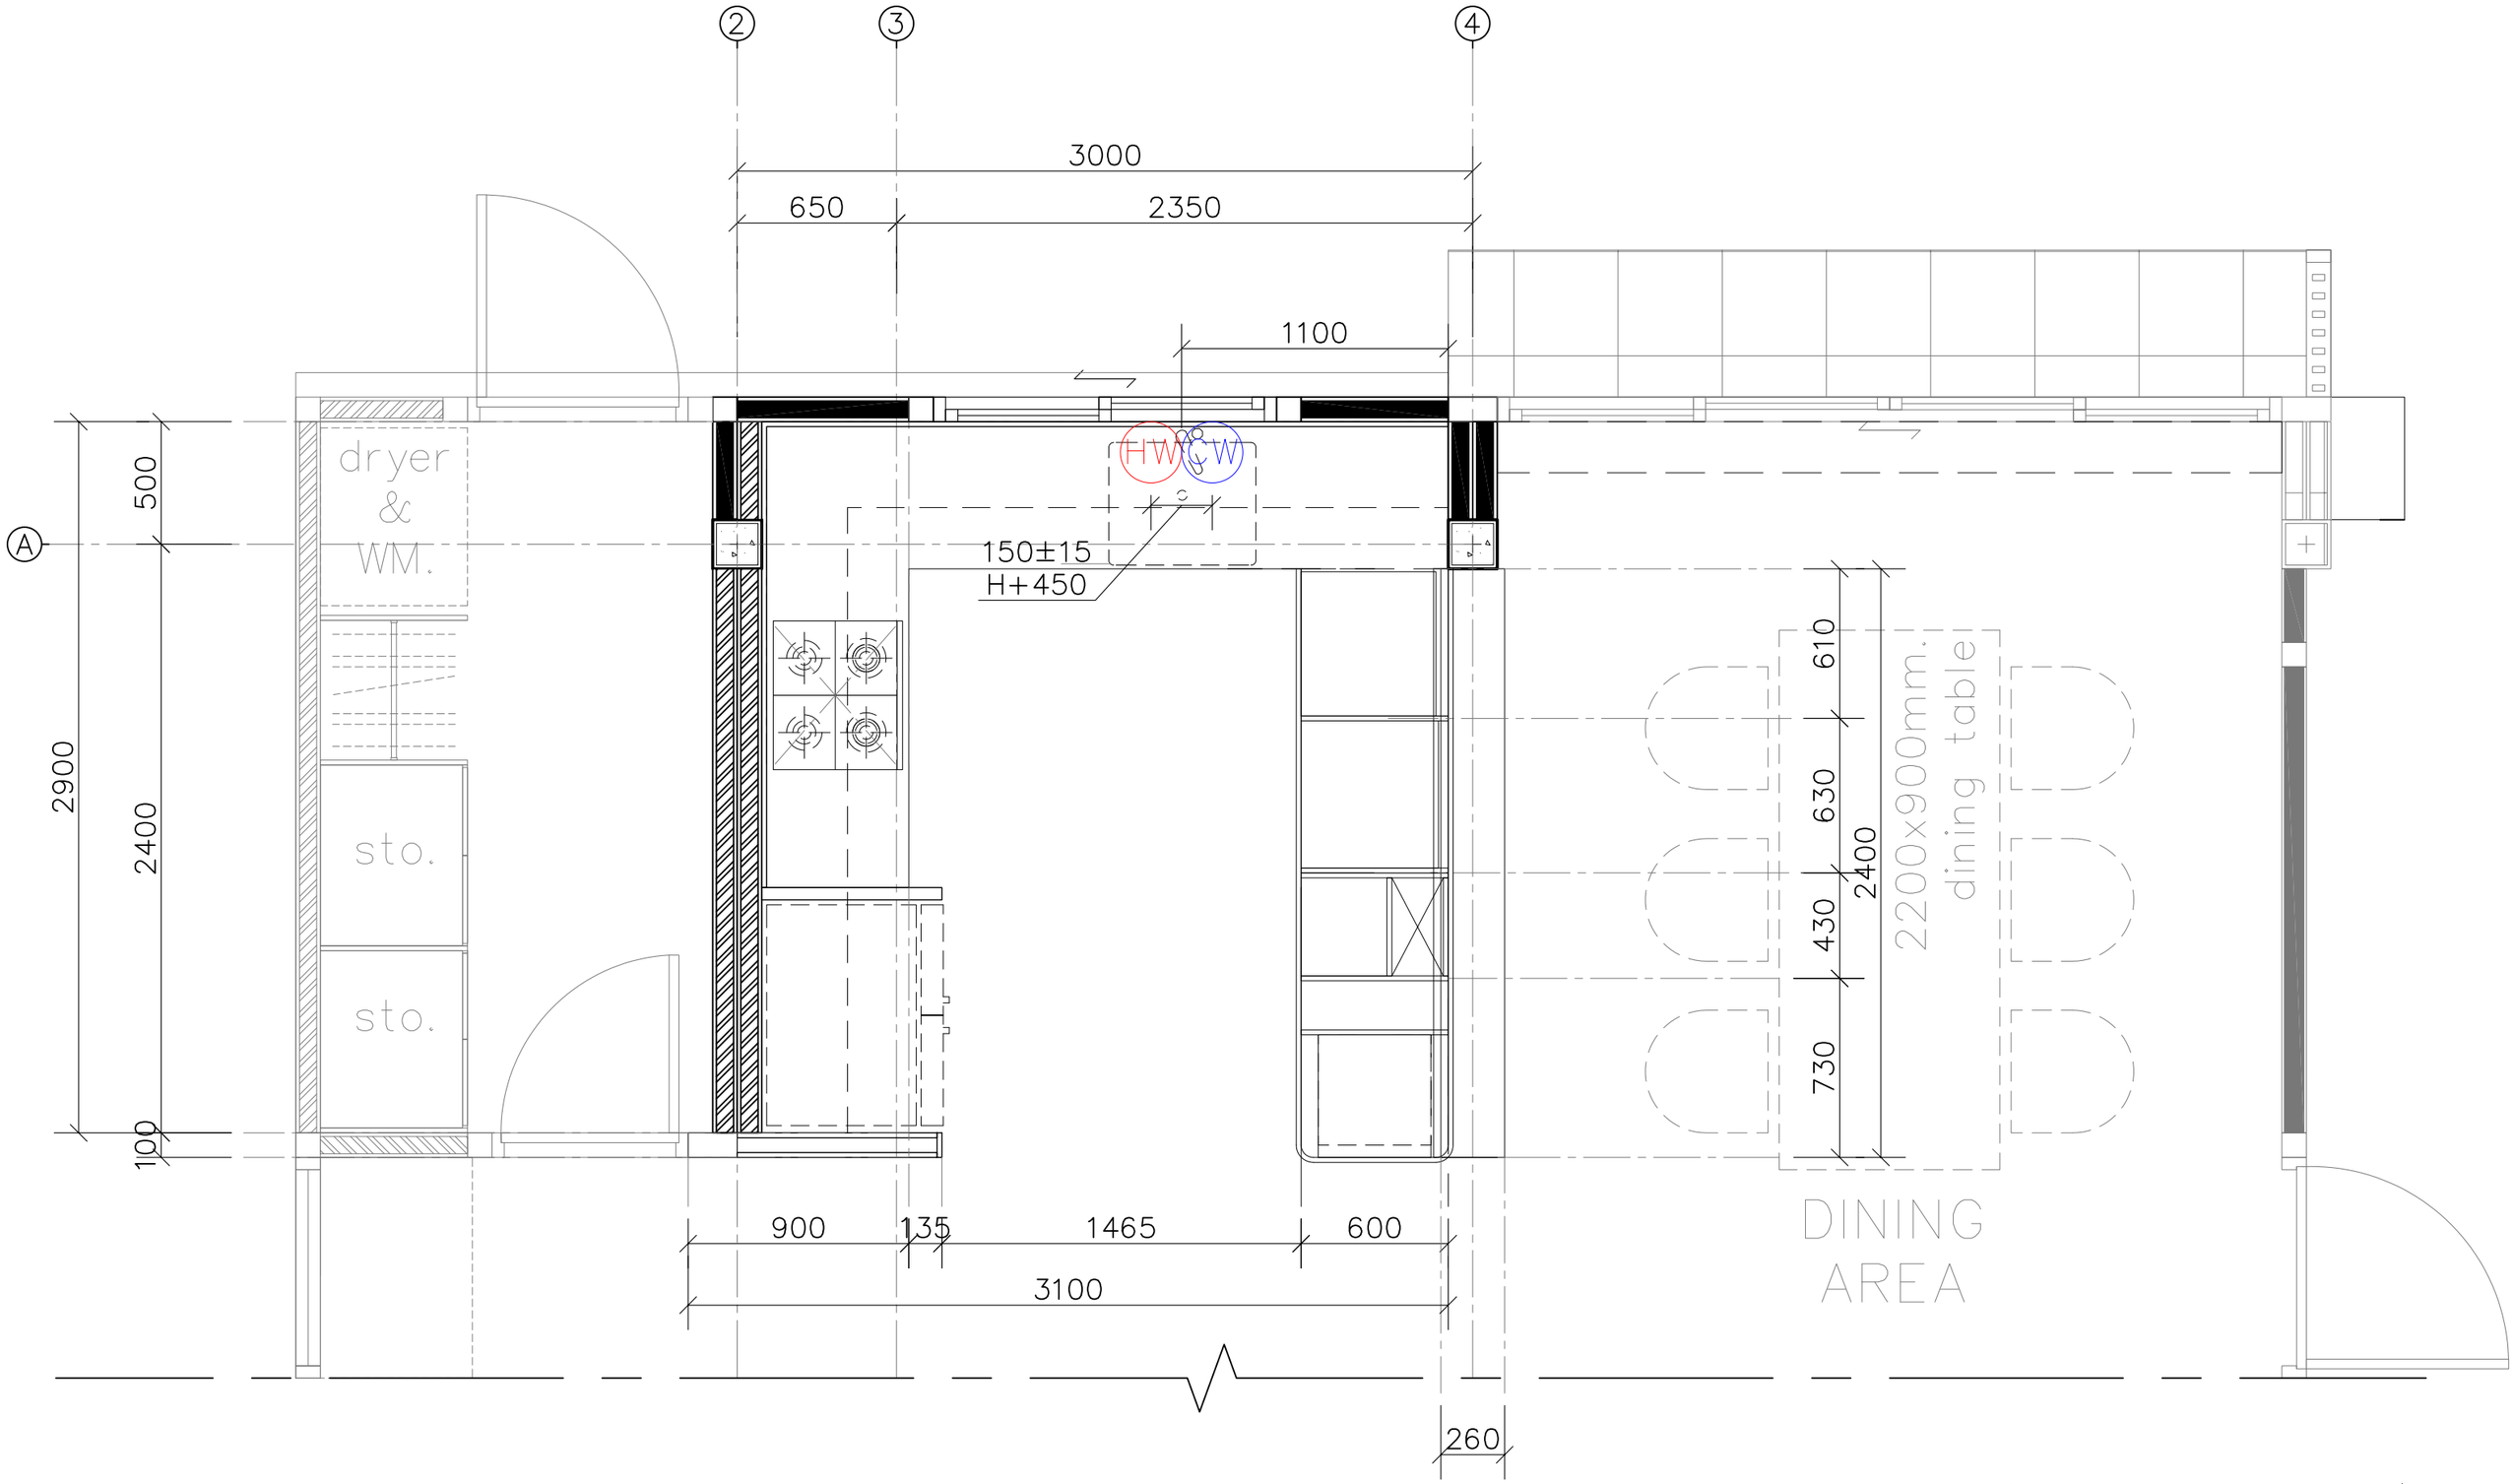

WATER LOCATION PLAN (แบบขยายส่วนครัว)
scale 1:25

SPACEMAN	PROJECT: SONIA HOUSE	LOCATION: REIGNWOOD PARK, LAMLUKKA, PATHUM THANI	ARCHITECT	INTERIOR DESIGNER: ปรัตถกร ประมุขกุล ภ-สน 1438	STRUCTURAL ENGINEER	TITLE: 1st FLOOR WATER LOCATION PLAN (แบบขยายครัว)	2026-05-06 ID1-06

Note: SPACEMAN takes no responsibility for dimensions obtained by scaling from this drawing. If no dimension is shown the recipient must ascertain the dimension specifically from the architect or by site measurement and may not rely on the drawing. Supply of the drawing in digital form is solely for convenience and no reliance may be placed on any data in digital form. All data must be checked against hard copy. This drawing is issued for design intent only and should not be used for construction unless stated. This drawing is the property of SPACEMAN

1:25 @ A3

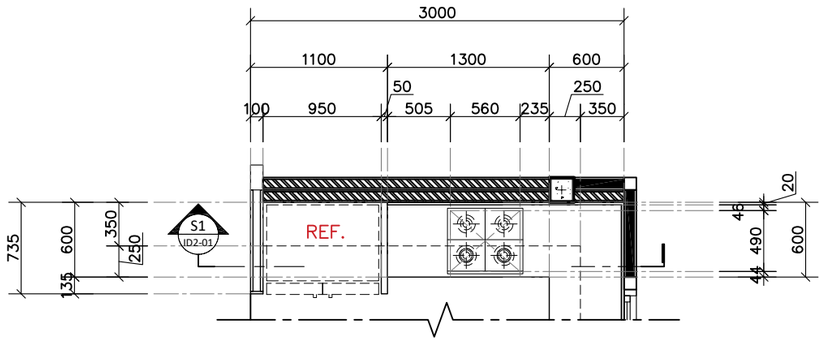

P1 / ID2-01 แบบขยาย (ส่วนครัว)
PLAN 01
SCALE 1:50

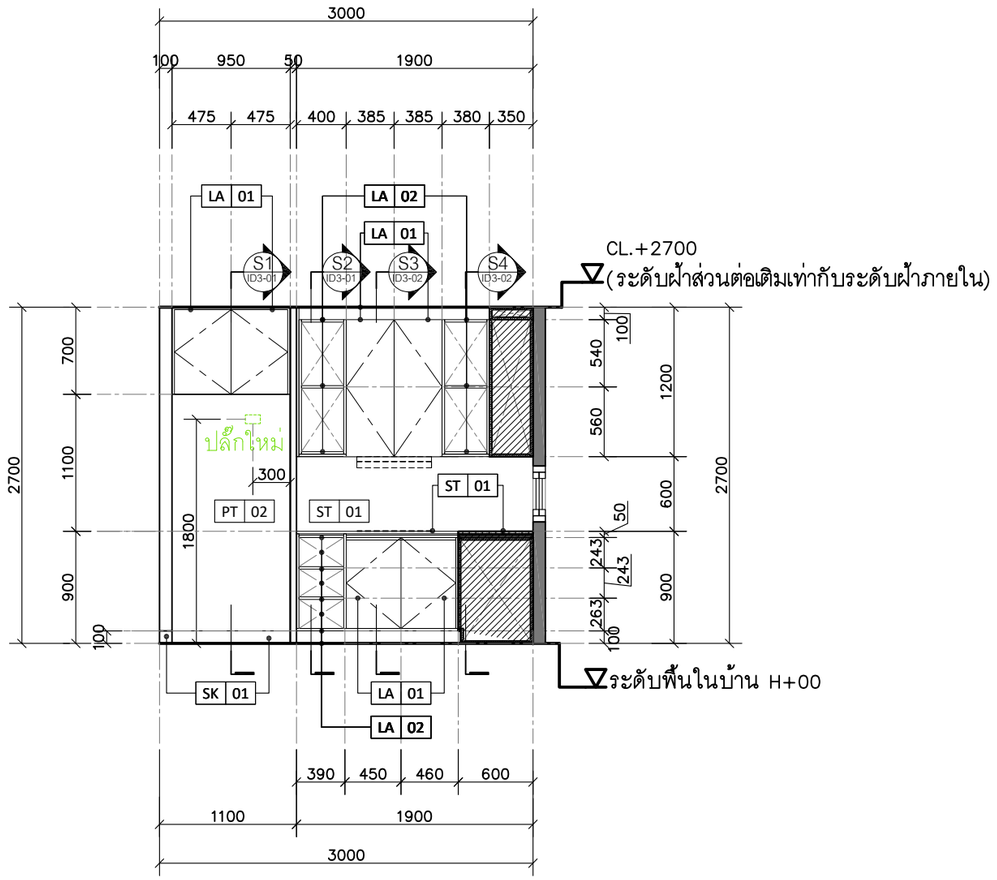

E1 / ID2-01 แบบขยาย (ส่วนครัว)
ELEVATION 01
SCALE 1:50

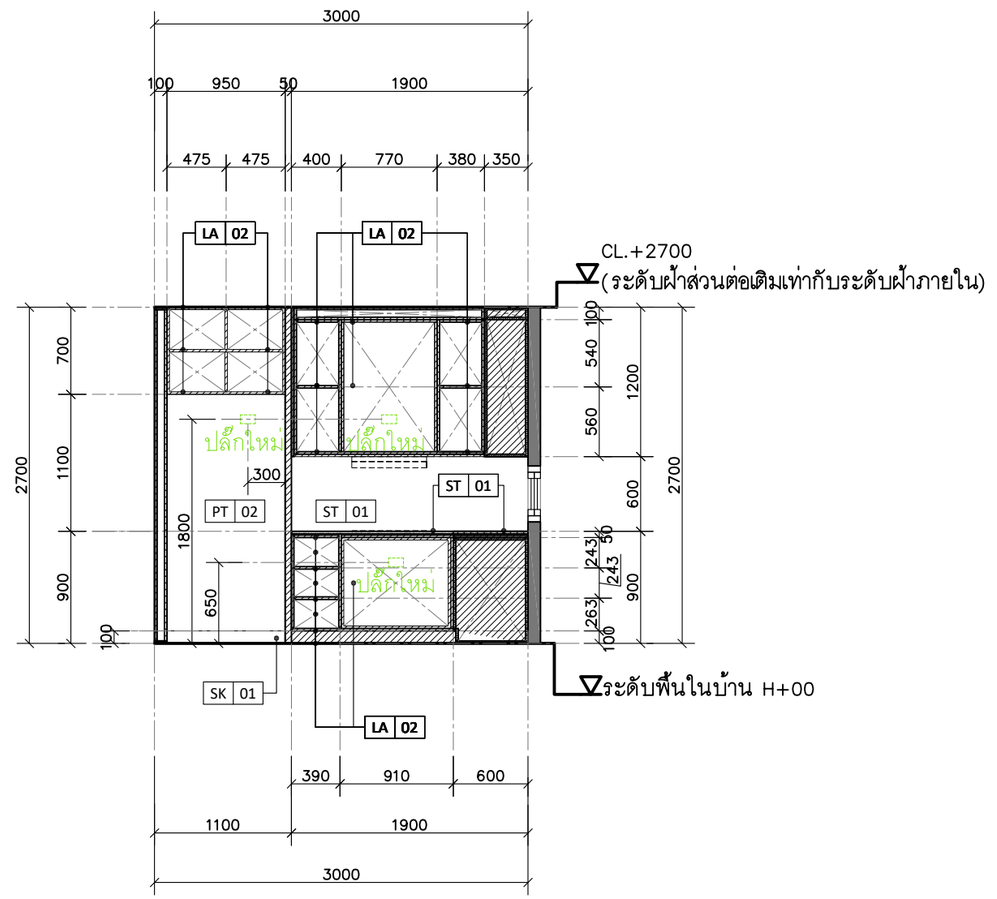

S1 / ID2-01 แบบขยาย (ส่วนครัว)
SECTION 01
SCALE 1:50

SPACEMAN

PROJECT: SONIA HOUSE
LOCATION: REIGNWOOD PARK LAMLUKKA, PATHUM THANI
ARCHITECT:
INTERIOR DESIGNER: ปรัตถกร ประมุขกุล ภ-สน 1438
STRUCTURAL ENGINEER:
TITLE: 1st FLOOR แบบขยายส่วนครัว PLAN 01,ELEVATION 01,SECTION 01
2026-05-06
ID2-01
1:50 @ A3

Note: SPACEMAN takes no responsibility for dimensions obtained by scaling from this drawing. If no dimension is shown the recipient must ascertain the dimension specifically from the architect or by site measurement and may not rely on the drawing. Supply of the drawing in digital form is solely for convenience and no reliance may be placed on any data in digital form. All data must be checked against hard copy. This drawing is issued for design intent only and should not be used for construction unless stated. This drawing is the property of SPACEMAN

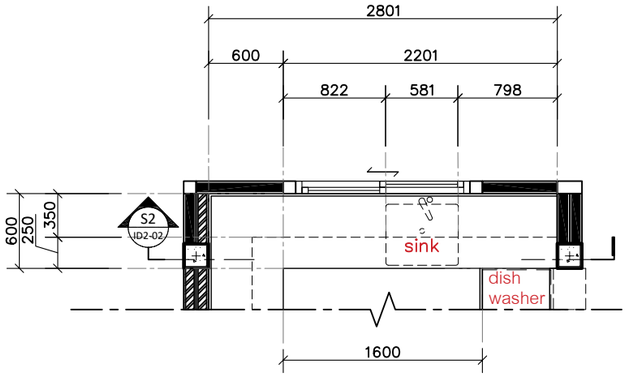

P2 แบบขยาย (ส่วนครัว)
ID2-02 PLAN 02
SCALE 1:50

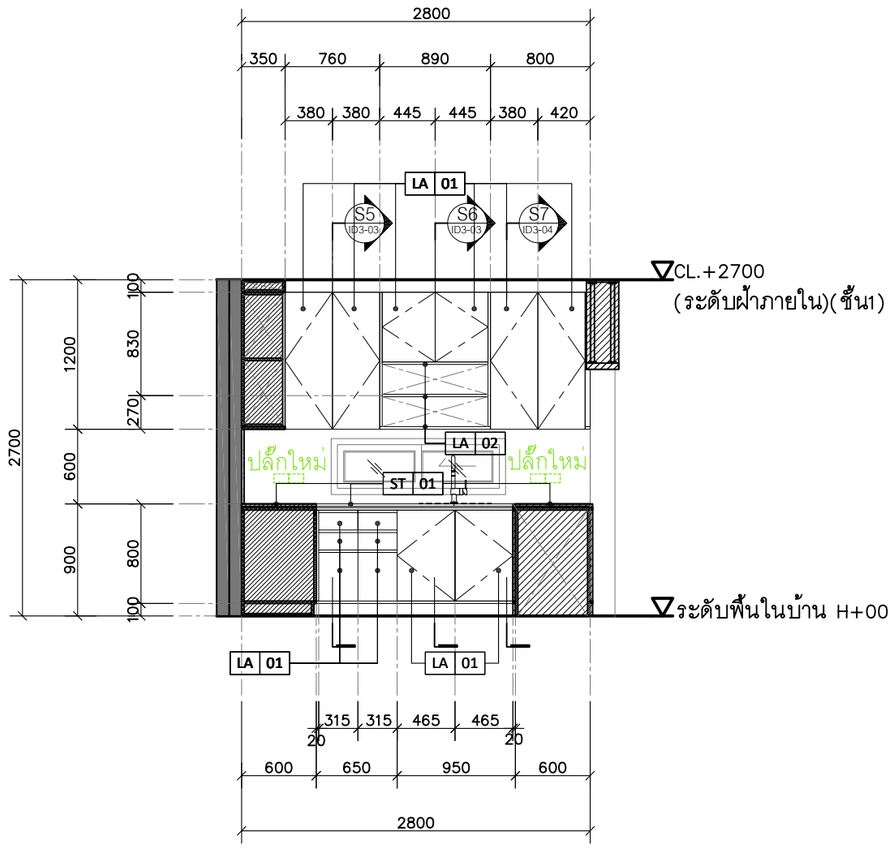

E2 แบบขยาย (ส่วนครัว)
ID2-02 ELEVATION 02
SCALE 1:50

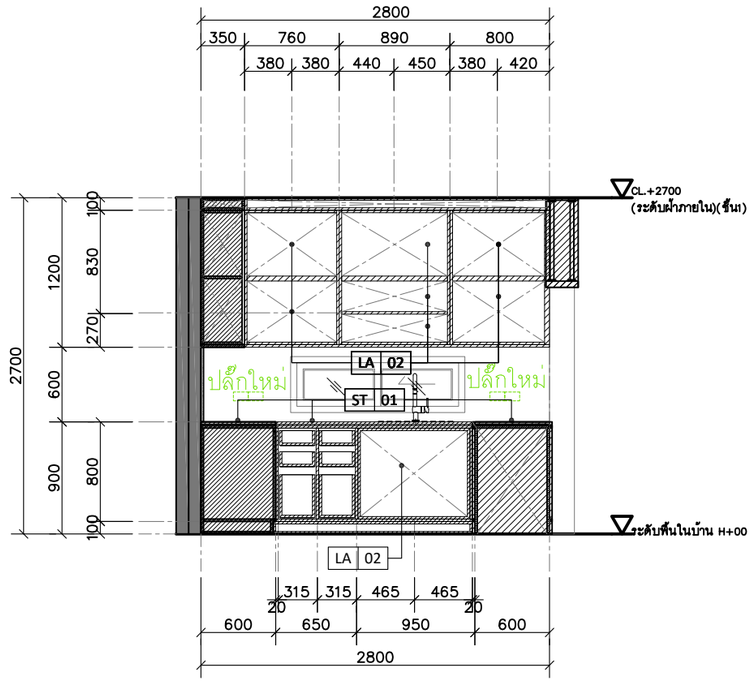

S2 แบบขยาย (ส่วนครัว)
ID2-02 SECTION 02
SCALE 1:50

SPACEMAN

PROJECT: SONIA HOUSE

LOCATION: REIGNWOOD PARK
LAMLUKKA, PATHUM THANI

ARCHITECT:

INTERIOR DESIGNER: ปรัตถกร ประมุขกุล ภ-สน 1438

STRUCTURAL ENGINEER:

TITLE: 1st FLOOR
แบบขยายส่วนครัว
PLAN 02,ELEVATION 02,SECTION 02

2026-05-06
ID2-02
1:50 @ A3

Note: SPACEMAN takes no responsibility for dimensions obtained by scaling from this drawing. If no dimension is shown the recipient must ascertain the dimension specifically from the architect or by site measurement and may not rely on the drawing. Supply of the drawing in digital form is solely for convenience and no reliance may be placed on any data in digital form. All data must be checked against hard copy. This drawing is issued for design intent only and should not be used for construction unless stated. This drawing is the property of SPACEMAN

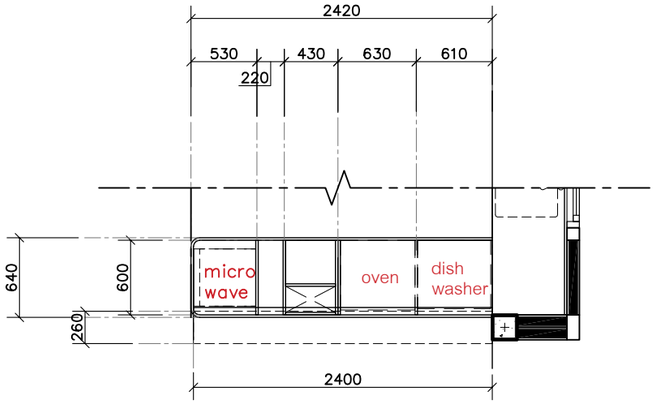

P3 แบบขยาย (ส่วนครัว)
ID2-03 PLAN 03
SCALE 1:50

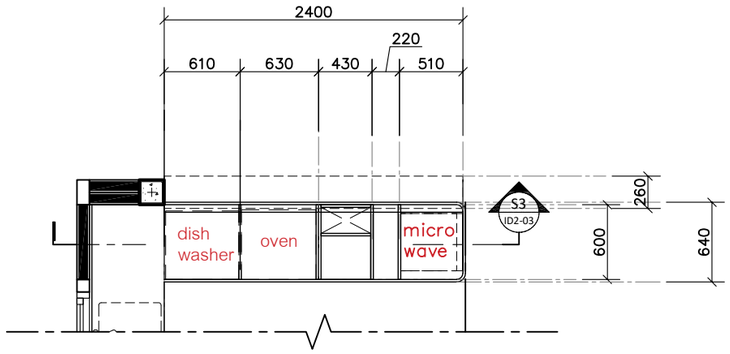

P4 แบบขยาย (ส่วนครัว)
ID2-03 PLAN 04
SCALE 1:50

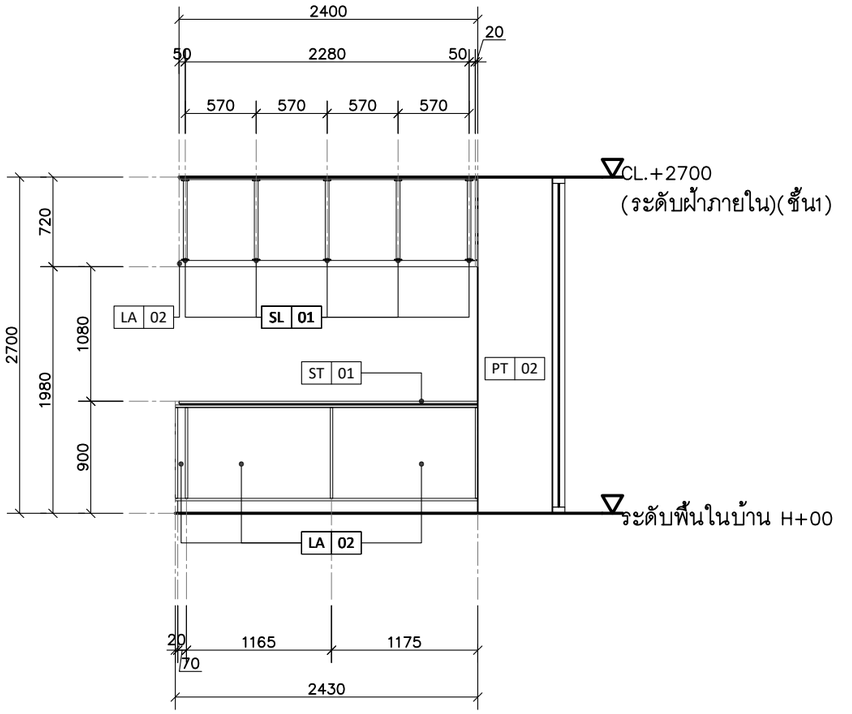

E3 แบบขยาย (ส่วนครัว)
ID2-03 ELEVATION 03
SCALE 1:50

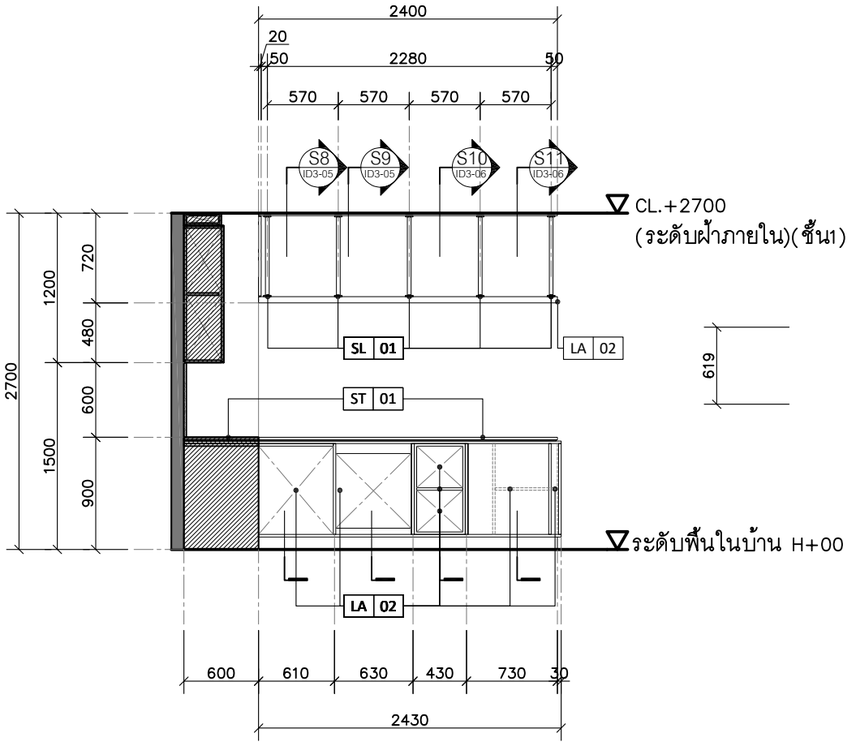

E4 แบบขยาย (ส่วนครัว)
ID2-03 ELEVATION 04
SCALE 1:50

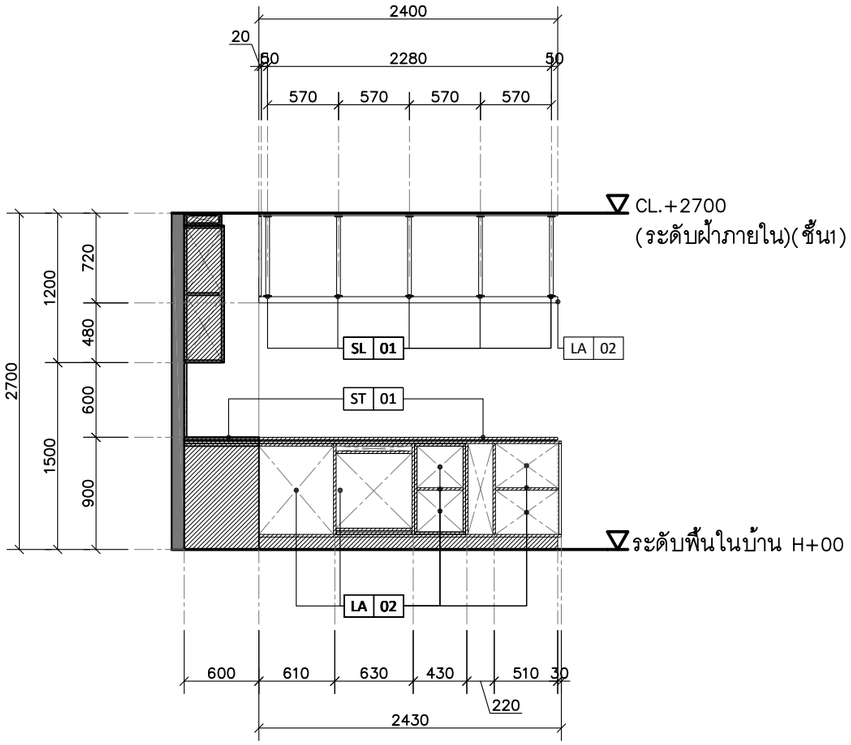

S3 แบบขยาย (ส่วนครัว)
ID2-03 SECTION 03
SCALE 1:50

SPACEMAN

PROJECT: SONIA HOUSE
LOCATION: REIGNWOOD PARK, LAMLUKKA, PATHUM THANI
ARCHITECT:
INTERIOR DESIGNER: ปรัตถกร ประมุขกุล ภ-สน 1438
STRUCTURAL ENGINEER:
TITLE: 1st FLOOR แบบขยายส่วนครัว ELEVATION 03,ELEVATION 04 ,SECTION 03

2026-05-06
ID2-03
1:50 @ A3

Note: SPACEMAN takes no responsibility for dimensions obtained by scaling from this drawing. If no dimension is shown the recipient must ascertain the dimension specifically from the architect or by site measurement and may not rely on the drawing. Supply of the drawing in digital form is solely for convenience and no reliance may be placed on any data in digital form. All data must be checked against hard copy. This drawing is issued for design intent only and should not be used for construction unless stated. This drawing is the property of SPACEMAN

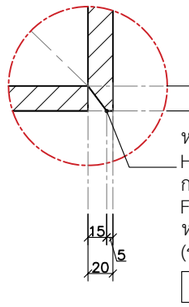

หน้าบานเปิดโครง
HMR E0(PURPLE CORE) หนา 20 มม.
กรุลามิเนตสีขาว
FORMICA
หรือเทียบเท่า
(ระบุเฉดสีภายหลัง)

LA	01

D1 ID3-01 DETAIL 1
scale 1:5

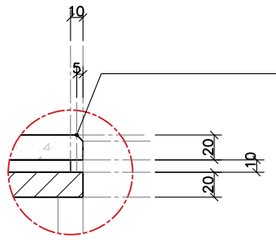

TOP COUNTER
ครัวหินอ่อน SILATAK/
ชมพูพรานกระต่าย
หนา 20 มม.
ลบมุม 5 มม.

ST	01

D2 ID3-01 DETAIL 2
scale 1:5

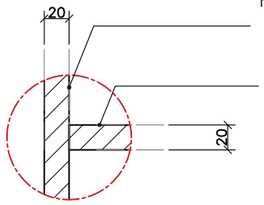

โครง HMR E0(PURPLE CORE) หนา 20 มม.
กรุด้วยลามิเนตลายไม้
FORMICA หรือเทียบเท่า
(ระบุภายหลัง)

LA	02

ชั้นวางโครง HMR E0(PURPLE CORE)
หนา 20 มม.
กรุด้วยลามิเนตลายไม้
FORMICA หรือเทียบเท่า
(ระบุภายหลัง)

LA	02

D3 ID3-01 DETAIL 3
scale 1:5

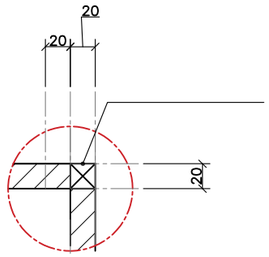

โครง HMR E0(PURPLE CORE)
หนา 20 มม.
กรุด้วยลามิเนตลายไม้
FORMICA หรือเทียบเท่า
(ระบุภายหลัง)

LA	02

D4 ID3-01 DETAIL 4
scale 1:5

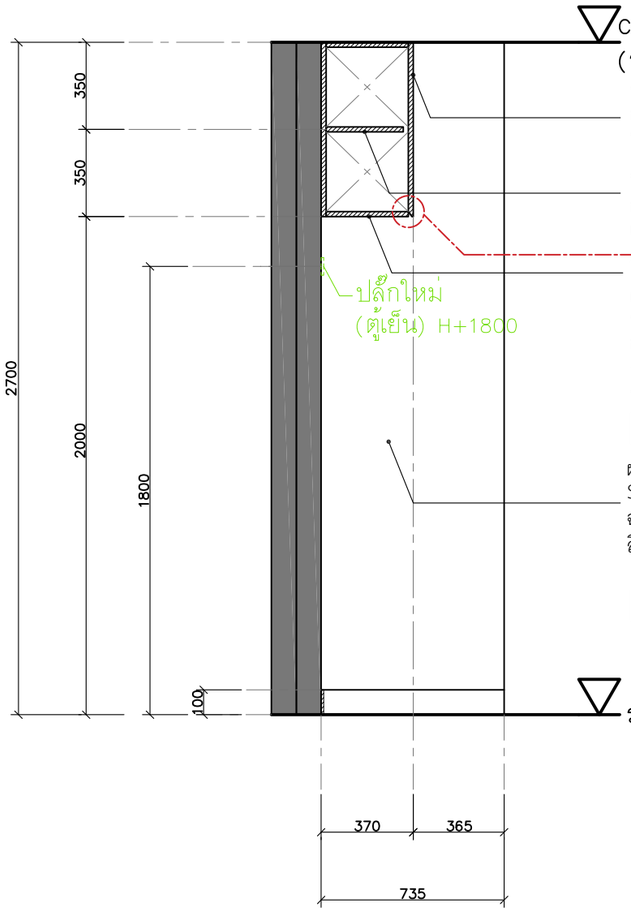

หน้าบานเปิดโครง HMR E0(PURPLE CORE) หนา 20 มม.
กรุลามิเนตสีขาว FORMICA
หรือเทียบเท่า (ระบุเฉดสีภายหลัง)

LA	01

ชั้นวางโครง HMR E0(PURPLE CORE) หนา 20 มม.
กรุลามิเนตลายไม้ FORMICA หรือเทียบเท่า
(ระบุภายหลัง)

LA	02

โครง HMR E0
(PURPLE CORE)
หนา 20 มม.
กรุลามิเนต
ลายไม้ FORMICA
หรือเทียบเท่า(ระบุภายหลัง)

LA	02

D1 ID3-01

ผนังโครงเคร่าเหล็กกรุแผ่น
SMARTBOARD
ฉาบเรียบ ทาสีซุปเปอร์ชิลด์
สีน้ำอะคริลิก ชนิดกึ่งเงา
สีขาว (ระบุเฉดสีภายหลัง) "PT-02"

PT	02

แบบขยาย (ส่วนครัว)
S1 ID3-01 SECTION 1
scale 1:25

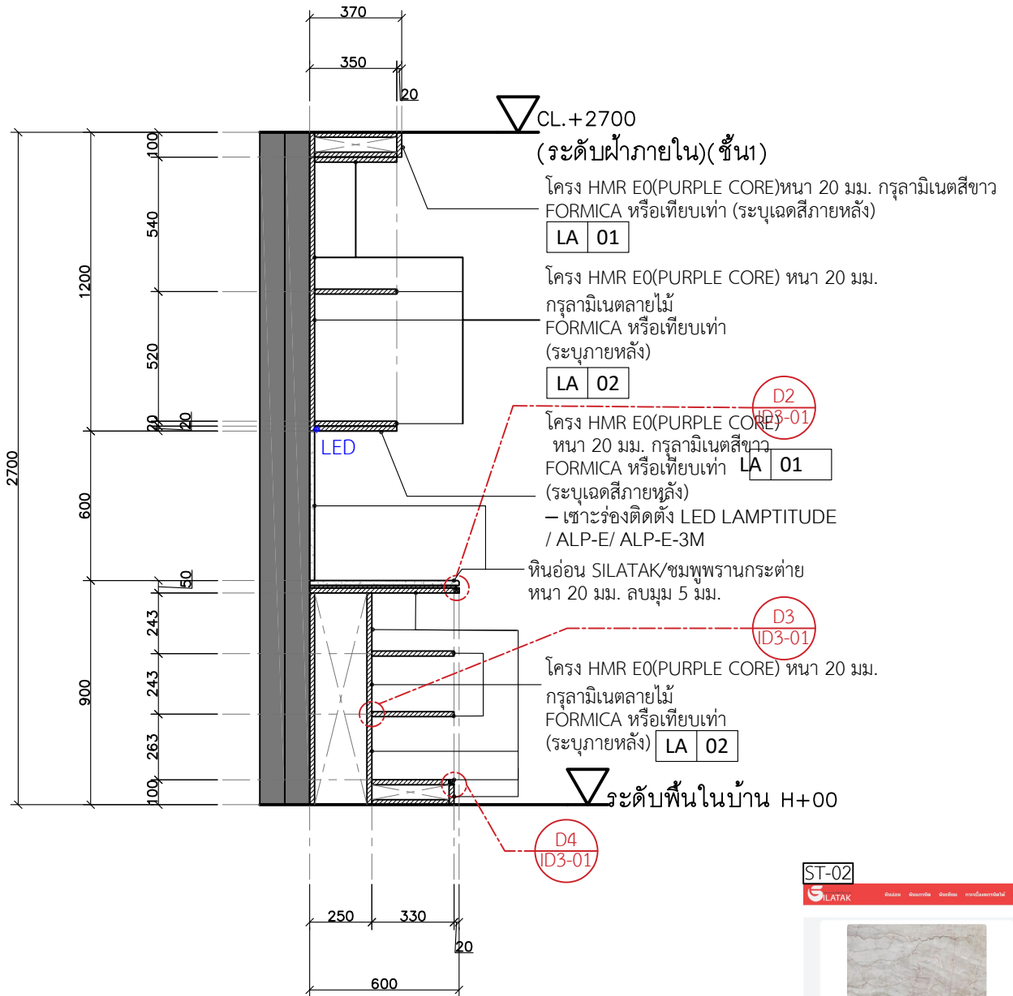

โครง HMR E0(PURPLE CORE)หนา 20 มม. กรุลามิเนตสีขาว
FORMICA หรือเทียบเท่า (ระบุเฉดสีภายหลัง)

LA	01

โครง HMR E0(PURPLE CORE) หนา 20 มม.
กรุลามิเนตลายไม้
FORMICA หรือเทียบเท่า
(ระบุภายหลัง)

LA	02

โครง HMR E0(PURPLE CORE)
หนา 20 มม. กรุลามิเนตสีขาว
FORMICA หรือเทียบเท่า

LA	01

(ระบุเฉดสีภายหลัง)
– เซาะร่องติดตั้ง LED LAMPTITUDE
/ ALP-E/ ALP-E-3M

หินอ่อน SILATAK/ชมพูพรานกระต่าย
หนา 20 มม. ลบมุม 5 มม.

โครง HMR E0(PURPLE CORE) หนา 20 มม.
กรุลามิเนตลายไม้
FORMICA หรือเทียบเท่า
(ระบุภายหลัง)

LA	02

แบบขยาย (ส่วนครัว)
S2 ID3-01 SECTION 2
scale 1:25

ST-02

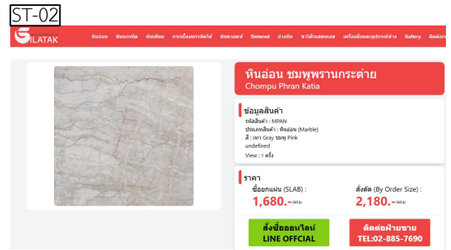

หินอ่อน/SILATAK CHOMPU PHRAN KATIA/สีเทาชมพู
(หรือเทียบเท่า)

SPACEMAN

PROJECT: SONIA HOUSE
LOCATION: REIGNWOOD PARK
LAMLUKKA, PATHUM THANI
ARCHITECT:
INTERIOR DESIGNER: ปรัตถกร ประมุขกุล ภ–สน 1438
STRUCTURAL ENGINEER:
TITLE: 1st FLOOR
แบบขยายส่วนครัว
SECTION 01, 02

2026–05–06
ID3–01
1:25 @ A3

Note: SPACEMAN takes no responsibility for dimensions obtained by scaling from this drawing. If no dimension is shown the recipient must ascertain the dimension specifically from the architect or by site measurement and may not rely on the drawing. Supply of the drawing in digital form is solely for convenience and no reliance may be placed on any data in digital form. All data must be checked against hard copy. This drawing is issued for design intent only and should not be used for construction unless stated. This drawing is the property of SPACEMAN

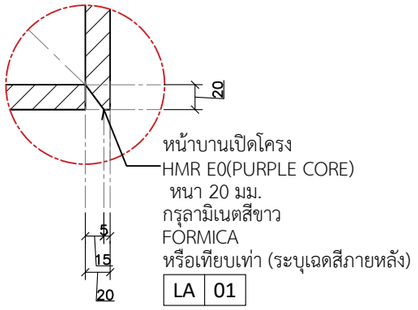

หน้าบานเปิดโครง
HMR E0(PURPLE CORE)
หนา 20 มม.
กรุลามิเนตสีขาว
FORMICA
หรือเทียบเท่า (ระบุเฉดสีภายหลัง)

LA	01

D1 ID3-02 DETAIL 1
scale 1:5

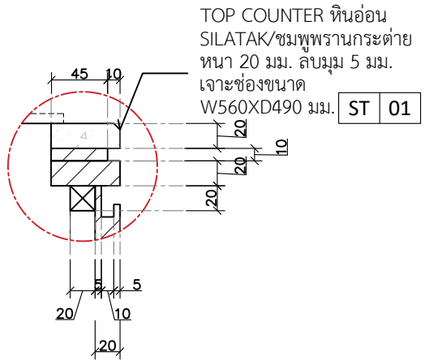

TOP COUNTER หินอ่อน
SILATAK/ชมพูพรานกระต่าย
หนา 20 มม. ลบมุม 5 มม.
เจาะช่องขนาด
W560XD490 มม.

ST	01

D2 ID3-02 DETAIL 2
scale 1:5

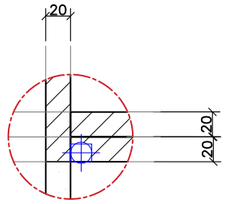

โครง HMR E0(PURPLE CORE) หนา 20 มม.
กรุลามิเนตสีขาว FORMICA
หรือเทียบเท่า
(ระบุเฉดสีภายหลัง)

LA	01

D3 ID3-02 DETAIL 3
scale 1:5

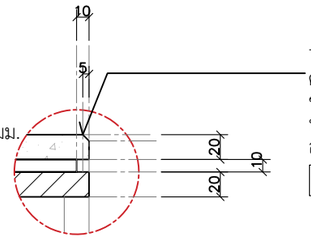

TOP COUNTER
ครัวหินอ่อน SILATAK/
ชมพูพรานกระต่าย
หนา 20 มม.
ลบมุม 5 มม.

ST	01

D4 ID3-02 DETAIL 4
scale 1:5

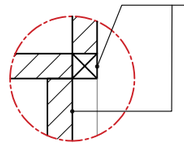

โครง HMR E0
(PURPLE CORE)หนา 20 มม.
กรุด้วยลามิเนตลายไม้
FORMICA หรือเทียบเท่า
(ระบุภายหลัง)

LA	02

D5 ID3-02 DETAIL 5
scale 1:5

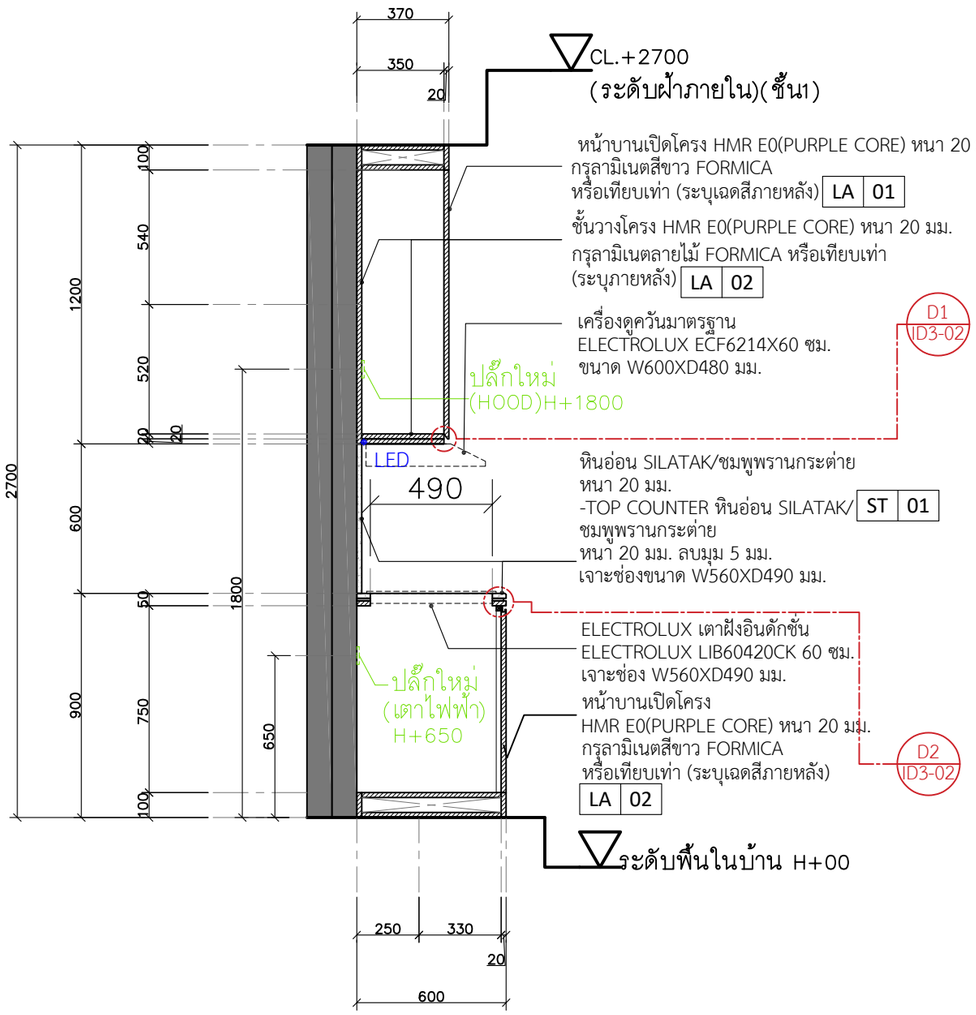

แบบขยาย (ส่วนครัว)
S3 ID3-02 SECTION 3
scale 1:25

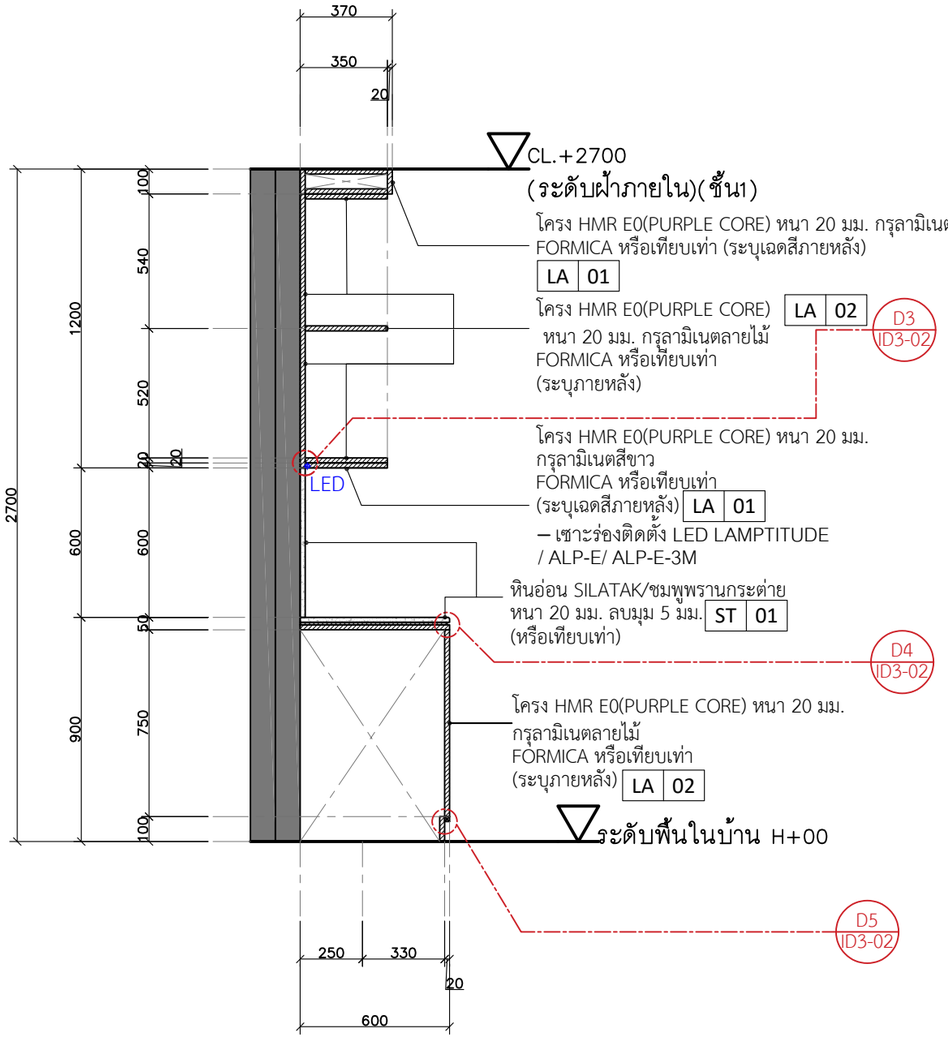

แบบขยาย (ส่วนครัว)
S4 ID3-02 SECTION 4
scale 1:25

ST-02

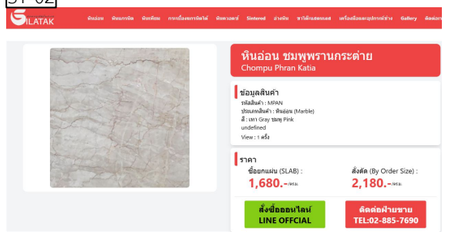

หินอ่อน/SILATAK CHOMPU PHRAN KATIA/สีเทาชมพู
(หรือเทียบเท่า)

E1-01

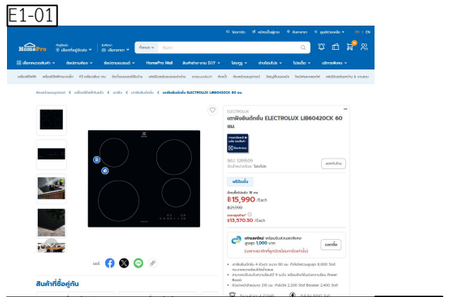

ELECTROLUX เตาฝังอินดักชั่น ELECTROLUX
LIB60420CK 60 ซม. เจาะช่อง W560XD490 มม.

E1-02

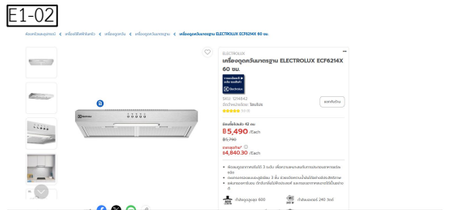

เครื่องดูดควันมาตรฐาน ELECTROLUX ECF6214X 60 ซม.

SPACEMAN

PROJECT SONIA HOUSE
LOCATION REIGNWOOD PARK
LAMLUKKA, PATHUM THANI
ARCHITECT
INTERIOR DESIGNER ปรัตถกร ประมุขกุล ภ–สน 1438
STRUCTURAL ENGINEER
TITLE 1st FLOOR
แบบขยายส่วนครัว
SECTION 03 ,04
2026–05–06
ID3–02
1:25 @ A3

Note: SPACEMAN takes no responsibility for dimensions obtained by scaling from this drawing. If no dimension is shown the recipient must ascertain the dimension specifically from the architect or by site measurement and may not rely on the drawing. Supply of the drawing in digital form is solely for convenience and no reliance may be placed on any data in digital form. All data must be checked against hard copy. This drawing is issued for design intent only and should not be used for construction unless stated. This drawing is the property of SPACEMAN

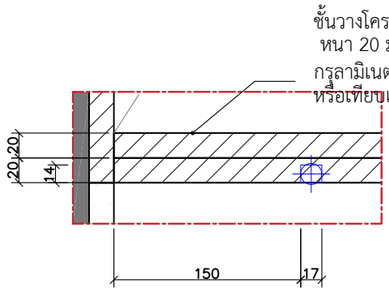

D1 DETAIL 1
ID3-03 scale 1:5

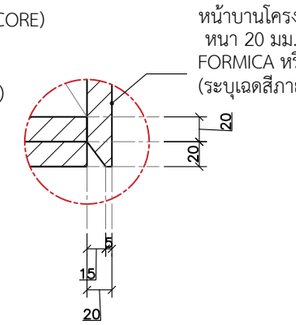

D2 DETAIL 2
ID3-03 scale 1:5

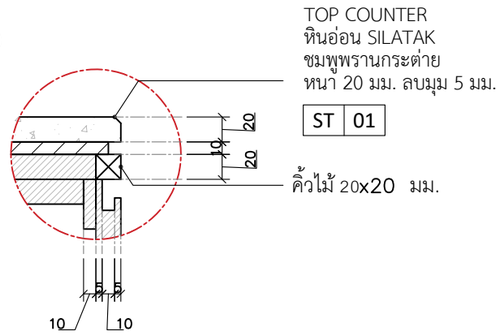

D3 DETAIL 3
ID3-03 scale 1:5

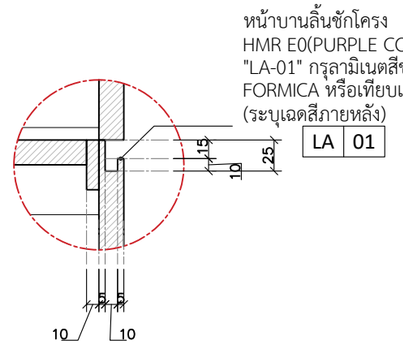

D4 DETAIL 4
ID3-03 scale 1:5

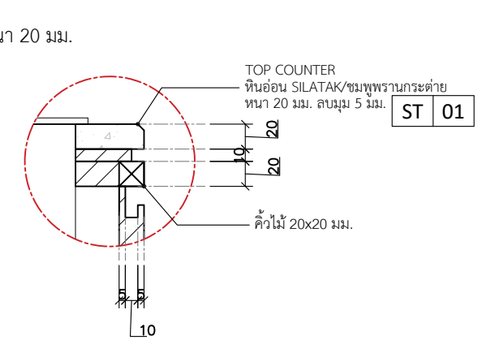

D5 DETAIL 5
ID3-03 scale 1:5

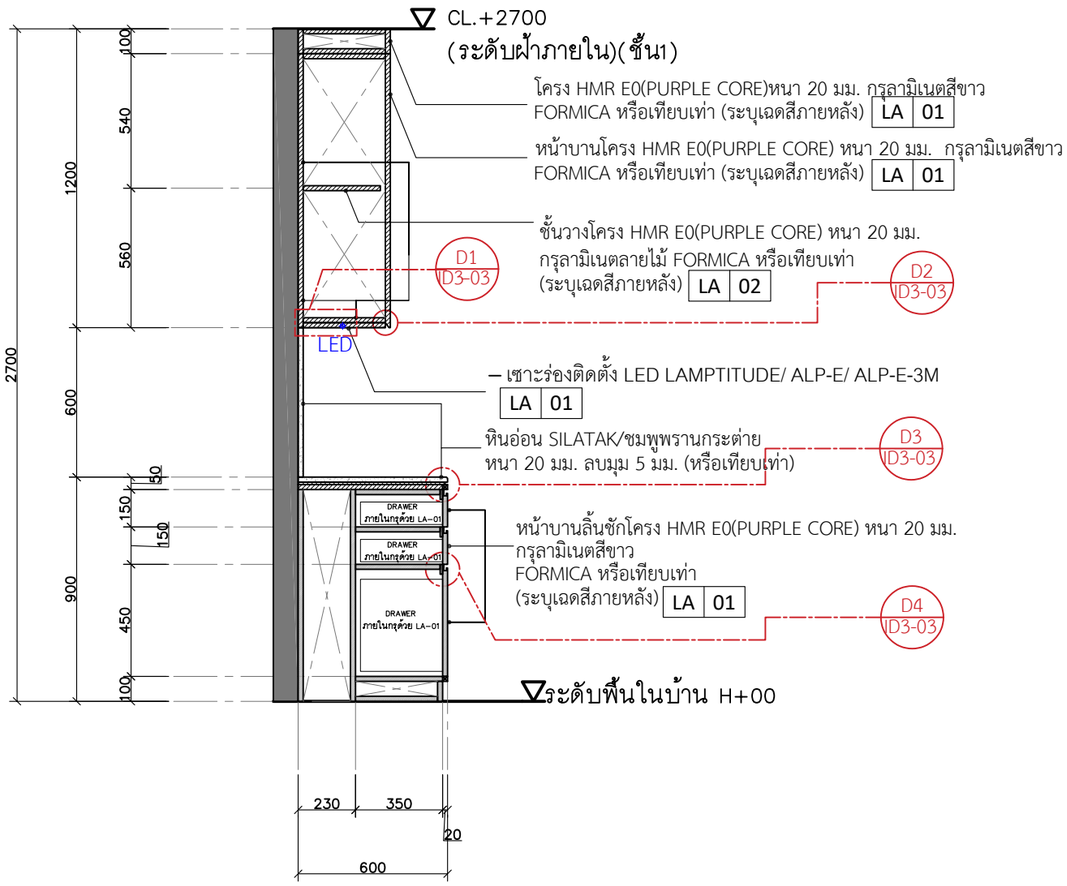

แบบขยาย (ส่วนครัว)
S5 SECTION 5
ID3-03 scale 1:25

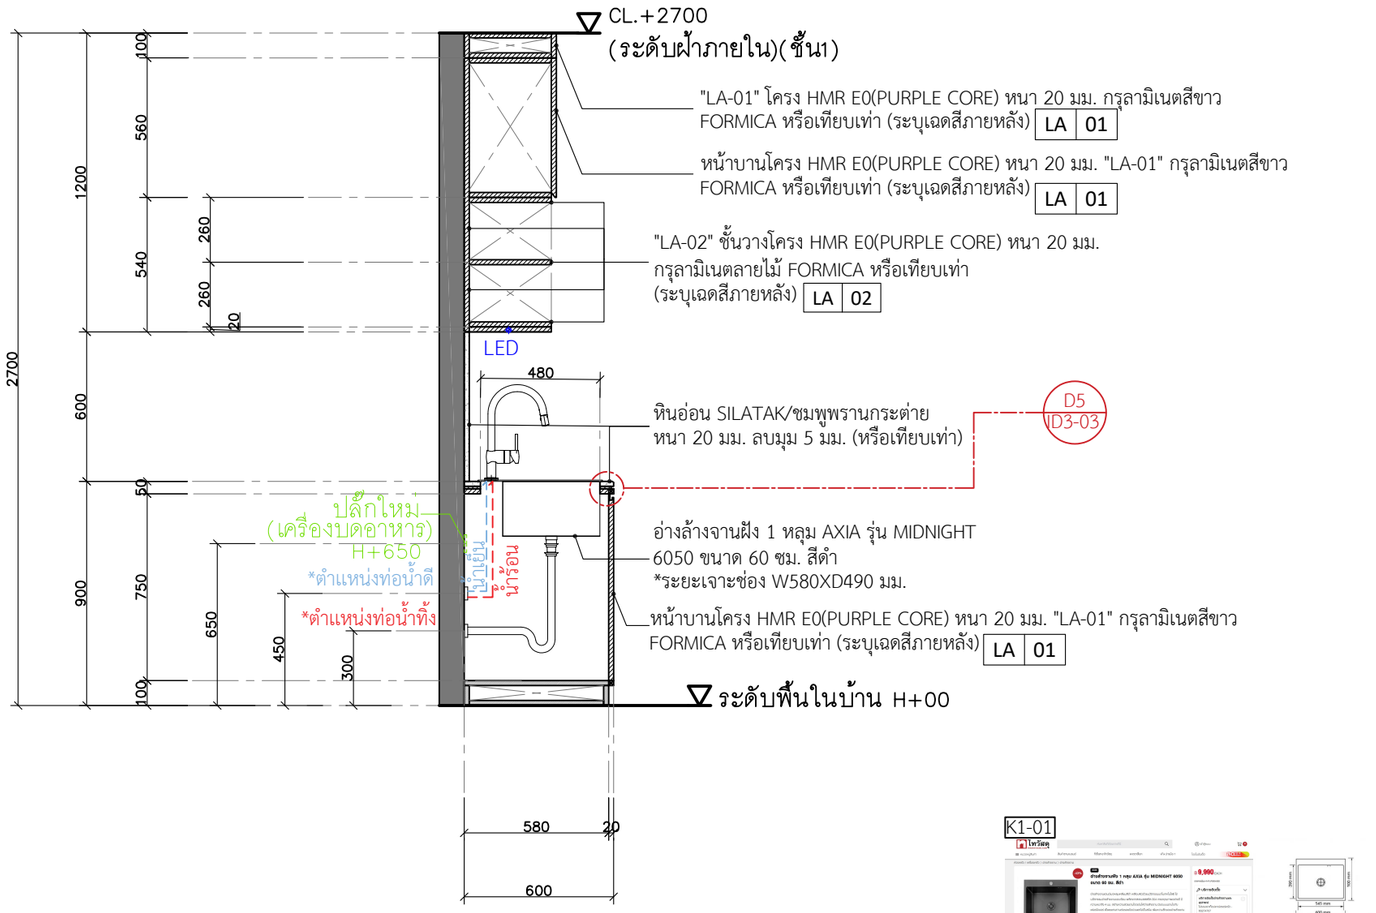

แบบขยาย (ส่วนครัว)
S6 SECTION 6
ID3-03 scale 1:25

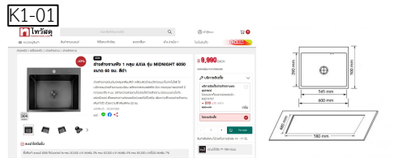

อ่างล้างจานฝัง 1 หลุม AXIA รุ่น MIDNIGHT 6050 ขนาด 60 ซม. สีดำ
*ระยะเจาะช่อง W580XD490 มม.

SPACEMAN

PROJECT: SONIA HOUSE
LOCATION: REIGNWOOD PARK LAMLUKKA, PATHUM THANI
ARCHITECT:
INTERIOR DESIGNER: ปรัตถกร ประมุขกุล ภ-สน 1438
STRUCTURAL ENGINEER:
TITLE: 1st FLOOR แบบขยายส่วนครัว SECTION 05 ,06
2026-05-06
ID3-03
1:25 @ A3

Note: SPACEMAN takes no responsibility for dimensions obtained by scaling from this drawing. If no dimension is shown the recipient must ascertain the dimension specifically from the architect or by site measurement and may not rely on the drawing. Supply of the drawing in digital form is solely for convenience and no reliance may be placed on any data in digital form. All data must be checked against hard copy. This drawing is issued for design intent only and should not be used for construction unless stated. This drawing is the property of SPACEMAN

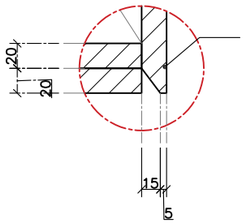

หน้าบานโครง HMR E0(PURPLE CORE) หนา 20 มม.
"LA-01" กรุลามิเนตสีขาว
FORMICA หรือเทียบเท่า
(ระบุเฉดสีภายหลัง) LA 01

D1 DETAIL 1
ID3-04 scale 1:5

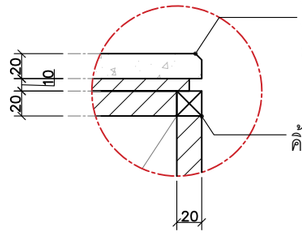

TOP COUNTER
หินอ่อน SILATAK/ชมพูพรานกระต่าย
หนา 20 มม. ลบมุม 5 มม. ST 01
(หรือเทียบเท่า)

คิ้วไม้ 20x20 มม.

D2 DETAIL 2
ID3-04 scale 1:5

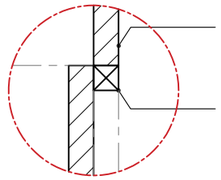

โครง HMR E0(PURPLE CORE) หนา 20 มม.
กรุด้วยลามิเนตลายไม้
FORMICA หรือเทียบเท่า
(ระบุภายหลัง) LA 02

คิ้วไม้ 20x20 มม.

D3 DETAIL 3
ID3-04 scale 1:5

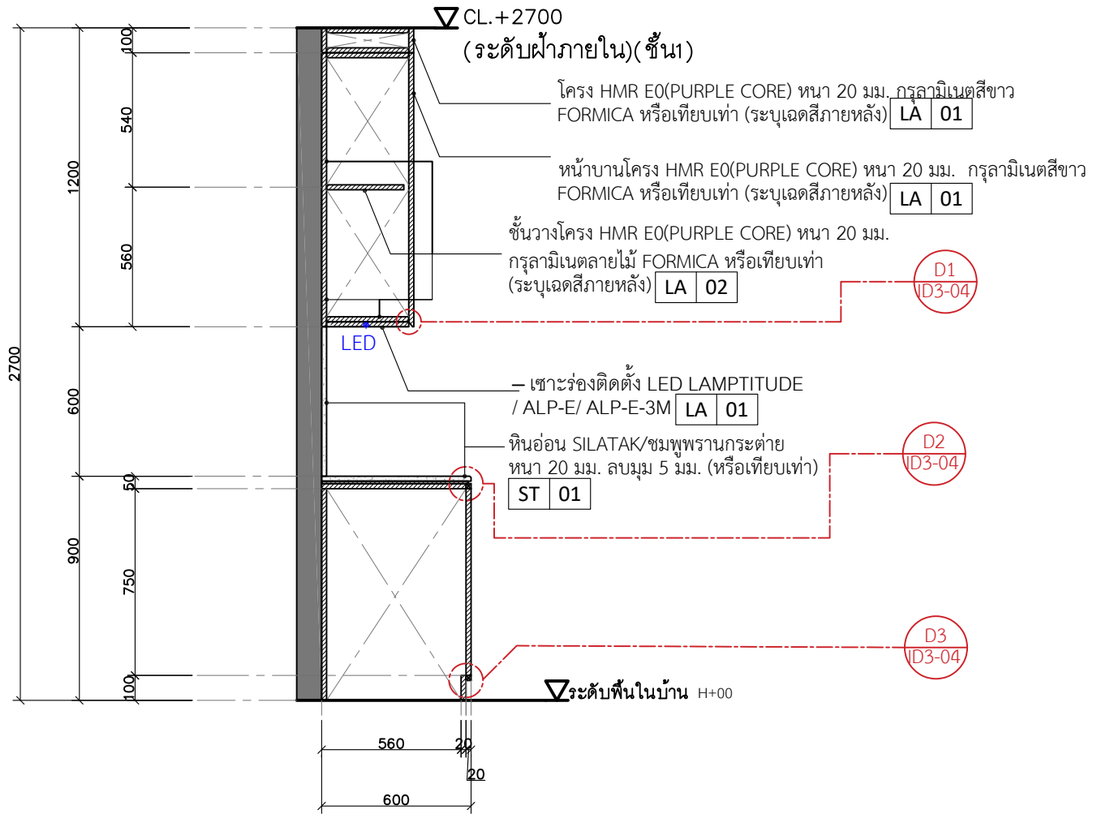

แบบขยาย (ส่วนครัว)
S7 SECTION 7
ID3-04 scale 1:25

SPACEMAN	PROJECT: SONIA HOUSE	LOCATION: REIGNWOOD PARK LAMLUKKA, PATHUM THANI	ARCHITECT	INTERIOR DESIGNER: ปรัตถกร ประมุขกุล ภ-สน 1438	STRUCTURAL ENGINEER	TITLE: 1st FLOOR แบบขยายส่วนครัว SECTION 07	2026-05-06 ID3-04

Note: SPACEMAN takes no responsibility for dimensions obtained by scaling from this drawing. If no dimension is shown the recipient must ascertain the dimension specifically from the architect or by site measurement and may not rely on the drawing. Supply of the drawing in digital form is solely for convenience and no reliance may be placed on any data in digital form. All data must be checked against hard copy. This drawing is issued for design intent only and should not be used for construction unless stated. This drawing is the property of SPACEMAN

1:25 @ A3

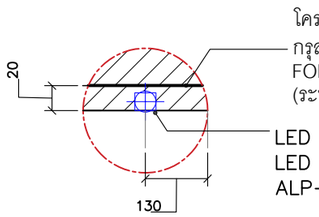

D1 DETAIL 1
ID3-05 scale 1:5

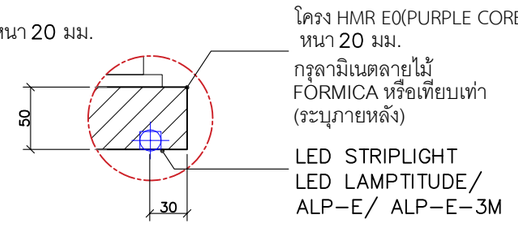

D2 DETAIL 2
ID3-05 scale 1:5

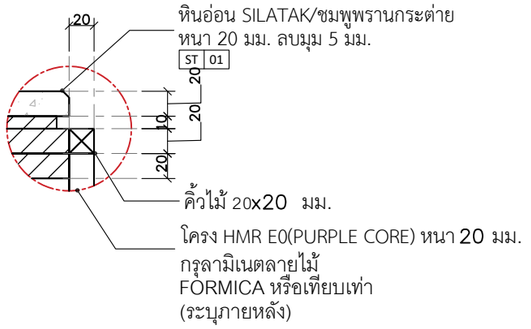

D3 DETAIL 3
ID3-05 scale 1:5

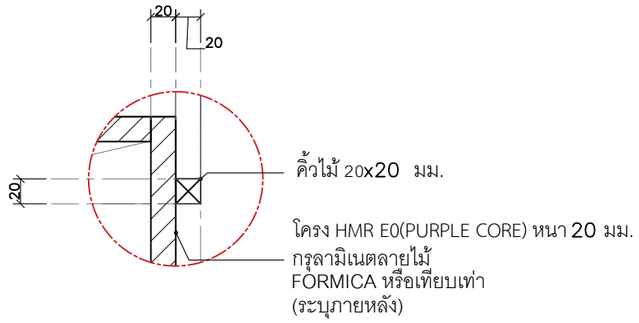

D4 DETAIL 4
ID3-05 scale 1:5

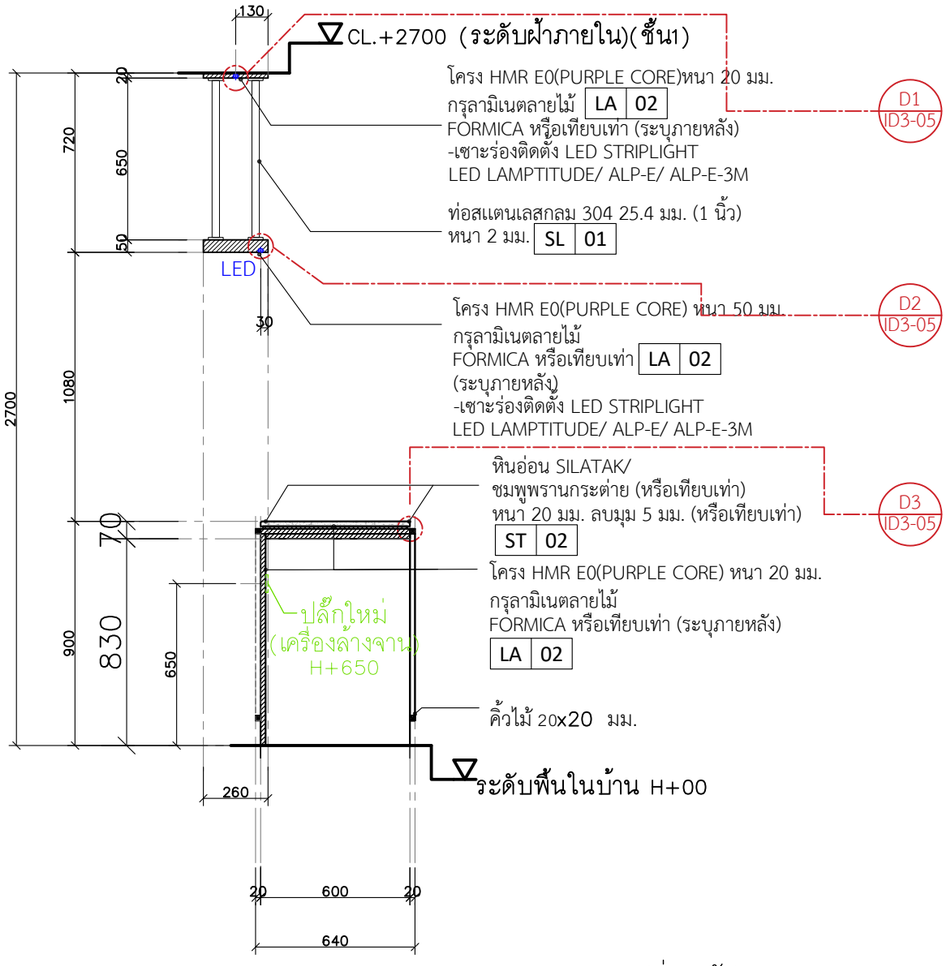

แบบขยาย (ส่วนครัว)
S8 SECTION 8
ID3-05 scale 1:25

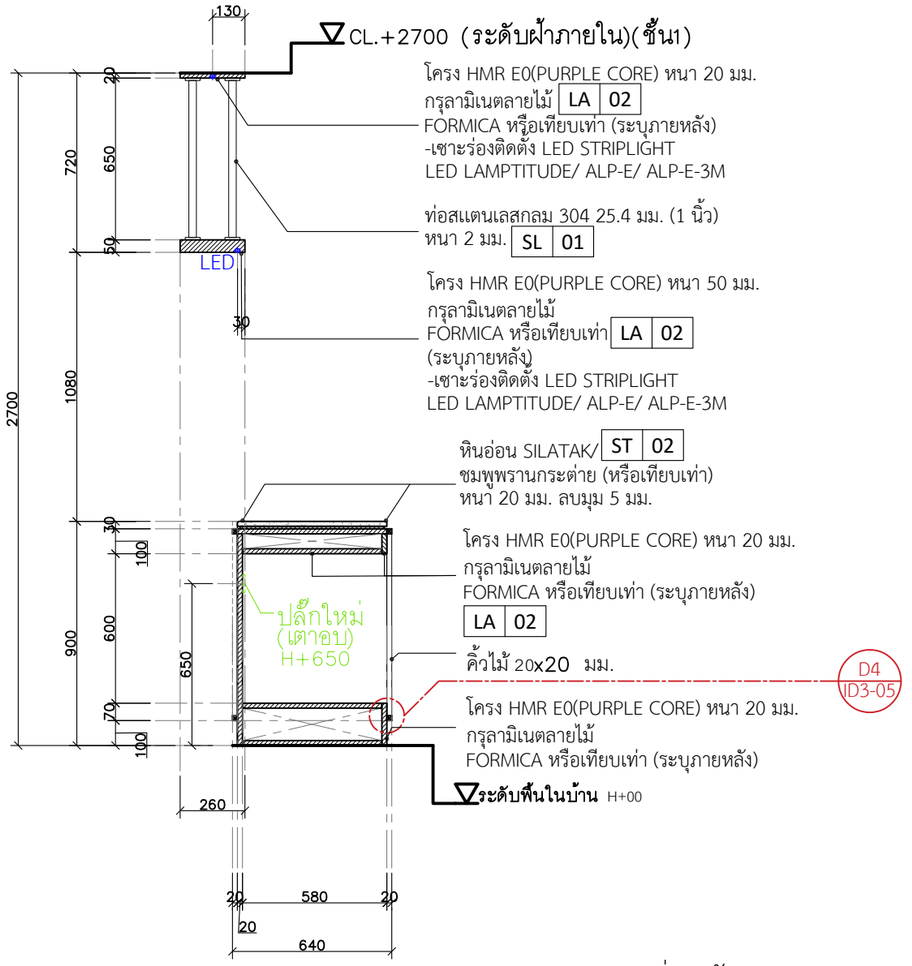

แบบขยาย (ส่วนครัว)
S9 SECTION 9
ID3-05 scale 1:25

SPACEMAN

PROJECT SONIA HOUSE

LOCATION REIGNWOOD PARK
LAMLUKKA, PATHUM THANI

ARCHITECT

INTERIOR DESIGNER ปรัตถกร ประมุขกุล ภ-สน 1438

STRUCTURAL ENGINEER

TITLE 1st FLOOR,
แบบขยายส่วนครัว
SECTION 08 ,09

2026-05-06
ID3-05

1:25 @ A3

Note: SPACEMAN takes no responsibility for dimensions obtained by scaling from this drawing. If no dimension is shown the recipient must ascertain the dimension specifically from the architect or by site measurement and may not rely on the drawing. Supply of the drawing in digital form is solely for convenience and no reliance may be placed on any data in digital form. All data must be checked against hard copy. This drawing is issued for design intent only and should not be used for construction unless stated. This drawing is the property of SPACEMAN

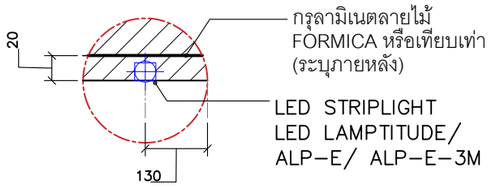

D1 DETAIL 1
ID3-06 scale 1:5

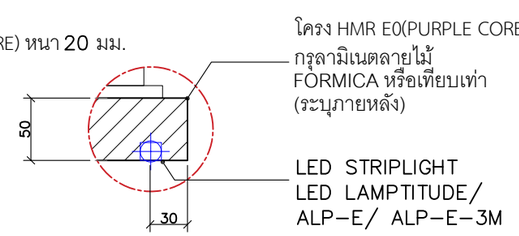

D2 DETAIL 2
ID3-06 scale 1:5

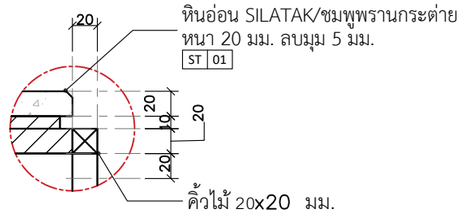

D3 DETAIL 3
ID3-06 scale 1:5

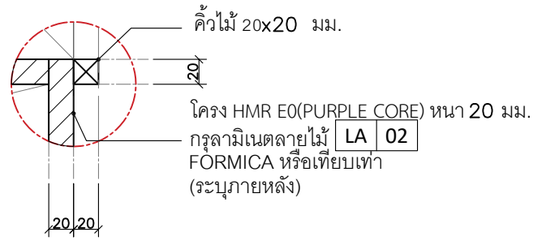

D4 DETAIL 4
ID3-06 scale 1:5

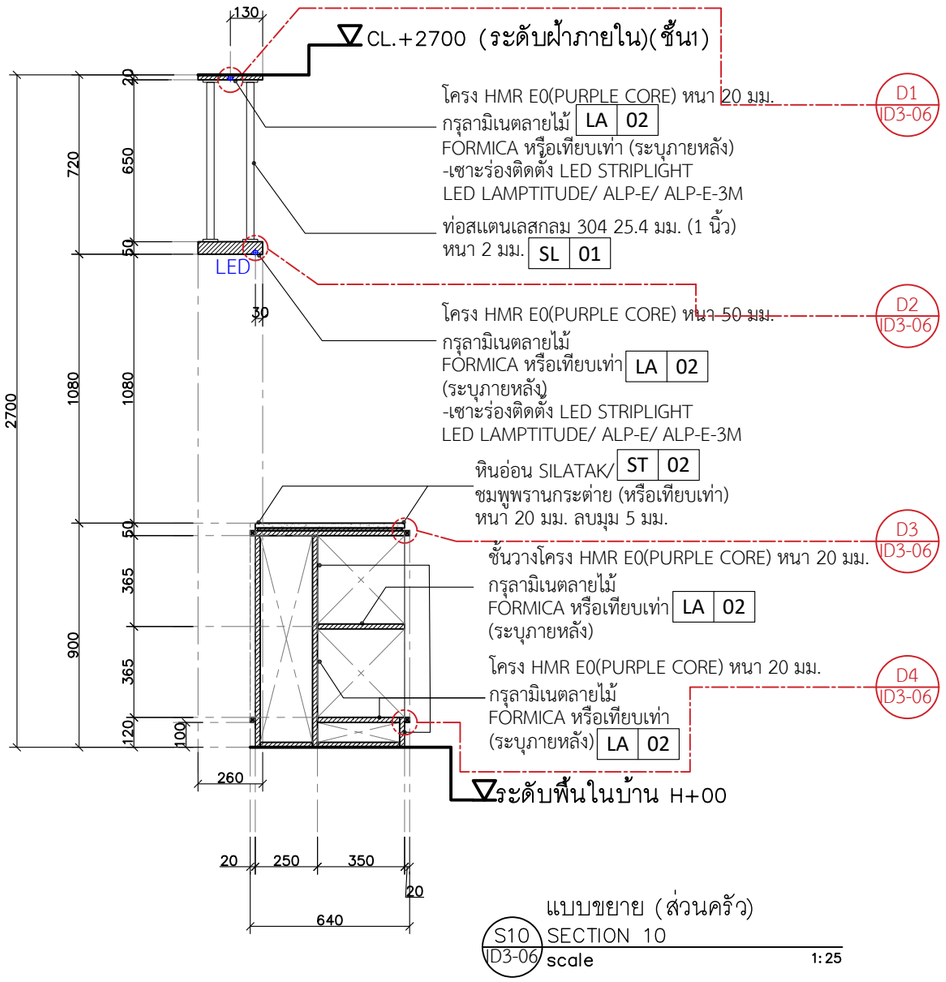

แบบขยาย (ส่วนครัว)
S10 SECTION 10
ID3-06 scale 1:25

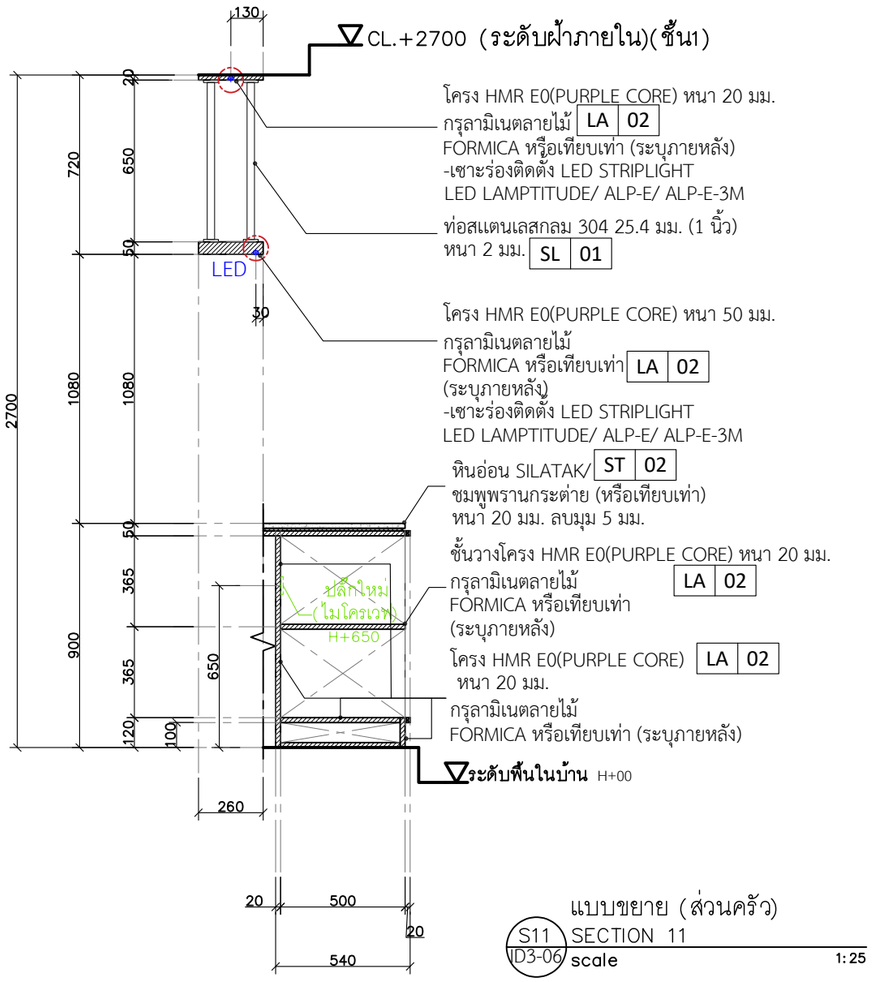

แบบขยาย (ส่วนครัว)
S11 SECTION 11
ID3-06 scale 1:25

SPACEMAN

PROJECT: SONIA HOUSE

LOCATION: REIGNWOOD PARK
LAMLUKKA, PATHUM THANI

ARCHITECT

INTERIOR DESIGNER: ปรัตถกร ประมุขกุล ภ-สน 1438

STRUCTURAL ENGINEER

TITLE: 1st FLOOR
แบบขยายส่วนครัว
SECTION 10 ,11

2026-05-06
ID3-06

1:25 @ A3

Note: SPACEMAN takes no responsibility for dimensions obtained by scaling from this drawing. If no dimension is shown the recipient must ascertain the dimension specifically from the architect or by site measurement and may not rely on the drawing. Supply of the drawing in digital form is solely for convenience and no reliance may be placed on any data in digital form. All data must be checked against hard copy. This drawing is issued for design intent only and should not be used for construction unless stated. This drawing is the property of SPACEMAN

*ผู้รับเหมาตรวจสอบคู่มือของอุปกรณ์
ก่อนดำเนินการ

D1–03 / PLAYROOM

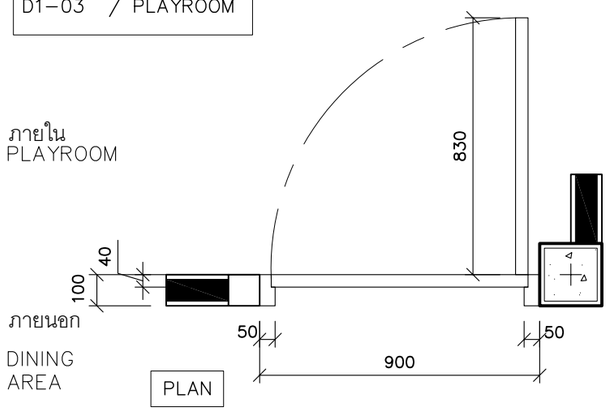

PLAN

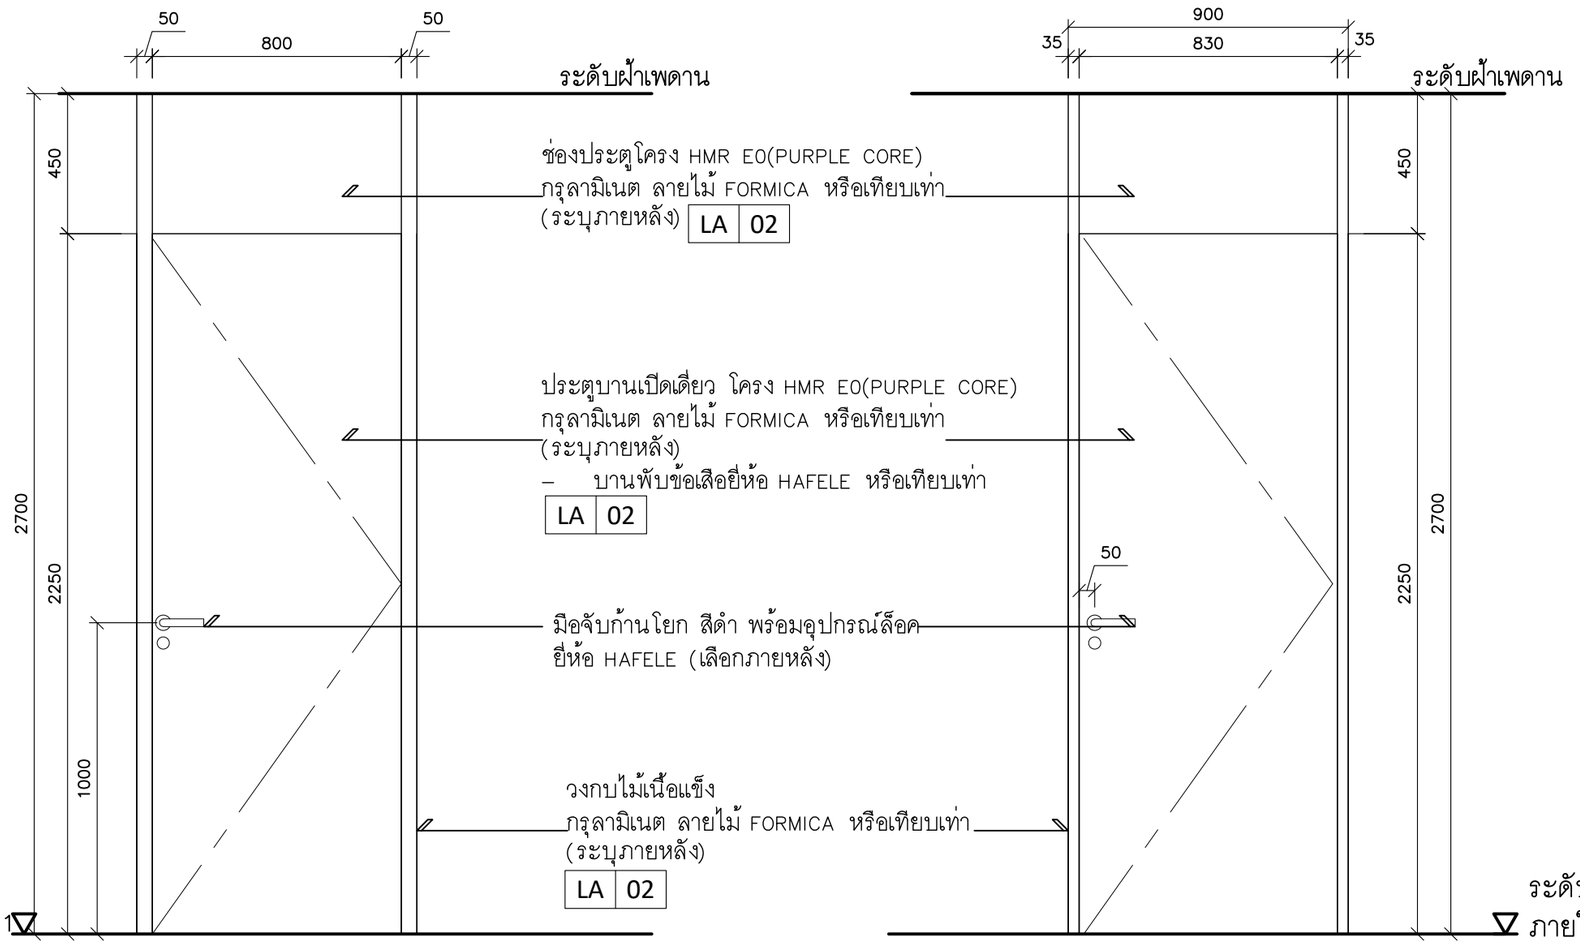

ภายนอก

ภายใน

SPACEMAN

PROJECT: SONIA HOUSE

LOCATION:

ARCHITECT:

INTERIOR DESIGNER: ปรัตถกร ประมุขกุล ภ–สน 1438

STRUCTURAL ENGINEER:

TITLE: D1–03 แบบขยายบริเวณครัว
DOOR PLAN AND ELEVATION

2026–04–28
ID6–01
1:20 @ A3

Note: SPACEMAN takes no responsibility for dimensions obtained by scaling from this drawing. If no dimension is shown the recipient must ascertain the dimension specifically from the architect or by site measurement and may not rely on the drawing. Supply of the drawing in digital form is solely for convenience and no reliance may be placed on any data in digital form. All data must be checked against hard copy. This drawing is issued for design intent only and should not be used for construction unless stated. This drawing is the property of SPACEMAN

SONIA HOUSE

REIGNWOOD PARK

LAMLUKKA, PATHUM THANI

แบบขยายตรงข้ามครัว

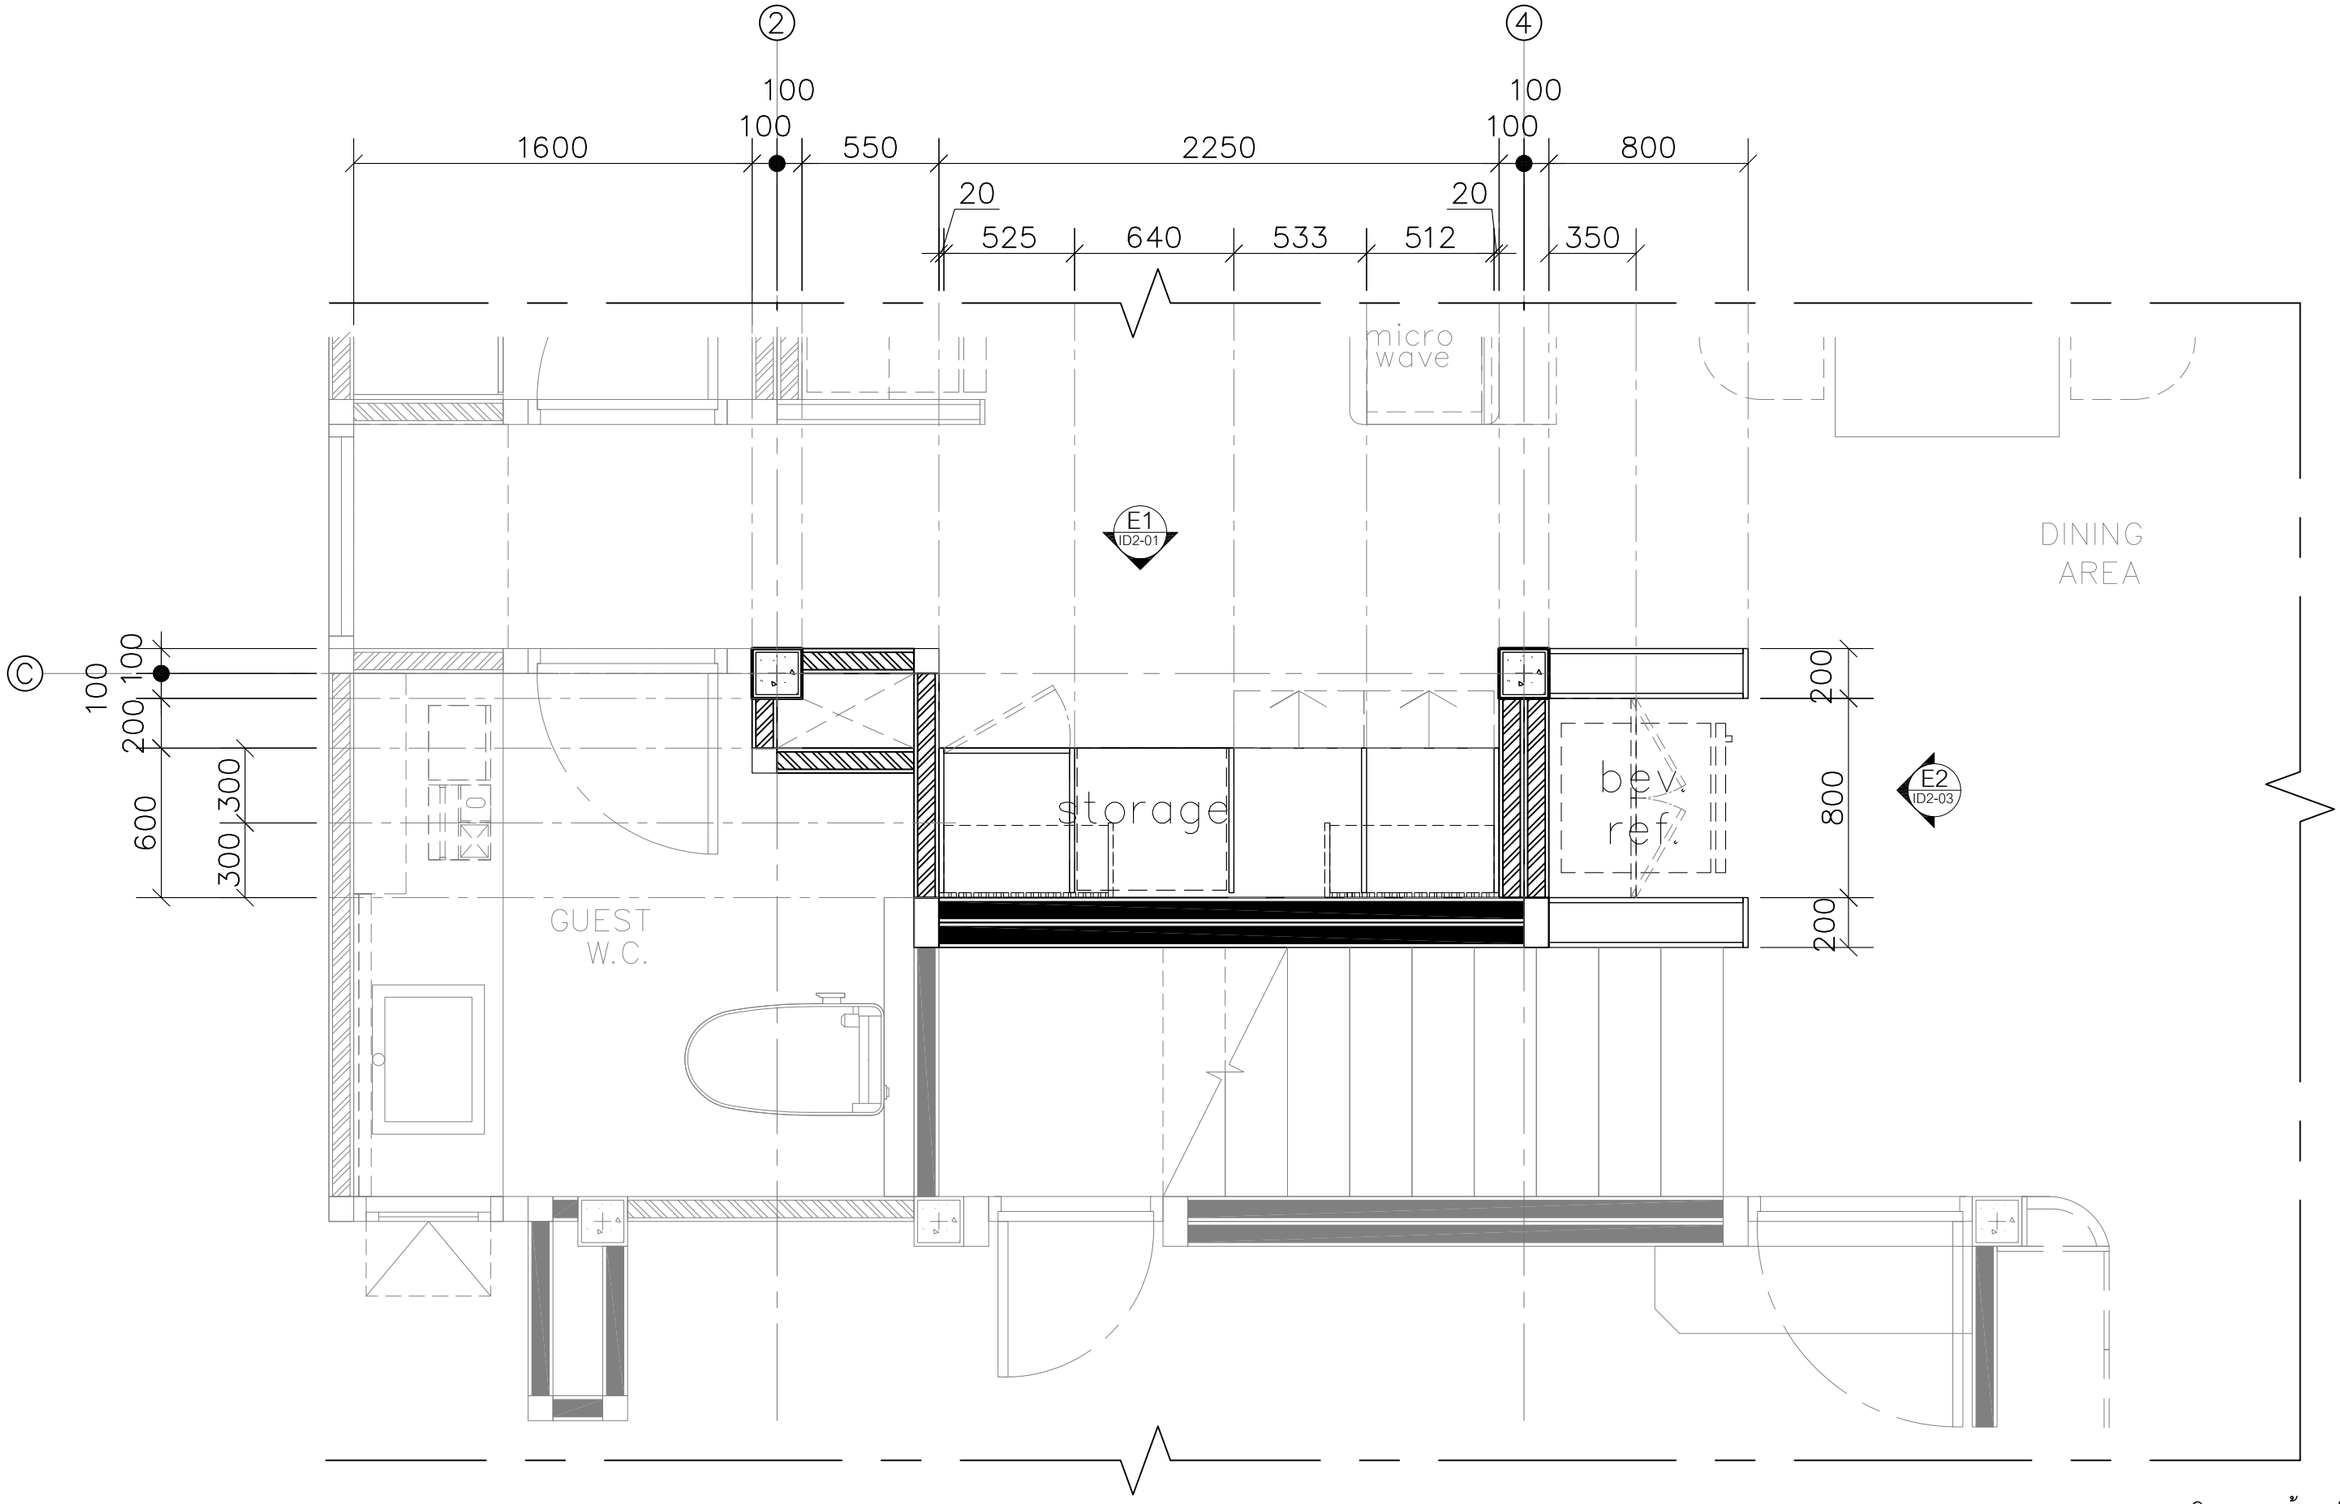

FURNITURE LAYOUT PLAN (แบบขยายบริเวณตรงข้ามครัว)

scale 1:25

SPACEMAN

PROJECT: SONIA HOUSE

LOCATION: REIGNWOOD PARK LAMLUKKA, PATHUM THANI

ARCHITECT:

INTERIOR DESIGNER: ปรัตถกร ประมุขกุล ภ-สน 1438

STRUCTURAL ENGINEER:

TITLE: 1st FLOOR FURNITURE LAYOUT PLAN (แบบขยายบริเวณตรงข้ามครัว)

2026-02-04
ID1-01
1:25 @ A3

Note: SPACEMAN takes no responsibility for dimensions obtained by scaling from this drawing. If no dimension is shown the recipient must ascertain the dimension specifically from the architect or by site measurement and may not rely on the drawing. Supply of the drawing in digital form is solely for convenience and no reliance may be placed on any data in digital form. All data must be checked against hard copy. This drawing is issued for design intent only and should not be used for construction unless stated. This drawing is the property of SPACEMAN

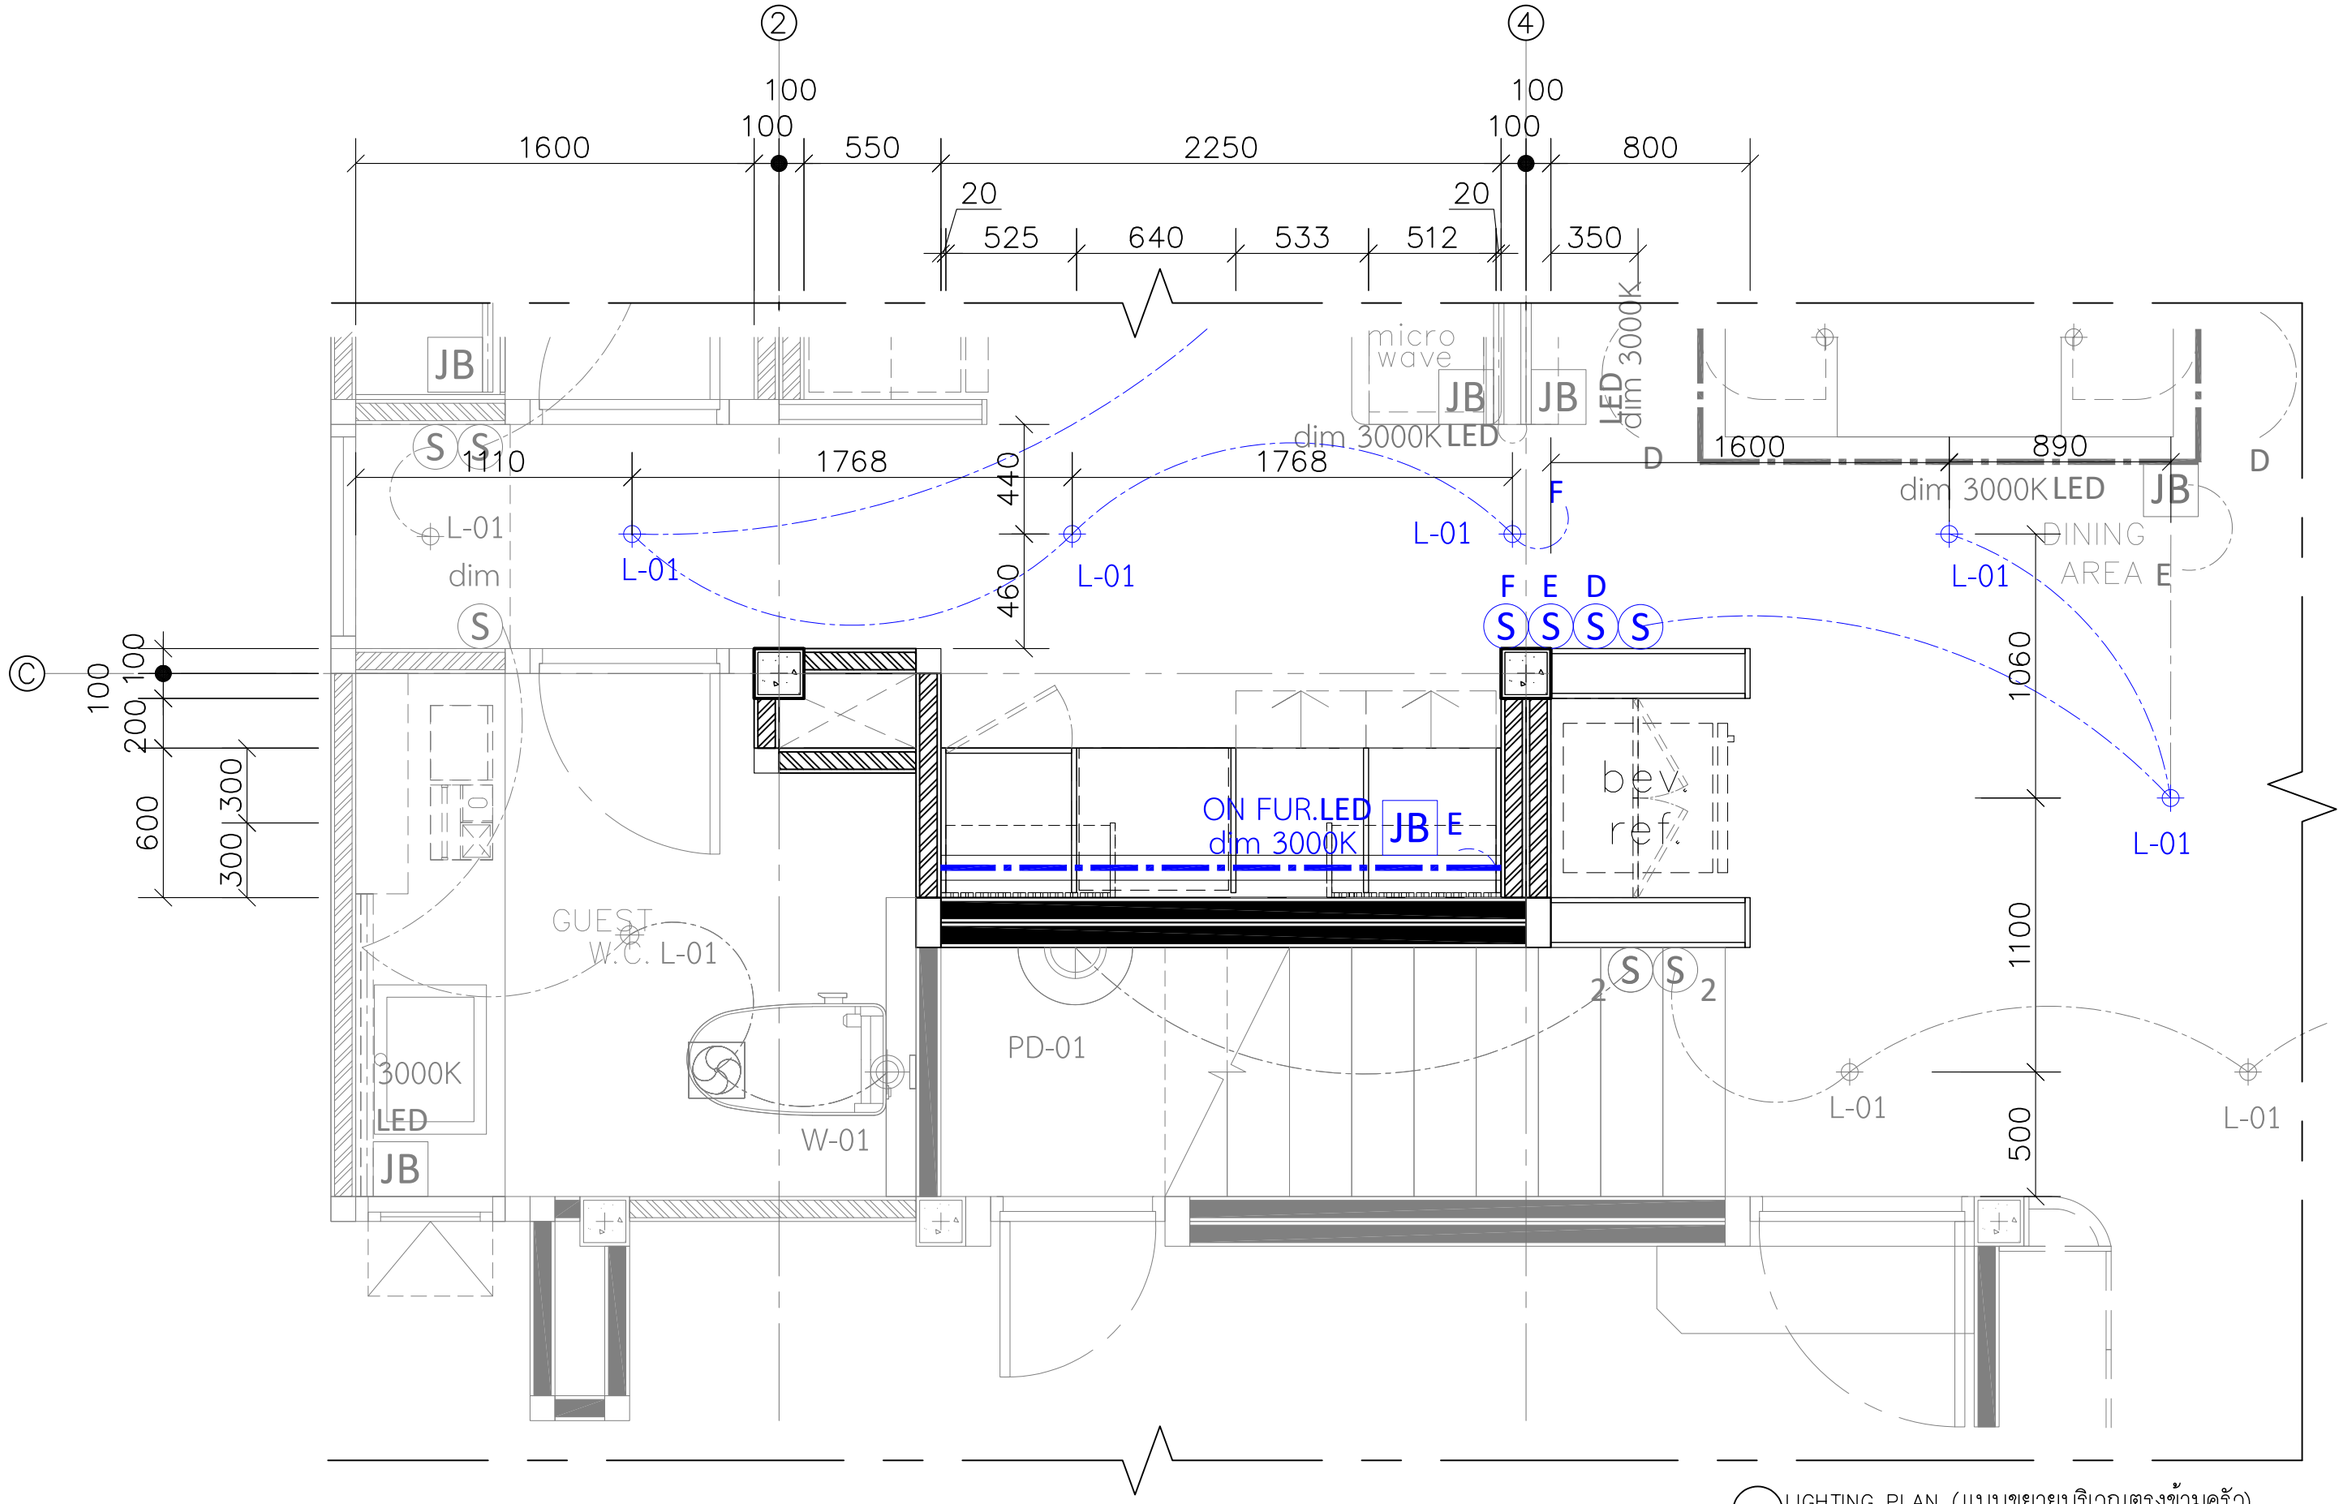

LIGHTING PLAN (แบบขยายบริเวณตรงข้ามครัว)
scale 1:25

SPACEMAN

PROJECT: SONIA HOUSE
LOCATION: REIGNWOOD PARK LAMLUKKA, PATHUM THANI
ARCHITECT:
INTERIOR DESIGNER: ปรัตถกร ประมุขกุล ภ-สน 1438
STRUCTURAL ENGINEER:
TITLE: 1st FLOOR LIGHTING PLAN (แบบขยายบริเวณตรงข้ามครัว)
2026-02-04
ID1-02
1:25 @ A3

Note: SPACEMAN takes no responsibility for dimensions obtained by scaling from this drawing. If no dimension is shown the recipient must ascertain the dimension specifically from the architect or by site measurement and may not rely on the drawing. Supply of the drawing in digital form is solely for convenience and no reliance may be placed on any data in digital form. All data must be checked against hard copy. This drawing is issued for design intent only and should not be used for construction unless stated. This drawing is the property of SPACEMAN

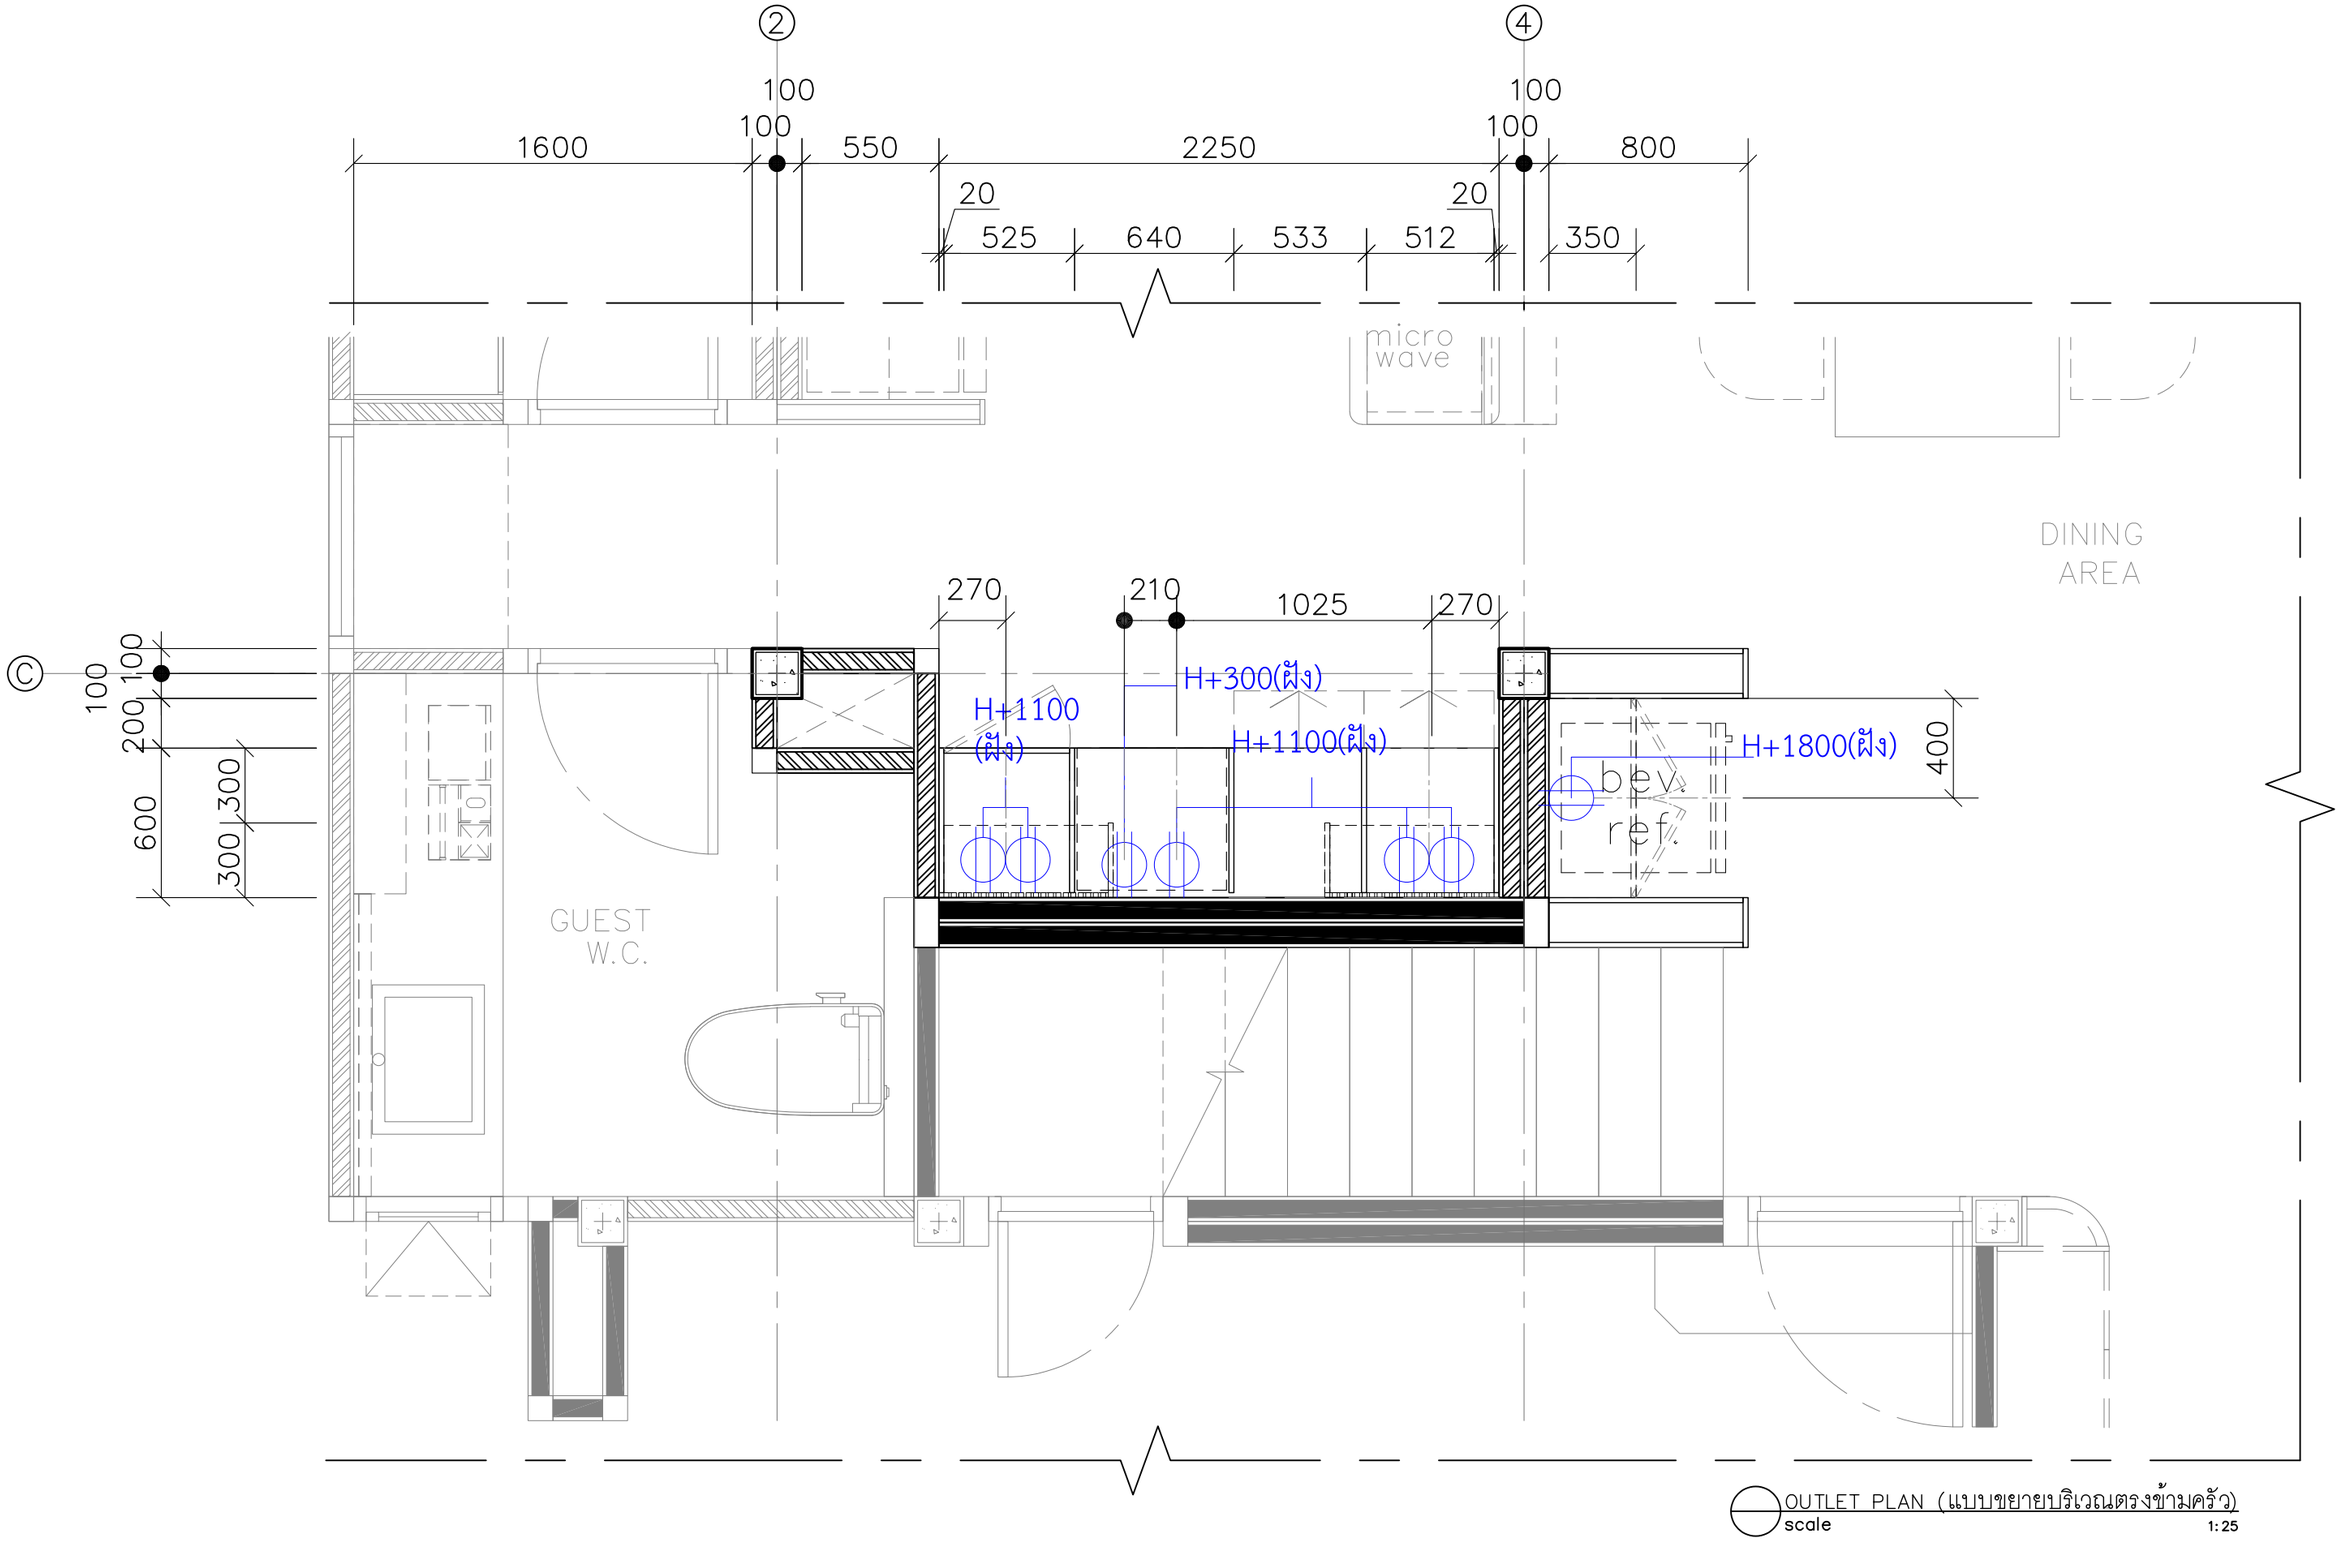

OUTLET PLAN (แบบขยายบริเวณตรงข้ามครัว)
scale 1:25

SPACEMAN

PROJECT: SONIA HOUSE

LOCATION: REIGNWOOD PARK
LAMLUKKA, PATHUM THANI

ARCHITECT:

INTERIOR DESIGNER: ปรัตถกร ประมุขกุล ภ-สน 1438

STRUCTURAL ENGINEER:

TITLE: 1st FLOOR
OUTLET PLAN
(แบบขยายบริเวณตรงข้ามครัว)

2026-02-04
ID1-03
1:25 @ A3

Note: SPACEMAN takes no responsibility for dimensions obtained by scaling from this drawing. If no dimension is shown the recipient must ascertain the dimension specifically from the architect or by site measurement and may not rely on the drawing. Supply of the drawing in digital form is solely for convenience and no reliance may be placed on any data in digital form. All data must be checked against hard copy. This drawing is issued for design intent only and should not be used for construction unless stated. This drawing is the property of SPACEMAN

WALL LIST

2 ผนังก่ออิฐฉาบปูน ทาสีซุปเปอร์ชิลด์ สีน้ำอะคริลิก ชนิดกึ่งเงา สีขาว (ระบุเฉดสีภายหลัง)

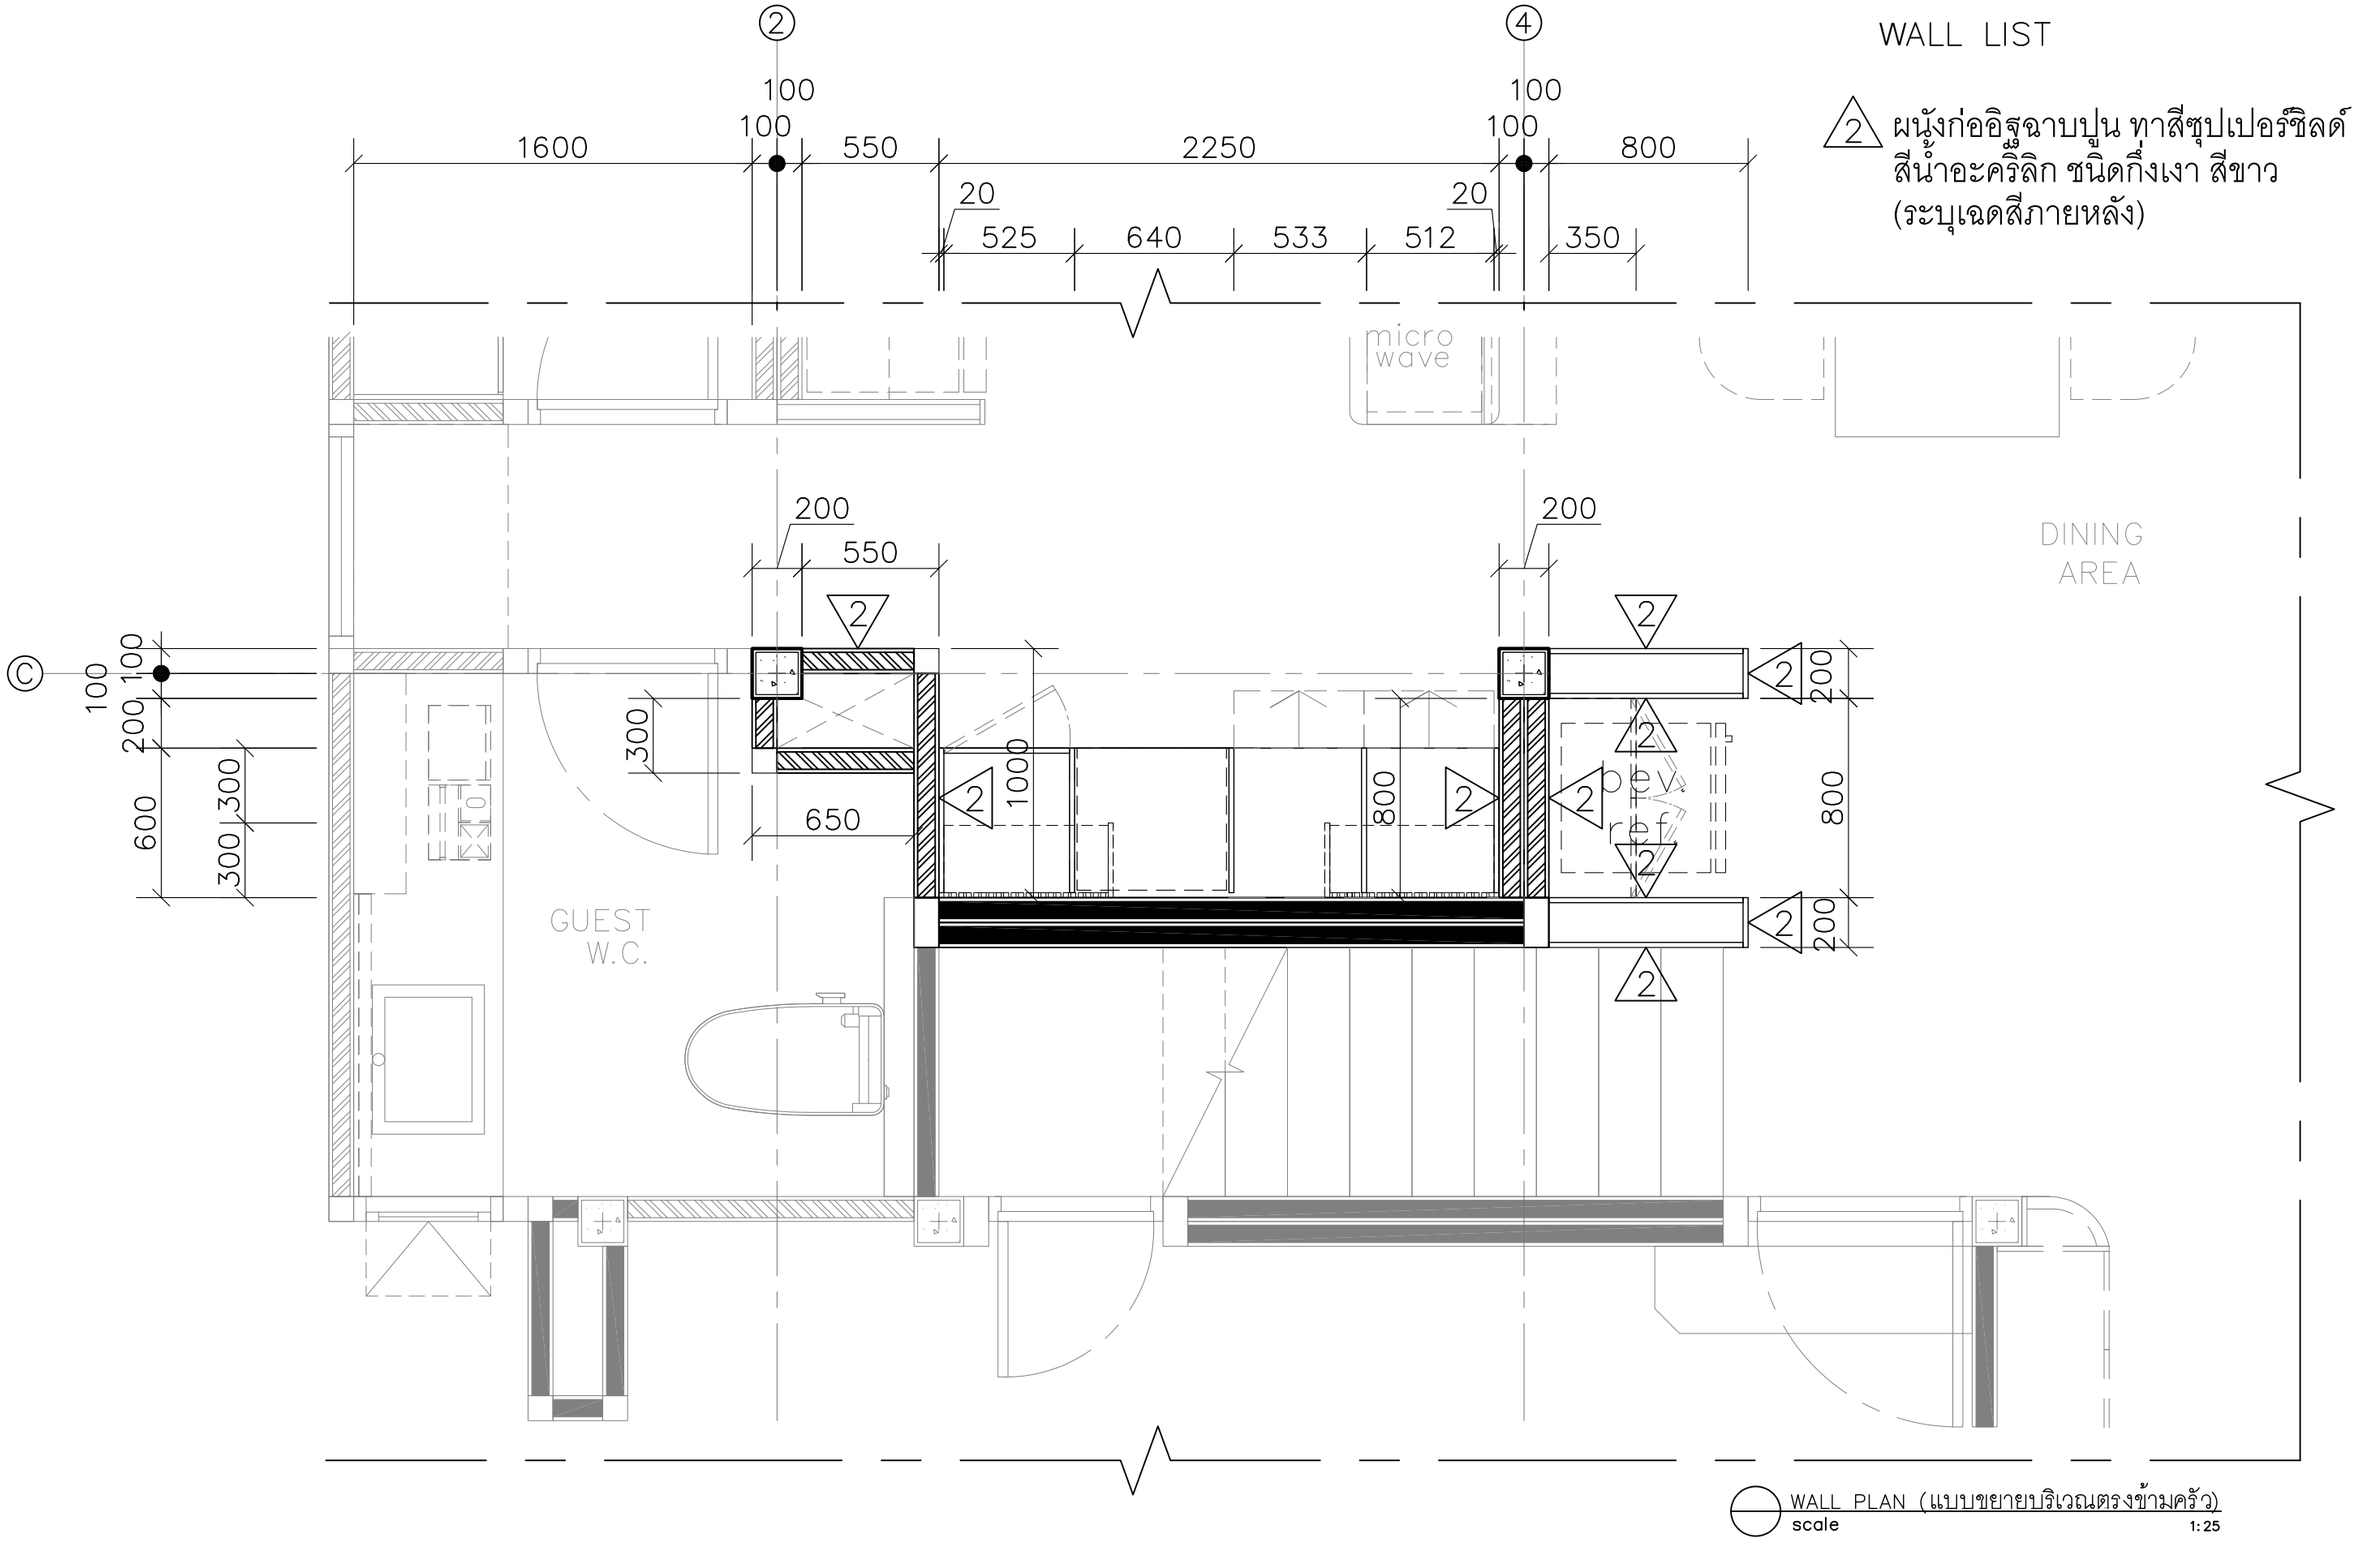

WALL PLAN (แบบขยายบริเวณตรงข้ามครัว)
scale 1:25

SPACEMAN	PROJECT: SONIA HOUSE	LOCATION: REIGNWOOD PARK LAMLUKKA, PATHUM THANI	ARCHITECT	INTERIOR DESIGNER: ปรัตถกร ประมุขกุล ภ-สน 1438	STRUCTURAL ENGINEER	TITLE: 1st FLOOR WALL PLAN (แบบขยายบริเวณตรงข้ามครัว)	2026-02-04 ID1-04

Note: SPACEMAN takes no responsibility for dimensions obtained by scaling from this drawing. If no dimension is shown the recipient must ascertain the dimension specifically from the architect or by site measurement and may not rely on the drawing. Supply of the drawing in digital form is solely for convenience and no reliance may be placed on any data in digital form. All data must be checked against hard copy. This drawing is issued for design intent only and should not be used for construction unless stated. This drawing is the property of SPACEMAN

1:25 @ A3

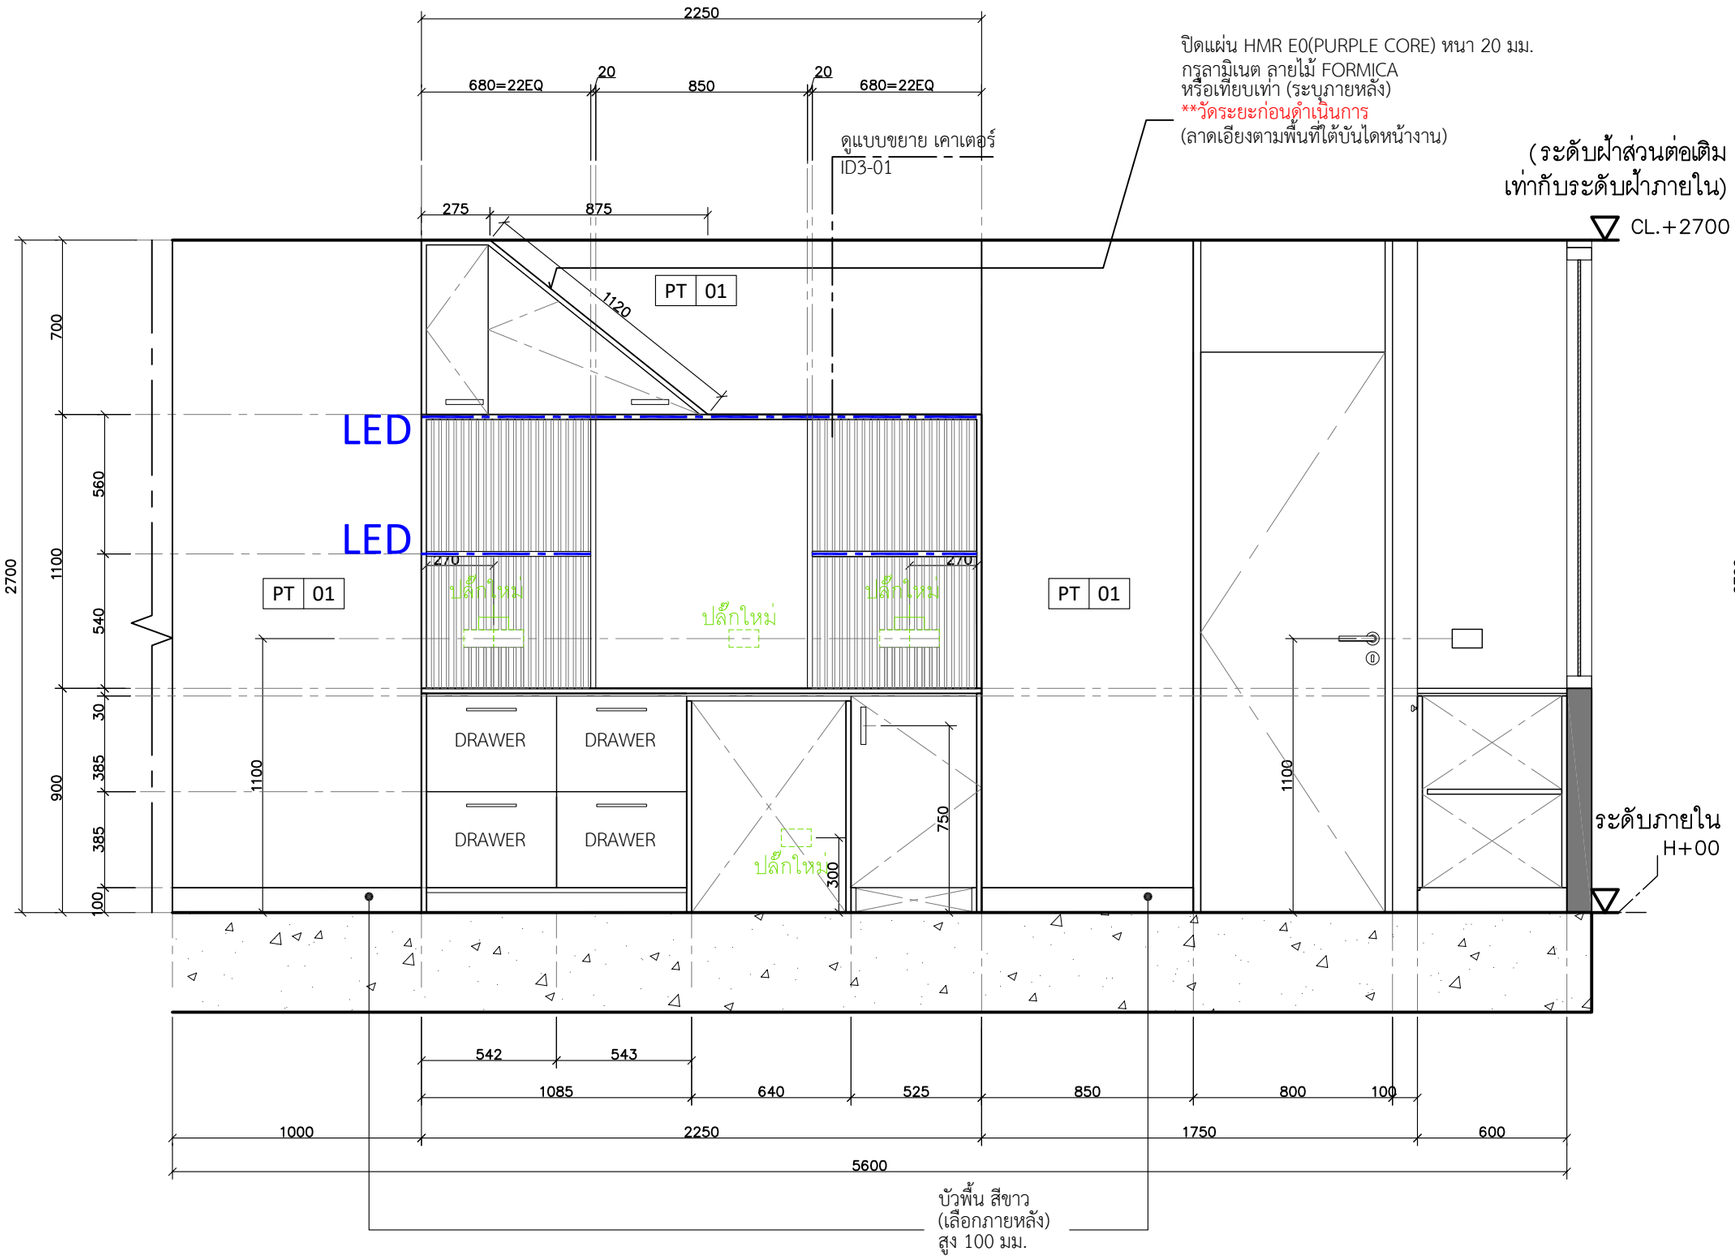

บริเวณตรงข้ามครัว
ELEVATION 1
scale 1:25

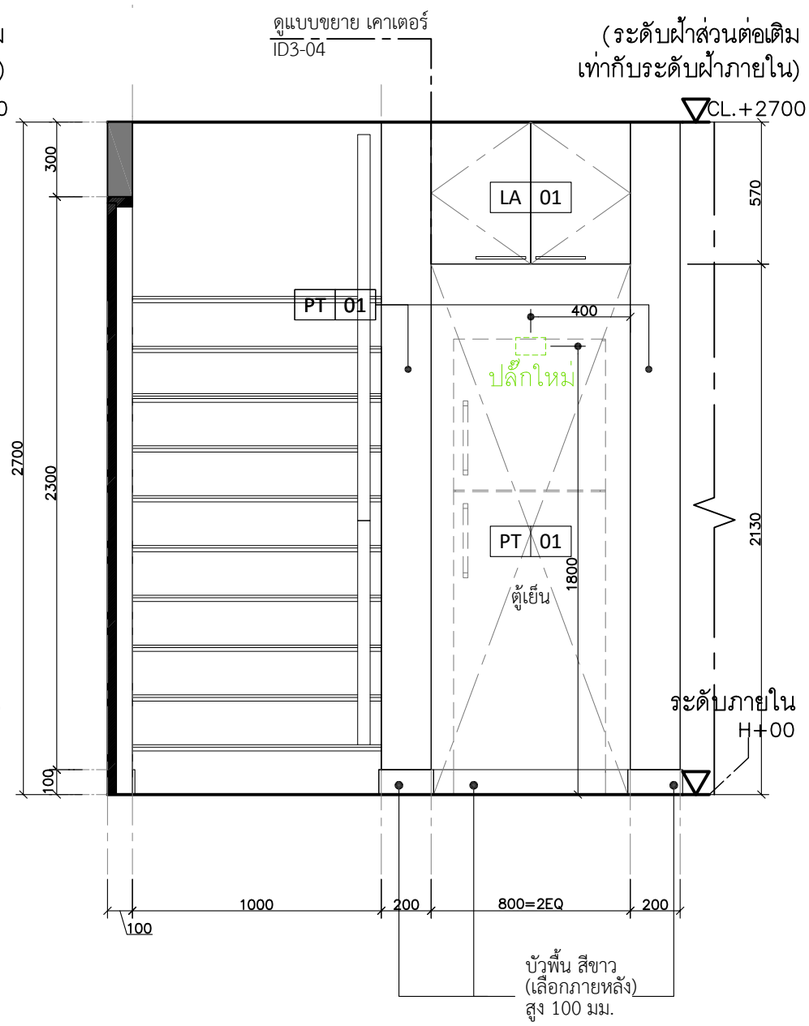

บริเวณตรงทางขึ้นบันได
ELEVATION 2
scale 1:25

SPACEMAN

PROJECT: SONIA HOUSE

LOCATION: REIGNWOOD PARK
LAMLUKKA, PATHUM THANI

ARCHITECT:

INTERIOR DESIGNER: ปรัตถกร ประมุขกุล ภ-สน 1438

STRUCTURAL ENGINEER:

TITLE: 1st FLOOR
แบบขยายบริเวณตรงข้ามครัว
ELEVATION 01

2026-02-04
ID2-01
1:25 @ A3

Note: SPACEMAN takes no responsibility for dimensions obtained by scaling from this drawing. If no dimension is shown the recipient must ascertain the dimension specifically from the architect or by site measurement and may not rely on the drawing. Supply of the drawing in digital form is solely for convenience and no reliance may be placed on any data in digital form. All data must be checked against hard copy. This drawing is issued for design intent only and should not be used for construction unless stated. This drawing is the property of SPACEMAN

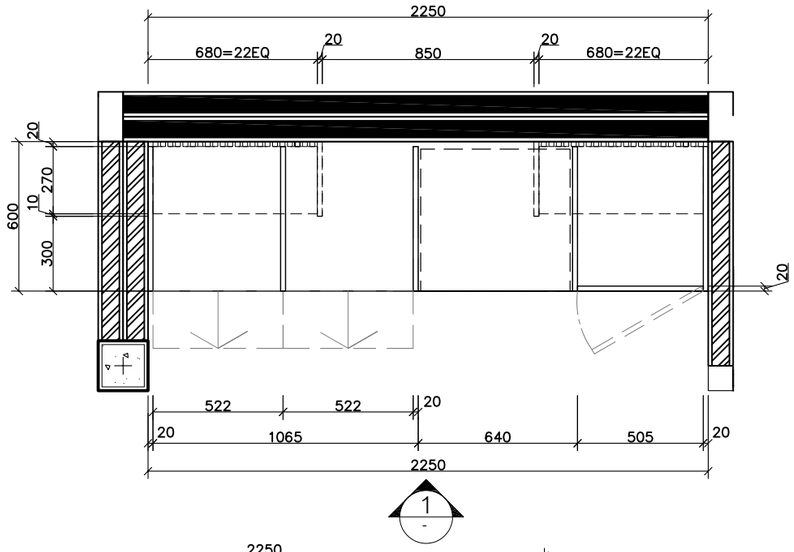

แบบขยายเคาเตอร์
บริเวณตรงข้ามครัว
PLAN

scale 1:25

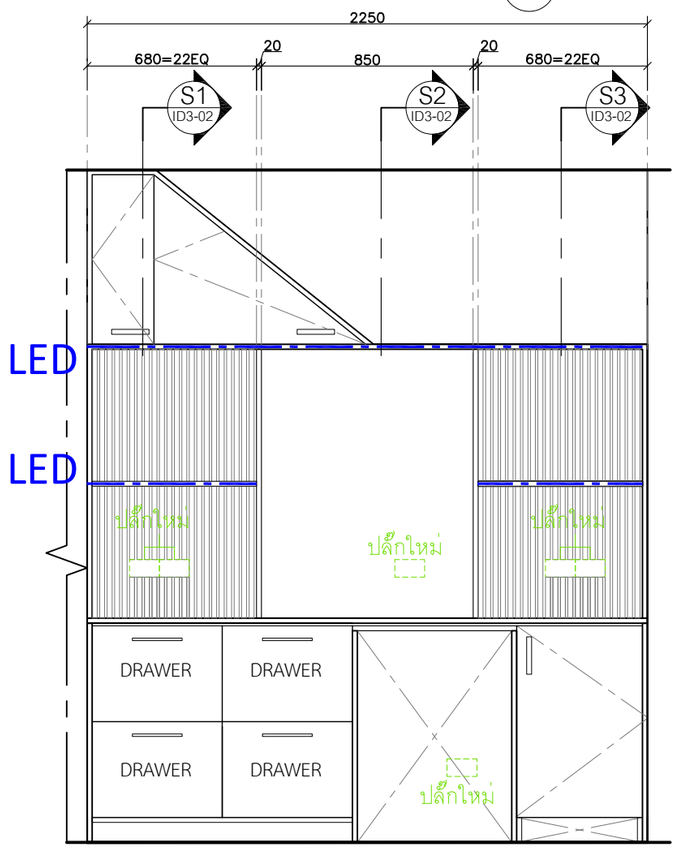

แบบขยายเคาเตอร์
บริเวณตรงข้ามครัว
ELEVATION 1

scale 1:25

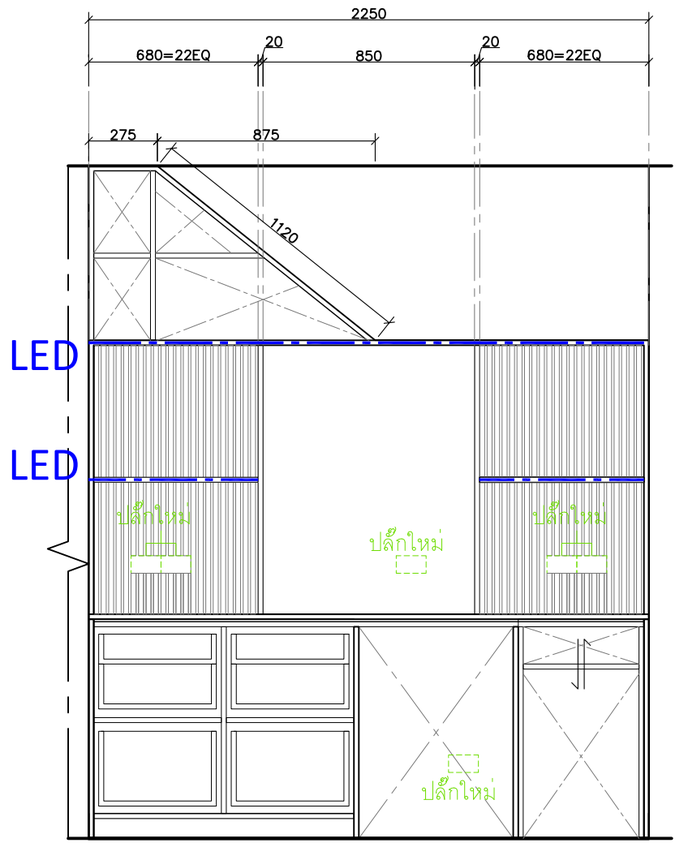

แบบขยายเคาเตอร์ (ภายใน)
บริเวณตรงข้ามครัว
ELEVATION 1

scale 1:25

SPACEMAN

PROJECT: SONIA HOUSE

LOCATION: REIGNWOOD PARK
LAMLUKKA, PATHUM THANI

ARCHITECT:

INTERIOR DESIGNER: ปรัตถกร ประมุขกุล ภ-สน 1438

STRUCTURAL ENGINEER:

TITLE: 1st FLOOR
แบบขยายบริเวณตรงข้ามครัว
ELEVATION 01

2026-02-04
ID3-01

Note: SPACEMAN takes no responsibility for dimensions obtained by scaling from this drawing. If no dimension is shown the recipient must ascertain the dimension specifically from the architect or by site measurement and may not rely on the drawing. Supply of the drawing in digital form is solely for convenience and no reliance may be placed on any data in digital form. All data must be checked against hard copy. This drawing is issued for design intent only and should not be used for construction unless stated. This drawing is the property of SPACEMAN

1:25 @ A3

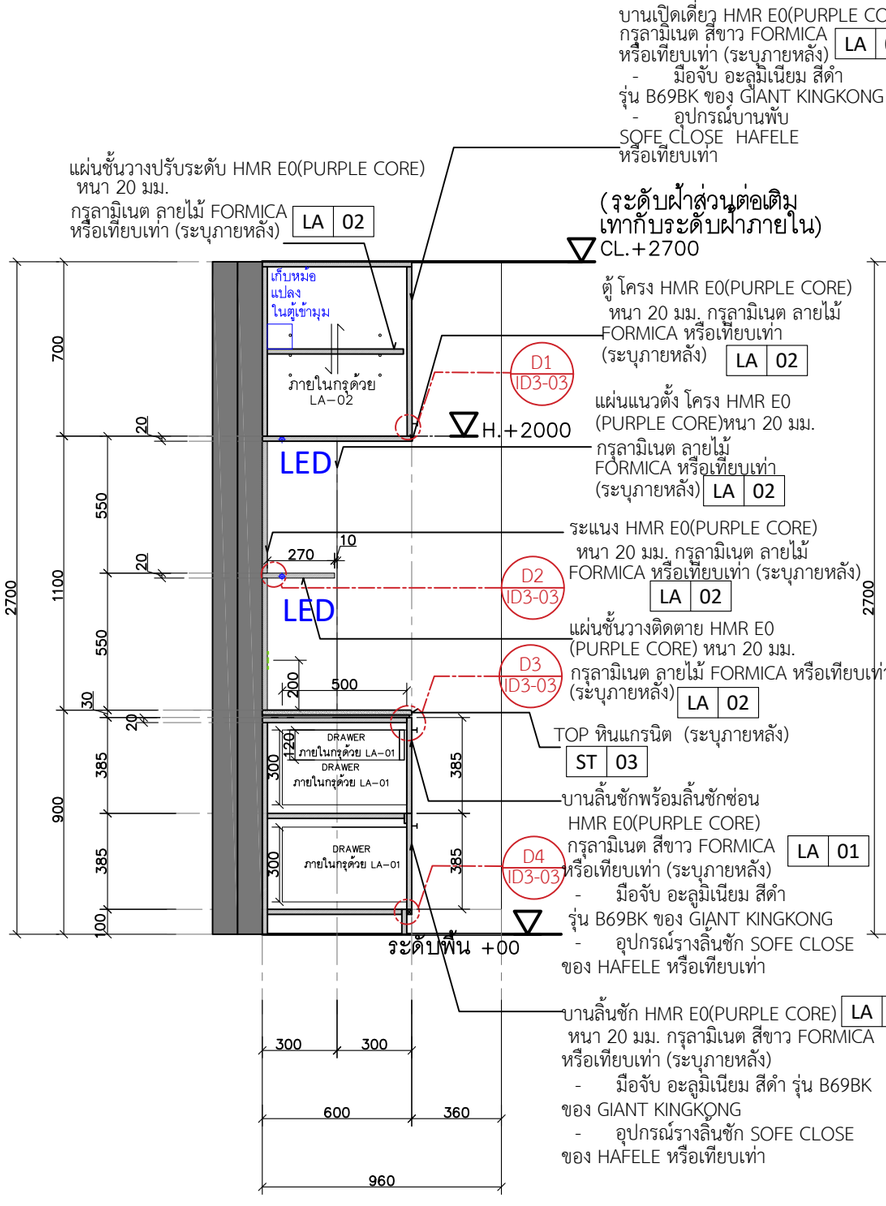

แบบขยายเคาเตอร์
บริเวณตรงข้ามครัว
SECTION 1

scale 1:25

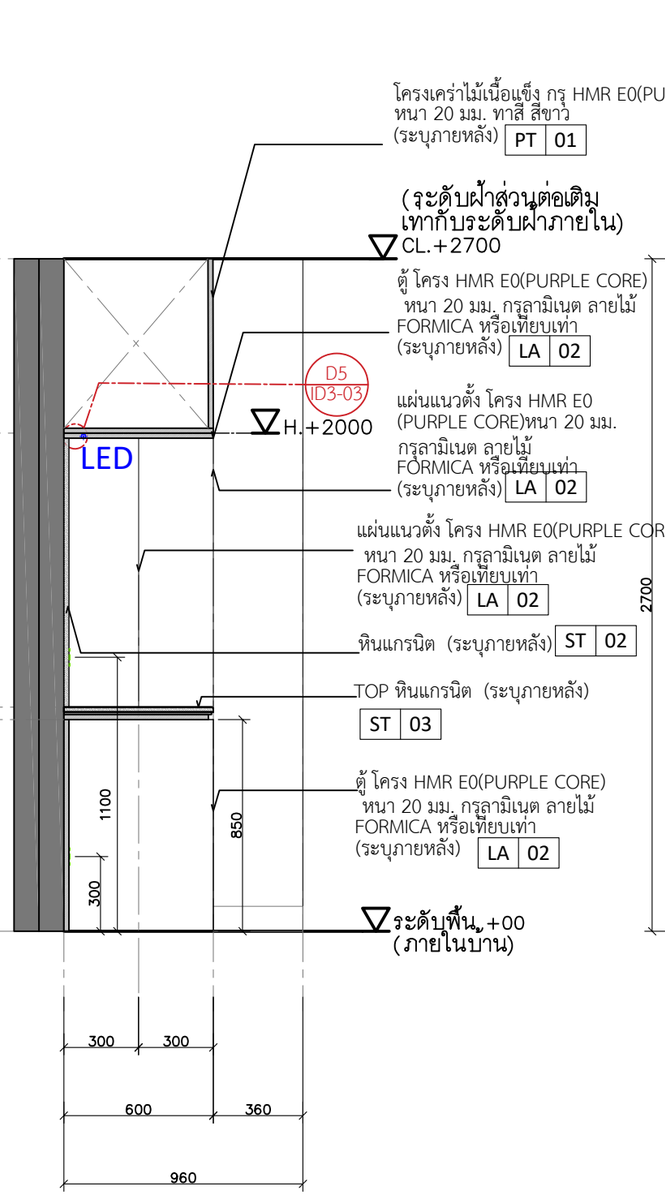

แบบขยายเคาเตอร์
บริเวณตรงข้ามครัว
SECTION 2

scale 1:25

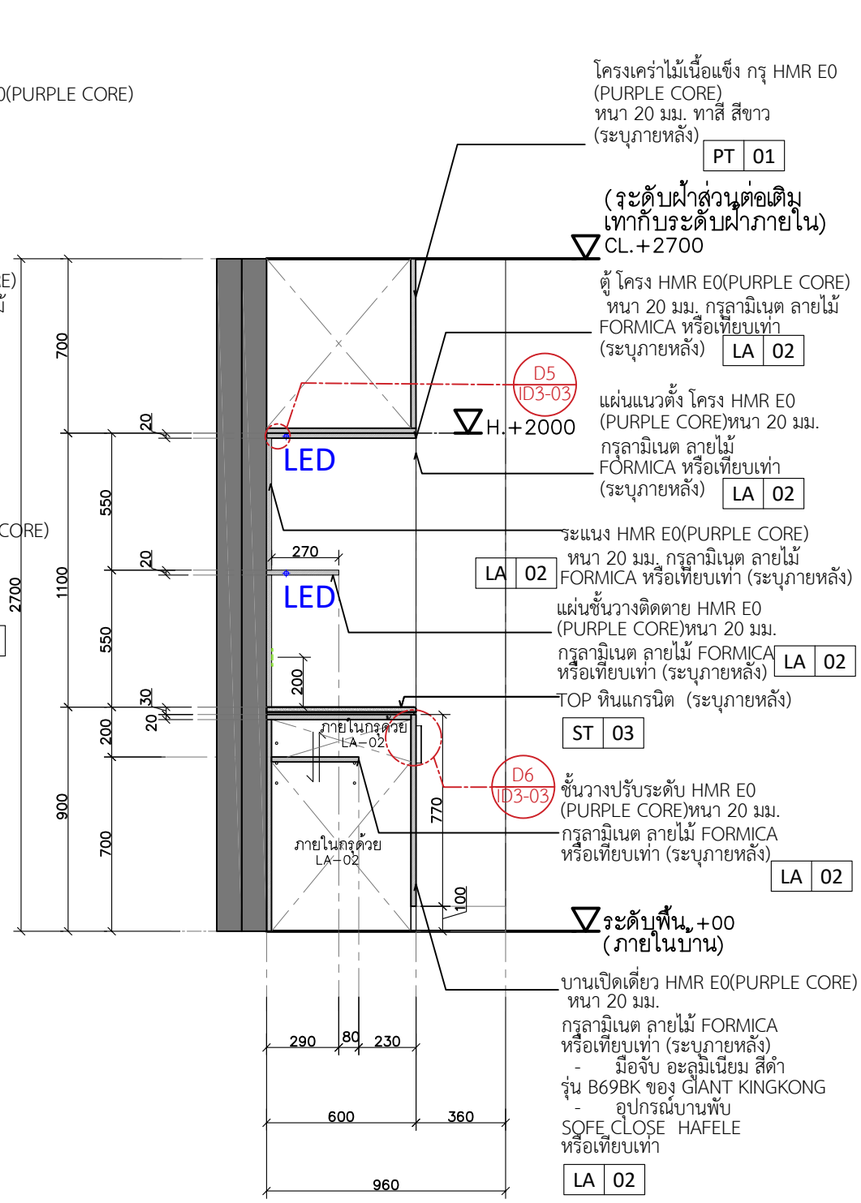

แบบขยายเคาเตอร์
บริเวณตรงข้ามครัว
SECTION 3

scale 1:25

SPACEMAN

PROJECT: SONIA HOUSE

LOCATION: REIGNWOOD PARK
LAMLUKKA, PATHUM THANI

ARCHITECT:

INTERIOR DESIGNER: ปรัตถกร ประมุขกุล ภ-สน 1438

STRUCTURAL ENGINEER:

TITLE: 1st FLOOR
แบบขยายบริเวณตรงข้ามครัว
SECTION 01

2026-02-04
ID3-02

1:25 @ A3

Note: SPACEMAN takes no responsibility for dimensions obtained by scaling from this drawing. If no dimension is shown the recipient must ascertain the dimension specifically from the architect or by site measurement and may not rely on the drawing. Supply of the drawing in digital form is solely for convenience and no reliance may be placed on any data in digital form. All data must be checked against hard copy. This drawing is issued for design intent only and should not be used for construction unless stated. This drawing is the property of SPACEMAN

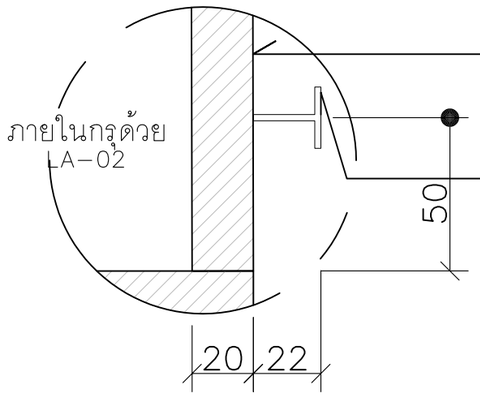

บานเปิดเดี่ยว
HMR E0(PURPLE CORE)
กรุลามิเนต สีขาว
FORMICA หรือเทียบเท่า
(ระบุภายหลัง)

มือจับ อะลูมิเนียม สีดำ
รุ่น B69BK ของ
GIANT KINGKONG

แบบขยายเคาเตอร์
บริเวณตรงข้ามครัว
DETAIL 1
IN SCALE 1:2

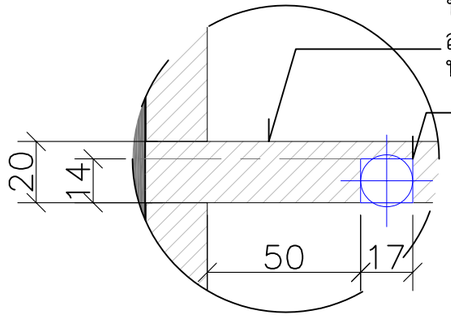

แผ่นชั้นวางติดตาย
HMR E0(PURPLE CORE)
หนา 20 มม. กรุลามิเนต
ลายไม้ FORMICA
หรือเทียบเท่า (ระบุภายหลัง)

ติดตั้ง LED STRIP LIGHT
LAMPTITUDE ALP-D
ขนาด W17XH14.3 มม .

แบบขยายเคาเตอร์
บริเวณตรงข้ามครัว
DETAIL 2
IN SCALE 1:2

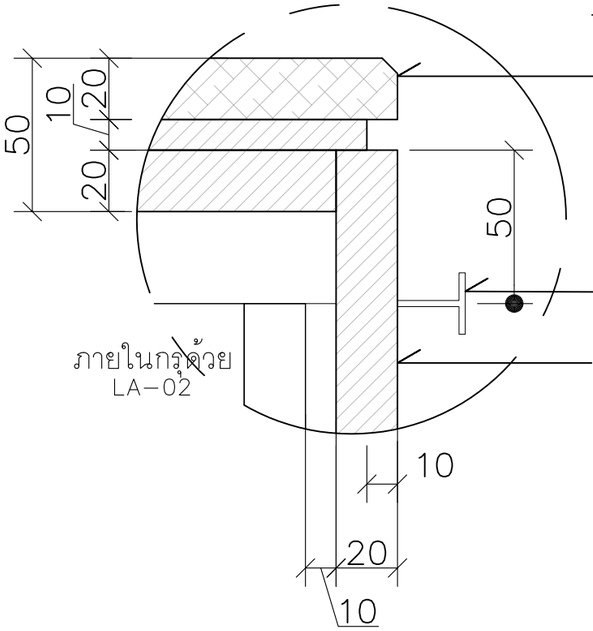

TOP หินแกรนิต
(ระบุภายหลัง)

มือจับ อะลูมิเนียม สีดำ
รุ่น B69BK ของ
GIANT KINGKONG

บานลิ้นชัก HMR E0
(PURPLE CORE)
กรุลามิเนต สีขาว FORMICA
หรือเทียบเท่า (ระบุภายหลัง)

แบบขยายเคาเตอร์
บริเวณตรงข้ามครัว
DETAIL 3
IN SCALE 1:2

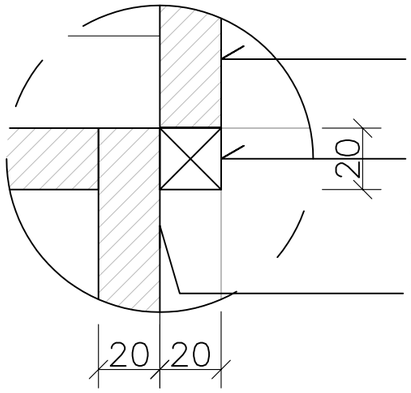

บานลิ้นชัก HMR E0(PURPLE CORE)
กรุลามิเนต สีขาว FORMICA
หรือเทียบเท่า (ระบุภายหลัง)

คิ้วไม้ 20**x20** มม.

ขาตู้ล่าง HMR E0(PURPLE CORE)
กรุลามิเนต ลายไม้ FORMICA
หรือเทียบเท่า (ระบุภายหลัง)

แบบขยายเคาเตอร์
บริเวณตรงข้ามครัว
DETAIL 4
IN SCALE 1:2

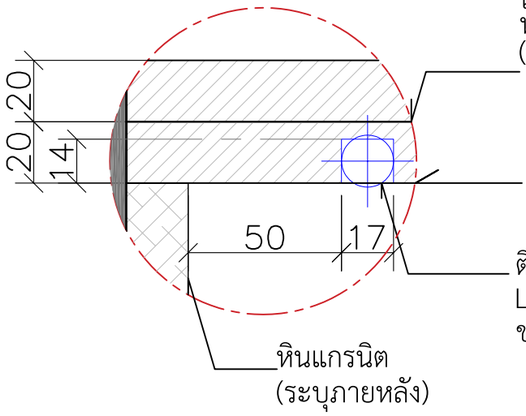

โครงเคร่าไม้เนื้อแข็ง กรุ HMR E0(PURPLE CORE)
หนา 20 มม. ทาสี สีขาว
(ระบุภายหลัง)

ตู้ โครง HMR E0(PURPLE CORE)
หนา 20 มม. กรุลามิเนต ลายไม้
FORMICA หรือเทียบเท่า
(ระบุภายหลัง)

ติดตั้ง LED STRIP LIGHT
LAMPTITUDE ALP-D
ขนาด W17XH14.3 มม .

หินแกรนิต
(ระบุภายหลัง)

แบบขยายเคาเตอร์
บริเวณตรงข้ามครัว
DETAIL 5
IN SCALE 1:2

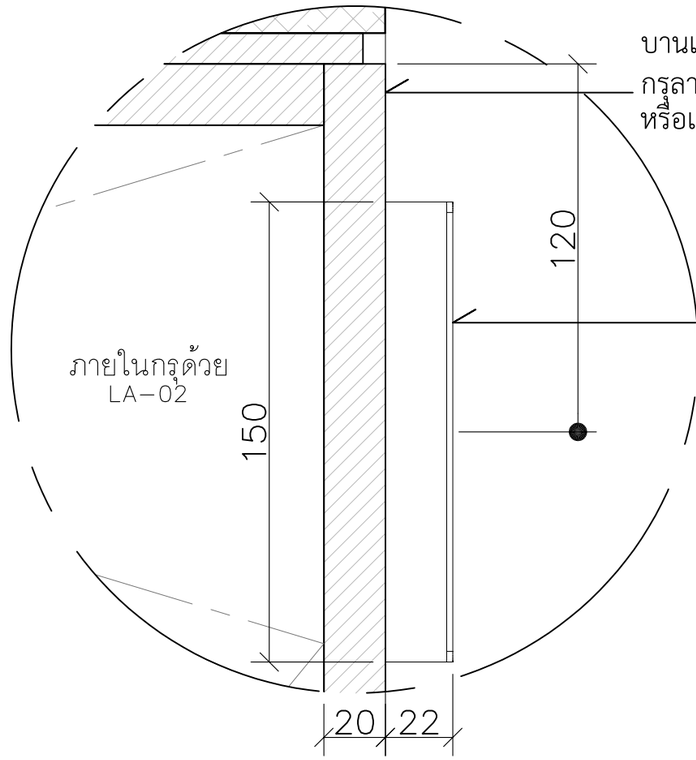

บานเปิดเดี่ยว HMR E0(PURPLE CORE)
กรุลามิเนต ลายไม้ FORMICA
หรือเทียบเท่า (ระบุภายหลัง)

มือจับ อะลูมิเนียม สีดำ
รุ่น B69BK ของ GIANT KINGKONG

แบบขยายเคาเตอร์
บริเวณตรงข้ามครัว
DETAIL 6
IN SCALE 1:2

SPACEMAN

PROJECT: SONIA HOUSE
LOCATION:
ARCHITECT:
INTERIOR DESIGNER: ปรัตถกร ประมุขกุล ภ-สน 1438
STRUCTURAL ENGINEER:
TITLE: 1st FLOOR แบบขยายบริเวณตรงข้ามครัว SECTION 01
2026-05-26
ID3-03
1:10 @ A3

Note: SPACEMAN takes no responsibility for dimensions obtained by scaling from this drawing. If no dimension is shown the recipient must ascertain the dimension specifically from the architect or by site measurement and may not rely on the drawing. Supply of the drawing in digital form is solely for convenience and no reliance may be placed on any data in digital form. All data must be checked against hard copy. This drawing is issued for design intent only and should not be used for construction unless stated. This drawing is the property of SPACEMAN

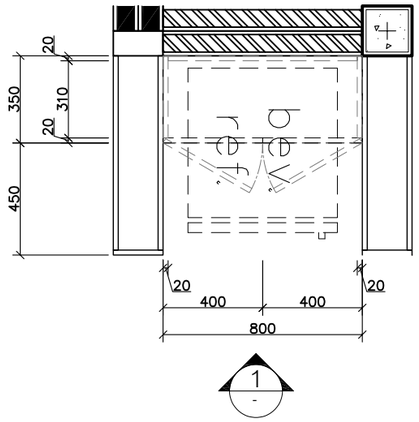

แบบขยายตู้ลอย
บริเวณตรงทางขึ้นบันได
ELEVATION 2

scale 1:25

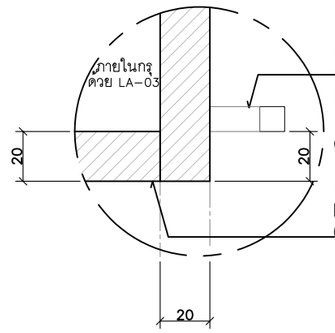

บานเปิดคู่ HMR E0(PURPLE CORE)
หนา 20 มม.
กรุลามิเนต สีขาว FORMICA
หรือเทียบเท่า (ระบุภายหลัง)
มือจับแบบดึง สีเงิน HAFELE 481.21.021 SV-MT หรือเทียบเท่า

ตู้ โครง HMR E0(PURPLE CORE)
หนา 20 มม.
กรุลามิเนต ลายไม้ สีอ่อน
FORMICA หรือเทียบเท่า
(ระบุภายหลัง)

DETAIL 1

scale 1:2.5

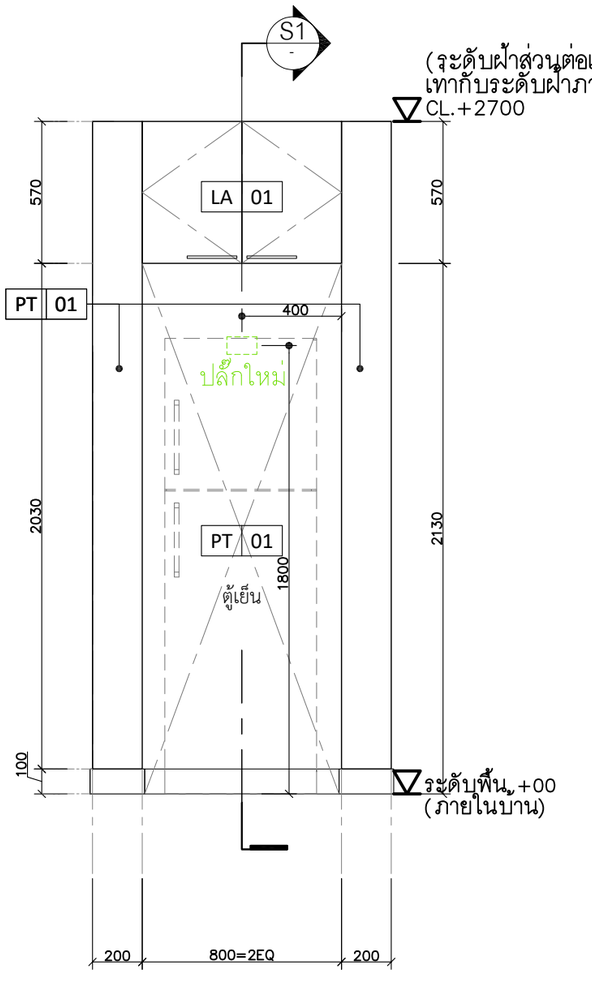

แบบขยายตู้ลอย
บริเวณตรงทางขึ้นบันได
ELEVATION 1

scale 1:25

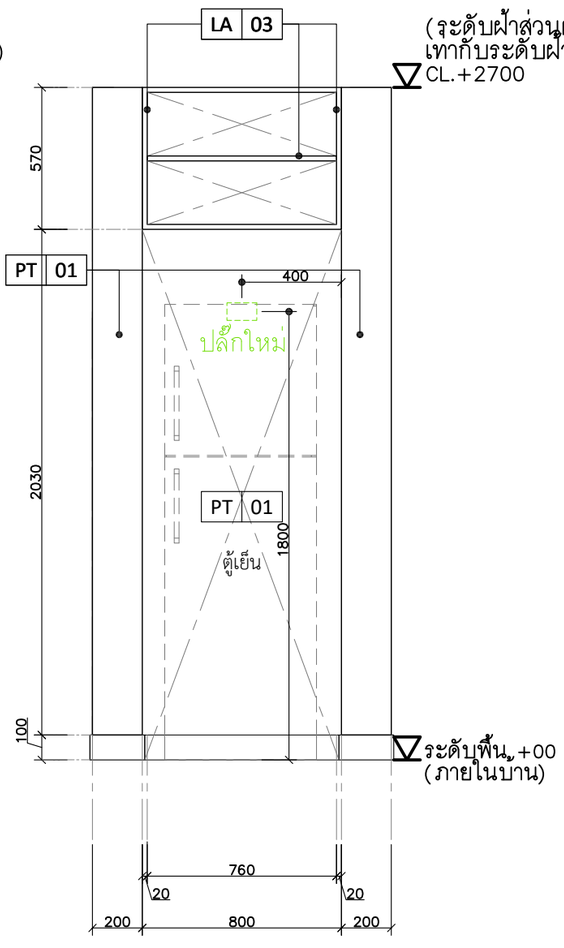

แบบขยายตู้ลอย
บริเวณตรงทางขึ้นบันได
ELEVATION 1

scale 1:25

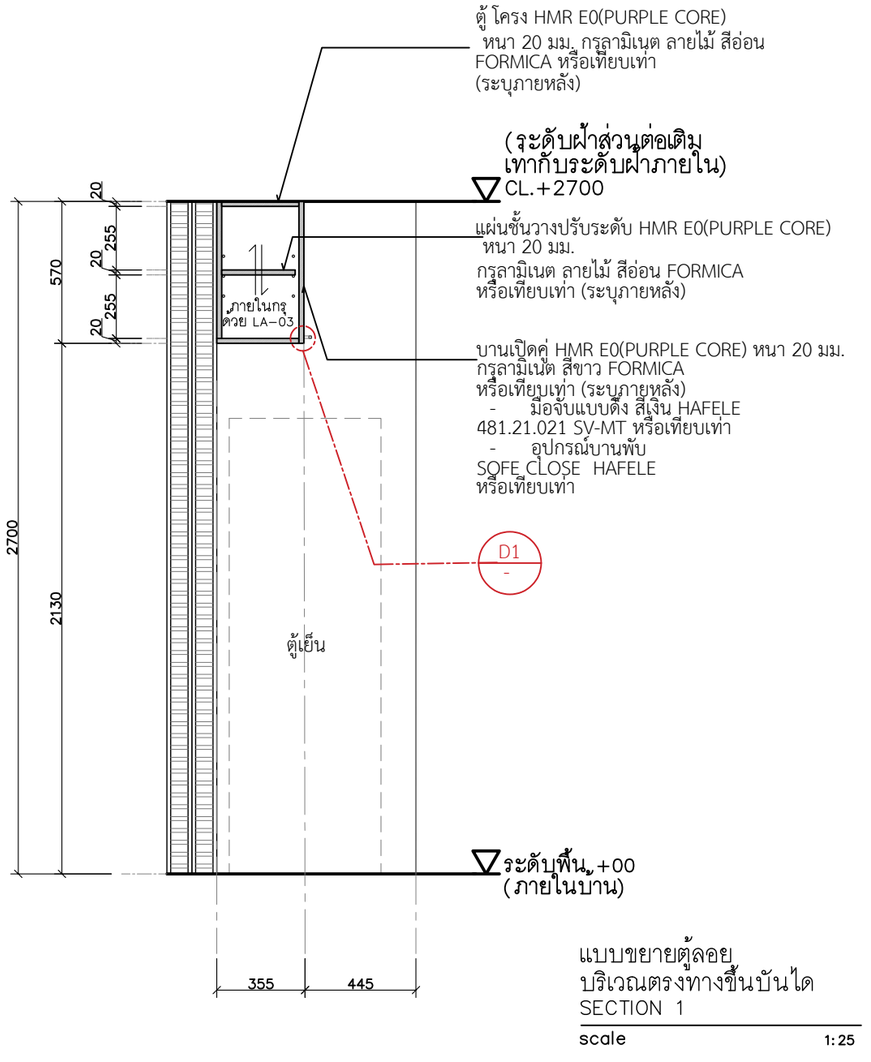

แบบขยายตู้ลอย
บริเวณตรงทางขึ้นบันได
SECTION 1

scale 1:25

SPACEMAN

PROJECT | SONIA HOUSE

LOCATION | REIGNWOOD PARK
LAMLUKKA, PATHUM THANI

ARCHITECT

INTERIOR DESIGNER | ปรัตถกร ประมุขกุล ภ-สน 1438

STRUCTURAL ENGINEER

TITLE | 1st FLOOR แบบขยาย ตู้ลอย
PLAN ,ELEVATION ,SECTION

2026-02-04
ID3-04

1:25 @ A3

Note: SPACEMAN takes no responsibility for dimensions obtained by scaling from this drawing. If no dimension is shown the recipient must ascertain the dimension specifically from the architect or by site measurement and may not rely on the drawing. Supply of the drawing in digital form is solely for convenience and no reliance may be placed on any data in digital form. All data must be checked against hard copy. This drawing is issued for design intent only and should not be used for construction unless stated. This drawing is the property of SPACEMAN

SONIA HOUSE

REIGNWOOD PARK

LAMLUKKA, PATHUM THANI

แบบขยายส่วนต่อเติมข้างบ้าน

SANITARY SPEC

Symbol	Description	QTY.
S1-01	ก๊อกอ่างล้างหน้า/ดำ/ขนาด W25XD18.5XH330มม. Code : ก๊อกซิงค์ติดเคาน์เตอร์ BATH&BATH รุ่น BT-C7/ดำ / by BATH&BATH	1
S1-02	อ่างล้างหน้าแบบฝังใต้เคาน์เตอร์/ขาว/ ขนาด W686XD423XH213มม Code : รุ่นลาเดน่า 27" KOHLER Ladena K-76509K-0/ By KOHLER	1
S1-03	ชักโครก/ขาว/ขนาด W392XD749XH708มม. Code: สุขภัณฑ์ แบบชิ้นเดียว รุ่นแอโรไดน์ KOHLER Aerodyne K-3869X-S-0 / By KOHLER	1
S1-04	สายชำระ/ขนาด W28XD71XH204 มม. Code : สายฉีดชำระ รุ่นสเปซซิตี้ KOHLER SPACITY K-29152T-WPT / ByKOHLER	1
S1-05	ที่ใส่กระดาษทิชชู่/ดำ/ขนาด W118.5XD64XH148 มม. Code : ที่ใส่กระดาษทิชชูสีดำ รุ่น NR-94002-BA / By PRIME	1

REFLECTED CEILING LEGEND

Symbol	Description	
XXX 0000	ประเภทฝ้าเพดาน ระดับความสูงฝ้าเพดาน	
CL 1	แผ่นยิปซัมมอยส์บล็อค ตราช้าง (ทนชื้น) ขอบลาด 9 มม 1200x2400 มม	
LT-01	โคมไฟดาวน์ไลท์ แบบฝังฝ้าเพดาน / โคมสีขาว / GU10(3000K) By LAMPTITUDE ติดต่อ: -	RONA-G-GU10 -WW-FR
EL-02	โคมไฟติดผนังด้านนอก *ไฟติดผนังตามสเปคของโครงการ*	
LED	LED Strip light (ไฟซ่อน) By LAMPTITUDE ติดต่อ: -	ALP-E-1M
LED	LED Strip light (ไฟซ่อน) By LAMPTITUDE ติดต่อ: -	ALP-D 3M
	พัดลมระบายอากาศเพดาน/ สีขาว By MITSUBISHI ติดต่อ: -	VD-15Z4T7-N
S	สวิตซ์ไฟทางเดียว	
2S	สวิตซ์ไฟ2ทาง	

Remark :

• ตำแหน่งการติดตั้งสวิตซ์และเต้ารับต่างๆให้ดูในแบบรูปด้าน หากตำแหน่งการติดตั้ง
ในแบบกับหน้างานมีความขัดแย้งกันให้ผู้รับจ้างติดต่อกับผู้ออกแบบเพื่อหาข้อสรุป

• การติดตั้งและการเชื่อมต่อให้อ้างอิงกับแบบงานระบบหากแบบมีความขัดแย้งกับ
หน้างานให้ผู้รับจ้างแจ้งกับผู้ออกแบบเพื่อดำเนินการแก้ไข

DOOR

Symbol	Description	Dimention
D1-01	ประตูบานเปิดเดี่ยว โครง HMR หนา 42 มม. - วงกบ CNC HMR หนา 45 มม. กรุลามิเนตลายไม้ FORMICA หรือเทียบเท่า (ระบุภายหลัง) - บานประตู HMR กรุลามิเนตลายไม้ FORMICA หรือเทียบเท่า (ระบุภายหลัง) *ติดตั้ง 950.05.962 ซีลประตูอัตโนมัติ DDS12 DDS12 RETRACTABLE DOOR SEAL HAFELE - มือจับก้านโยก+พร้อมระบบล็อค สีดำ HAFELE หรือเทียบเท่า (ระบุภายหลัง)	(ก) 800 x (ส) 2700 มม.
D1-02	ประตู TOSTEM WE70 AIR FLOW DOOR สี NATURAL BLACK - ความกว้างเฟรมประตู 72 มม. สูง 2400มม. ความหนากระจก 6 มม.	(ก) 900 x (ส) 2400 มม.

WINDOW

Symbol	Description	Dimention
W1	ช่องแสงติดตาย กระจกเทมเปอร์หนา 10 มม. เฟรมอลูมิเนียม สีดำ	(ก) 800 x (ส) 2700 มม.
W2	หน้าต่างกระทุ้ง กระจกลามิเนต 6 มม. เฟรมอลูมิเนียม สีดำ	(ก) 600 x (ส) 400 มม.

Glass / Mirror

CODE		
GL-01	ประเภท	กระจกเทมเปอร์
	รหัส	-
	สี / ขนาด	ความหนา 10 มม.
	ผู้ผลิต	TYK Glass ติดต่อ: -
GL-02	ประเภท	กระจกเงา
	รหัส	-
	สี / ขนาด	ความหนา 6 มม.
	ผู้ผลิต	TYK Glass ติดต่อ: -

LAMINATE

CODE		
LA-01	ประเภท	ลามิเนต
	รหัส	*ระบุสเปคสีภายหลัง
	สี / ขนาด	*ระบุสเปคสีภายหลัง
	ผู้ผลิต	FORMICA ติดต่อ: -

STONE / MABLE

CODE		
ST-01	ประเภท	หินอ่อน
	รหัส	SIAMTAK Türkiye WHITE EMPERADOR
	สี / ขนาด	สีงาช้าง (WHITE EMPERADOR)
	ผู้ผลิต	Siamtak ติดต่อ: -

SKIRTING

CODE		
SK-01	ประเภท	บัวผนัง
	รหัส	-
	สี / ขนาด	สีขาว
	ผู้ผลิต	Contractor ติดต่อ: -

CERAMIC TILE

CODE		
CT-01	ประเภท	กระเบื้องพื้น/COTTO ผนัง อาร์คสโตน-A ขาว (Ant-SL) R/T 24X24 A
	รหัส	1255782
	สี / ขนาด	สีขาว/ 600 x 600 มม.
	ผู้ผลิต	Boonthavorn ติดต่อ: -
CT-02	ประเภท	กระเบื้องพื้น /ICEBERG WHITE R.10(AGT602144AR)60X60*A
	รหัส	1213709
	สี / ขนาด	สีขาว/ 600x600 มม.
	ผู้ผลิต	Boonthavorn ติดต่อ: -

PAINT / SPRAY PAINT

CODE		
PT-01	ประเภท	สีทาภายใน
	รหัส	*ระบุรหัสสีภายหลัง
	สี / ขนาด	สีน้ำพลาสติกทาภายนอก TOA Supershield Advance สีขาว
	ผู้ผลิต	TOA ติดต่อ: -
PT-02	ประเภท	สีทาภายใน
	รหัส	*ระบุรหัสสีภายหลัง
	สี / ขนาด	สีชุปเปอร์ชิลด์ สีน้ำอะคริลิก ชนิดกึ่งเงา สีขาว (ระบุเฉดสีภายหลัง)
	ผู้ผลิต	TOA ติดต่อ: -

SPACEMAN

PROJECT: SONIA HOUSE

LOCATION: REIGNWOOD PARK LAMLUKKA, PATHUM THANI

ARCHITECT:

INTERIOR DESIGNER: ปรัตถกร ประมุขกุล ภ-สน 1438

STRUCTURAL ENGINEER:

TITLE: 1st floor LEGEND DESCRIPTION / LIST OF MATERIALS (ส่วนต่อเติมข้างบ้าน)

2026-03-13
ID0-00
1:50 @ A3

Note: SPACEMAN takes no responsibility for dimensions obtained by scaling from this drawing. If no dimension is shown the recipient must ascertain the dimension specifically from the architect or by site measurement and may not rely on the drawing. Supply of the drawing in digital form is solely for convenience and no reliance may be placed on any data in digital form. All data must be checked against hard copy. This drawing is issued for design intent only and should not be used for construction unless stated. This drawing is the property of SPACEMAN

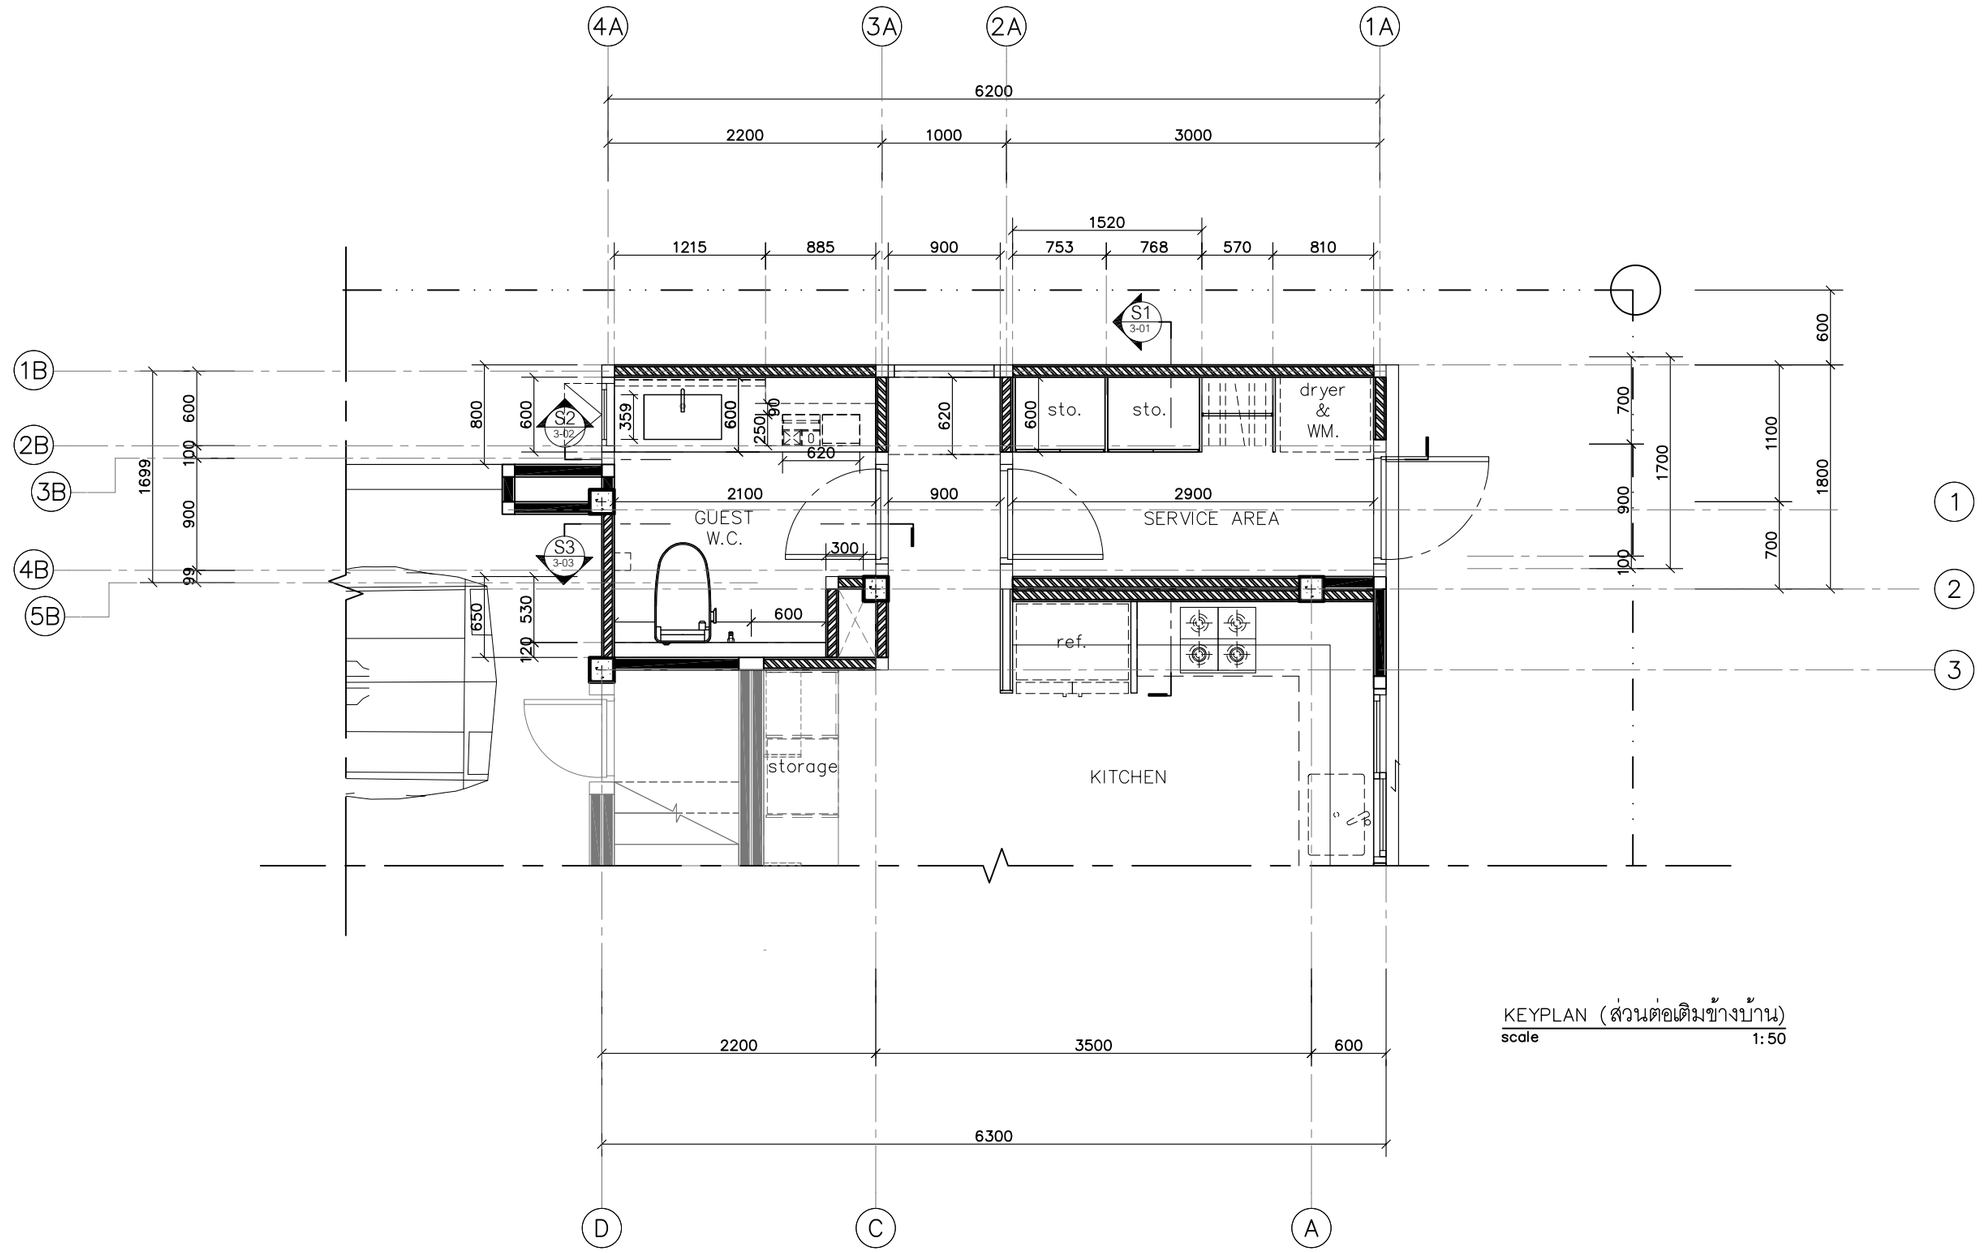

KEYPLAN (ส่วนต่อเติมข้างบ้าน)
scale 1:50

SPACEMAN	PROJECT: SONIA HOUSE	LOCATION: REIGNWOOD PARK LAMLUKKA, PATHUM THANI	ARCHITECT	INTERIOR DESIGNER: ปรัตถกร ประมุขกุล ภ-สน 1438	STRUCTURAL ENGINEER	TITLE: 1st FLOOR KEY PLAN (ส่วนต่อเติมข้างบ้าน)	2026-03-13 ID1-01 1:50 @ A3

Note: SPACEMAN takes no responsibility for dimensions obtained by scaling from this drawing. If no dimension is shown the recipient must ascertain the dimension specifically from the architect or by site measurement and may not rely on the drawing. Supply of the drawing in digital form is solely for convenience and no reliance may be placed on any data in digital form. All data must be checked against hard copy. This drawing is issued for design intent only and should not be used for construction unless stated. This drawing is the property of SPACEMAN

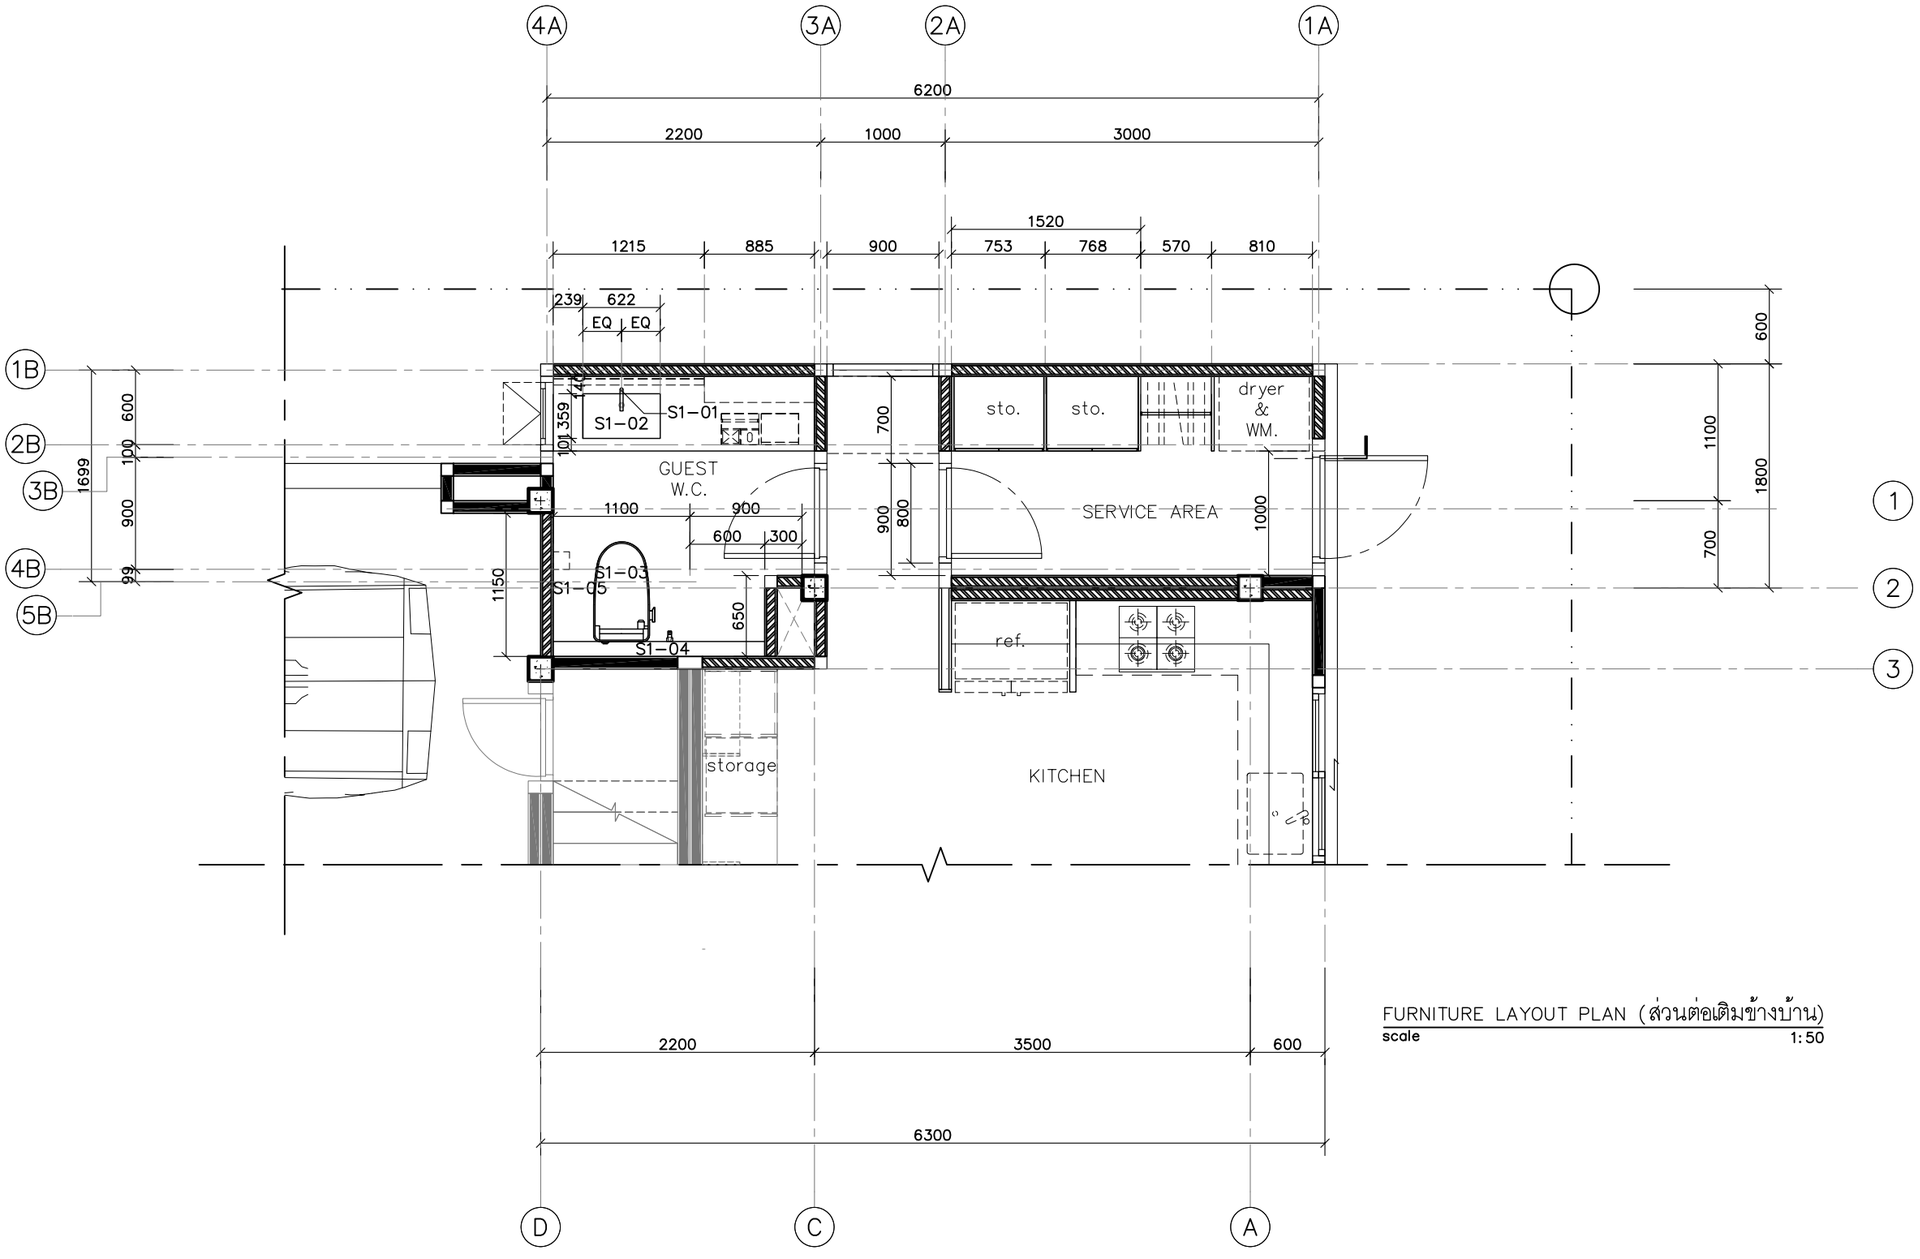

FURNITURE LAYOUT PLAN (ส่วนต่อเติมข้างบ้าน)
scale 1:50

S-01

FAUCET/BATH&BATH/ก๊อกซิงค์ติดเคาน์เตอร์ BATH&BATH รุ่น BT-C7/ดำ/ขนาด W25XD18.5XH330มม.

S-02

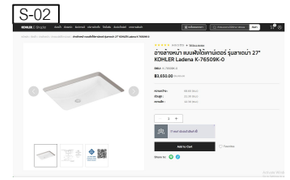

WASH BASIN/KOHLER/อ่างล้างหน้า แบบฝังใต้เคาน์เตอร์ รุ่นลาเดน่า 27" KOHLER Ladena K-76509K-0/ขนาด W686XD423XH213 มม. *ระยะเจาะ TOP เคาน์เตอร์ W622XD359 มม.

S-03

FLUSH TOILET/KOHLER/สุขภัณฑ์ แบบชิ้นเดียว รุ่นแอโรไดน์ KOHLER Aerodyne K-3869X-S-0/ขนาด W392XD749XH708 มม.

S-04

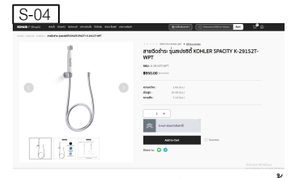

BIDET/KOHLER/สายฉีดชำระ รุ่นสเปซซิตี้ KOHLER SPACITY K-29152T-WPT/ขนาด W28XD71XH204 มม.

S-05

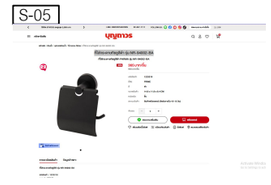

TISSUE HOLDER/PRIME/ ที่ใส่กระดาษทิชชูสีดำ รุ่น NR-94002-BA ขนาด W118.5XD64XH148 มม.

SPACEMAN

PROJECT: SONIA HOUSE

LOCATION: REIGNWOOD PARK
LAMLUKKA, PATHUM THANI

ARCHITECT:

INTERIOR DESIGNER: ปรัตถกร ประมุขกุล ภ-สน 1438

STRUCTURAL ENGINEER:

TITLE: 1st FLOOR
FURNITURE LAYOUT PLAN
(ส่วนต่อเติมข้างบ้าน)

2026-03-13
ID1-02
1:50 @ A3

Note: SPACEMAN takes no responsibility for dimensions obtained by scaling from this drawing. If no dimension is shown the recipient must ascertain the dimension specifically from the architect or by site measurement and may not rely on the drawing. Supply of the drawing in digital form is solely for convenience and no reliance may be placed on any data in digital form. All data must be checked against hard copy. This drawing is issued for design intent only and should not be used for construction unless stated. This drawing is the property of SPACEMAN

รูปประกอบ สำหรับติดตั้งฝาปิดด้านนอกอาคาร
แบบชนิดกันแมลง– ครอบกันฝน

–ครอบช่องระบายอากาศ ชนิดครอบกันฝน ZAGIO
รุ่น HTTP6G ขนาด 6 นิ้ว สีขาว ของไทวัสดุ
หรือเทียบเท่า

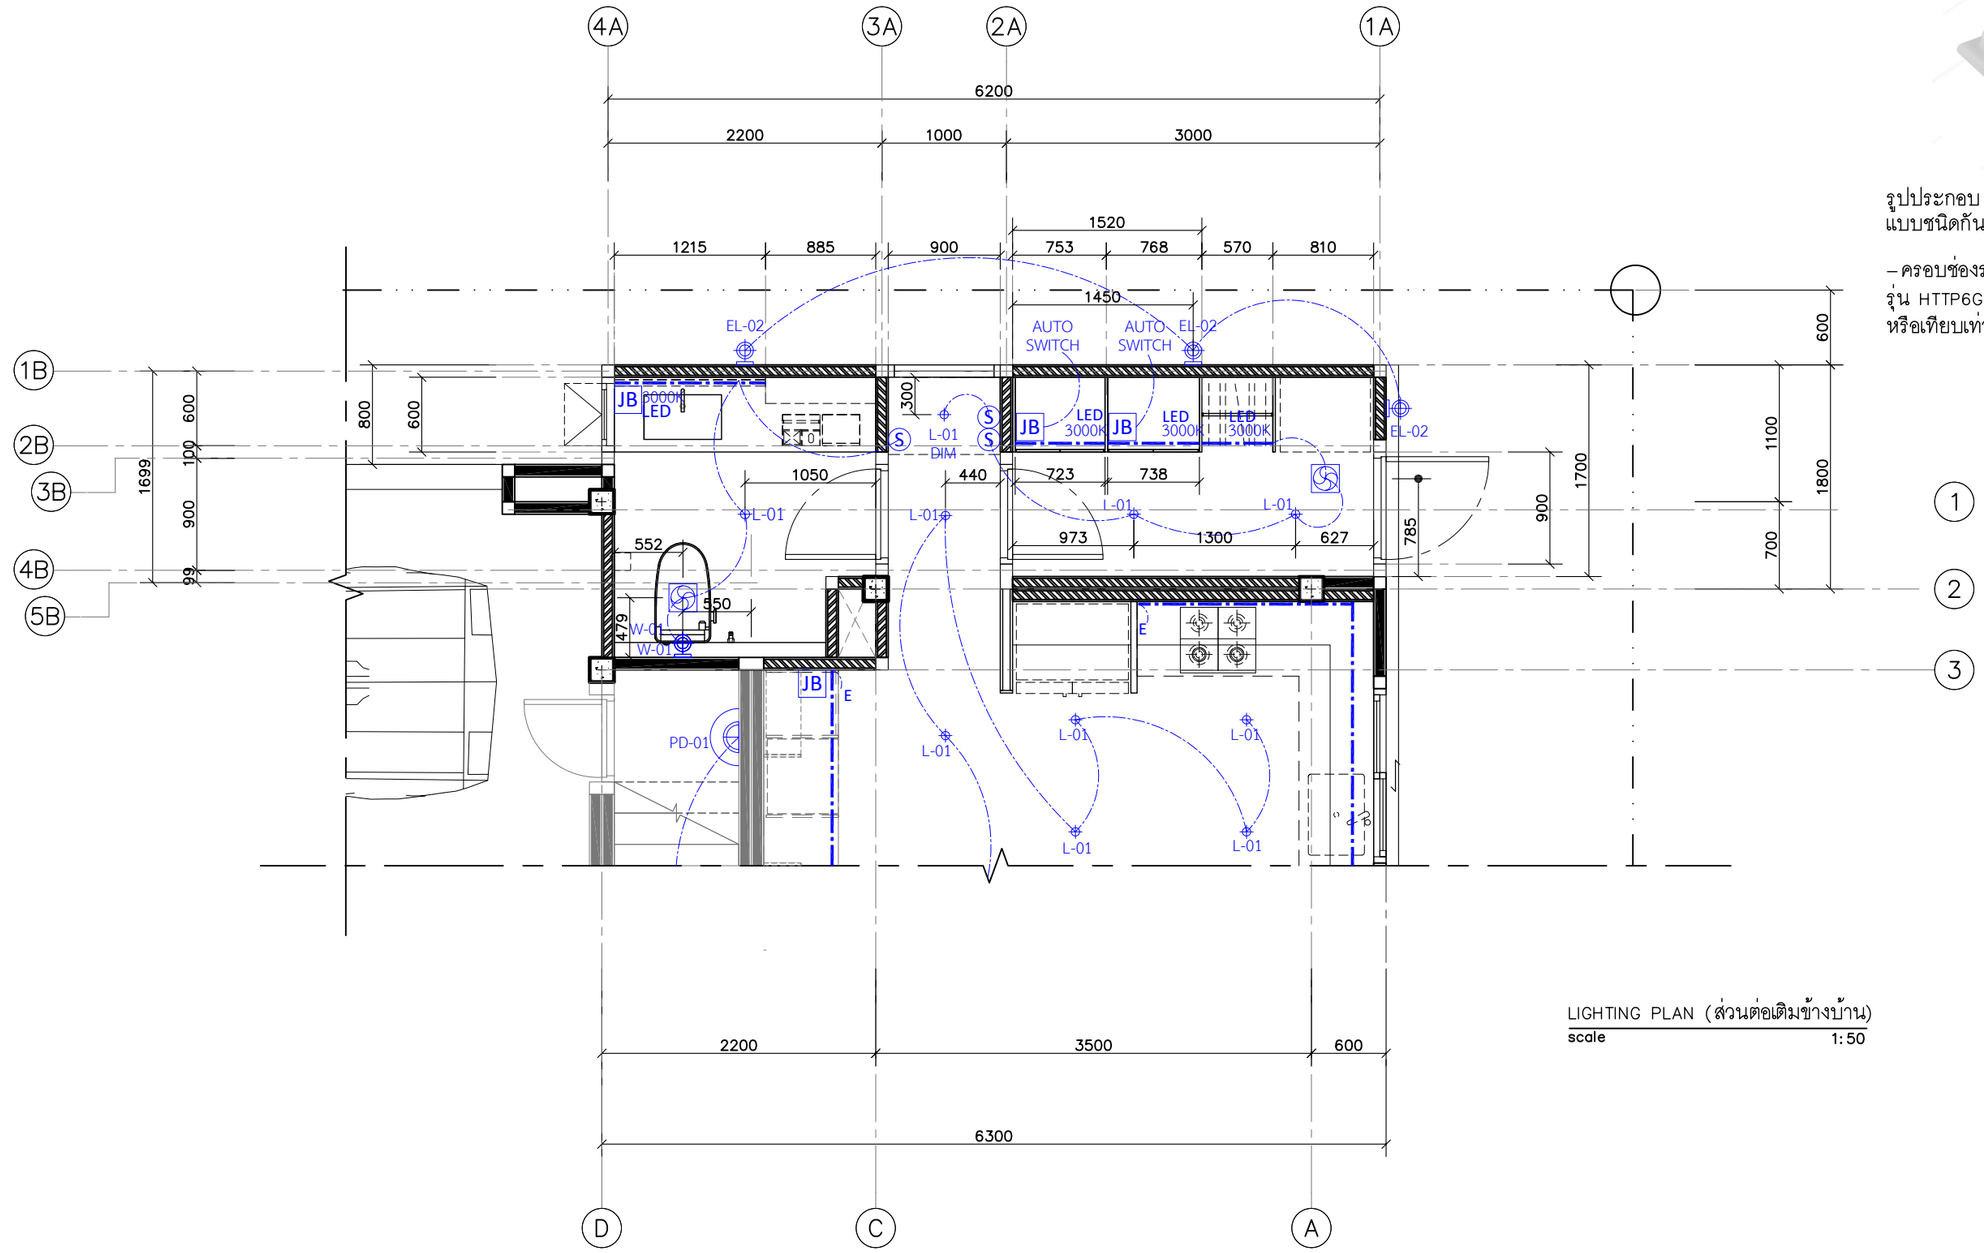

LIGHTING PLAN (ส่วนต่อเติมข้างบ้าน)
scale 1:50

SPACEMAN

PROJECT: SONIA HOUSE
LOCATION: REIGNWOOD PARK
LAMLUKKA, PATHUM THANI
ARCHITECT:
INTERIOR DESIGNER: ปรัตถกร ประมุขกุล ภ–สน 1438
STRUCTURAL ENGINEER:
TITLE: 1st FLOOR
LIGHTING PLAN (ส่วนต่อเติมข้างบ้าน)
2026–03–13
ID1–03
1:50 @ A3

Note: SPACEMAN takes no responsibility for dimensions obtained by scaling from this drawing. If no dimension is shown the recipient must ascertain the dimension specifically from the architect or by site measurement and may not rely on the drawing. Supply of the drawing in digital form is solely for convenience and no reliance may be placed on any data in digital form. All data must be checked against hard copy. This drawing is issued for design intent only and should not be used for construction unless stated. This drawing is the property of SPACEMAN

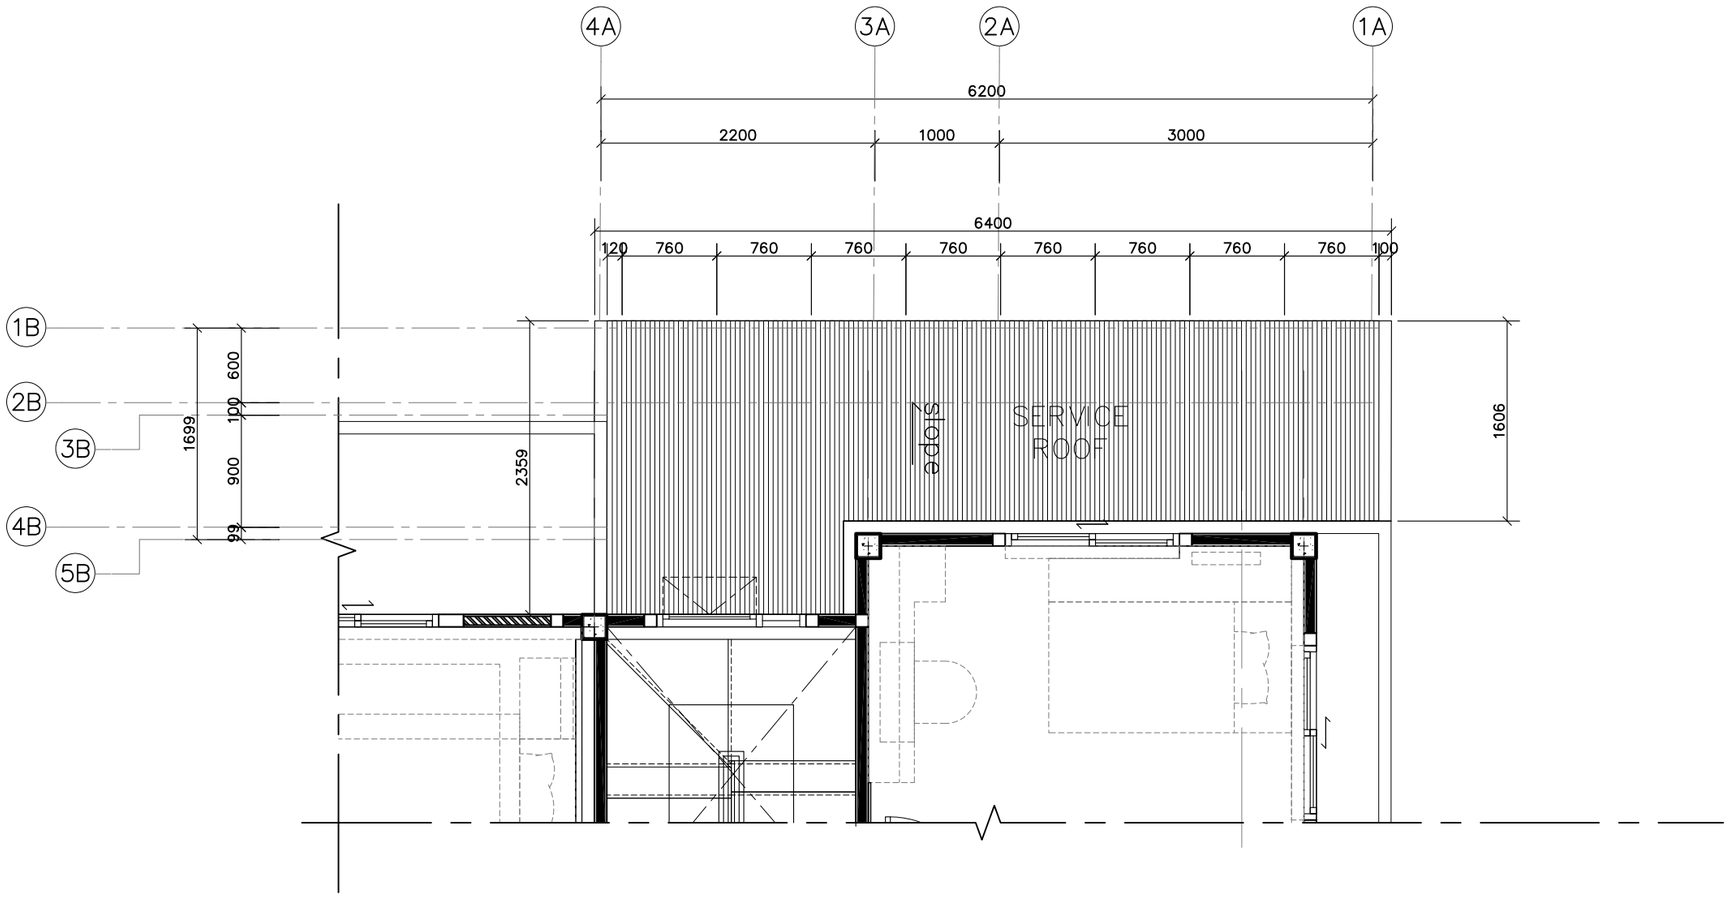

ROOF PLAN (ส่วนต่อเติมข้างบ้าน)
scale 1:50

SPACEMAN	PROJECT: SONIA HOUSE	LOCATION: REIGNWOOD PARK LAMLUKKA, PATHUM THANI	ARCHITECT	INTERIOR DESIGNER: ปรัตถกร ประมุขกุล ภ-สน 1438	STRUCTURAL ENGINEER	TITLE: 1st FLOOR ROOF PLAN (ส่วนต่อเติมข้างบ้าน)	2026-03-13 ID1-04 1:50 @ A3

Note: SPACEMAN takes no responsibility for dimensions obtained by scaling from this drawing. If no dimension is shown the recipient must ascertain the dimension specifically from the architect or by site measurement and may not rely on the drawing. Supply of the drawing in digital form is solely for convenience and no reliance may be placed on any data in digital form. All data must be checked against hard copy. This drawing is issued for design intent only and should not be used for construction unless stated. This drawing is the property of SPACEMAN

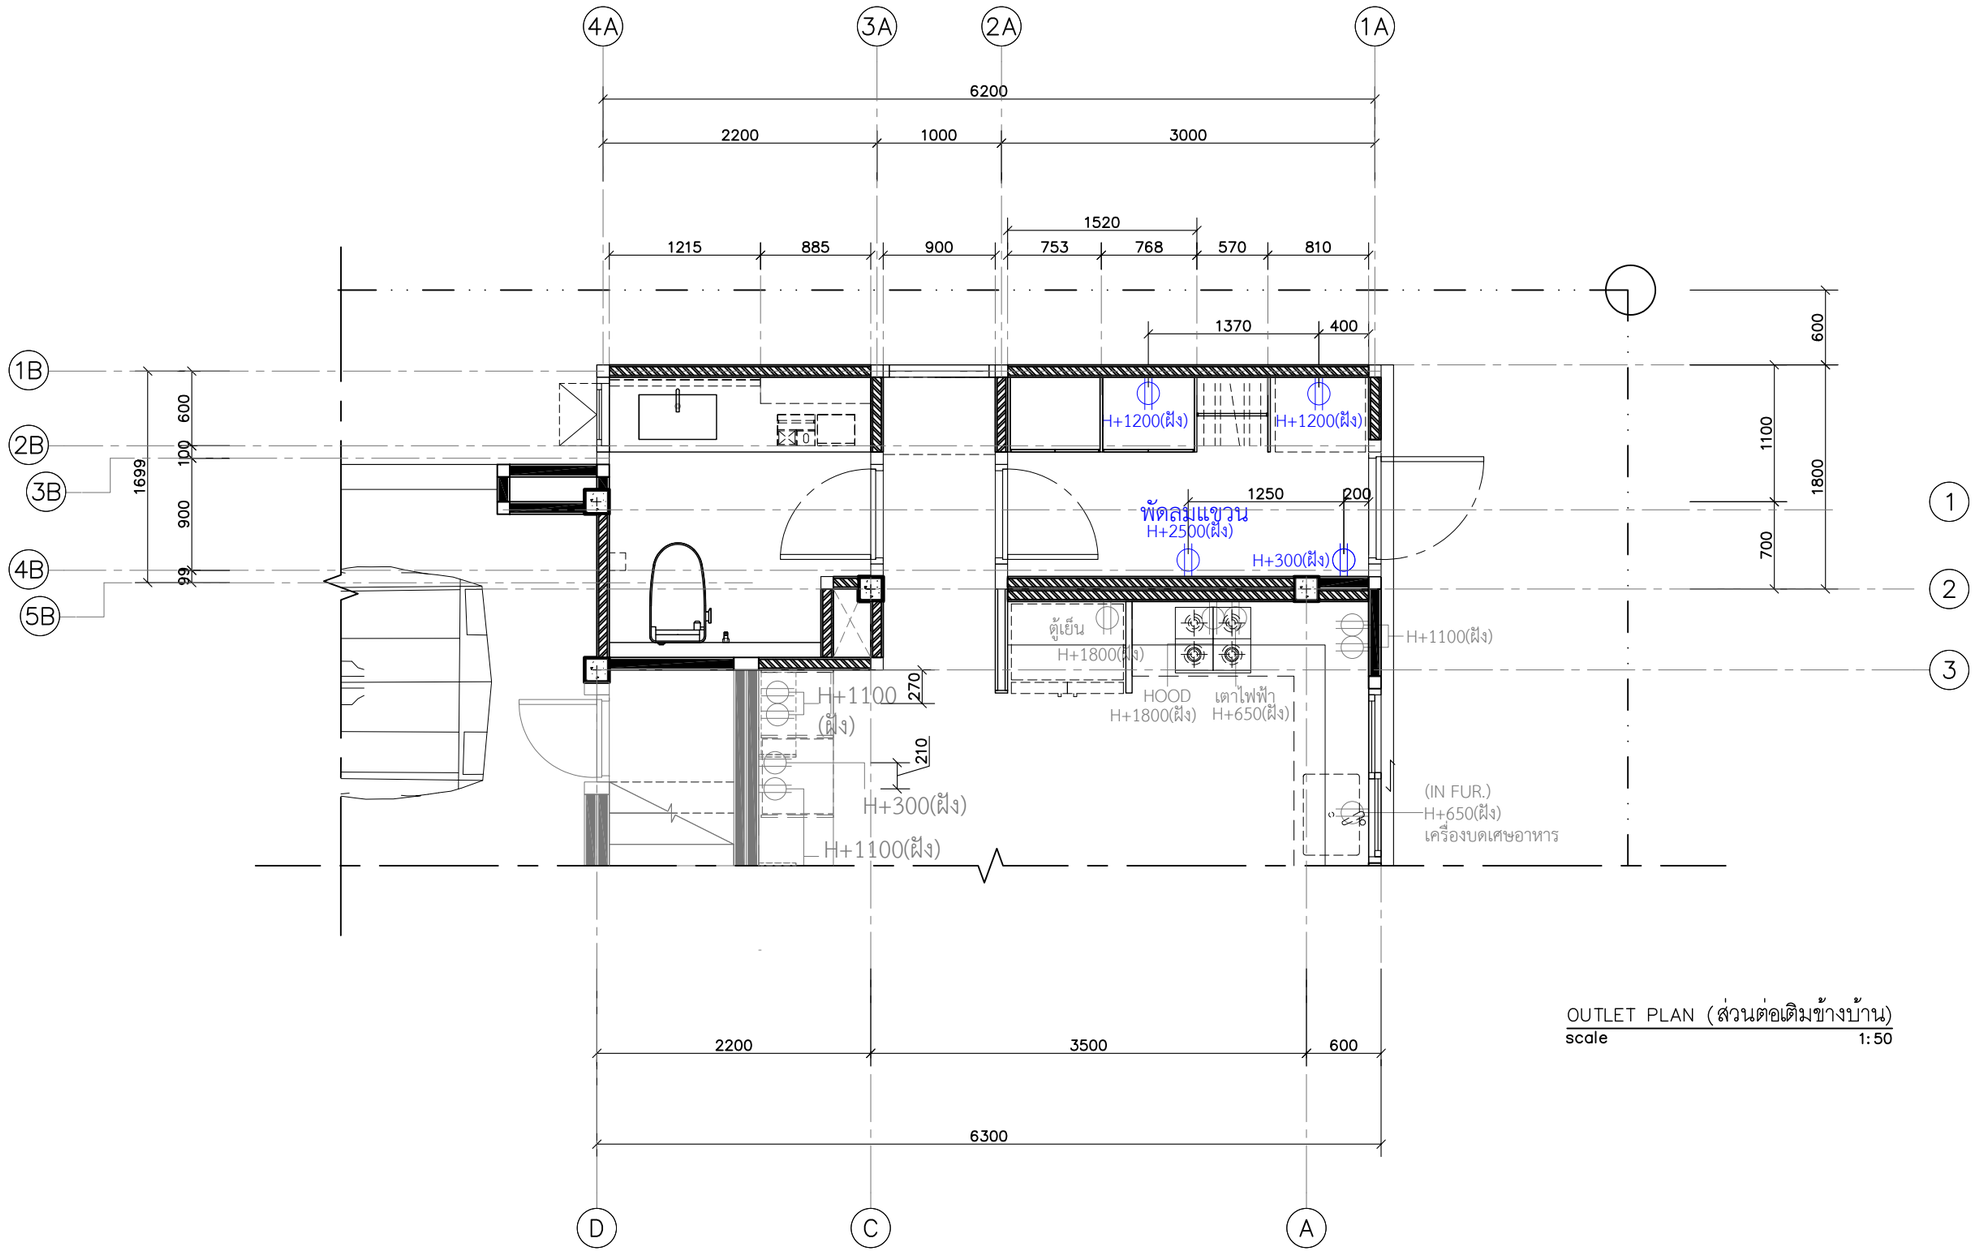

OUTLET PLAN (ส่วนต่อเติมข้างบ้าน)
scale 1:50

SPACEMAN	PROJECT: SONIA HOUSE	LOCATION: REIGNWOOD PARK LAMLUKKA, PATHUM THANI		INTERIOR DESIGNER: ปรัตถกร ประมุขกุล ภ-สน 1438	STRUCTURAL ENGINEER	TITLE: 1st FLOOR OUTLET PLAN (ส่วนต่อเติมข้างบ้าน)	2026-03-13 ID1-05 1:50 @ A3

Note: SPACEMAN takes no responsibility for dimensions obtained by scaling from this drawing. If no dimension is shown the recipient must ascertain the dimension specifically from the architect or by site measurement and may not rely on the drawing. Supply of the drawing in digital form is solely for convenience and no reliance may be placed on any data in digital form. All data must be checked against hard copy. This drawing is issued for design intent only and should not be used for construction unless stated. This drawing is the property of SPACEMAN

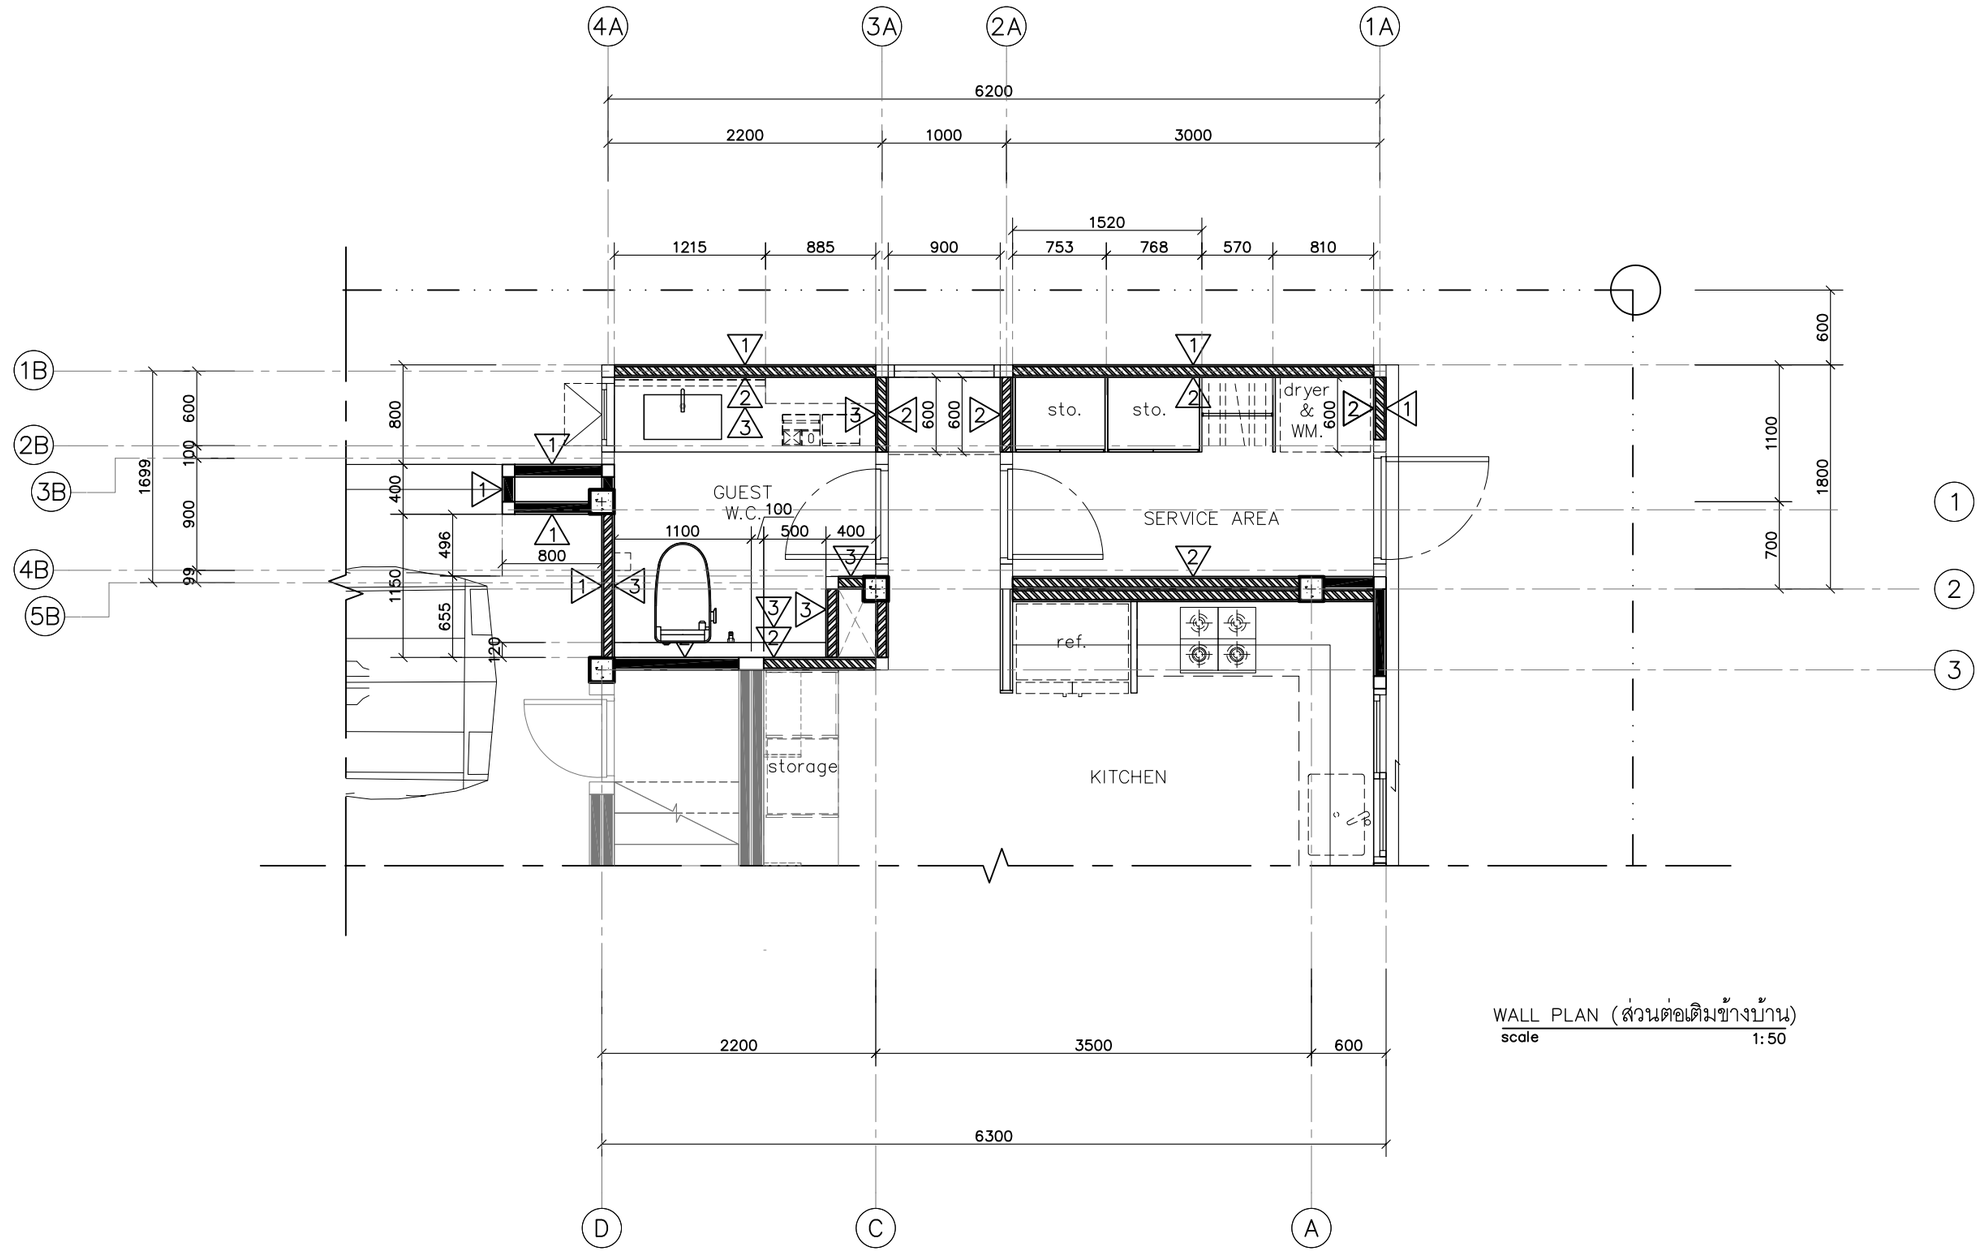

WALL PLAN (ส่วนต่อเติมข้างบ้าน)
scale 1:50

WALL LIST

1 ผนังก่ออิฐฉาบปูน ทาสีน้ำพลาสติกทาภายนอก TOA Supershield Advance สีขาว (ระบุเฉดสีภายหลัง)

2 ผนังก่ออิฐฉาบปูน ทาสีซุปเปอร์ชิลด์ สีน้ำอะคริลิก ชนิดกึ่งเงา สีขาว (ระบุเฉดสีภายหลัง)

3 ผนังก่ออิฐฉาบปูนกรุกระเบื้อง COTTO/GT 60X60 อาร์คสโตน-A ขาว (R11) R/T PM/ขนาด W60XD60XH9.7 มม.

SPACEMAN

PROJECT: SONIA HOUSE
LOCATION: REIGNWOOD PARK LAMLUKKA, PATHUM THANI
ARCHITECT:
INTERIOR DESIGNER: ปรัตถกร ประมุขกุล ภ-สน 1438
STRUCTURAL ENGINEER:
TITLE: 1st FLOOR WALL PLAN (ส่วนต่อเติมข้างบ้าน)

2026-03-13
ID1-06
1:50 @ A3

Note: SPACEMAN takes no responsibility for dimensions obtained by scaling from this drawing. If no dimension is shown the recipient must ascertain the dimension specifically from the architect or by site measurement and may not rely on the drawing. Supply of the drawing in digital form is solely for convenience and no reliance may be placed on any data in digital form. All data must be checked against hard copy. This drawing is issued for design intent only and should not be used for construction unless stated. This drawing is the property of SPACEMAN

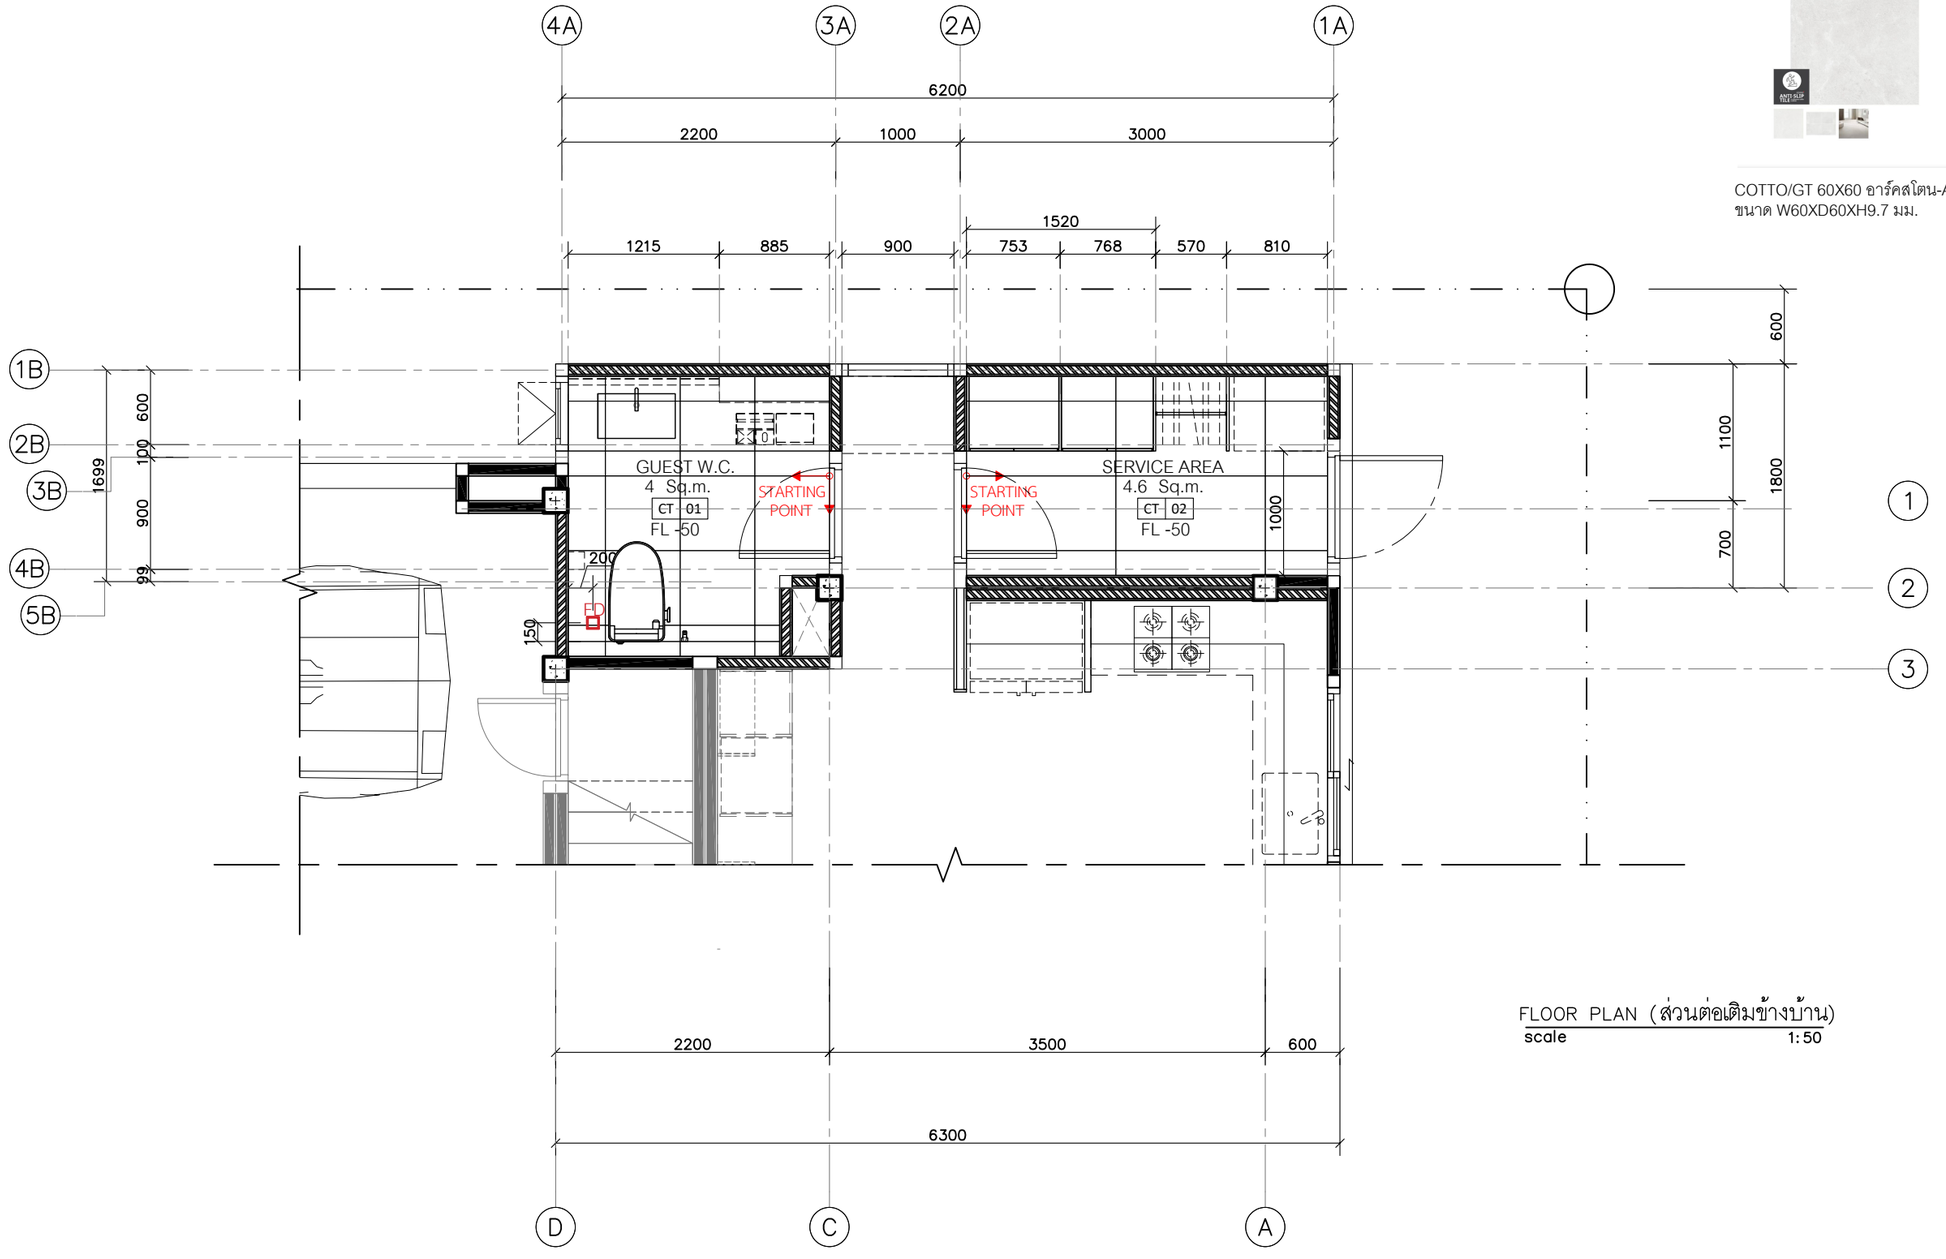

FLOOR PLAN (ส่วนต่อเติมข้างบ้าน)
scale 1:50

CT-01

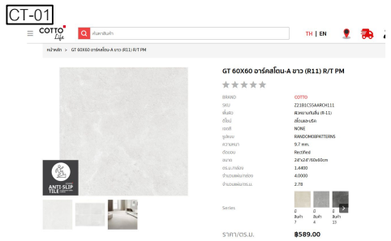

COTTO/GT 60X60 อาร์คสโตน-A ขาว (R11) R/T PM/
ขนาด W60XD60XH9.7 มม.

CT-02

WAWELL DECOR / WWLime Stone Mocca [R10]
สีขาว / ขนาด 1200x600 มม.

FLOOR DRAIN

KOHLER/K-75422T-CP ตะแกรงกันกลิ่น 10x10 cm./
ขนาด W100XD100XH82 มม.

SPACEMAN

PROJECT: SONIA HOUSE
LOCATION: REIGNWOOD PARK
LAMLUKKA, PATHUM THANI
ARCHITECT:
INTERIOR DESIGNER: ปรัตถกร ประมุขกุล ภ-สน 1438
STRUCTURAL ENGINEER:
TITLE: 1st FLOOR
FLOOR PLAN (ส่วนต่อเติมข้างบ้าน)
2026-03-13
ID1-07
1:50 @ A3

Note: SPACEMAN takes no responsibility for dimensions obtained by scaling from this drawing. If no dimension is shown the recipient must ascertain the dimension specifically from the architect or by site measurement and may not rely on the drawing. Supply of the drawing in digital form is solely for convenience and no reliance may be placed on any data in digital form. All data must be checked against hard copy. This drawing is issued for design intent only and should not be used for construction unless stated. This drawing is the property of SPACEMAN

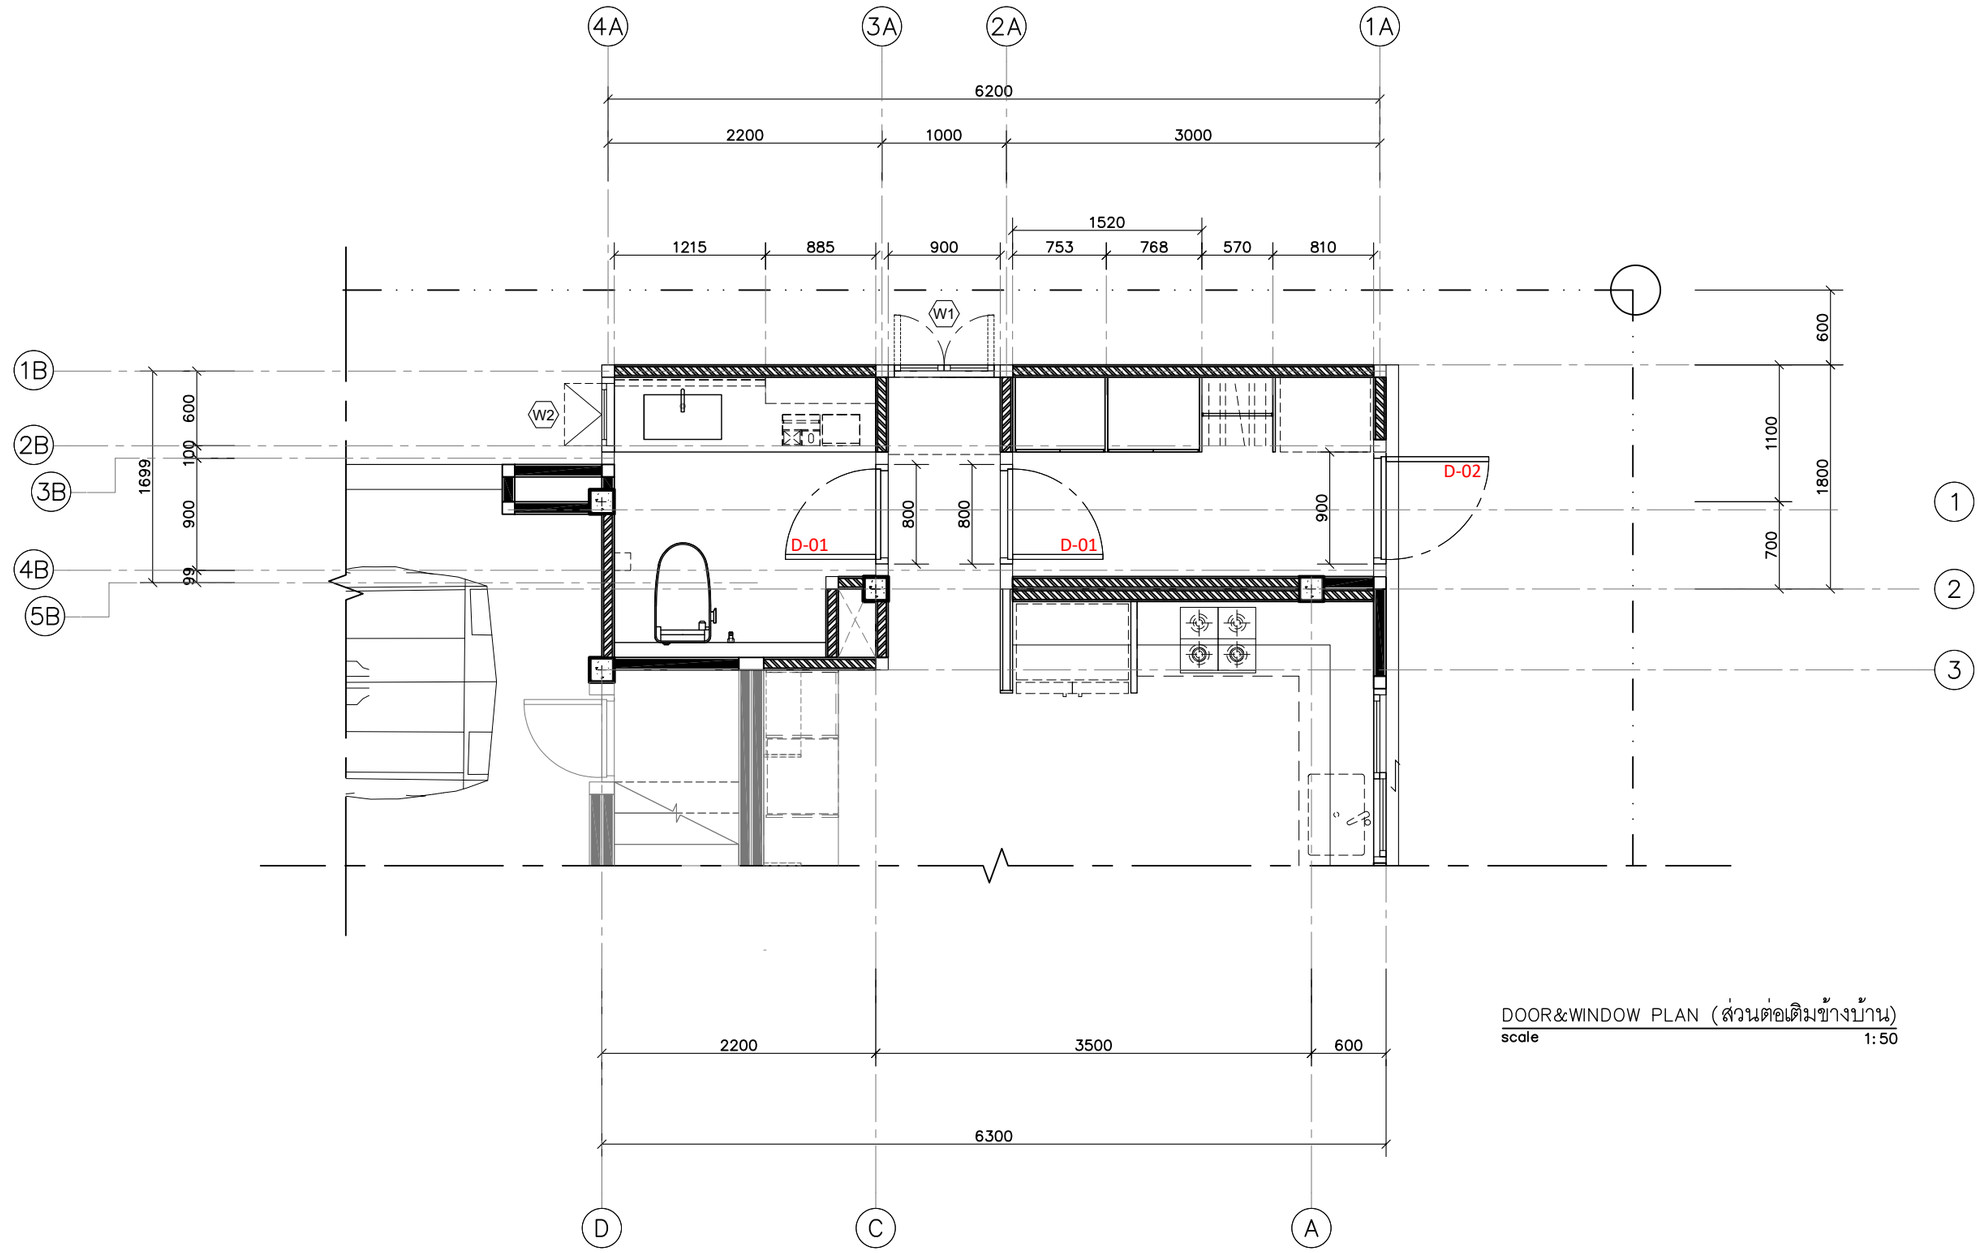

DOOR&WINDOW PLAN (ส่วนต่อเติมข้างบ้าน)
scale 1:50

SPACEMAN

PROJECT: SONIA HOUSE

LOCATION: REIGNWOOD PARK
LAMLUKKA, PATHUM THANI

ARCHITECT:

INTERIOR DESIGNER: ปรัตถกร ประมุขกุล ภ-สน 1438

STRUCTURAL ENGINEER:

TITLE: 1st FLOOR
LAYOUT PLAN (ส่วนต่อเติมข้างบ้าน)

2026-03-13
ID1-08
1:50 @ A3

Note: SPACEMAN takes no responsibility for dimensions obtained by scaling from this drawing. If no dimension is shown the recipient must ascertain the dimension specifically from the architect or by site measurement and may not rely on the drawing. Supply of the drawing in digital form is solely for convenience and no reliance may be placed on any data in digital form. All data must be checked against hard copy. This drawing is issued for design intent only and should not be used for construction unless stated. This drawing is the property of SPACEMAN

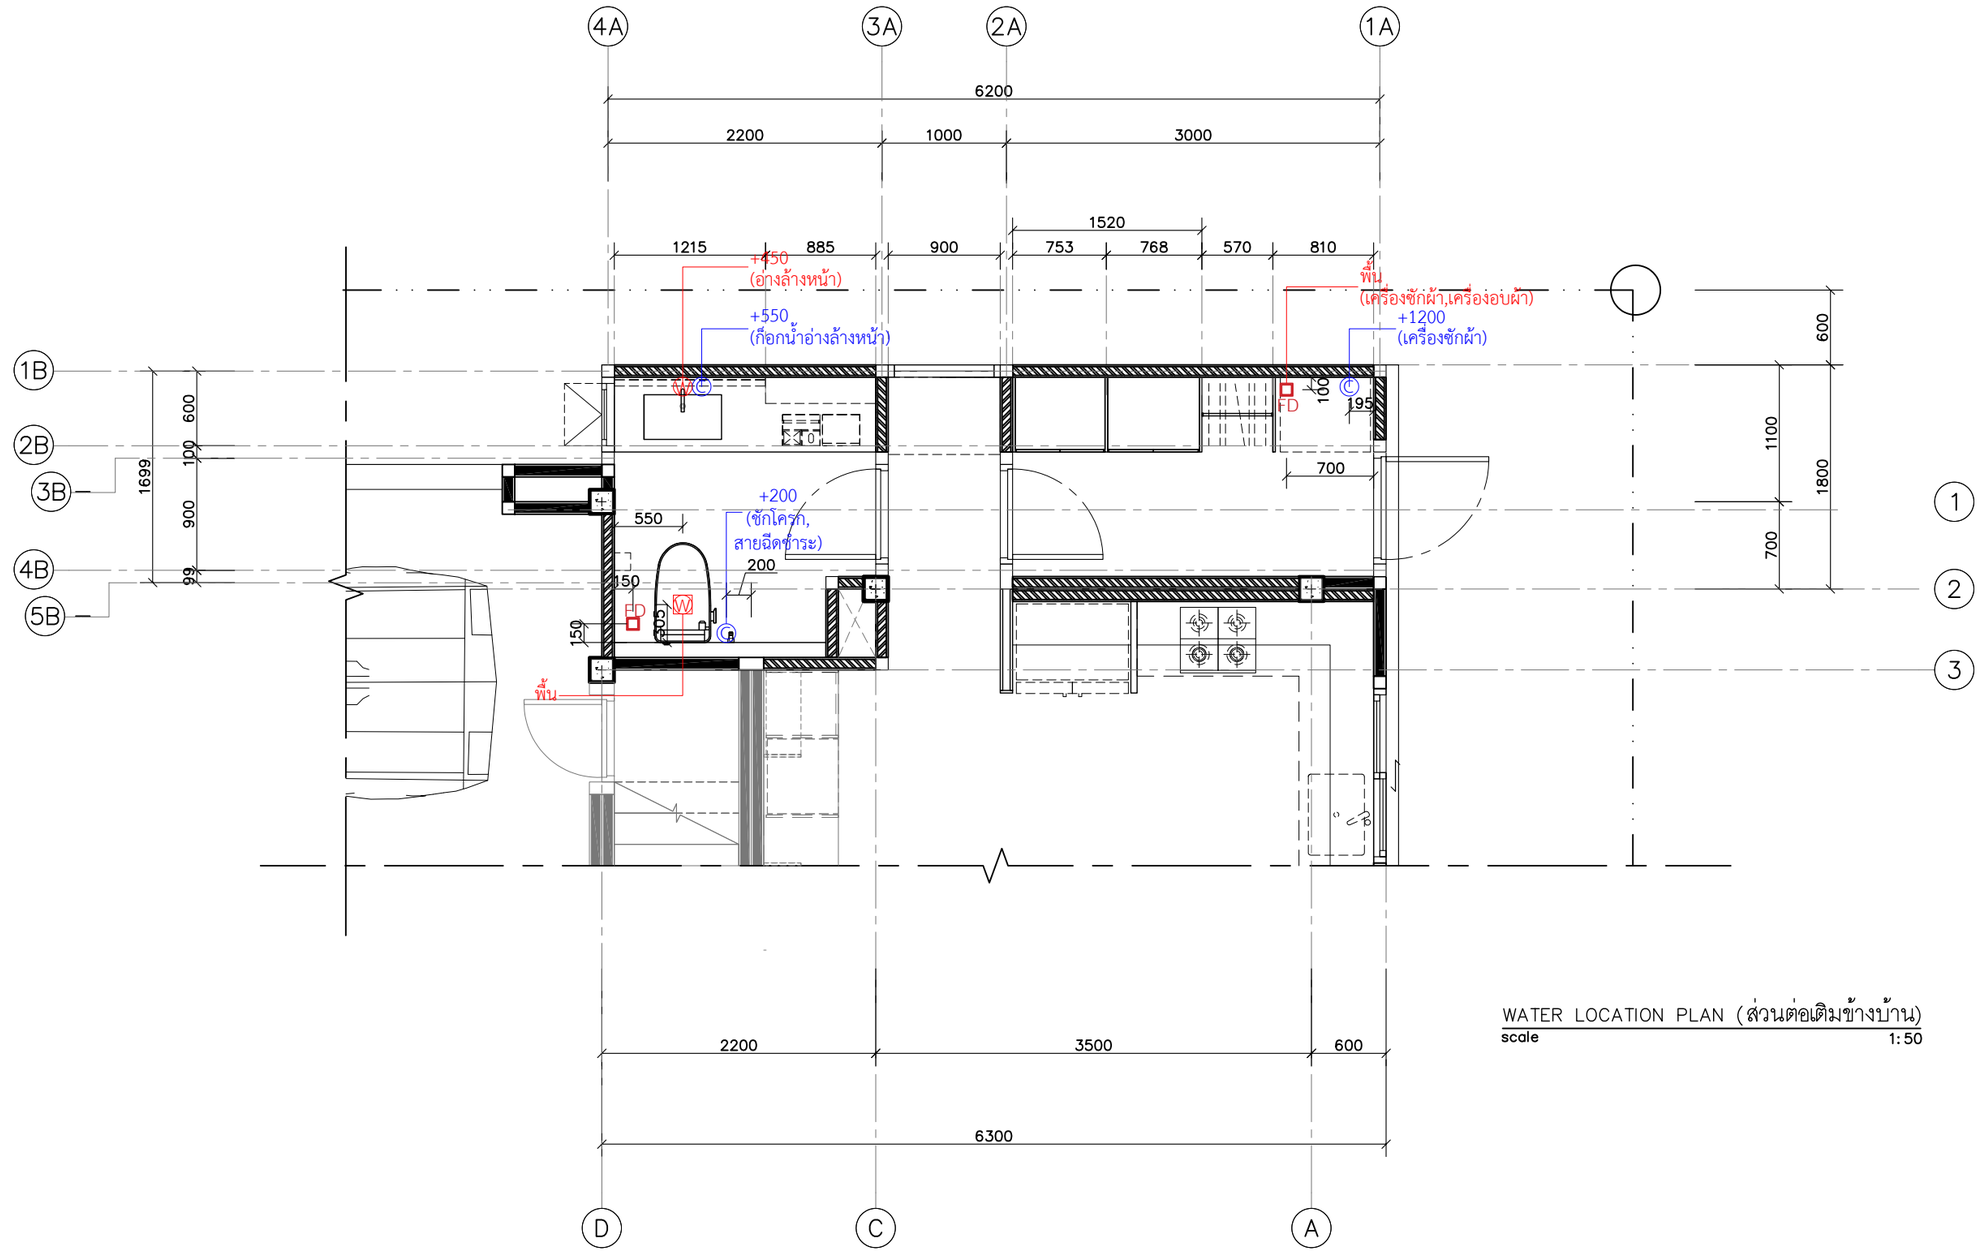

WATER LOCATION PLAN (ส่วนต่อเติมข้างบ้าน)
scale 1:50

SPACEMAN

PROJECT: SONIA HOUSE

LOCATION: REIGNWOOD PARK
LAMLUKKA, PATHUM THANI

ARCHITECT:

INTERIOR DESIGNER: ปรัตถกร ประมุขกุล ภ-สน 1438

STRUCTURAL ENGINEER:

TITLE: 1st FLOOR
WATER LOCATION PLAN
(ส่วนต่อเติมข้างบ้าน)

2026-03-13
ID1-09
1:50 @ A3

Note: SPACEMAN takes no responsibility for dimensions obtained by scaling from this drawing. If no dimension is shown the recipient must ascertain the dimension specifically from the architect or by site measurement and may not rely on the drawing. Supply of the drawing in digital form is solely for convenience and no reliance may be placed on any data in digital form. All data must be checked against hard copy. This drawing is issued for design intent only and should not be used for construction unless stated. This drawing is the property of SPACEMAN

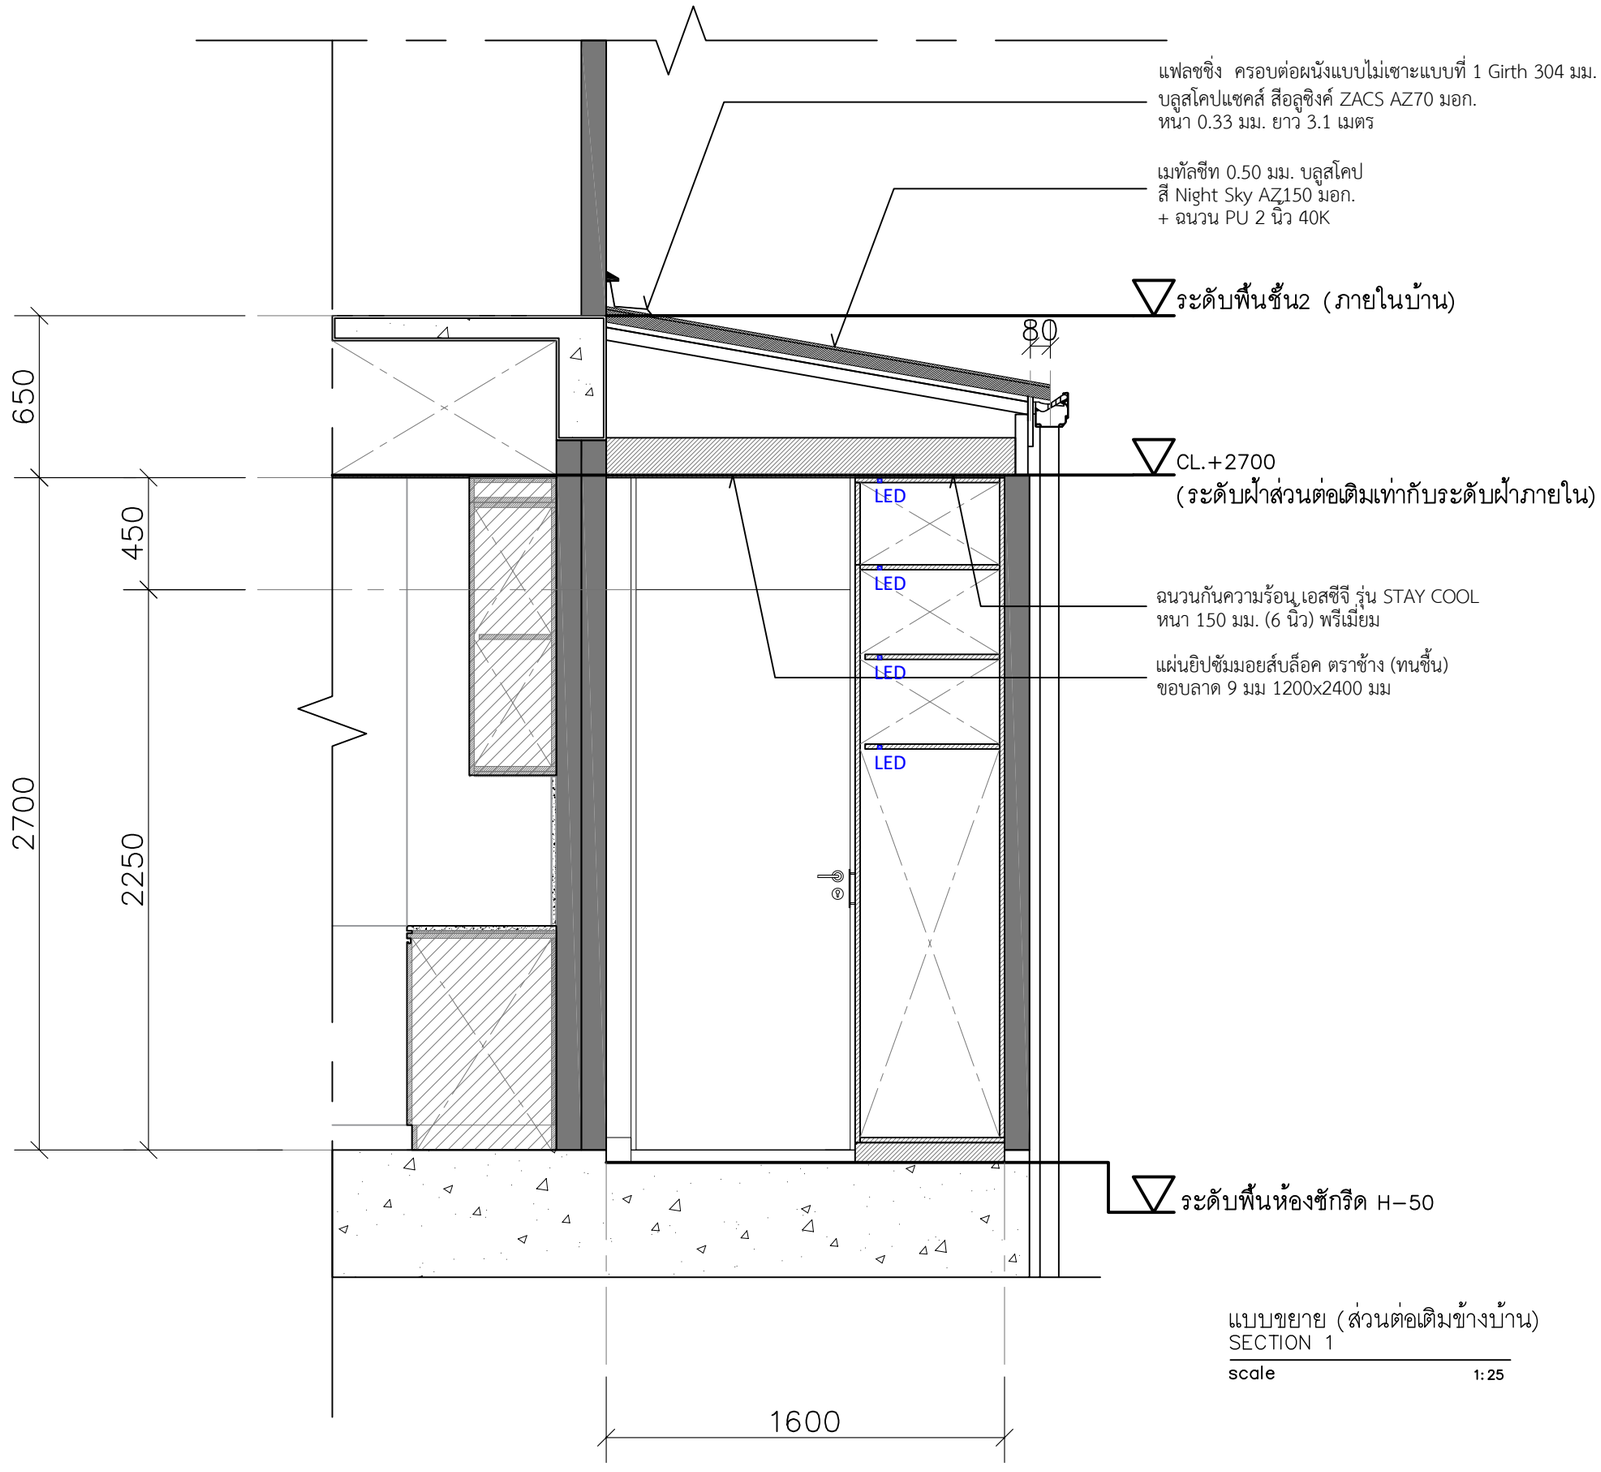

แบบขยาย (ส่วนต่อเติมข้างบ้าน)
SECTION 1
scale 1:25

SPACEMAN

PROJECT | SONIA HOUSE

LOCATION | REIGNWOOD PARK
LAMLUKKA, PATHUM THANI

ARCHITECT

INTERIOR DESIGNER | ปรัตถกร ประมุขกุล ภ-สน 1438

STRUCTURAL ENGINEER

TITLE | 1st FLOOR
SECTION 1 (ส่วนต่อเติมข้างบ้าน)

2026-03-13
ID3-01

1:25 @ A3

Note: SPACEMAN takes no responsibility for dimensions obtained by scaling from this drawing. If no dimension is shown the recipient must ascertain the dimension specifically from the architect or by site measurement and may not rely on the drawing. Supply of the drawing in digital form is solely for convenience and no reliance may be placed on any data in digital form. All data must be checked against hard copy. This drawing is issued for design intent only and should not be used for construction unless stated. This drawing is the property of SPACEMAN

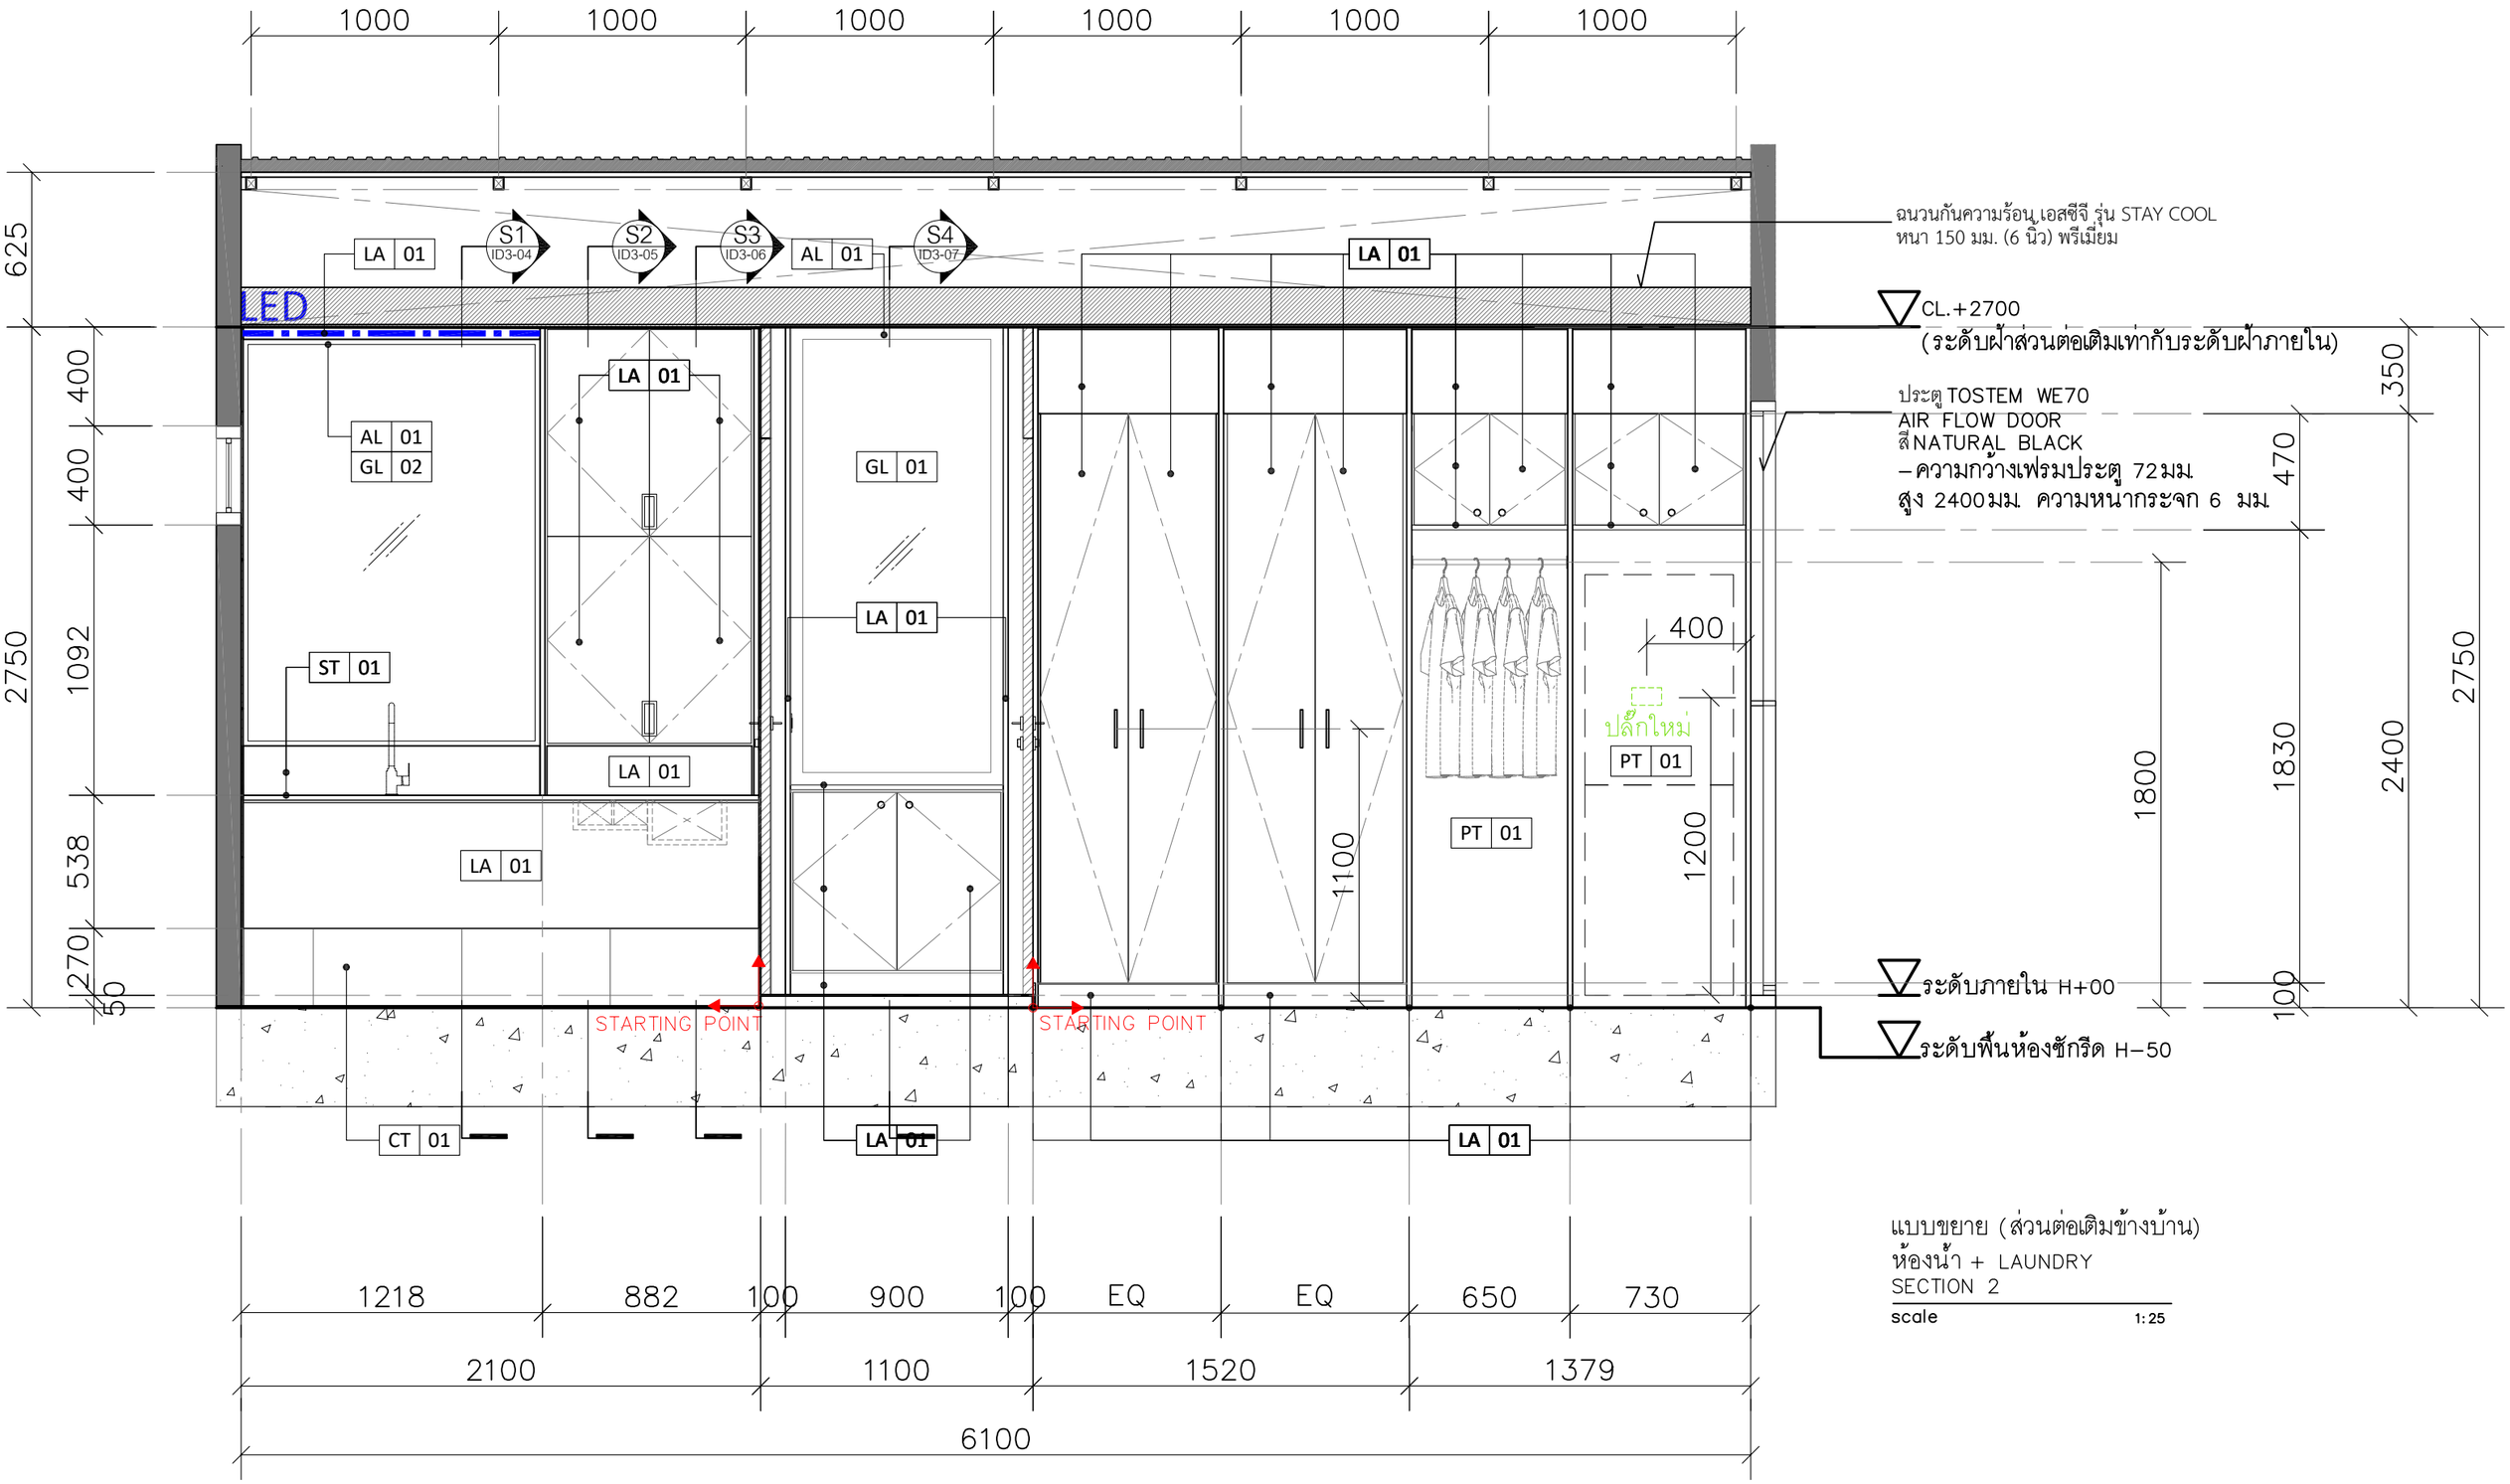

แบบขยาย (ส่วนต่อเติมข้างบ้าน)
ห้องน้ำ + LAUNDRY
SECTION 2

scale 1:25

ผู้รับเหมาดูคู่มือการติดตั้งสุขภัณฑ์ก่อนดำเนินการติดตั้ง

SPACEMAN

PROJECT SONIA HOUSE

LOCATION REIGNWOOD PARK
LAMLUKKA, PATHUM THANI

ARCHITECT

INTERIOR DESIGNER ปรัตถกร ประมุขกุล ภ–สน 1438

STRUCTURAL ENGINEER

TITLE 1st FLOOR
SECTION 2 (ส่วนต่อเติมข้างบ้าน)
ห้องน้ำ + LAUNDRY

2026–03–13
ID3–02

1:25 @ A3

Note: SPACEMAN takes no responsibility for dimensions obtained by scaling from this drawing. If no dimension is shown the recipient must ascertain the dimension specifically from the architect or by site measurement and may not rely on the drawing. Supply of the drawing in digital form is solely for convenience and no reliance may be placed on any data in digital form. All data must be checked against hard copy. This drawing is issued for design intent only and should not be used for construction unless stated. This drawing is the property of SPACEMAN

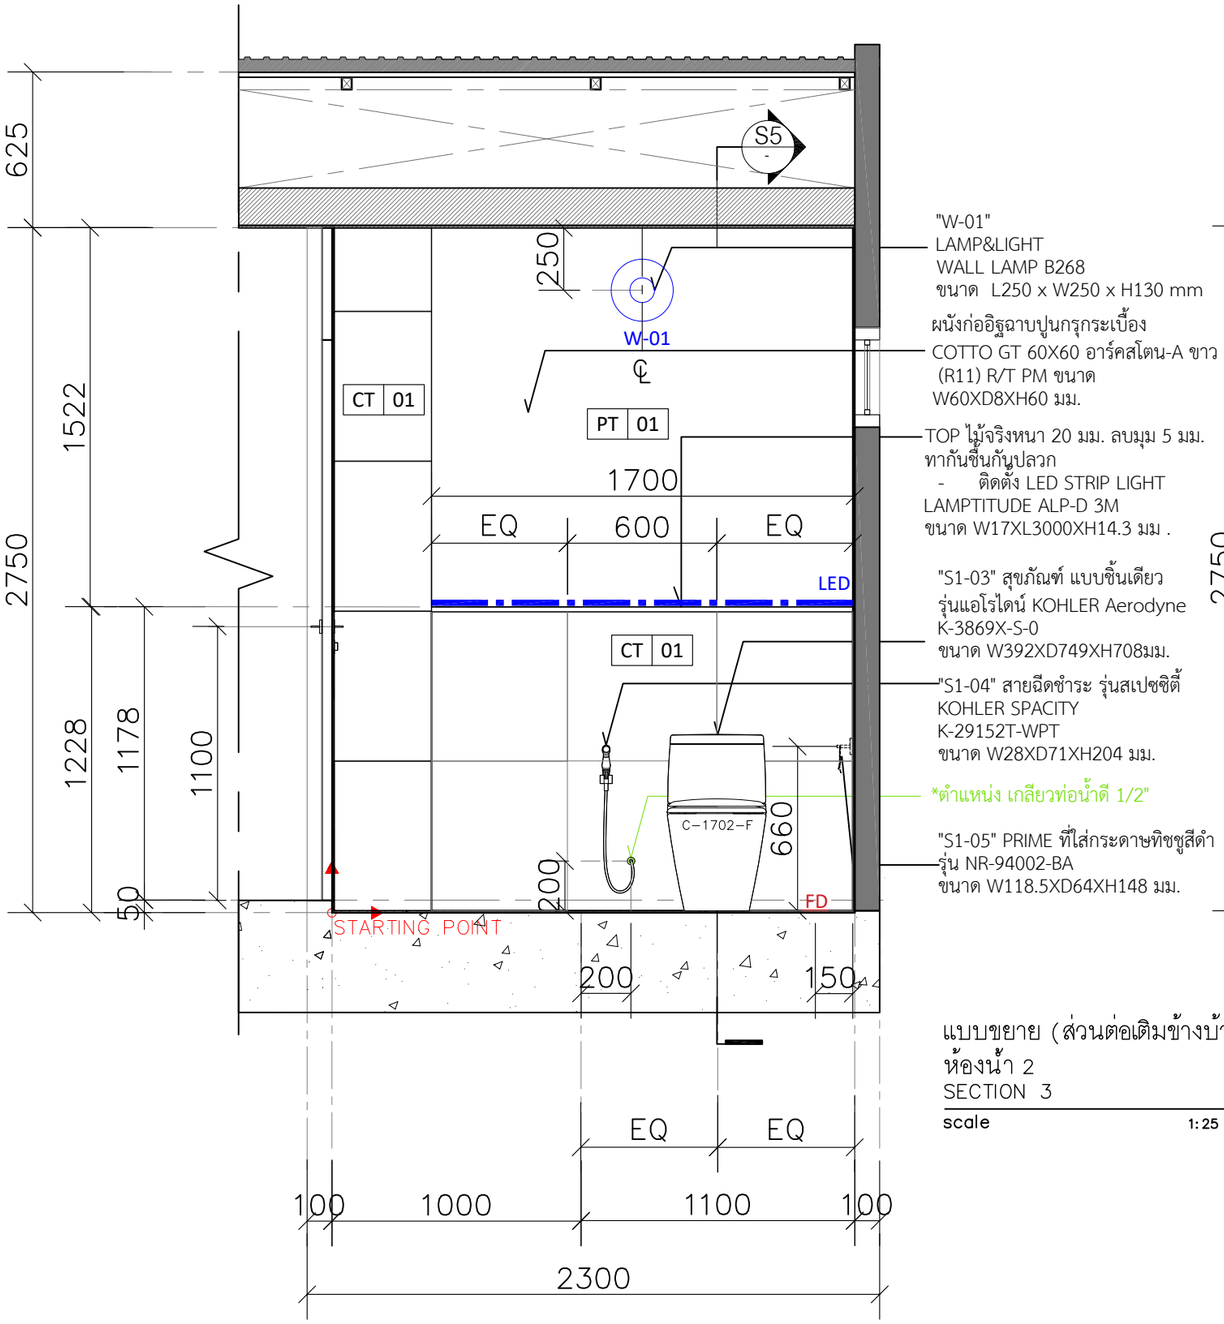

แบบขยาย (ส่วนต่อเติมข้างบ้าน)
ห้องน้ำ 2
SECTION 3
scale 1:25

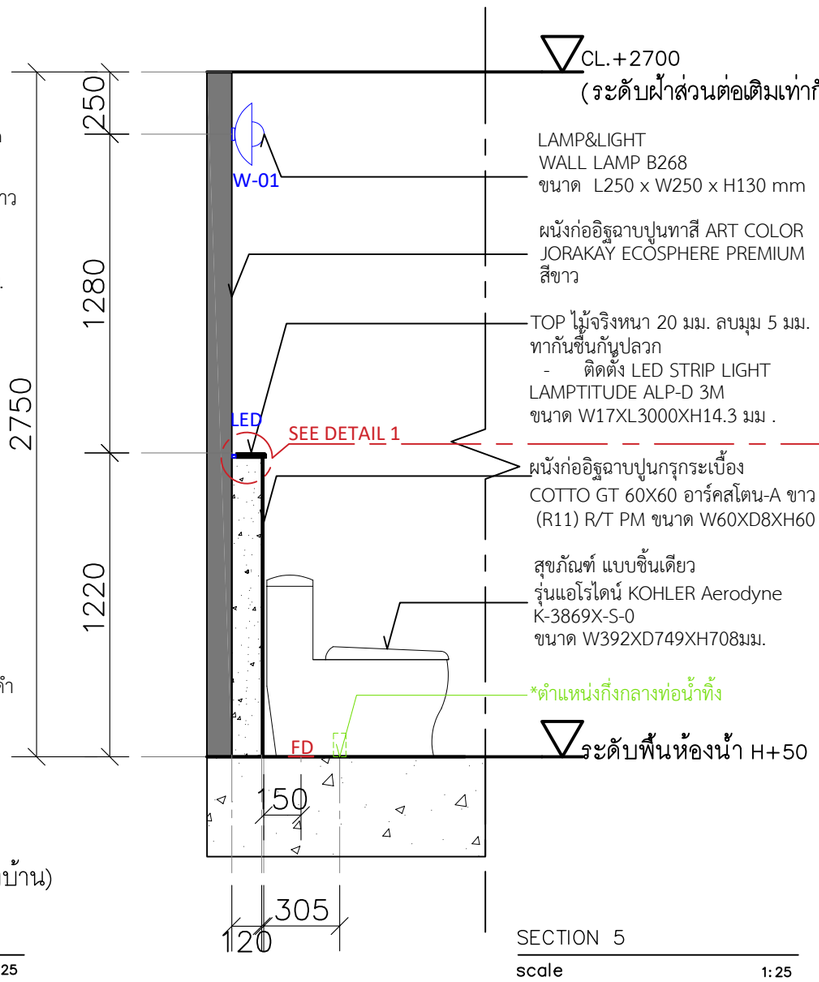

SECTION 5
scale 1:25

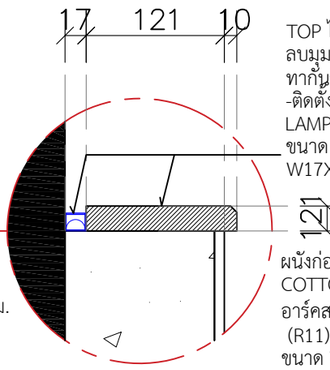

DETAIL 1
scale 1:5

ผู้รับเหมาดูคู่มือการติดตั้งสุขภัณฑ์ก่อนดำเนินการติดตั้ง

SPACEMAN

PROJECT: SONIA HOUSE
LOCATION: REIGNWOOD PARK
LAMLUKKA, PATHUM THANI
ARCHITECT:
INTERIOR DESIGNER: ปรัตถกร ประมุขกุล ภ-สน 1438
STRUCTURAL ENGINEER:
TITLE: 1st FLOOR
SECTION 3 (ส่วนต่อเติมห้องน้ำ)
SECTION 5 , DETAIL 1
2026-03-13
ID3-03
1:25 @ A3

Note: SPACEMAN takes no responsibility for dimensions obtained by scaling from this drawing. If no dimension is shown the recipient must ascertain the dimension specifically from the architect or by site measurement and may not rely on the drawing. Supply of the drawing in digital form is solely for convenience and no reliance may be placed on any data in digital form. All data must be checked against hard copy. This drawing is issued for design intent only and should not be used for construction unless stated. This drawing is the property of SPACEMAN

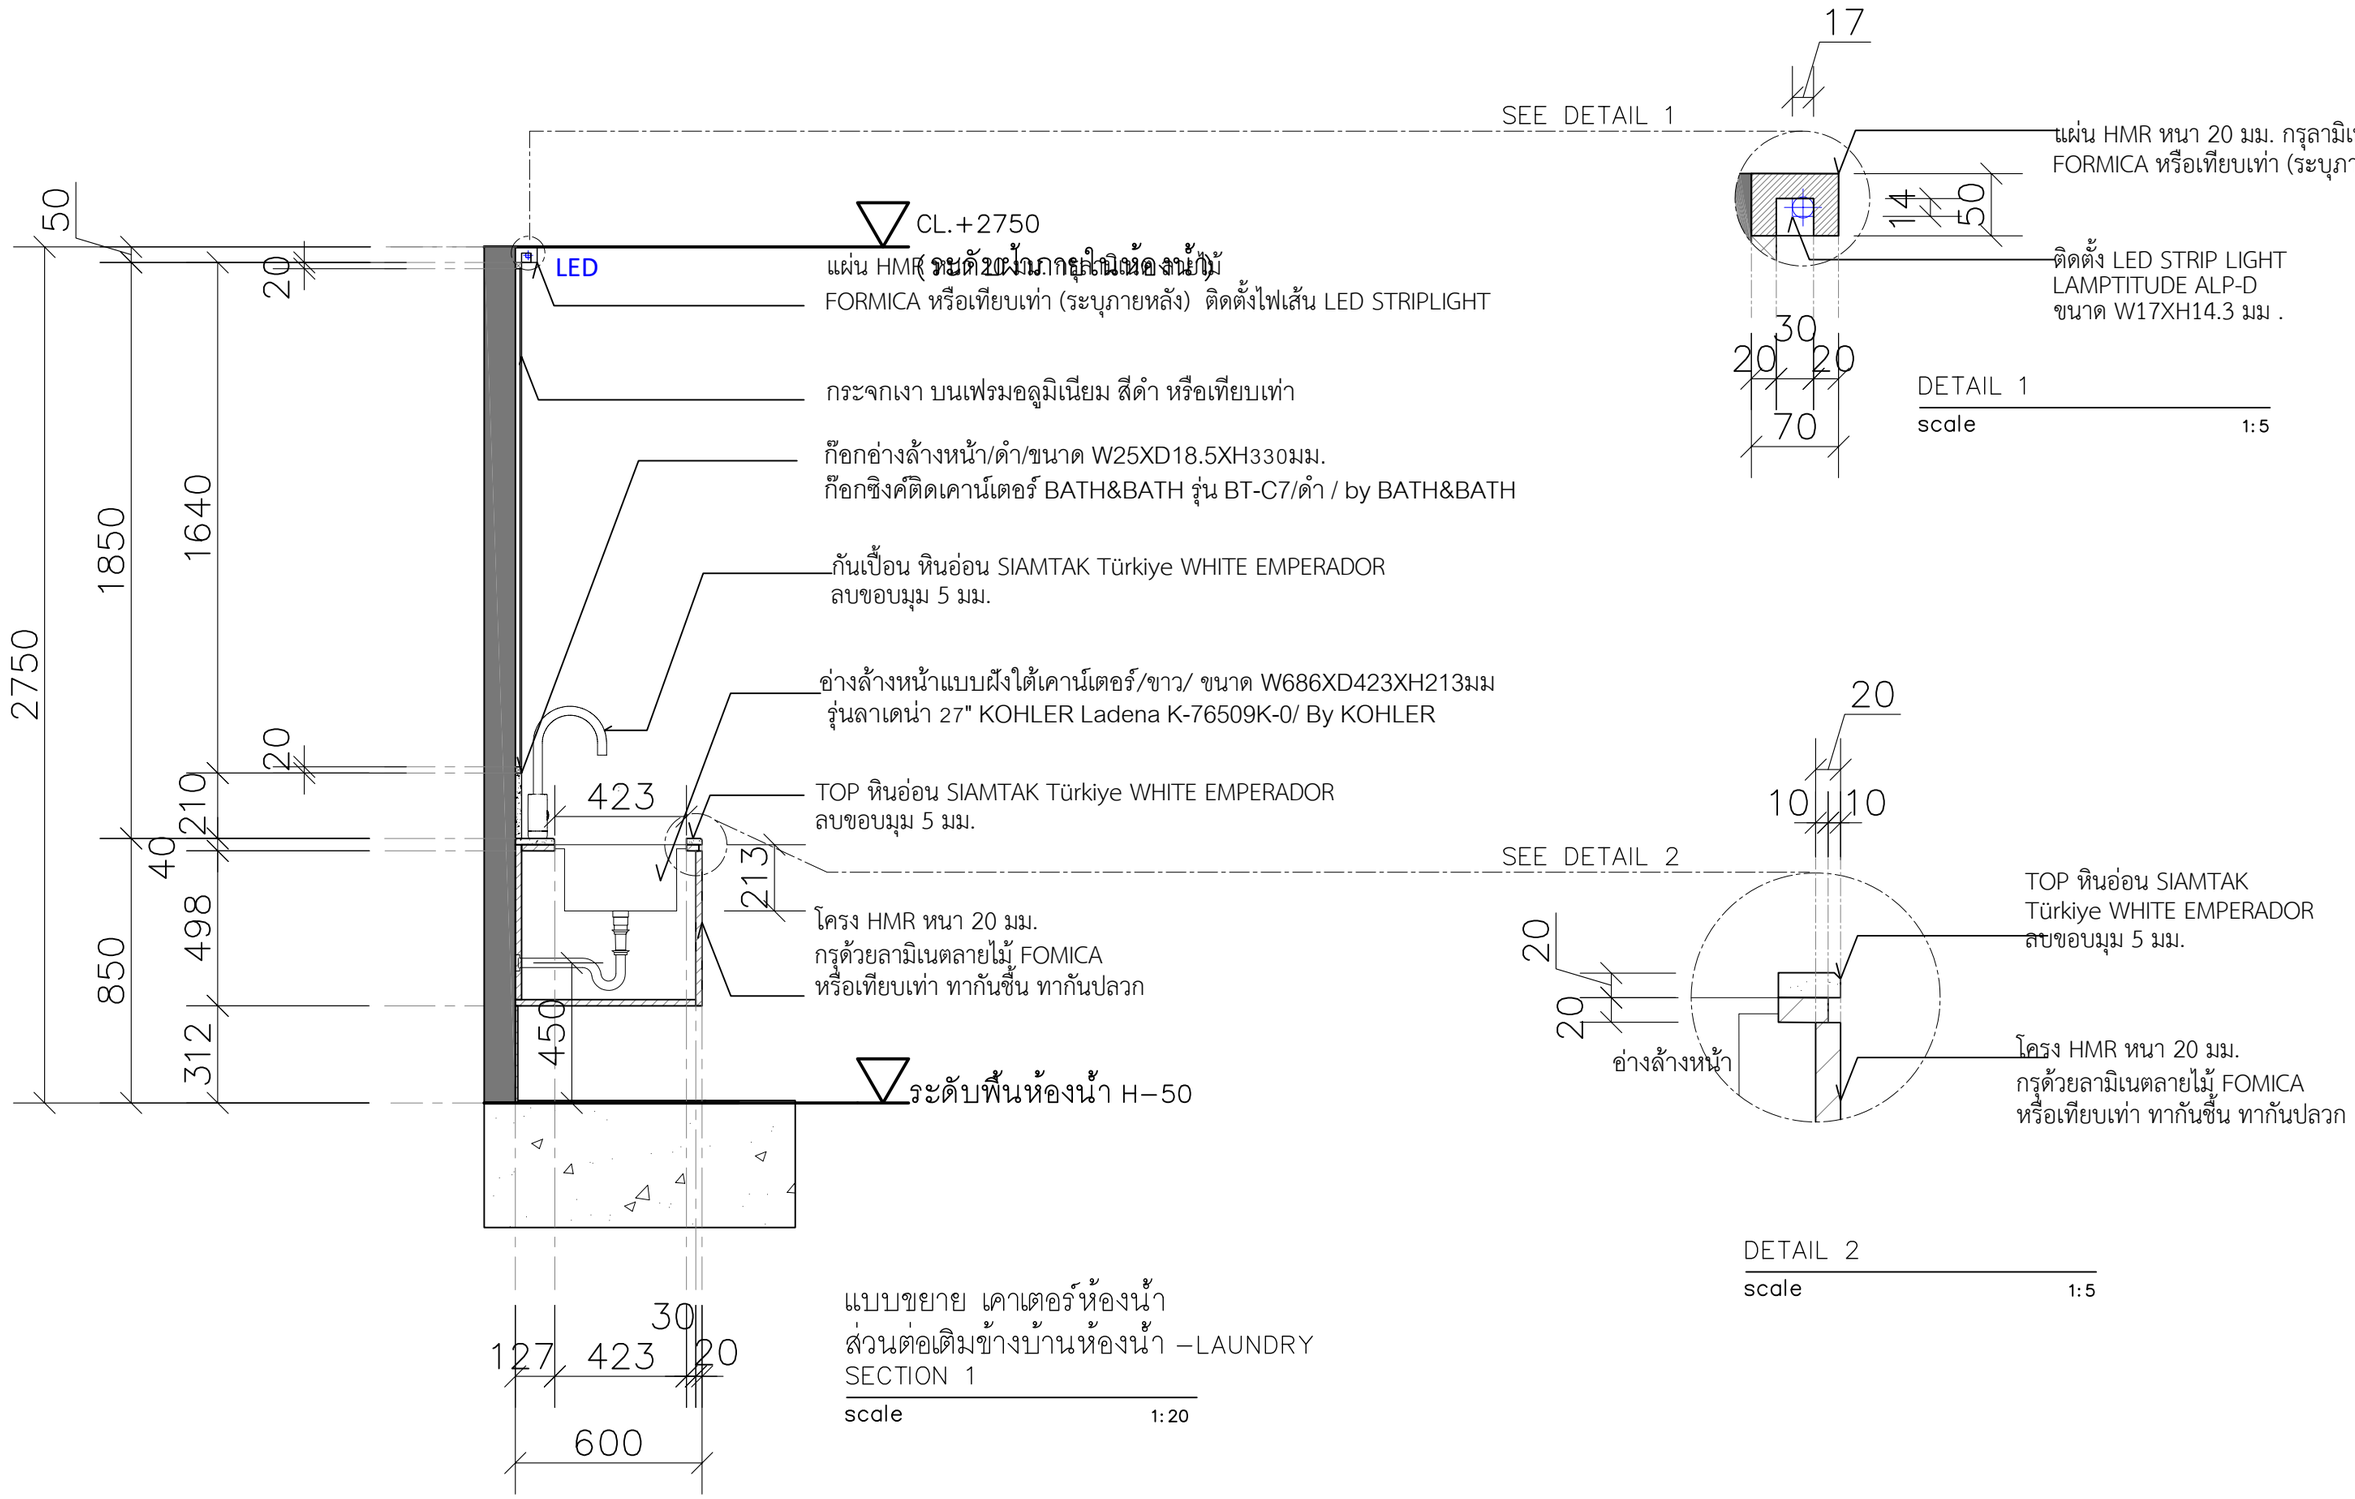

DETAIL 1

scale 1:5

DETAIL 2

scale 1:5

แบบขยาย เคาเตอร์ห้องน้ำ
ส่วนต่อเติมข้างบ้านห้องน้ำ –LAUNDRY
SECTION 1

scale 1:20

SPACEMAN

PROJECT: SONIA HOUSE

LOCATION: REIGNWOOD PARK
LAMLUKKA, PATHUM THANI

ARCHITECT:

INTERIOR DESIGNER: ปรัตถกร ประมุขกุล ภ-สน 1438

STRUCTURAL ENGINEER:

TITLE: 1st FLOOR (ส่วนต่อเติมข้างบ้าน)
แบบขยาย เคาเตอร์ห้องน้ำ
SECTION ,DETAIL

2026-06-25
ID3-04

1:20 @ A3

Note: SPACEMAN takes no responsibility for dimensions obtained by scaling from this drawing. If no dimension is shown the recipient must ascertain the dimension specifically from the architect or by site measurement and may not rely on the drawing. Supply of the drawing in digital form is solely for convenience and no reliance may be placed on any data in digital form. All data must be checked against hard copy. This drawing is issued for design intent only and should not be used for construction unless stated. This drawing is the property of SPACEMAN

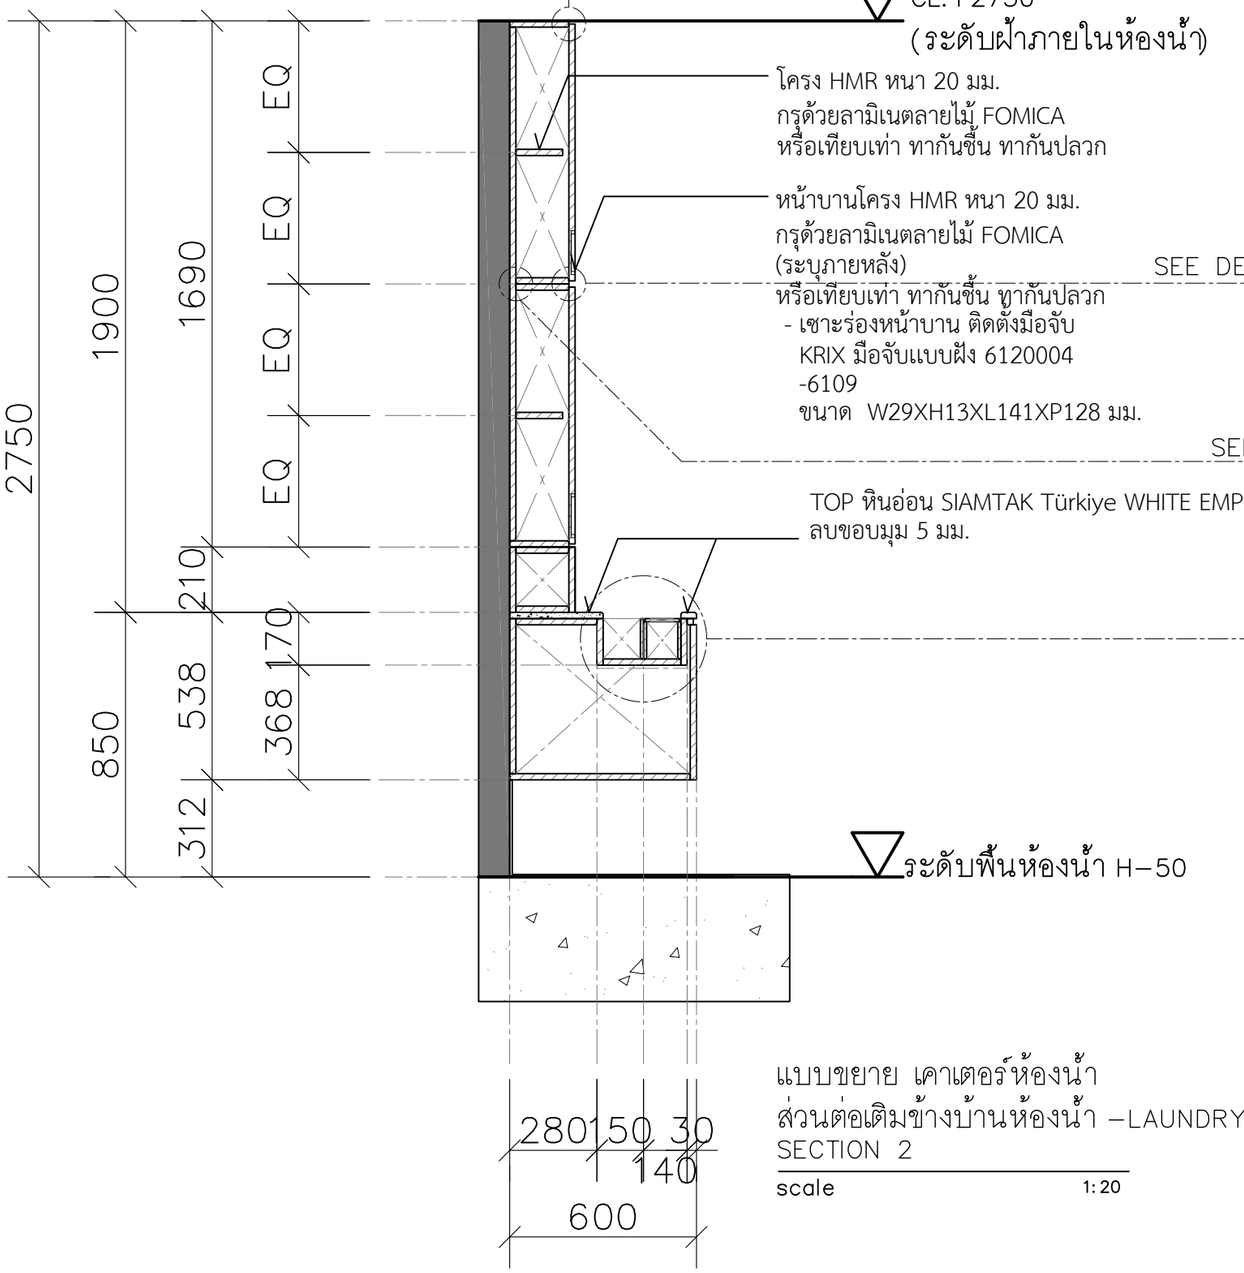

แบบขยาย เคาเตอร์ห้องน้ำ
ส่วนต่อเติมข้างบ้านห้องน้ำ -LAUNDRY
SECTION 2

scale 1:20

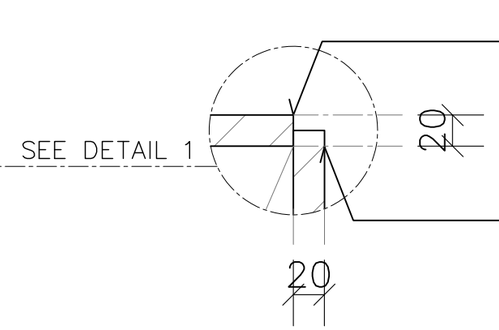

DETAIL 1

scale 1:5

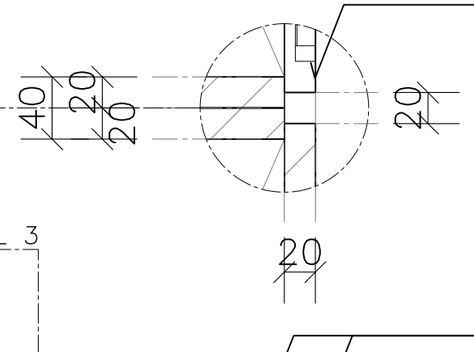

DETAIL 2

scale 1:5

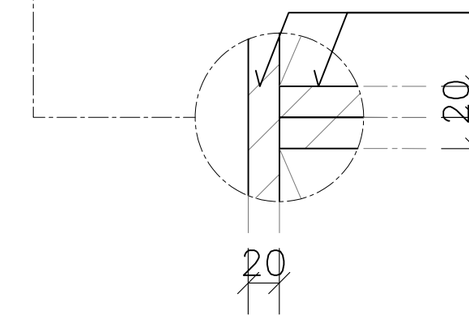

DETAIL 3

scale 1:5

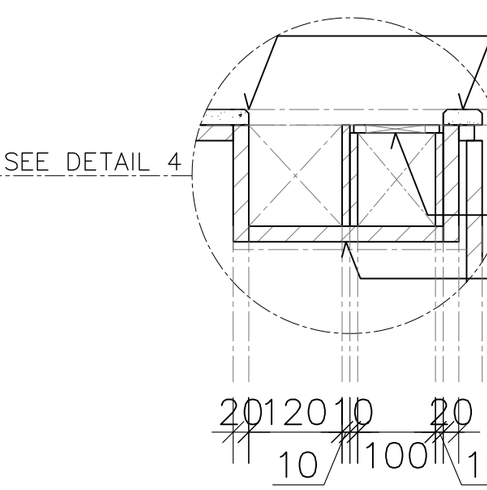

DETAIL 4

scale 1:10

SPACEMAN

PROJECT SONIA HOUSE

LOCATION REIGNWOOD PARK
LAMLUKKA, PATHUM THANI

ARCHITECT

INTERIOR DESIGNER ปรัตถกร ประมุขกุล ภ-สน 1438

STRUCTURAL ENGINEER

TITLE 1st FLOOR (ส่วนต่อเติมข้างบ้าน)
แบบขยาย เคาเตอร์ห้องน้ำ
SECTION ,DETAIL

2026-06-25
ID3-05

1:20 @ A3

Note: SPACEMAN takes no responsibility for dimensions obtained by scaling from this drawing. If no dimension is shown the recipient must ascertain the dimension specifically from the architect or by site measurement and may not rely on the drawing. Supply of the drawing in digital form is solely for convenience and no reliance may be placed on any data in digital form. All data must be checked against hard copy. This drawing is issued for design intent only and should not be used for construction unless stated. This drawing is the property of SPACEMAN

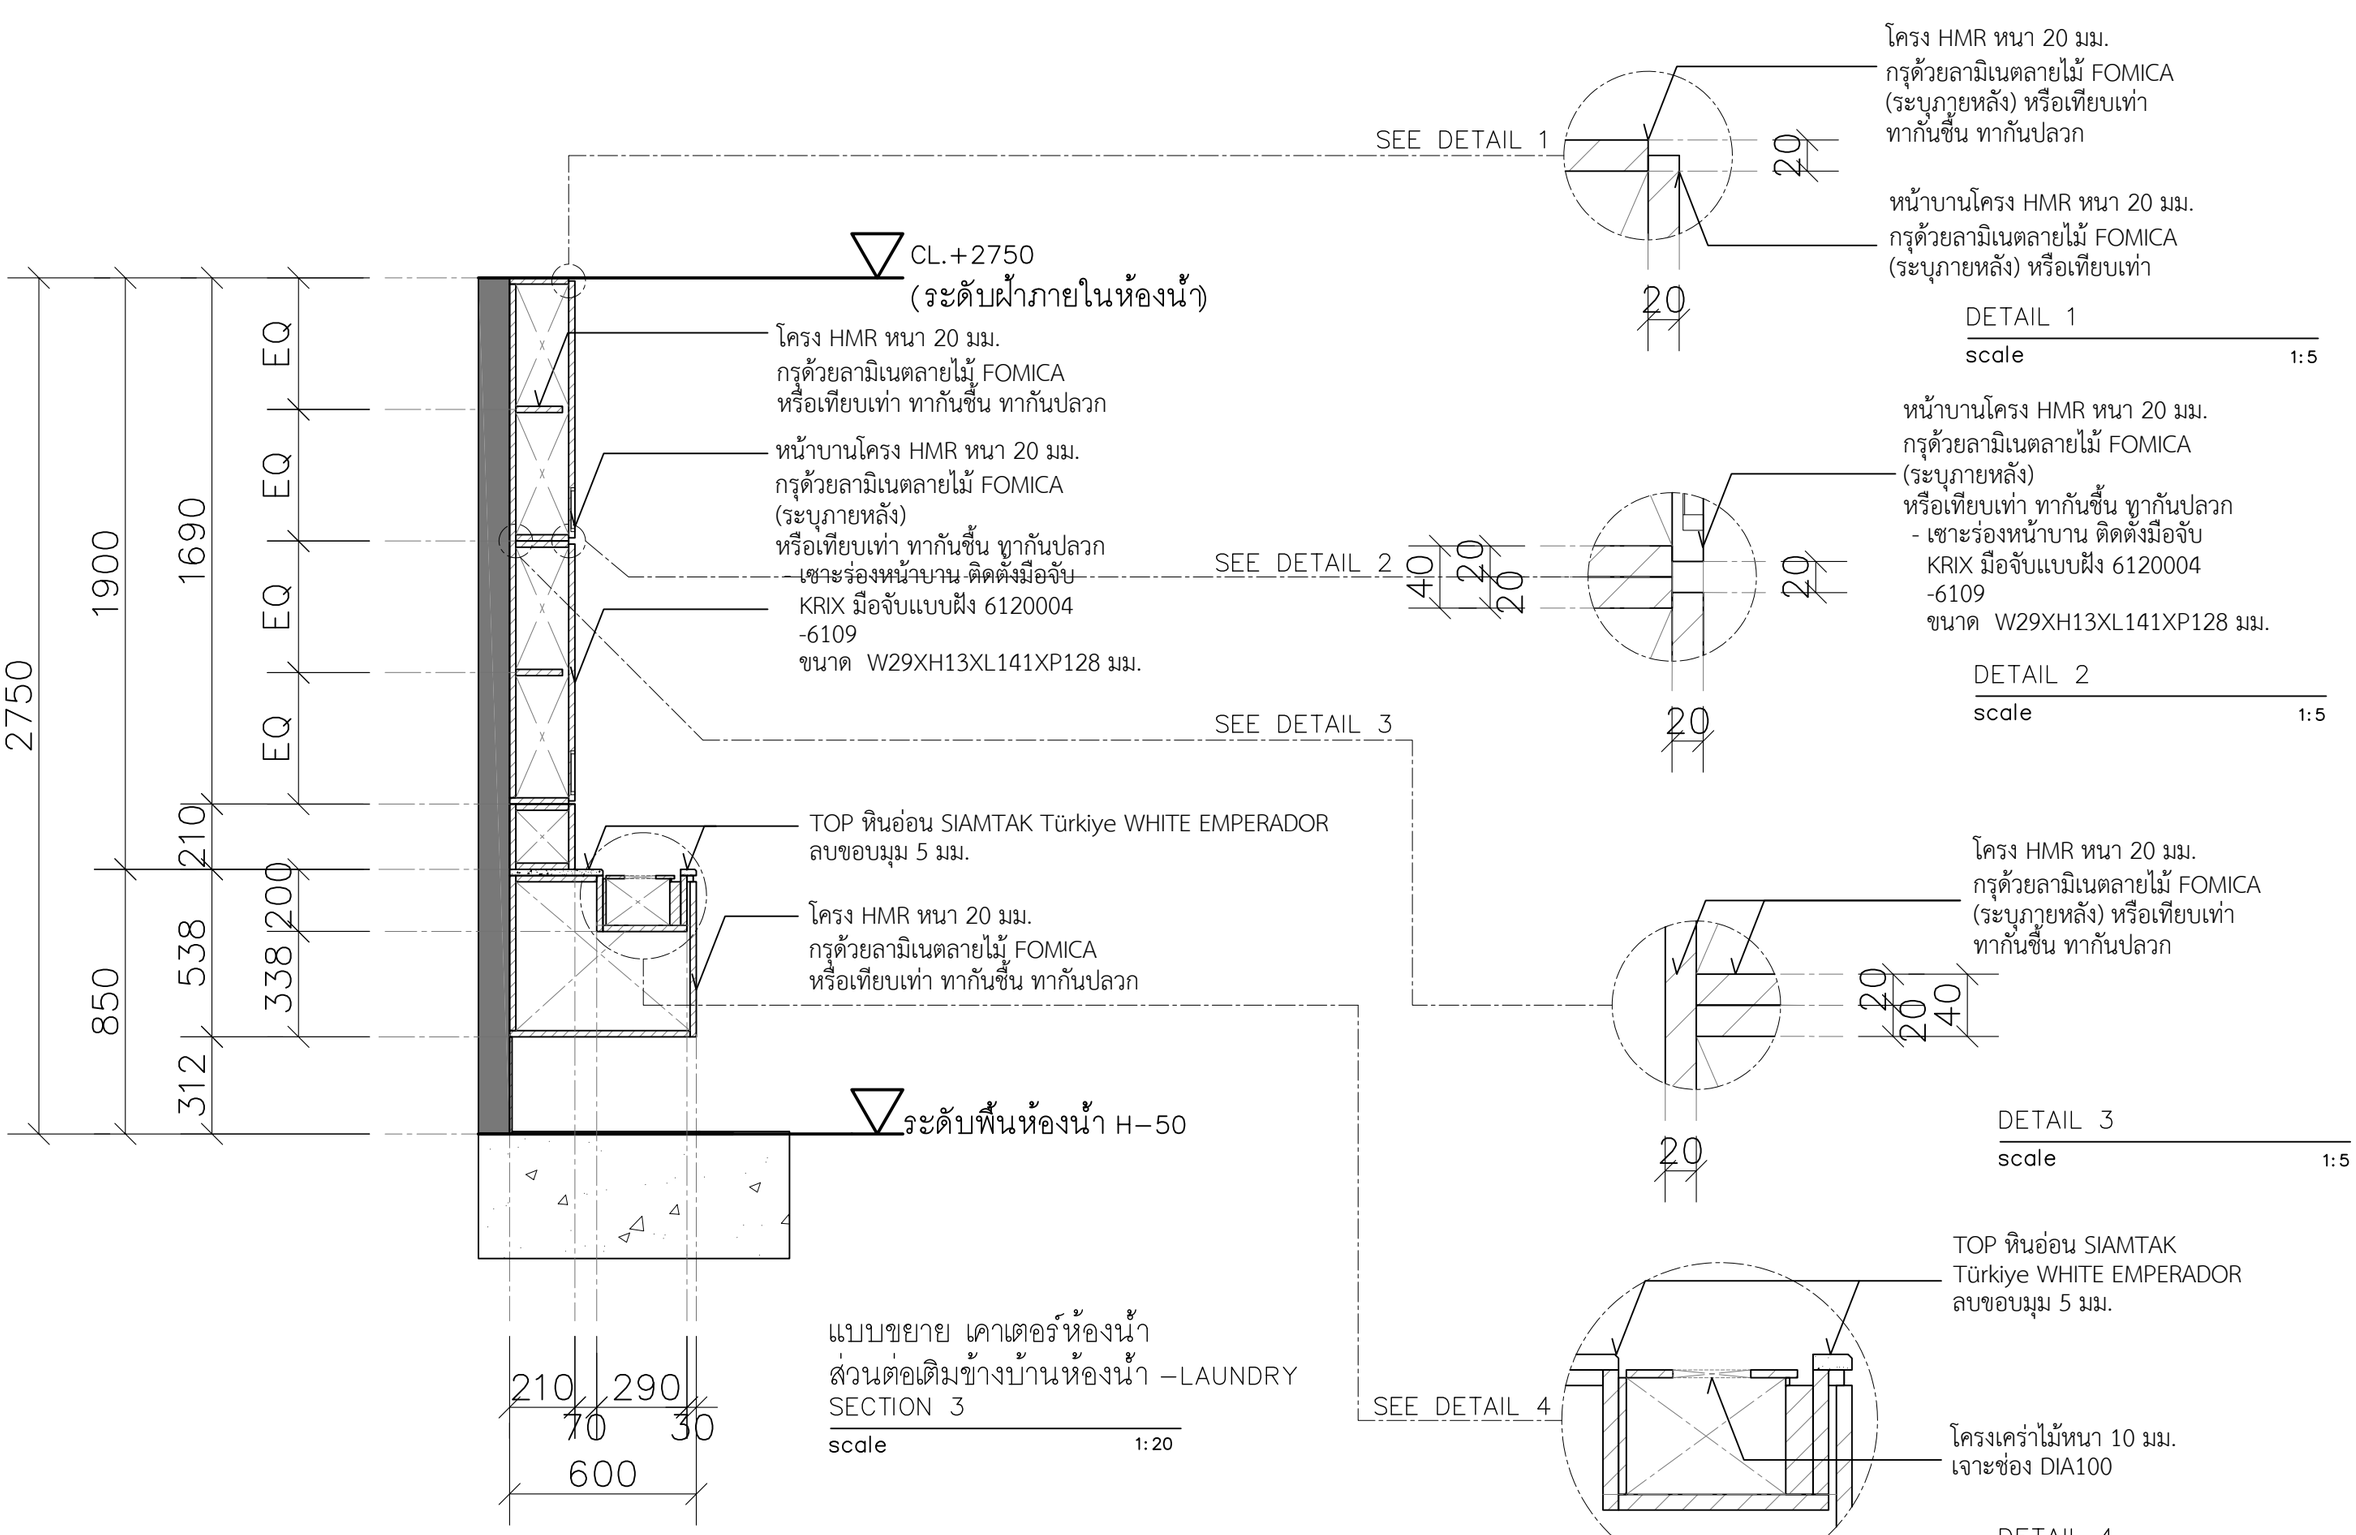

SPACEMAN

PROJECT: SONIA HOUSE

LOCATION: REIGNWOOD PARK
LAMLUKKA, PATHUM THANI

ARCHITECT:

INTERIOR DESIGNER: ปรัตถกร ประมุขกุล ภ-สน 1438

STRUCTURAL ENGINEER:

TITLE: 1st FLOOR (ส่วนต่อเติมข้างบ้าน)
แบบขยาย เคาเตอร์ห้องน้ำ
SECTION ,DETAIL

2026-06-25
ID3-06

1:20 @ A3

Note: SPACEMAN takes no responsibility for dimensions obtained by scaling from this drawing. If no dimension is shown the recipient must ascertain the dimension specifically from the architect or by site measurement and may not rely on the drawing. Supply of the drawing in digital form is solely for convenience and no reliance may be placed on any data in digital form. All data must be checked against hard copy. This drawing is issued for design intent only and should not be used for construction unless stated. This drawing is the property of SPACEMAN

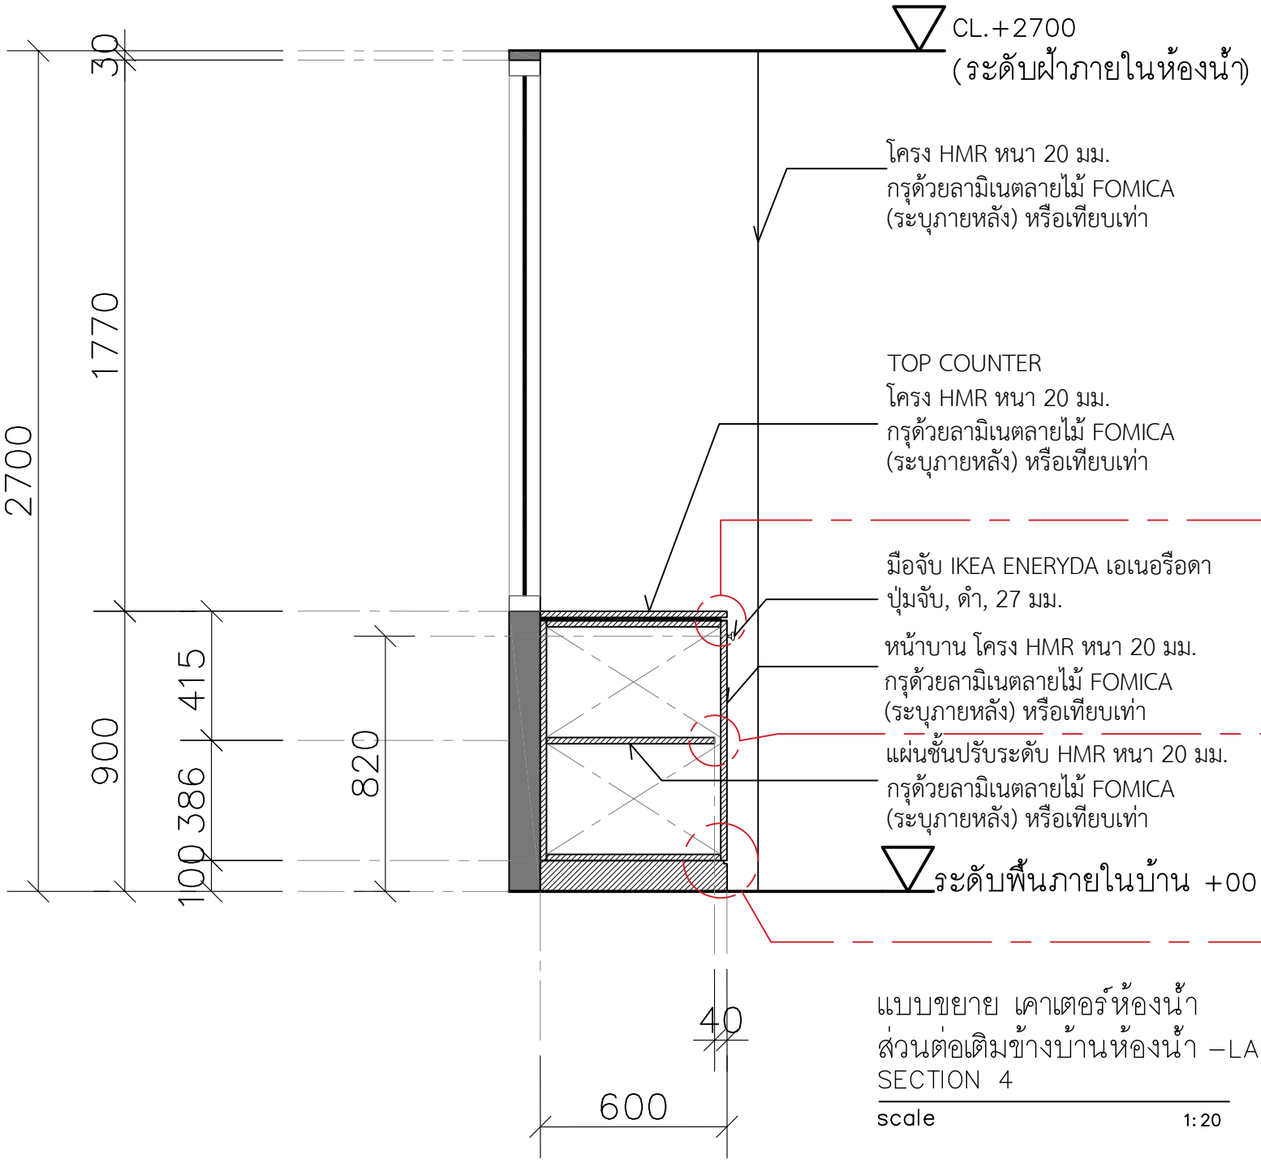

แบบขยาย เคาเตอร์ห้องน้ำ
ส่วนต่อเติมข้างบ้านห้องน้ำ –LAUNDRY
SECTION 4

scale 1:20

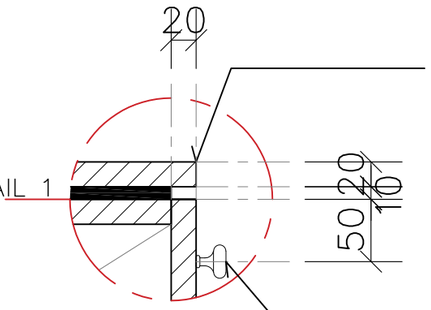

DETAIL 1

scale 1:5

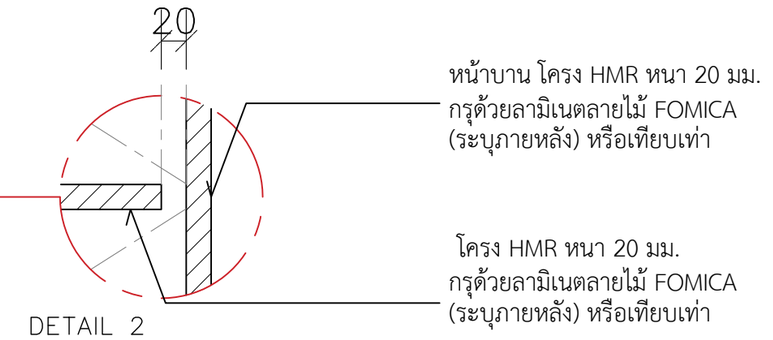

DETAIL 2

scale 1:5

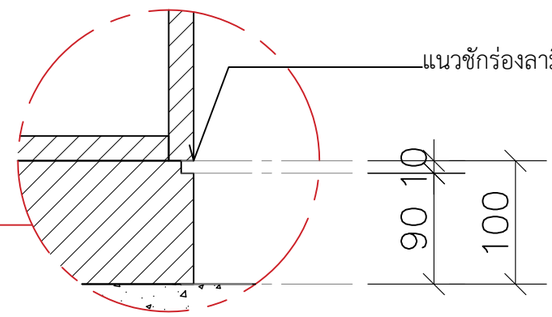

DETAIL 3

scale 1:5

SPACEMAN

PROJECT: SONIA HOUSE

LOCATION: REIGNWOOD PARK
LAMLUKKA, PATHUM THANI

ARCHITECT:

INTERIOR DESIGNER: ปรัตถกร ประมุขกุล ภ–สน 1438

STRUCTURAL ENGINEER:

TITLE: 1st FLOOR (ส่วนต่อเติมข้างบ้าน)
แบบขยาย ตู้เก็บของ
SECTION ,DETAIL

2026–06–25
ID3–07
1:20 @ A3

Note: SPACEMAN takes no responsibility for dimensions obtained by scaling from this drawing. If no dimension is shown the recipient must ascertain the dimension specifically from the architect or by site measurement and may not rely on the drawing. Supply of the drawing in digital form is solely for convenience and no reliance may be placed on any data in digital form. All data must be checked against hard copy. This drawing is issued for design intent only and should not be used for construction unless stated. This drawing is the property of SPACEMAN

D1–01 / แบบขยายส่วนต่อเติมข้างบ้าน

*ผู้รับเหมาตรวจสอบคู่มือของอุปกรณ์ก่อนดำเนินการ

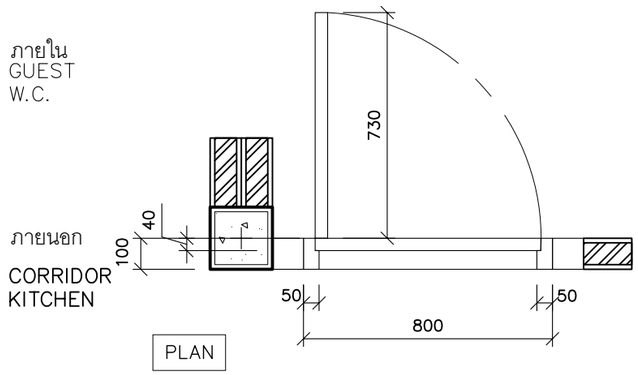

PLAN

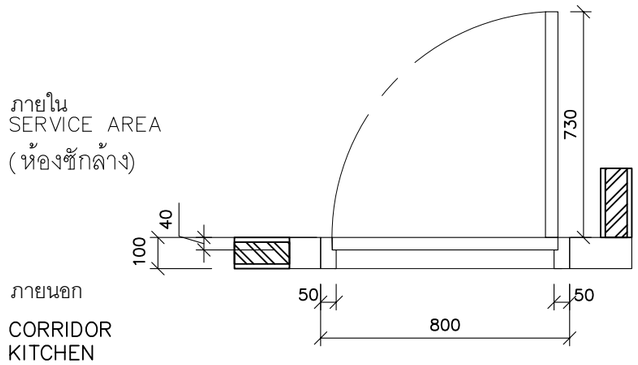

PLAN

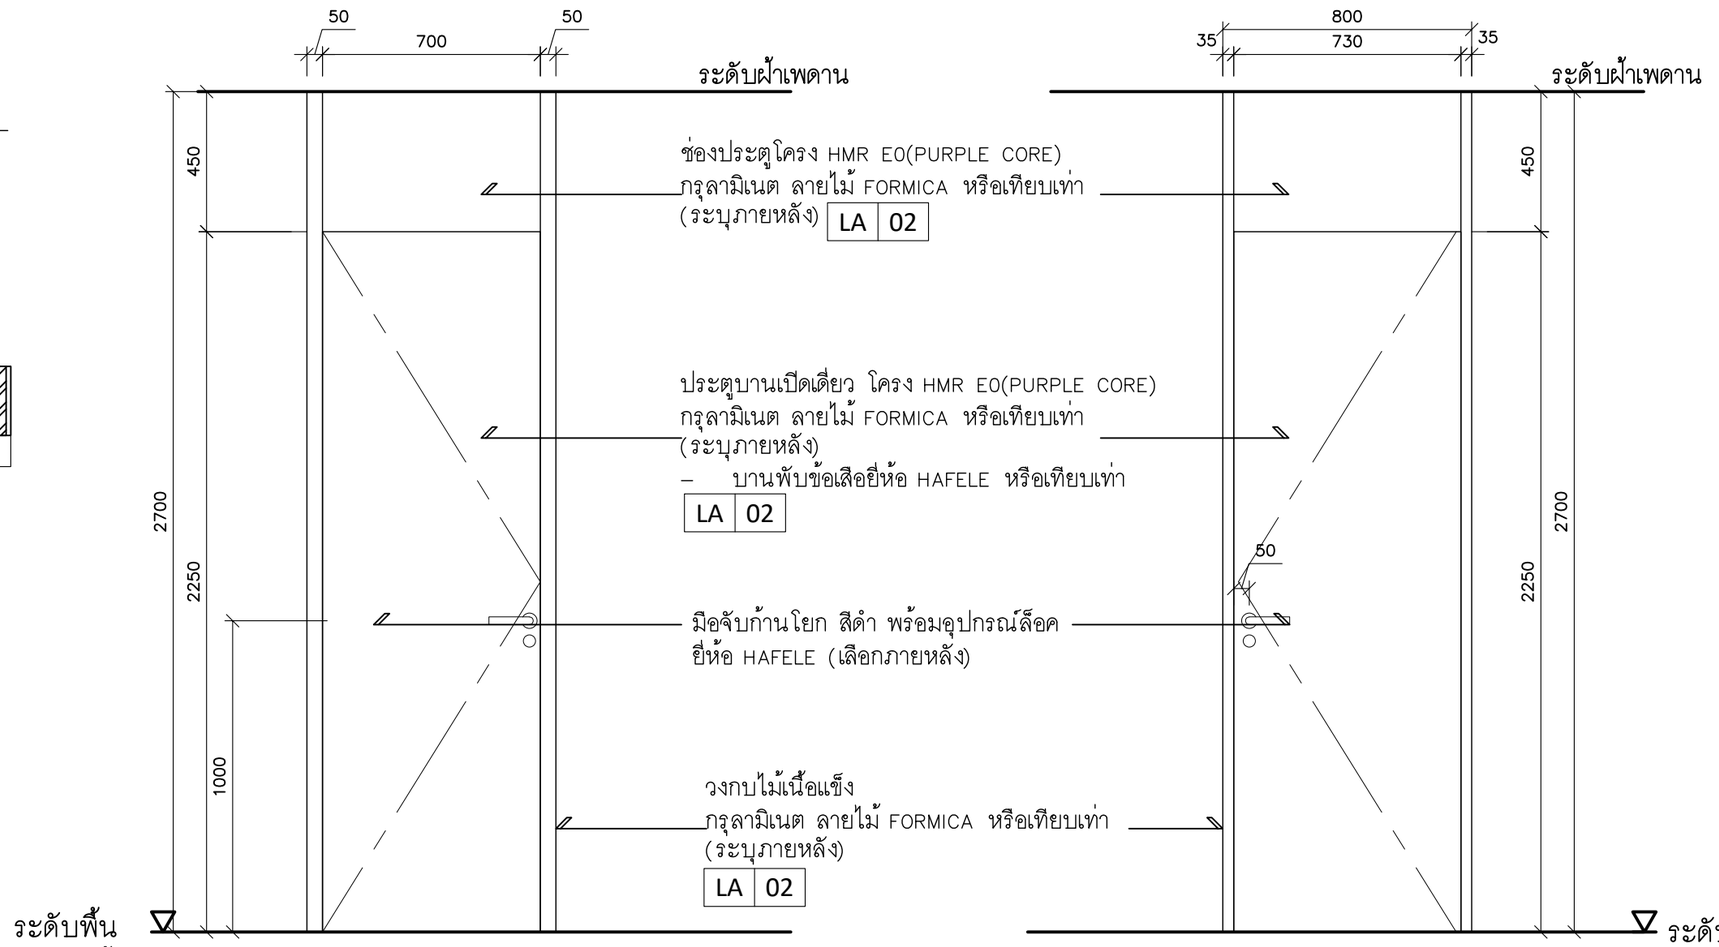

ภายนอก

ภายใน

SPACEMAN	PROJECT: SONIA HOUSE	LOCATION:	ARCHITECT:	INTERIOR DESIGNER: ปรัตถกร ประมุขกุล ภ–สน 1438	STRUCTURAL ENGINEER:	TITLE: D1–01 แบบขยายส่วนต่อเติมข้างบ้าน DOOR PLAN AND ELEVATION	2026–04–28 ID6–01 1:20 @ A3

Note: SPACEMAN takes no responsibility for dimensions obtained by scaling from this drawing. If no dimension is shown the recipient must ascertain the dimension specifically from the architect or by site measurement and may not rely on the drawing. Supply of the drawing in digital form is solely for convenience and no reliance may be placed on any data in digital form. All data must be checked against hard copy. This drawing is issued for design intent only and should not be used for construction unless stated. This drawing is the property of SPACEMAN

SONIA HOUSE

REIGNWOOD PARK

LAMLUKKA, PATHUM THANI

แบบขยายห้องนอนใหญ่

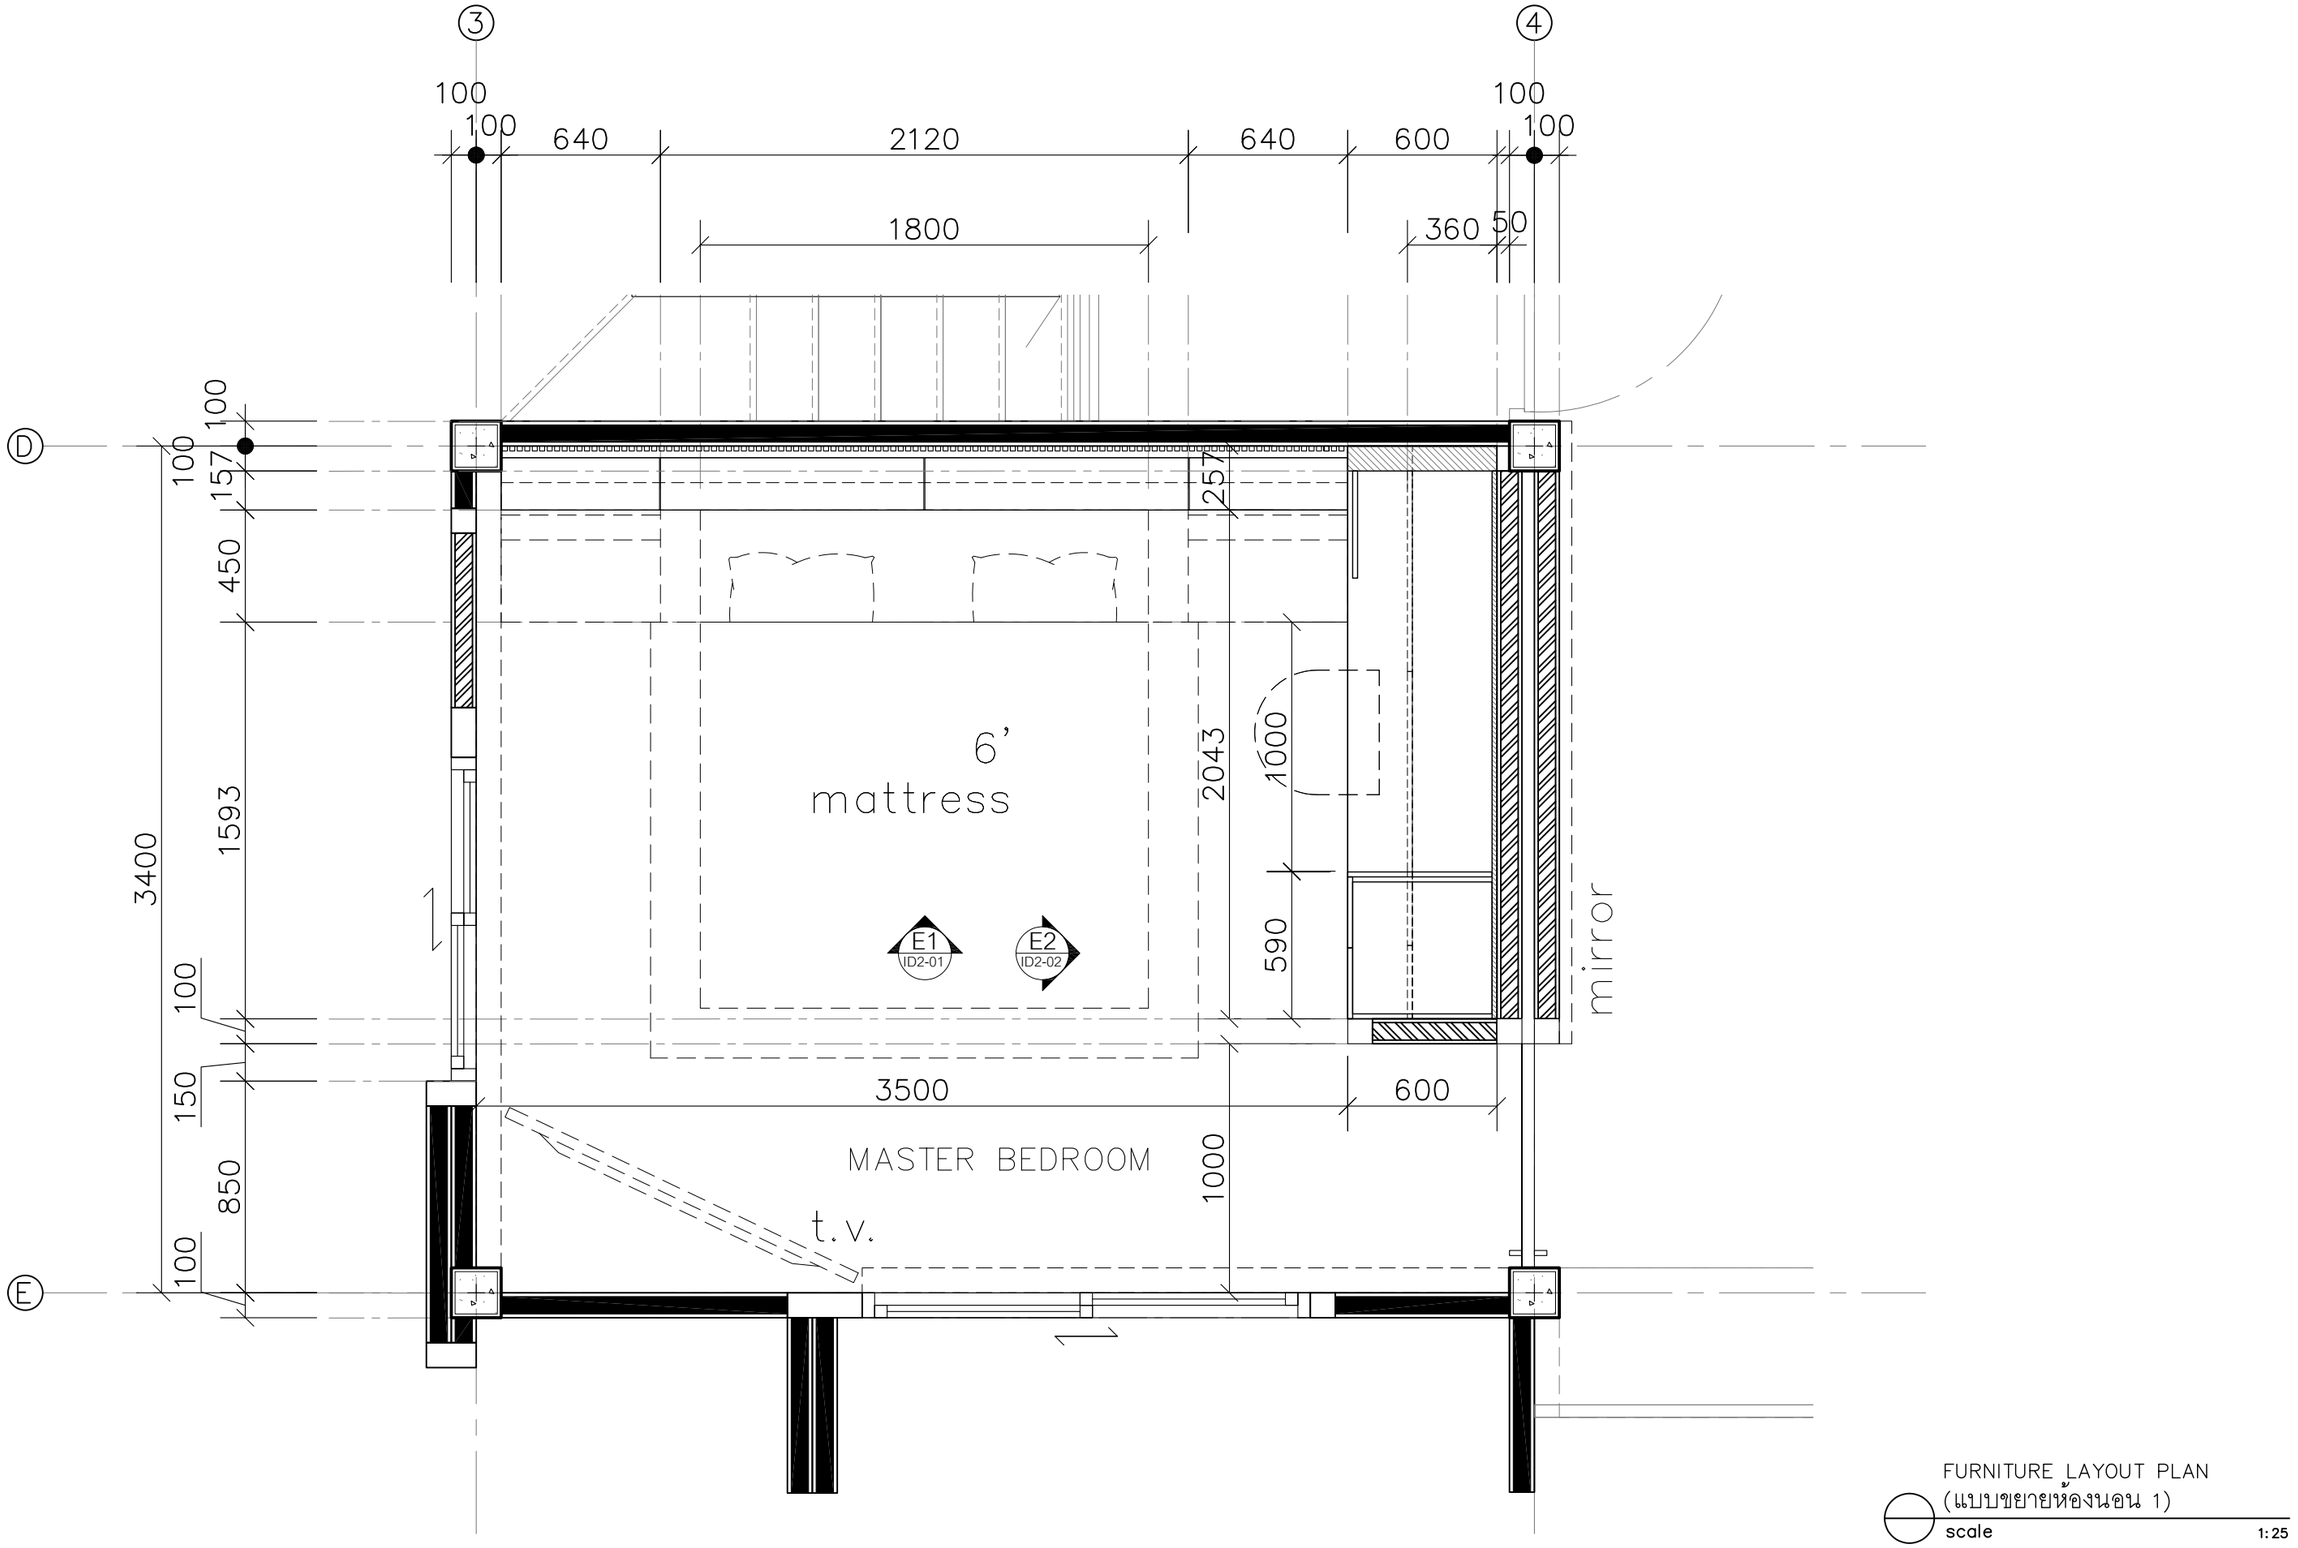

FURNITURE LAYOUT PLAN
(แบบขยายห้องนอน 1)
scale 1:25

SPACEMAN	PROJECT: SONIA HOUSE	LOCATION: REIGNWOOD PARK LAMLUKKA, PATHUM THANI	ARCHITECT	INTERIOR DESIGNER: ปรัตถกร ประมุขกุล ภ-สน 1438	STRUCTURAL ENGINEER	TITLE: 2nd FLOOR FURNITURE LAYOUT PLAN (แบบขยายห้องนอน 1)	2026-06-18 ID1-01 1:25 @ A3

Note: SPACEMAN takes no responsibility for dimensions obtained by scaling from this drawing. If no dimension is shown the recipient must ascertain the dimension specifically from the architect or by site measurement and may not rely on the drawing. Supply of the drawing in digital form is solely for convenience and no reliance may be placed on any data in digital form. All data must be checked against hard copy. This drawing is issued for design intent only and should not be used for construction unless stated. This drawing is the property of SPACEMAN

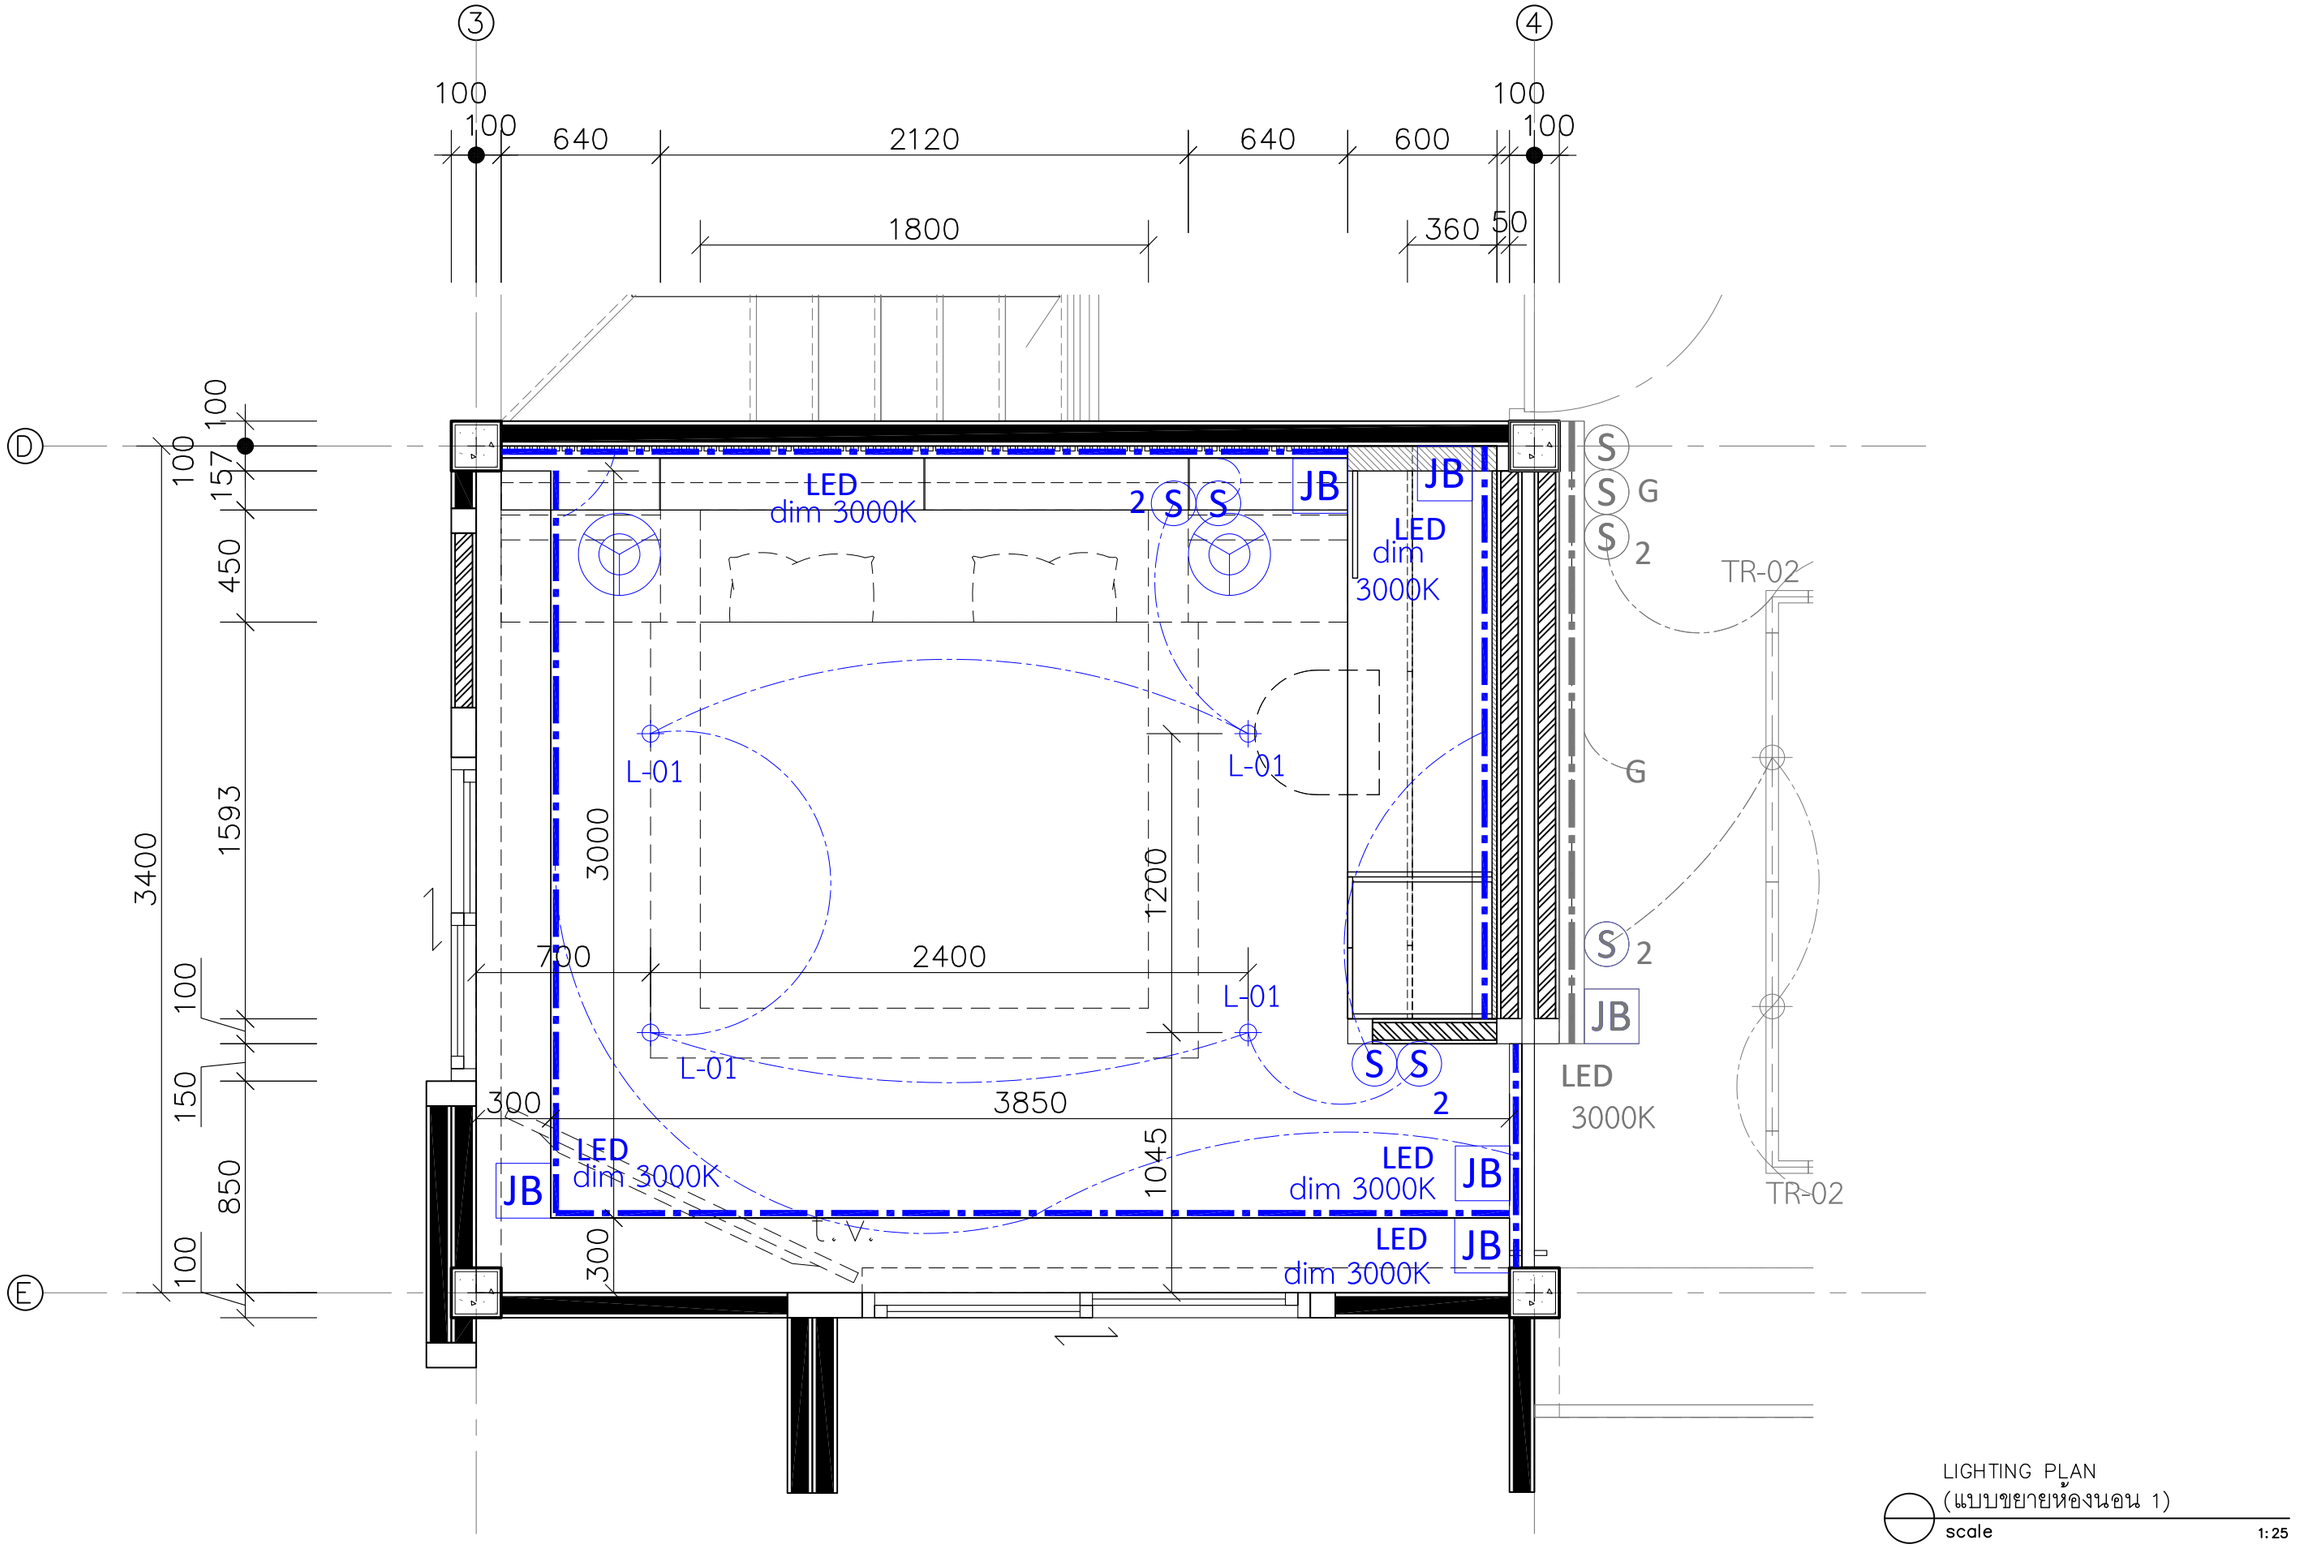

LIGHTING PLAN
(แบบขยายห้องนอน 1)
scale 1:25

SPACEMAN	PROJECT: SONIA HOUSE	LOCATION: REIGNWOOD PARK LAMLUKKA, PATHUM THANI	ARCHITECT	INTERIOR DESIGNER: ปรัตถกร ประมุขกุล ภ-สน 1438	STRUCTURAL ENGINEER	TITLE: 2nd FLOOR LIGHTING PLAN (แบบขยายห้องนอน 1)	2026-06-18 ID1-02

Note: SPACEMAN takes no responsibility for dimensions obtained by scaling from this drawing. If no dimension is shown the recipient must ascertain the dimension specifically from the architect or by site measurement and may not rely on the drawing. Supply of the drawing in digital form is solely for convenience and no reliance may be placed on any data in digital form. All data must be checked against hard copy. This drawing is issued for design intent only and should not be used for construction unless stated. This drawing is the property of SPACEMAN

1:25 @ A3

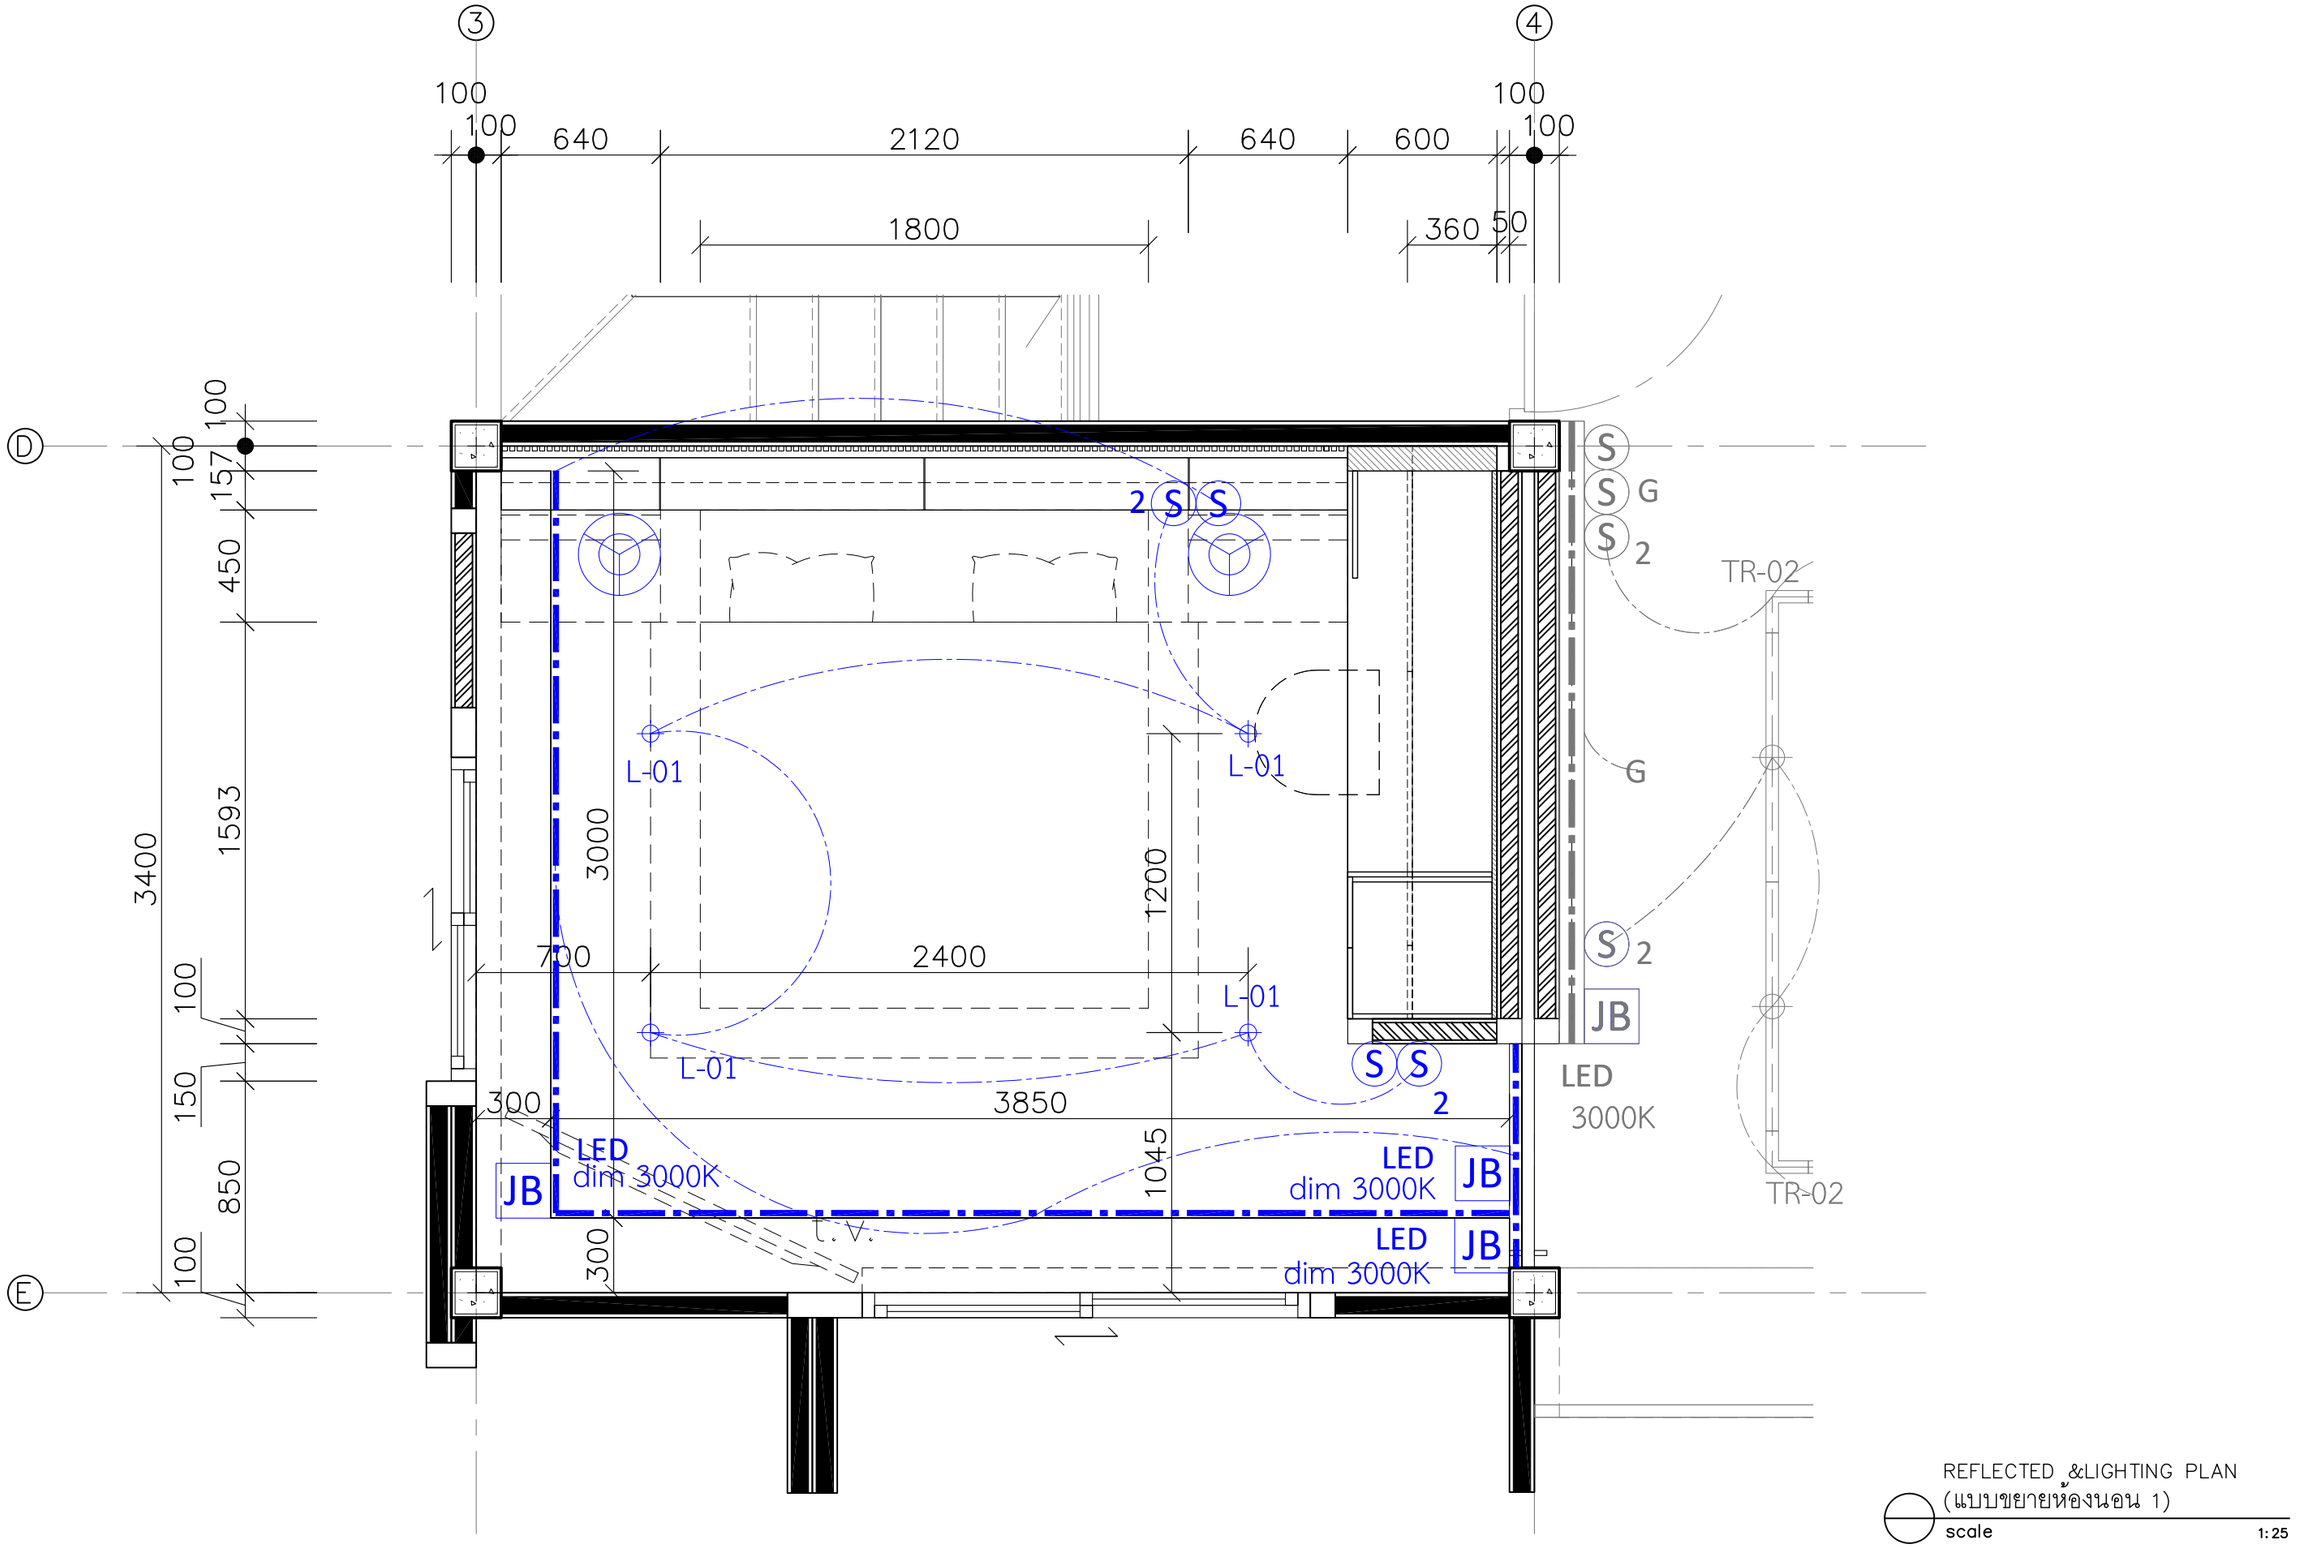

REFLECTED &LIGHTING PLAN
(แบบขยายห้องนอน 1)
scale 1:25

SPACEMAN

PROJECT: SONIA HOUSE

LOCATION: REIGNWOOD PARK
LAMLUKKA, PATHUM THANI

ARCHITECT:

INTERIOR DESIGNER: ปรัตถกร ประมุขกุล ภ-ส น 1438

STRUCTURAL ENGINEER:

TITLE: 2nd FLOOR
LIGHTING PLAN
(แบบขยายห้องนอน 1)

2026-06-18
ID1-02
1:25 @ A3

Note: SPACEMAN takes no responsibility for dimensions obtained by scaling from this drawing. If no dimension is shown the recipient must ascertain the dimension specifically from the architect or by site measurement and may not rely on the drawing. Supply of the drawing in digital form is solely for convenience and no reliance may be placed on any data in digital form. All data must be checked against hard copy. This drawing is issued for design intent only and should not be used for construction unless stated. This drawing is the property of SPACEMAN

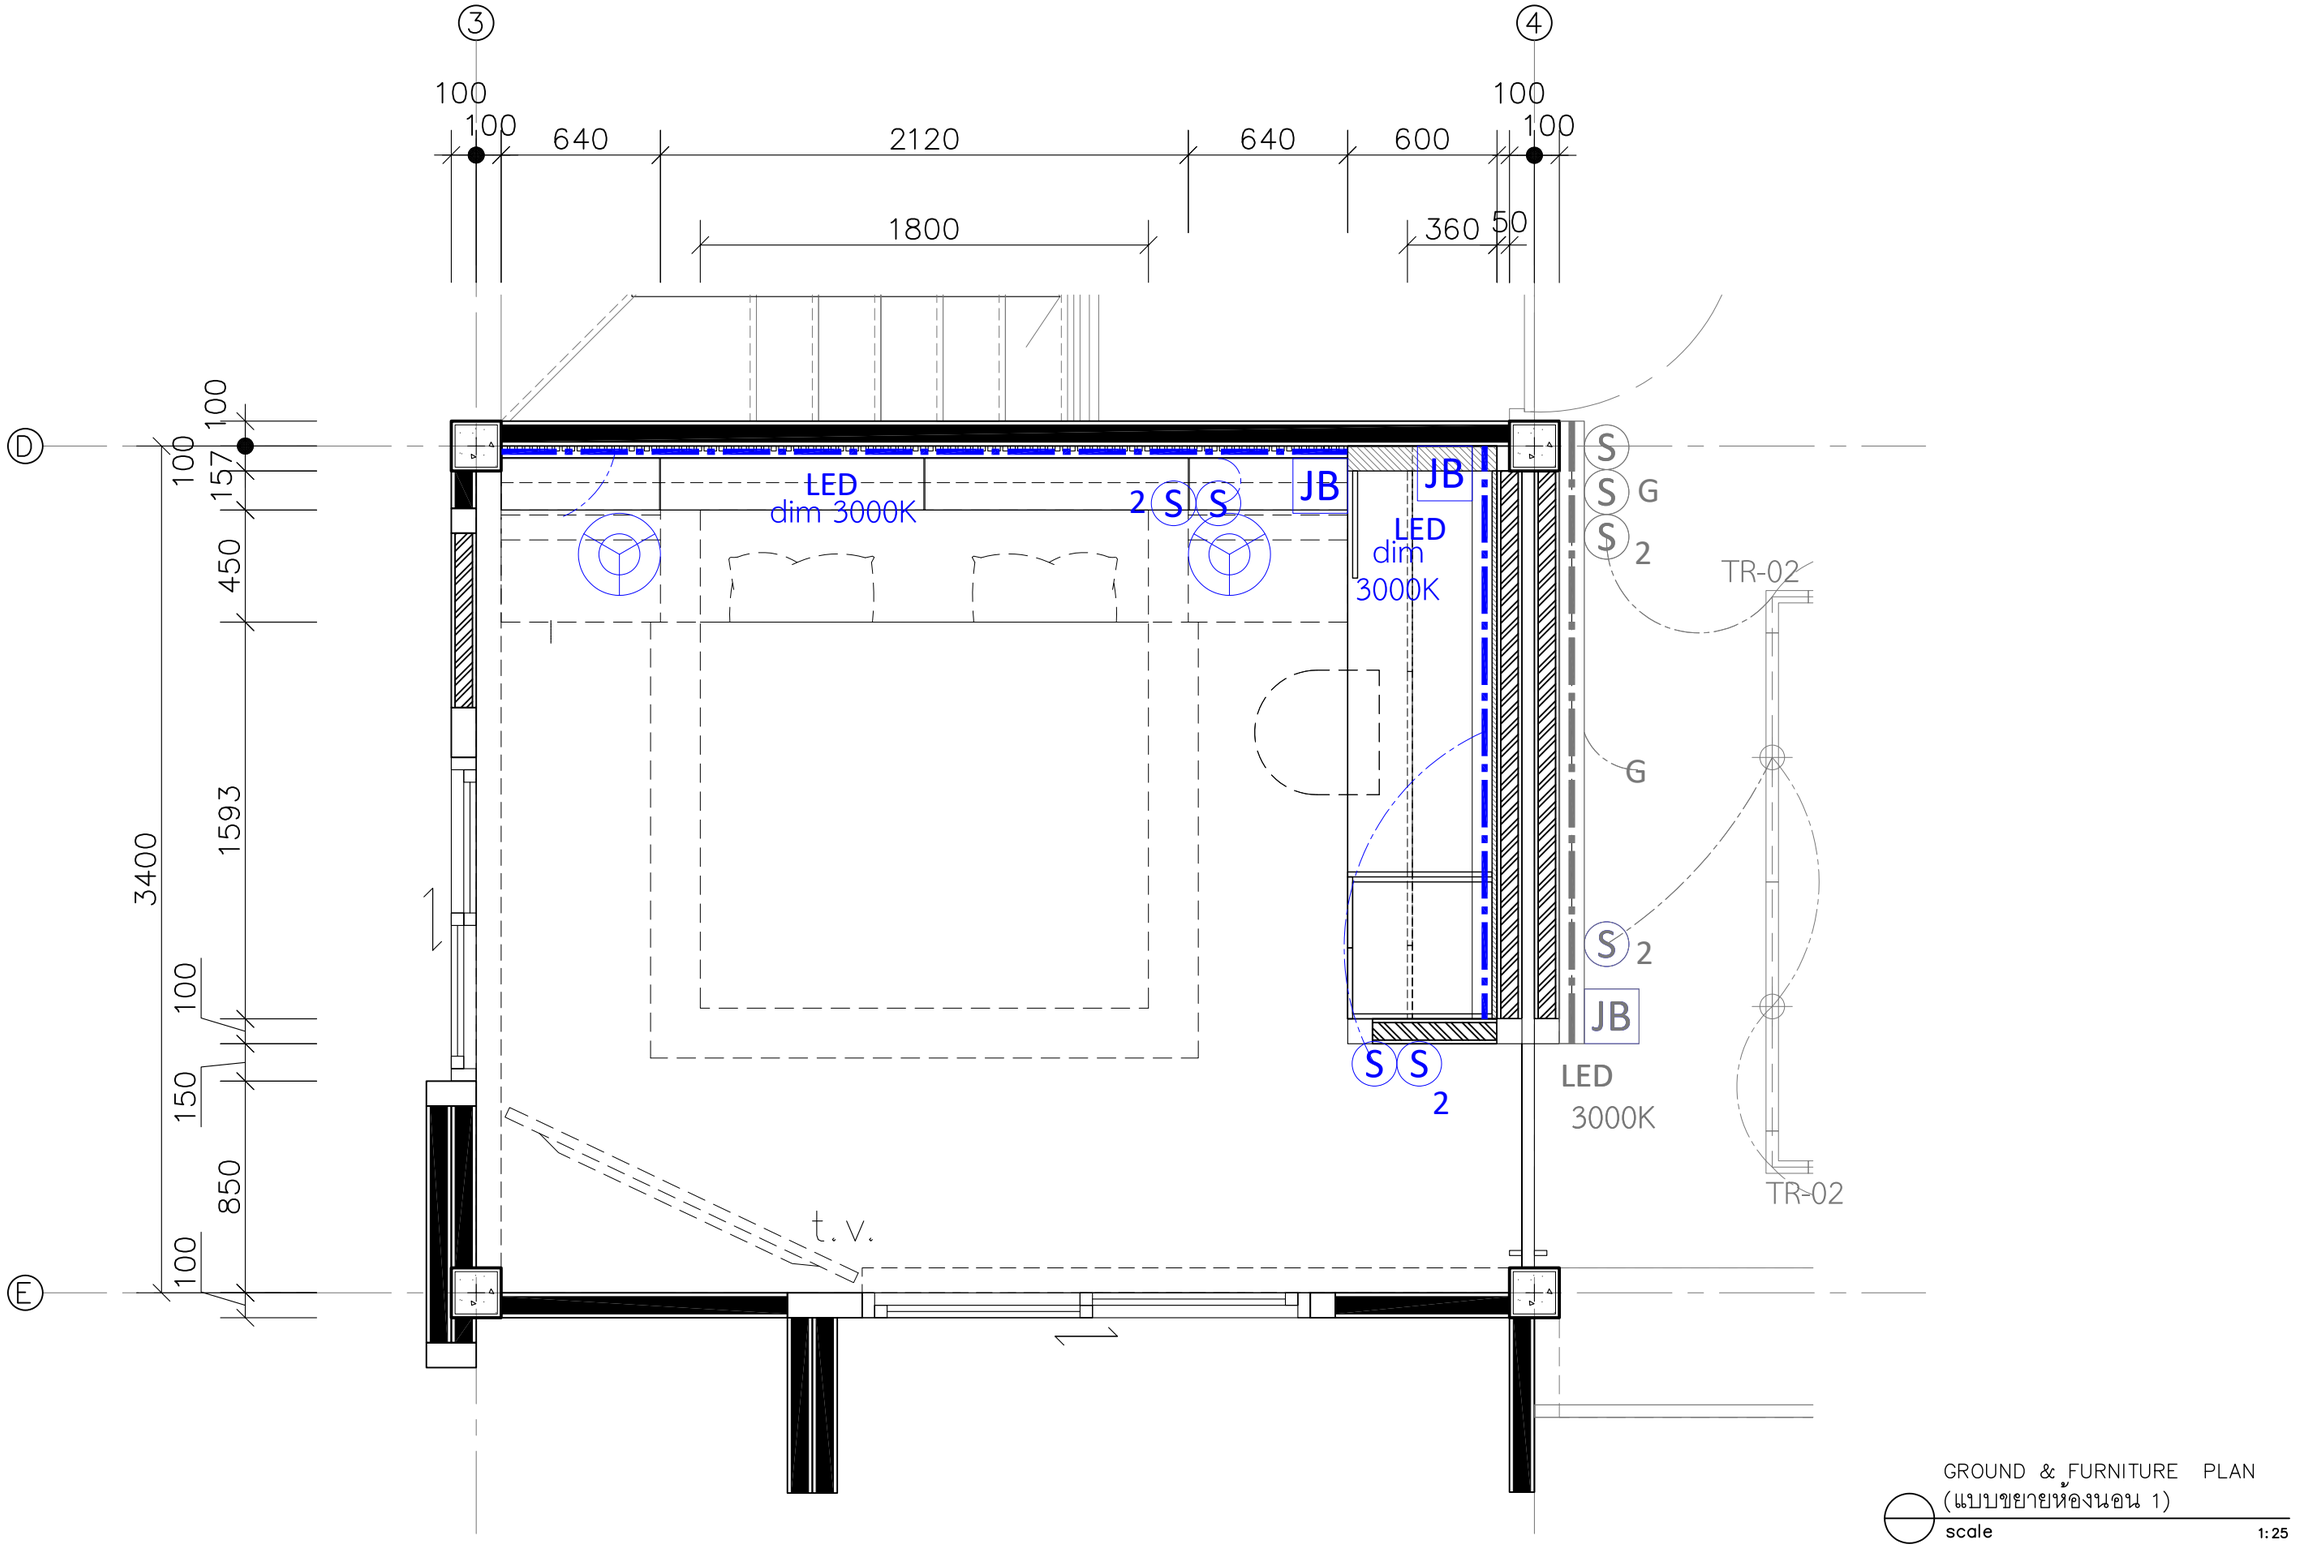

GROUND & FURNITURE PLAN
(แบบขยายห้องนอน 1)
scale 1:25

SPACEMAN	PROJECT: SONIA HOUSE	LOCATION: REIGNWOOD PARK LAMLUKKA, PATHUM THANI	ARCHITECT	INTERIOR DESIGNER: ปรัตถกร ประมุขกุล ภ-สน 1438	STRUCTURAL ENGINEER	TITLE: 2nd FLOOR LIGHTING PLAN (แบบขยายห้องนอน 1)	2026-06-18 ID1-02

Note: SPACEMAN takes no responsibility for dimensions obtained by scaling from this drawing. If no dimension is shown the recipient must ascertain the dimension specifically from the architect or by site measurement and may not rely on the drawing. Supply of the drawing in digital form is solely for convenience and no reliance may be placed on any data in digital form. All data must be checked against hard copy. This drawing is issued for design intent only and should not be used for construction unless stated. This drawing is the property of SPACEMAN

1:25 @ A3

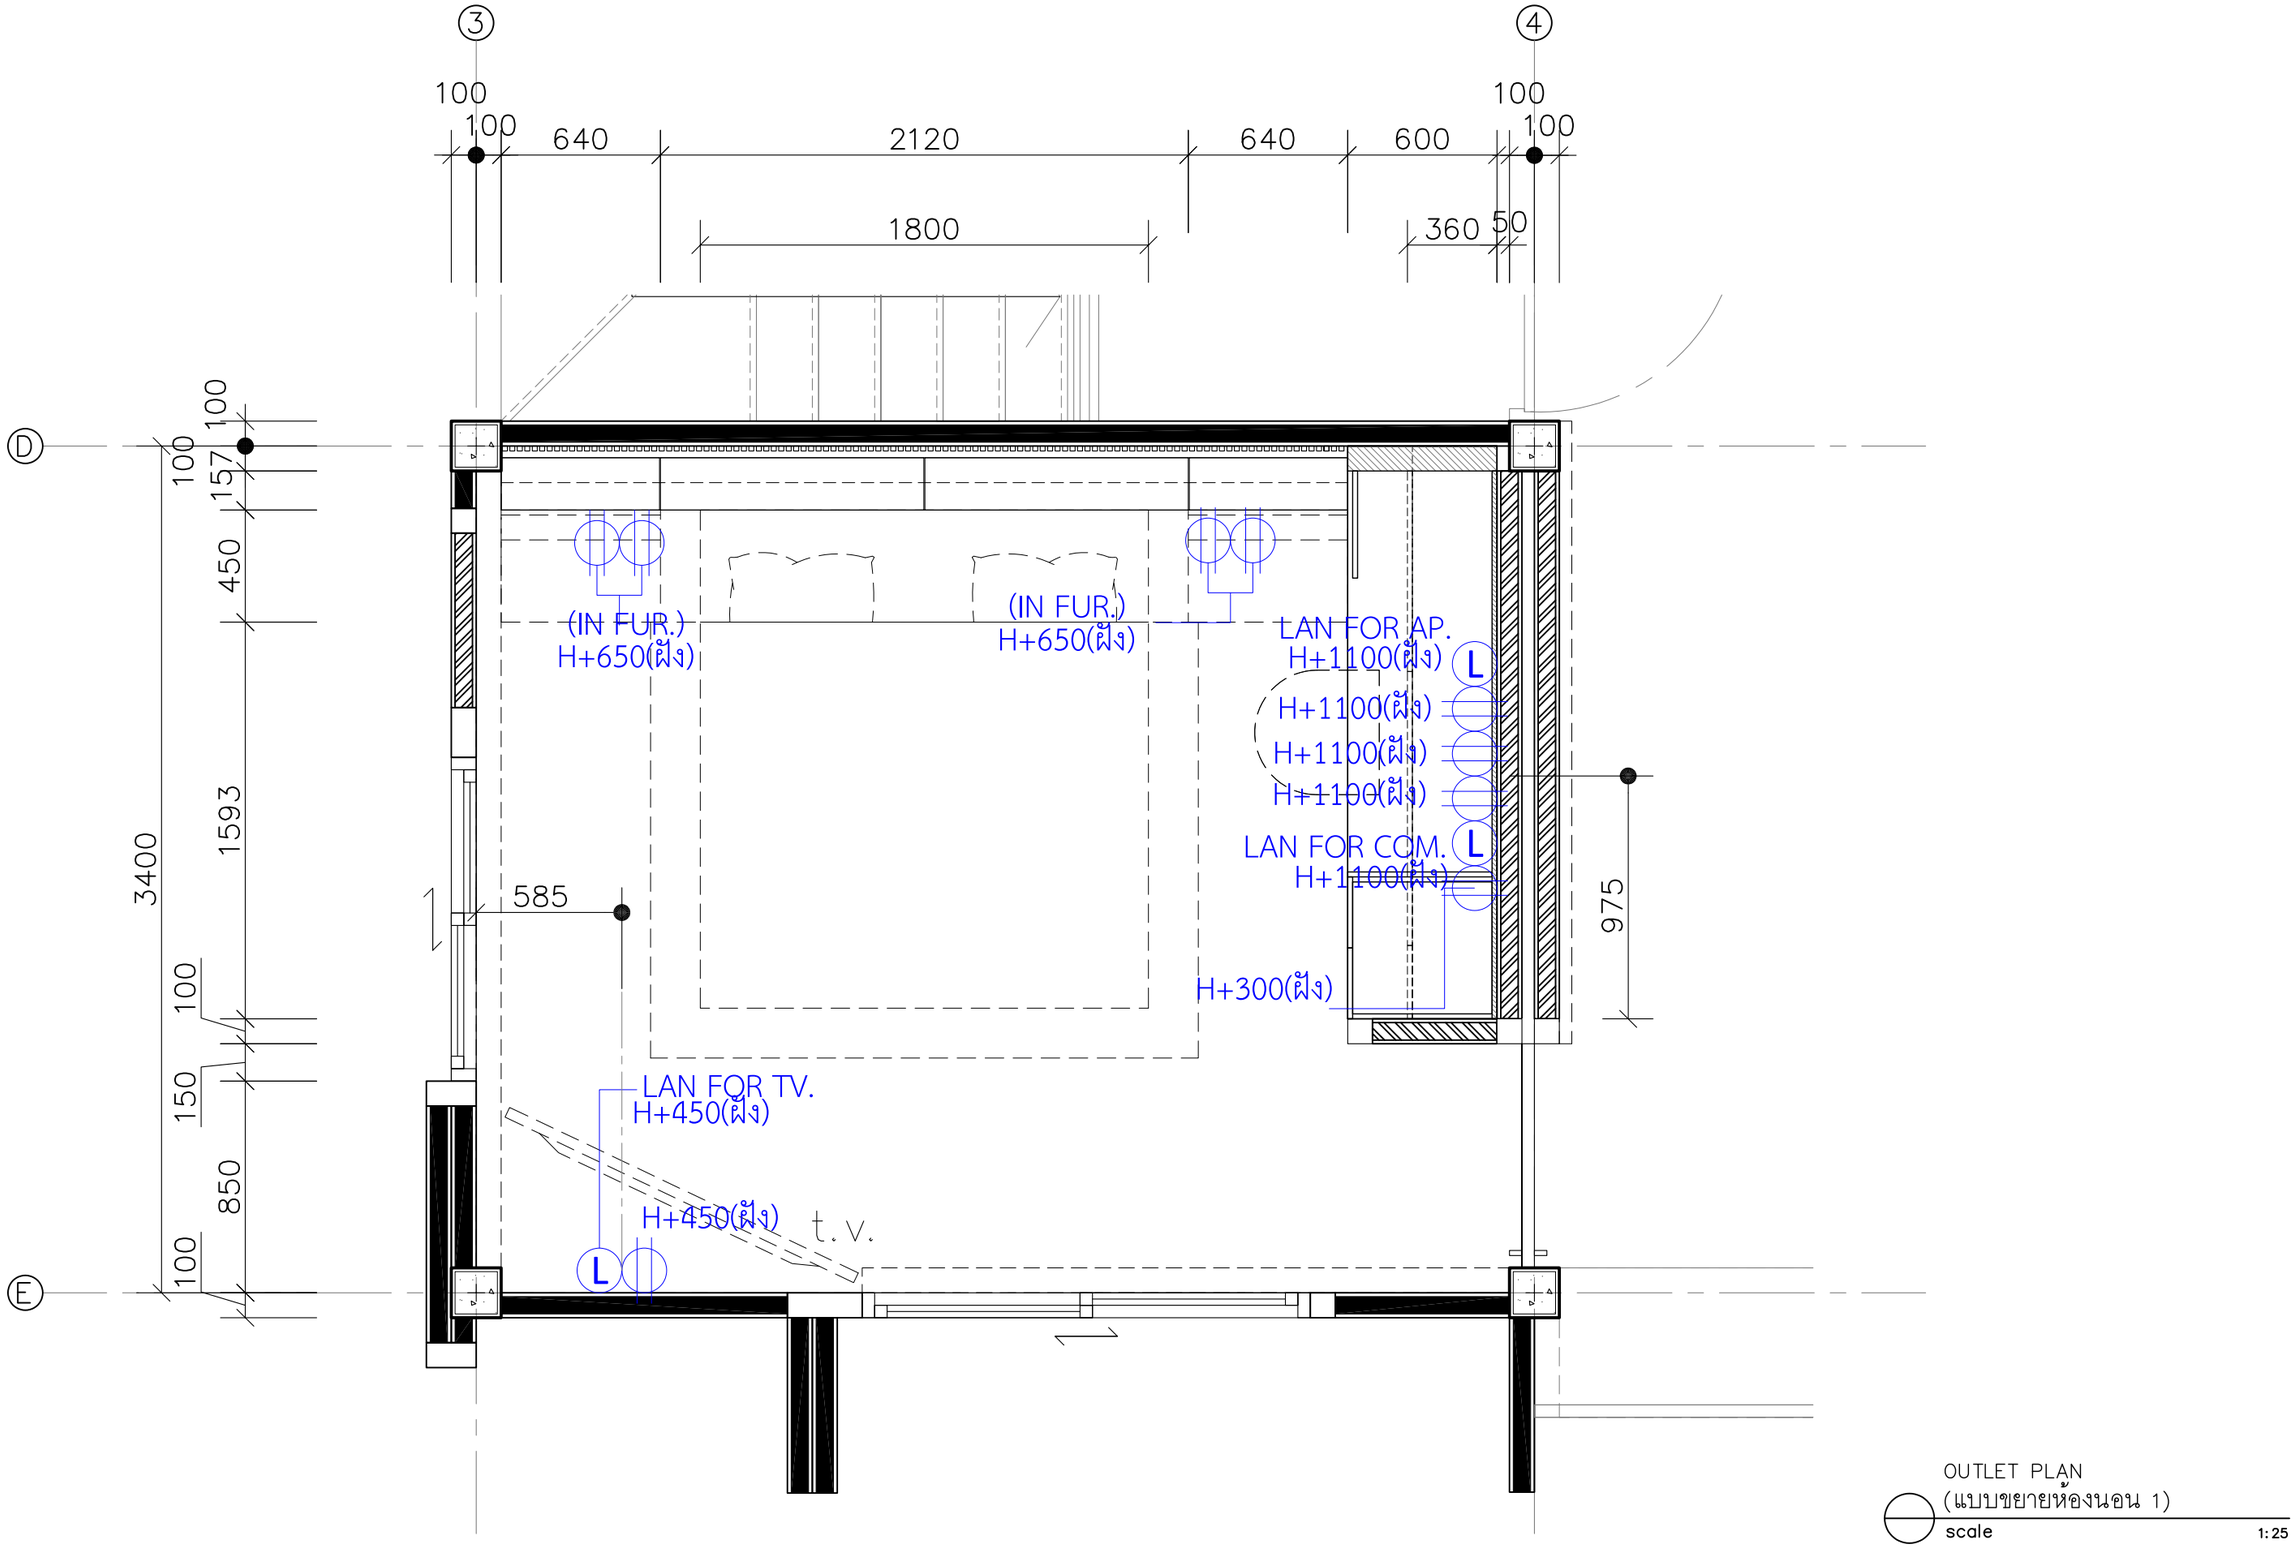

OUTLET PLAN
(แบบขยายห้องนอน 1)
scale 1:25

SPACEMAN

PROJECT: SONIA HOUSE

LOCATION: REIGNWOOD PARK
LAMLUKKA, PATHUM THANI

ARCHITECT:

INTERIOR DESIGNER: ปรัตถกร ประมุขกุล ภ-สน 1438

STRUCTURAL ENGINEER:

TITLE: 2nd FLOOR
OUTLET PLAN
(แบบขยายห้องนอน 1)

2026-06-18
ID1-03

1:25 @ A3

Note: SPACEMAN takes no responsibility for dimensions obtained by scaling from this drawing. If no dimension is shown the recipient must ascertain the dimension specifically from the architect or by site measurement and may not rely on the drawing. Supply of the drawing in digital form is solely for convenience and no reliance may be placed on any data in digital form. All data must be checked against hard copy. This drawing is issued for design intent only and should not be used for construction unless stated. This drawing is the property of SPACEMAN

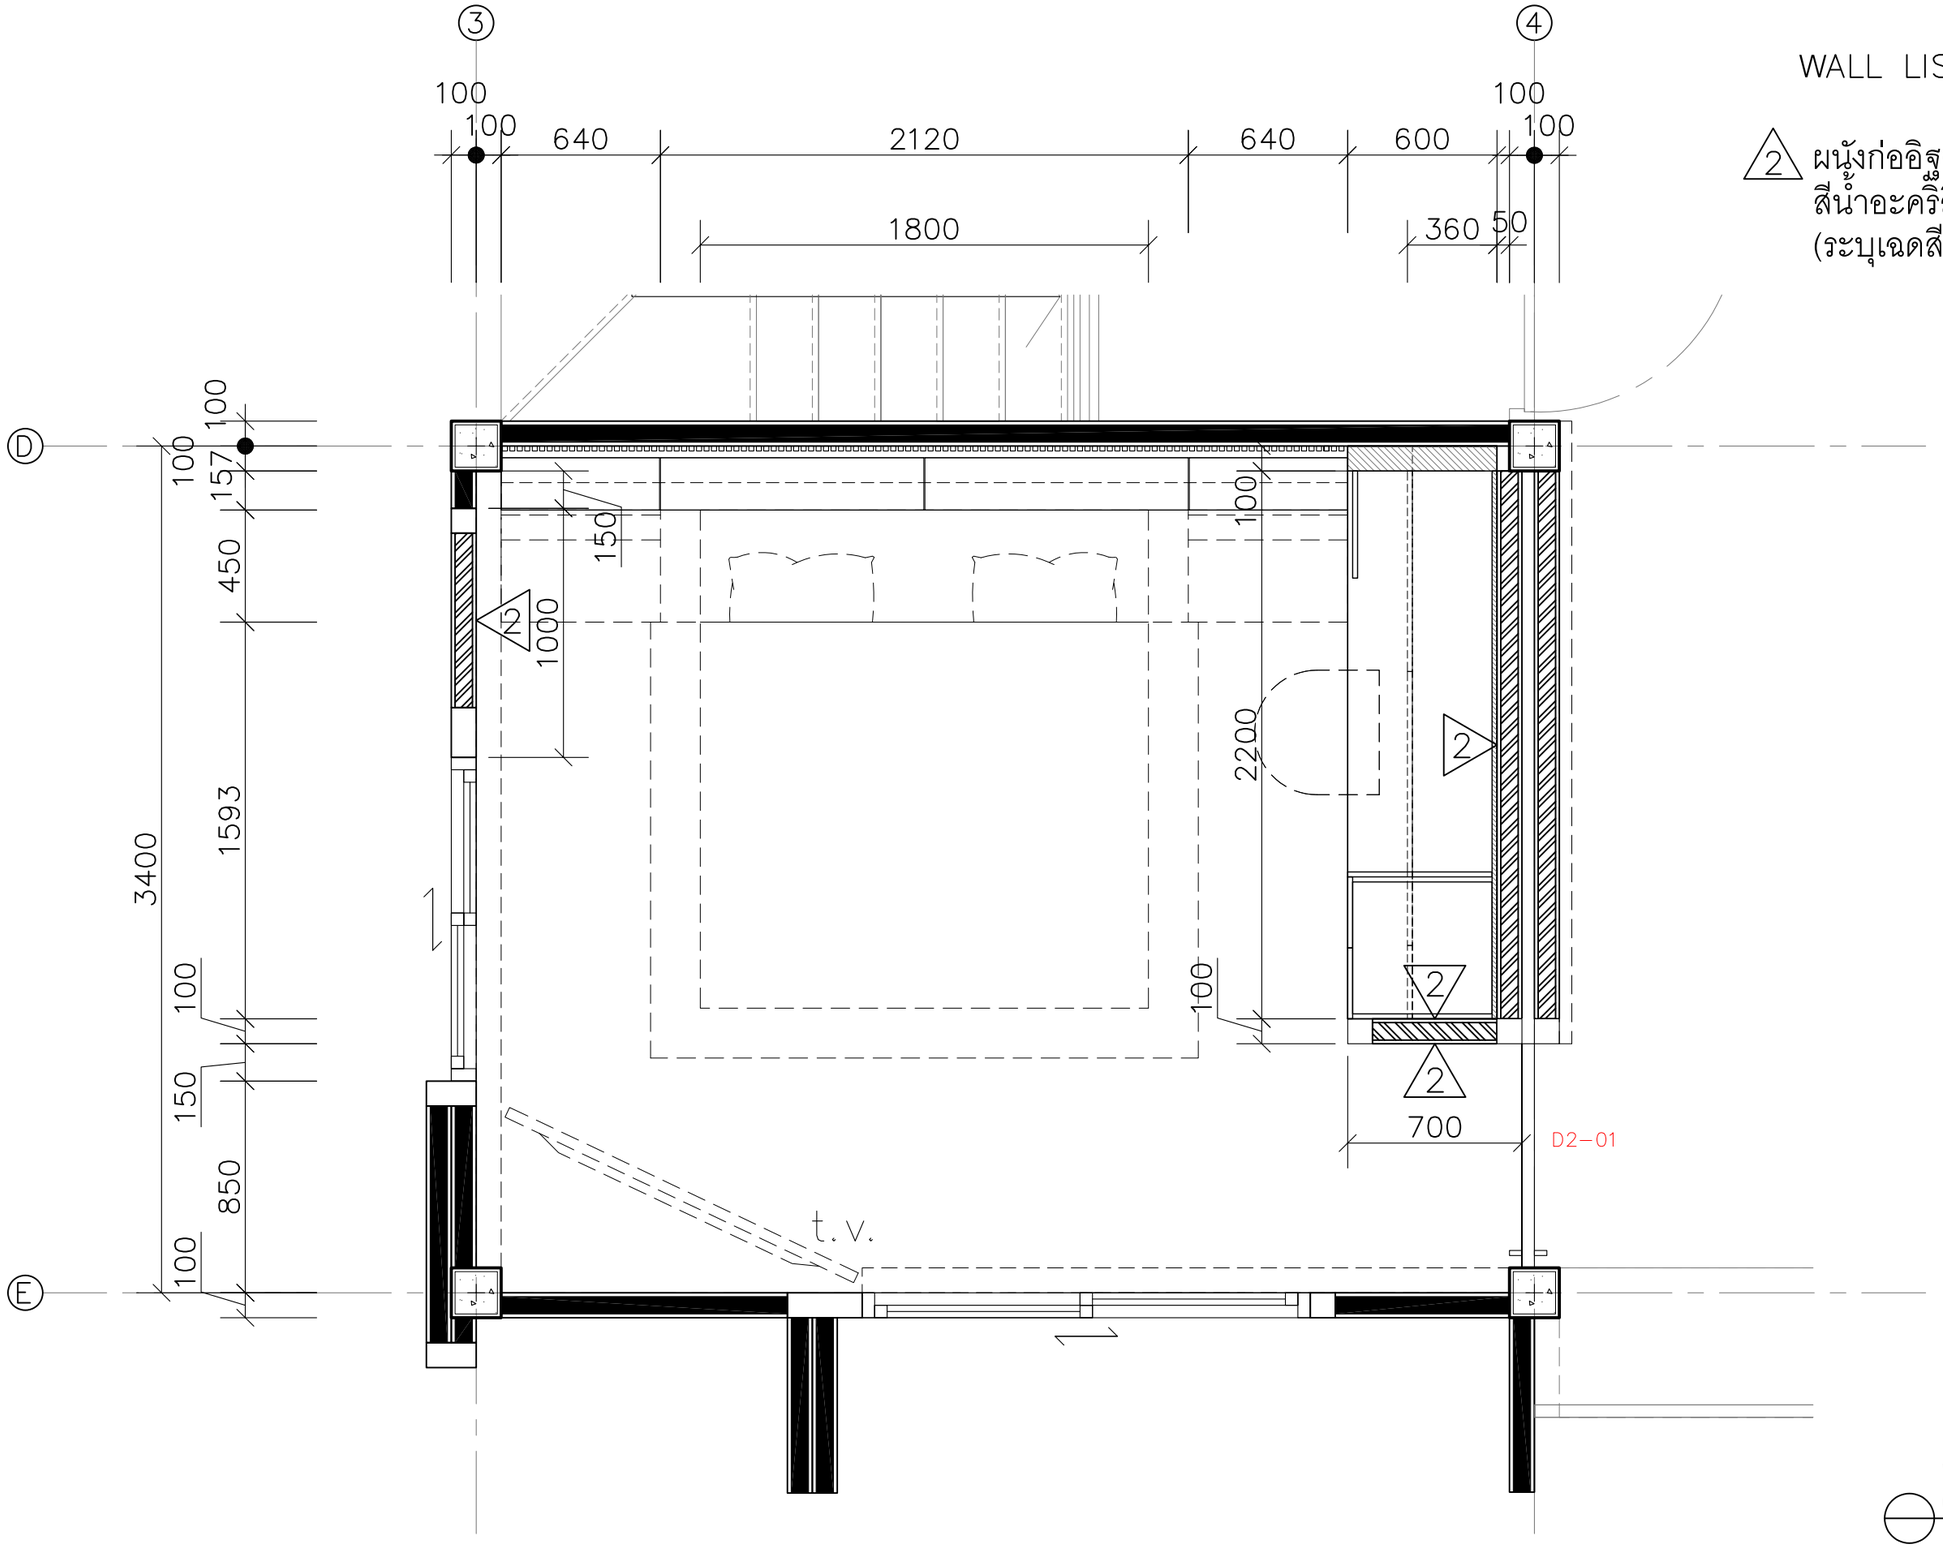

WALL LIST

2 ผนังก่ออิฐฉาบปูน ทาสีซุปเปอร์ชิลด์ สีน้ำอะคริลิก ชนิดกึ่งเงา สีขาว (ระบุเฉดสีภายหลัง)

WALL PLAN (แบบขยายห้องนอน 1)

scale 1:25

SPACEMAN

PROJECT: SONIA HOUSE

LOCATION: REIGNWOOD PARK LAMLUKKA, PATHUM THANI

ARCHITECT:

INTERIOR DESIGNER: ปรัตถกร ประมุขกุล ภ-สน 1438

STRUCTURAL ENGINEER:

TITLE: 2nd FLOOR WALL PLAN (แบบขยายห้องนอน 1)

2026-06-18
ID1-04
1:25 @ A3

Note: SPACEMAN takes no responsibility for dimensions obtained by scaling from this drawing. If no dimension is shown the recipient must ascertain the dimension specifically from the architect or by site measurement and may not rely on the drawing. Supply of the drawing in digital form is solely for convenience and no reliance may be placed on any data in digital form. All data must be checked against hard copy. This drawing is issued for design intent only and should not be used for construction unless stated. This drawing is the property of SPACEMAN

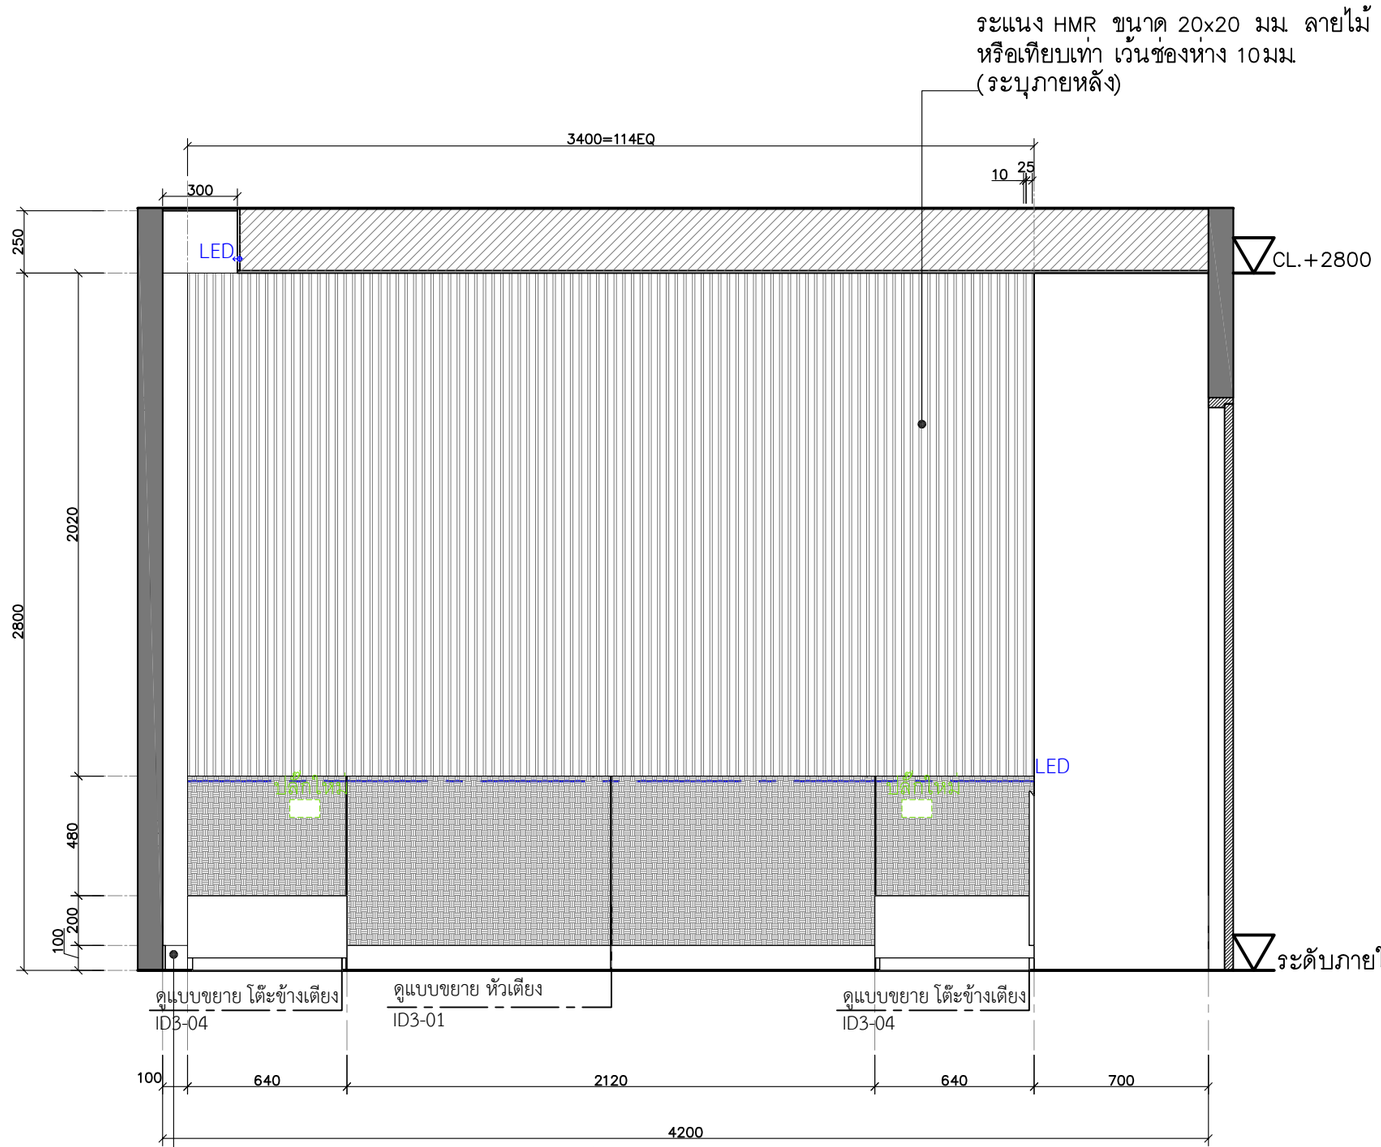

บริเวณ ห้องนอนใหญ่
ELEVATION 1

scale 1:25

SPACEMAN

PROJECT: SONIA HOUSE

LOCATION: REIGNWOOD PARK
LAMLUKKA, PATHUM THANI

ARCHITECT:

INTERIOR DESIGNER: ปรัตถกร ประมุขกุล ภ-สน 1438

STRUCTURAL ENGINEER:

TITLE: 2nd FLOOR
ELEVATION
(แบบขยายบริเวณห้องนอนใหญ่)

2026-06-18
ID2-01

1:25 @ A3

Note: SPACEMAN takes no responsibility for dimensions obtained by scaling from this drawing. If no dimension is shown the recipient must ascertain the dimension specifically from the architect or by site measurement and may not rely on the drawing. Supply of the drawing in digital form is solely for convenience and no reliance may be placed on any data in digital form. All data must be checked against hard copy. This drawing is issued for design intent only and should not be used for construction unless stated. This drawing is the property of SPACEMAN

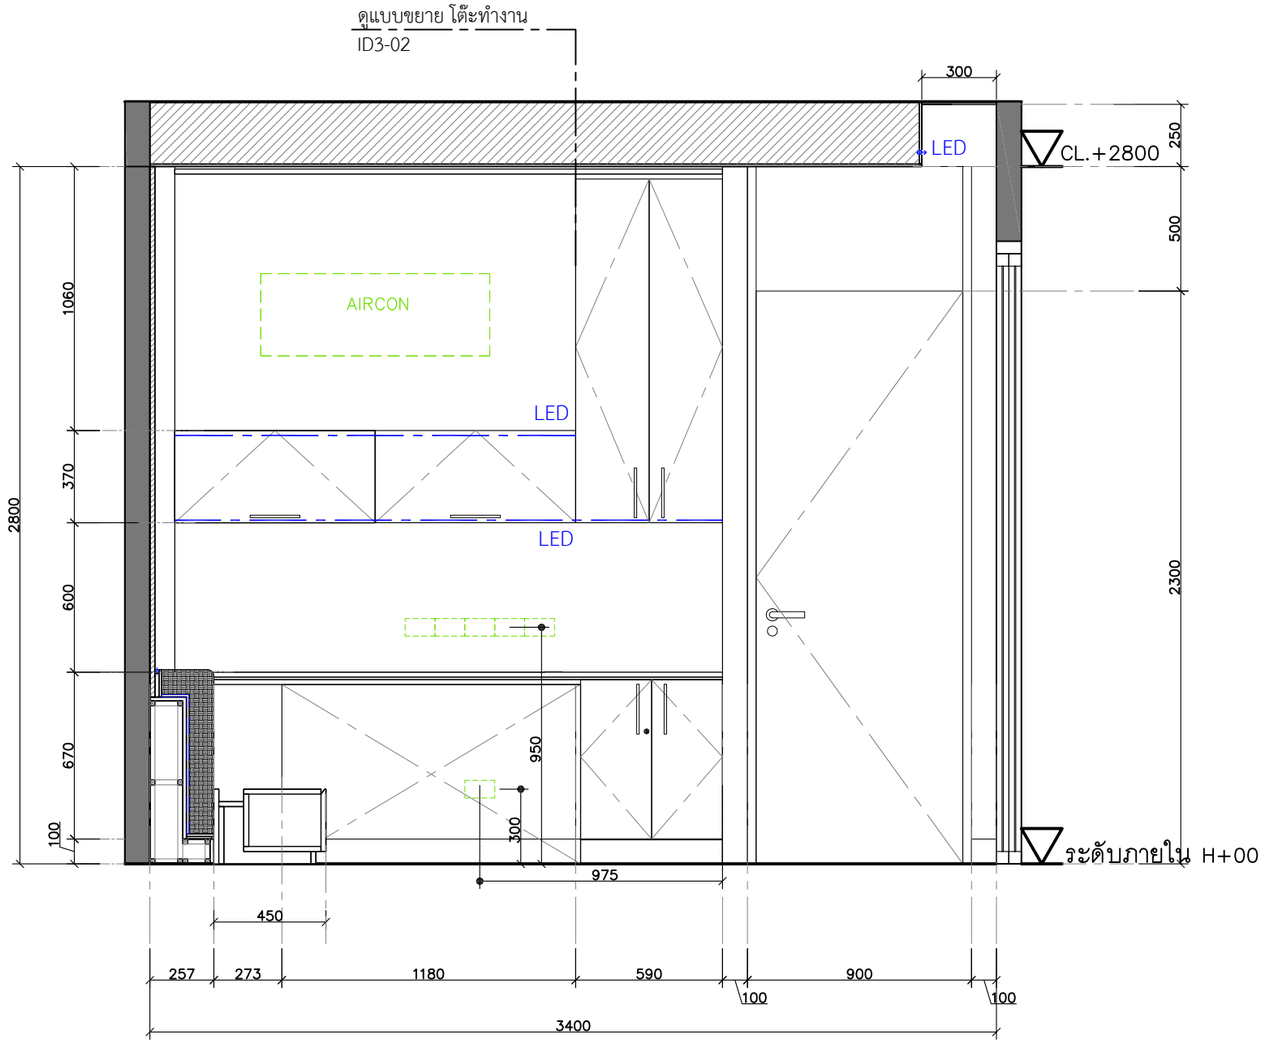

บริเวณ ห้องนอนใหญ่
ELEVATION 1
scale 1:25

SPACEMAN

PROJECT | SONIA HOUSE
LOCATION | REIGNWOOD PARK LAMLUKKA, PATHUM THANI
ARCHITECT |
INTERIOR DESIGNER | ปรัตถกร ประมุขกุล ภ-สน 1438
STRUCTURAL ENGINEER |
TITLE | 2nd FLOOR ELEVATION (แบบขยายบริเวณห้องนอนใหญ่)
2026-06-18
ID2-02
1:25 @ A3

Note: SPACEMAN takes no responsibility for dimensions obtained by scaling from this drawing. If no dimension is shown the recipient must ascertain the dimension specifically from the architect or by site measurement and may not rely on the drawing. Supply of the drawing in digital form is solely for convenience and no reliance may be placed on any data in digital form. All data must be checked against hard copy. This drawing is issued for design intent only and should not be used for construction unless stated. This drawing is the property of SPACEMAN

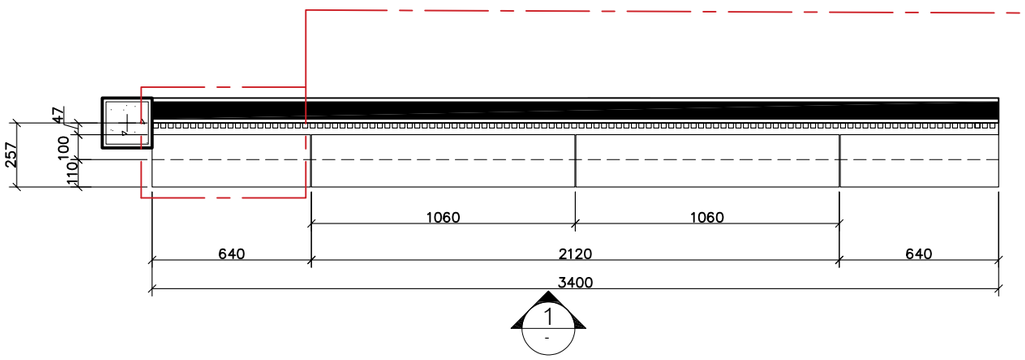

แบบขยาย หัวเตียง
บริเวณห้องนอนใหญ่
PLAN
scale 1:25

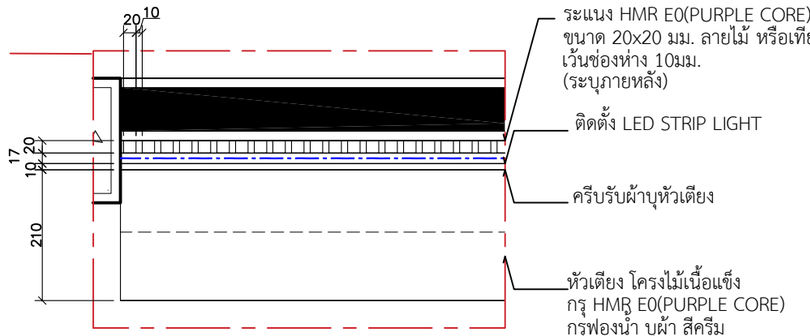

แบบขยาย หัวเตียง
บริเวณห้องนอนใหญ่
PLAN DETAIL
scale 1:10

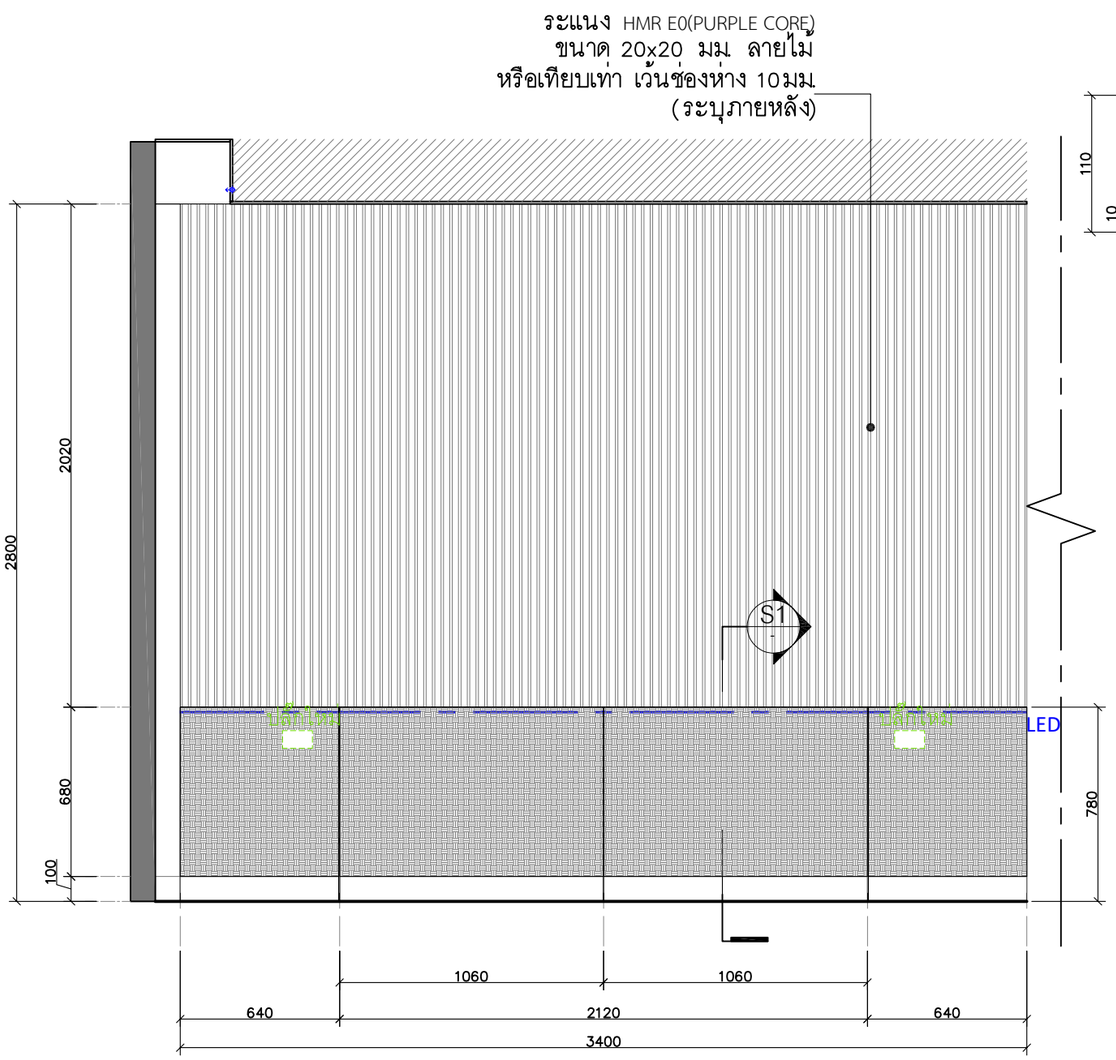

แบบขยาย หัวเตียง
บริเวณห้องนอนใหญ่
ELEVATION 1
scale 1:25

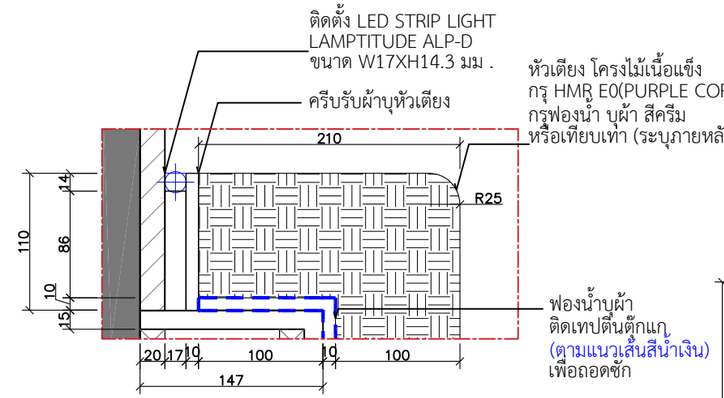

DETAIL 1
scale 1:5

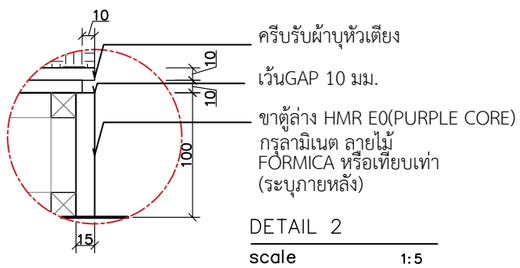

DETAIL 2
scale 1:5

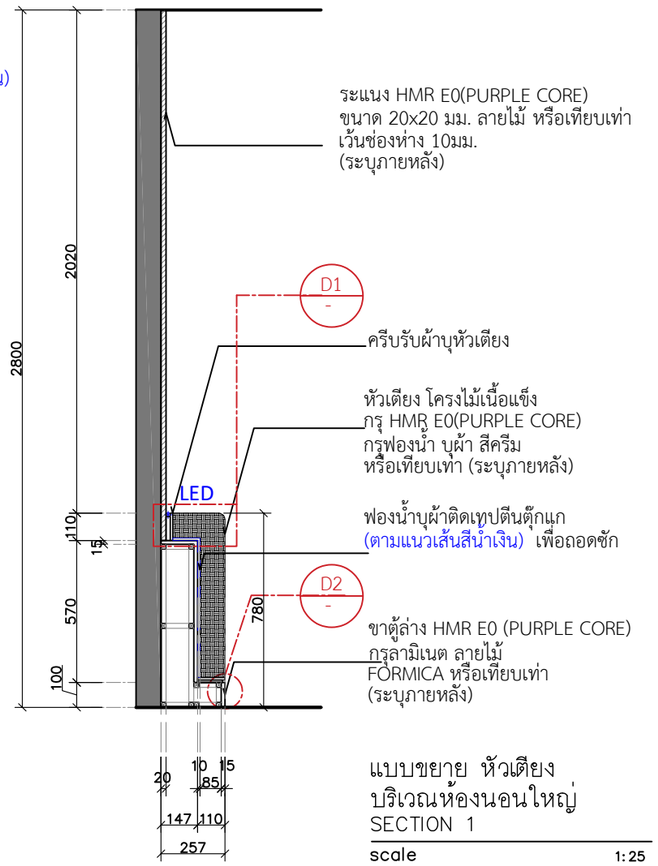

แบบขยาย หัวเตียง
บริเวณห้องนอนใหญ่
SECTION 1
scale 1:25

SPACEMAN

PROJECT: SONIA HOUSE

LOCATION: REIGNWOOD PARK
LAMLUKKA, PATHUM THANI

ARCHITECT:

INTERIOR DESIGNER: ปรัตถกร ประมุขกุล ภ-สน 1438

STRUCTURAL ENGINEER:

TITLE: 2nd FLOOR
แบบขยาย หัวเตียง
PLAN ,ELEVATION ,SECTION

2026-06-18
ID3-01

1:25 @ A3

Note: SPACEMAN takes no responsibility for dimensions obtained by scaling from this drawing. If no dimension is shown the recipient must ascertain the dimension specifically from the architect or by site measurement and may not rely on the drawing. Supply of the drawing in digital form is solely for convenience and no reliance may be placed on any data in digital form. All data must be checked against hard copy. This drawing is issued for design intent only and should not be used for construction unless stated. This drawing is the property of SPACEMAN

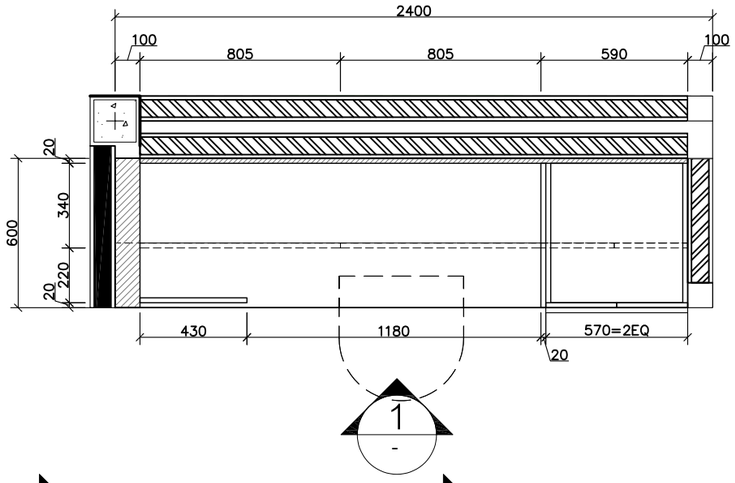

แบบขยาย โต๊ะทำงาน
บริเวณห้องนอนใหญ่
PLAN

scale 1:25

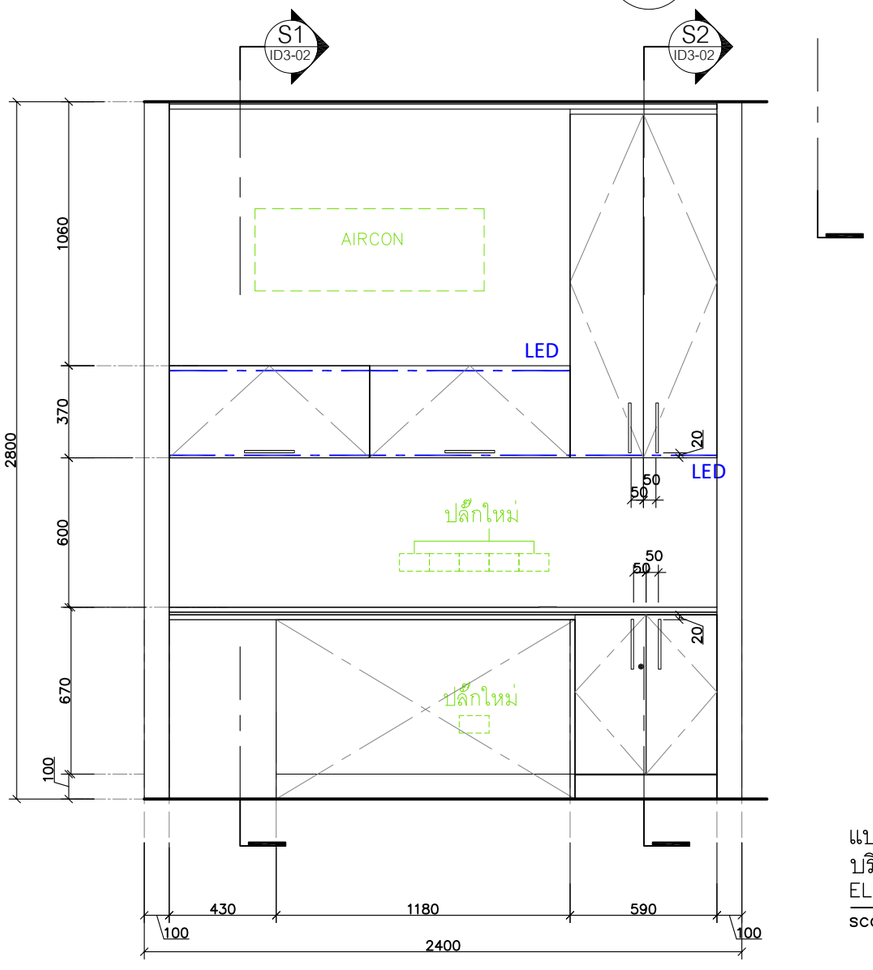

แบบขยาย โต๊ะทำงาน
บริเวณห้องนอนใหญ่
ELEVATION 1

scale 1:25

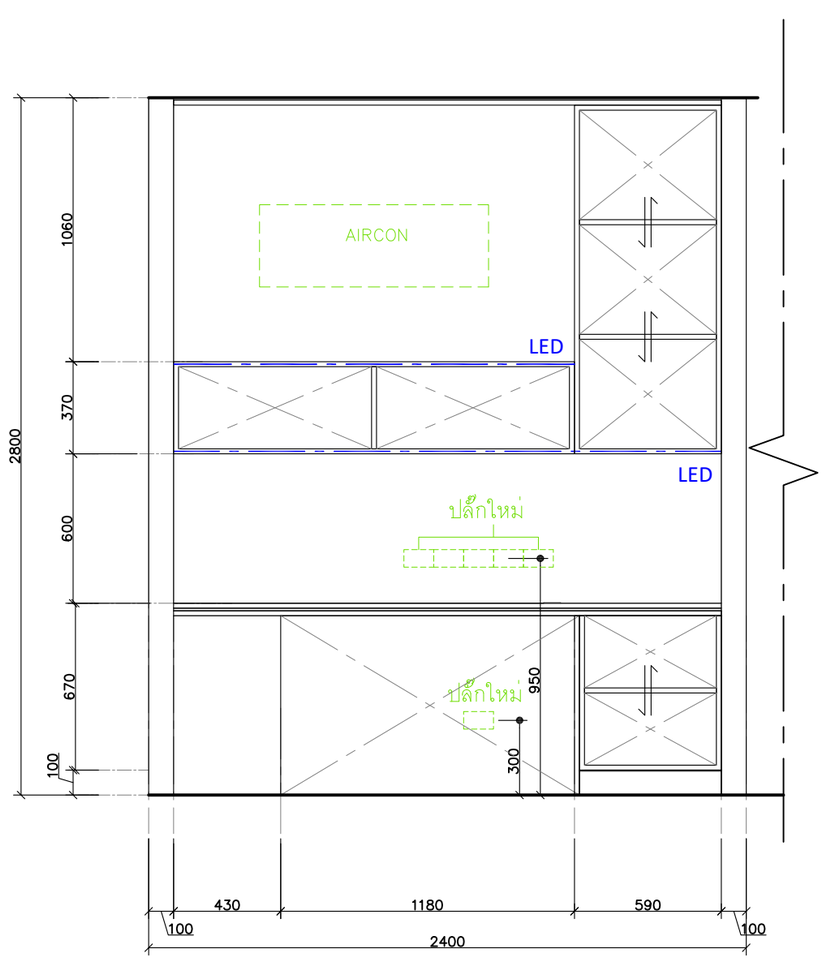

แบบขยาย โต๊ะทำงาน(ภายใน)
บริเวณห้องนอนใหญ่
ELEVATION 1

scale 1:25

SPACEMAN

PROJECT | SONIA HOUSE

LOCATION | REIGNWOOD PARK
LAMLUKKA, PATHUM THANI

ARCHITECT

INTERIOR DESIGNER | ปรัตถกร ประมุขกุล ภ-สน 1438

STRUCTURAL ENGINEER

TITLE | 2nd FLOOR
แบบขยาย โต๊ะทำงาน
ELEVATION

2026-06-18
ID3-02
1:25 @ A3

Note: SPACEMAN takes no responsibility for dimensions obtained by scaling from this drawing. If no dimension is shown the recipient must ascertain the dimension specifically from the architect or by site measurement and may not rely on the drawing. Supply of the drawing in digital form is solely for convenience and no reliance may be placed on any data in digital form. All data must be checked against hard copy. This drawing is issued for design intent only and should not be used for construction unless stated. This drawing is the property of SPACEMAN

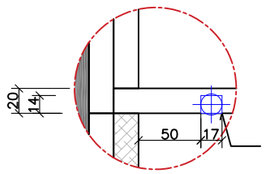

ติดตั้ง LED STRIP LIGHT
LAMPTITUDE ALP-D
ขนาด W17XH14.3 มม .

DETAIL 1
scale 1:5

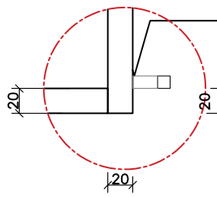

บานเปิดบนคู่ HMR E0
(PURPLE CORE)
หนา 20 มม. กรุลามิเนต
สีครีมอ่อน FORMICA
- มือจับแบบดึง สีเงิน
HAFELE 481.21.021 SV-MT
หรือเทียบเท่า

DETAIL 2
scale 1:5

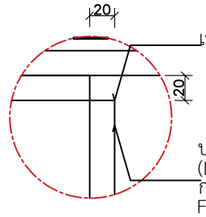

เว้นGAP 20 มม.

บานเปิดคู่ HMR E0
(PURPLE CORE) หนา 20 มม.
กรุลามิเนต สีครีมอ่อน
FORMICA หรือเทียบเท่า
(ระบุภายหลัง)

DETAIL 3
scale 1:5

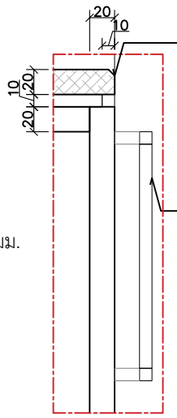

TOP แผ่น HMR E0(PURPLE CORE) หนา 20 มม.
กรุหินแกรนิต สีขาว (ระบุภายหลัง)
ลบขอบมุม 5มม.

บานเปิดบนคู่ HMR E0(PURPLE CORE)
หนา 20 มม. กรุลามิเนต
สีครีมอ่อน FORMICA
- มือจับแบบดึง สีเงิน
HAFELE 481.21.021 SV-MT
หรือเทียบเท่า

DETAIL 4
scale 1:5

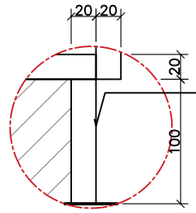

ขาตู้ล่าง แผ่น HMR E0
(PURPLE CORE) หนา 20 มม.
กรุลามิเนต ลายไม้ FORMICA
หรือเทียบเท่า (ระบุภายหลัง)

DETAIL 5
scale 1:5

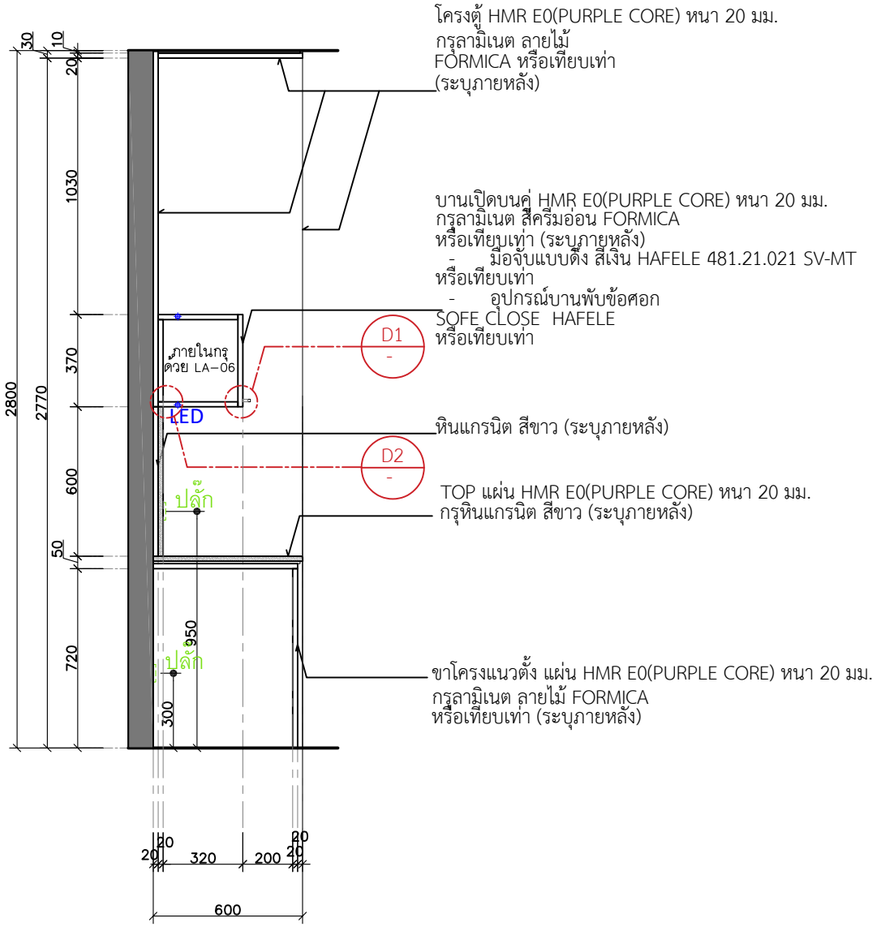

โครงตู้ HMR E0(PURPLE CORE) หนา 20 มม.
กรุลามิเนต ลายไม้
FORMICA หรือเทียบเท่า
(ระบุภายหลัง)

บานเปิดบนคู่ HMR E0(PURPLE CORE) หนา 20 มม.
กรุลามิเนต สีครีมอ่อน FORMICA
หรือเทียบเท่า (ระบุภายหลัง)
- มือจับแบบดึง สีเงิน HAFELE 481.21.021 SV-MT
หรือเทียบเท่า
- อุปกรณ์บานพับข้อศอก
SOFE CLOSE HAFELE
หรือเทียบเท่า

หินแกรนิต สีขาว (ระบุภายหลัง)

TOP แผ่น HMR E0(PURPLE CORE) หนา 20 มม.
กรุหินแกรนิต สีขาว (ระบุภายหลัง)

ขาโครงแนวตั้ง แผ่น HMR E0(PURPLE CORE) หนา 20 มม.
กรุลามิเนต ลายไม้ FORMICA
หรือเทียบเท่า (ระบุภายหลัง)

แบบขยาย โต๊ะทำงาน
บริเวณห้องนอนใหญ่
SECTION 1
scale 1:25

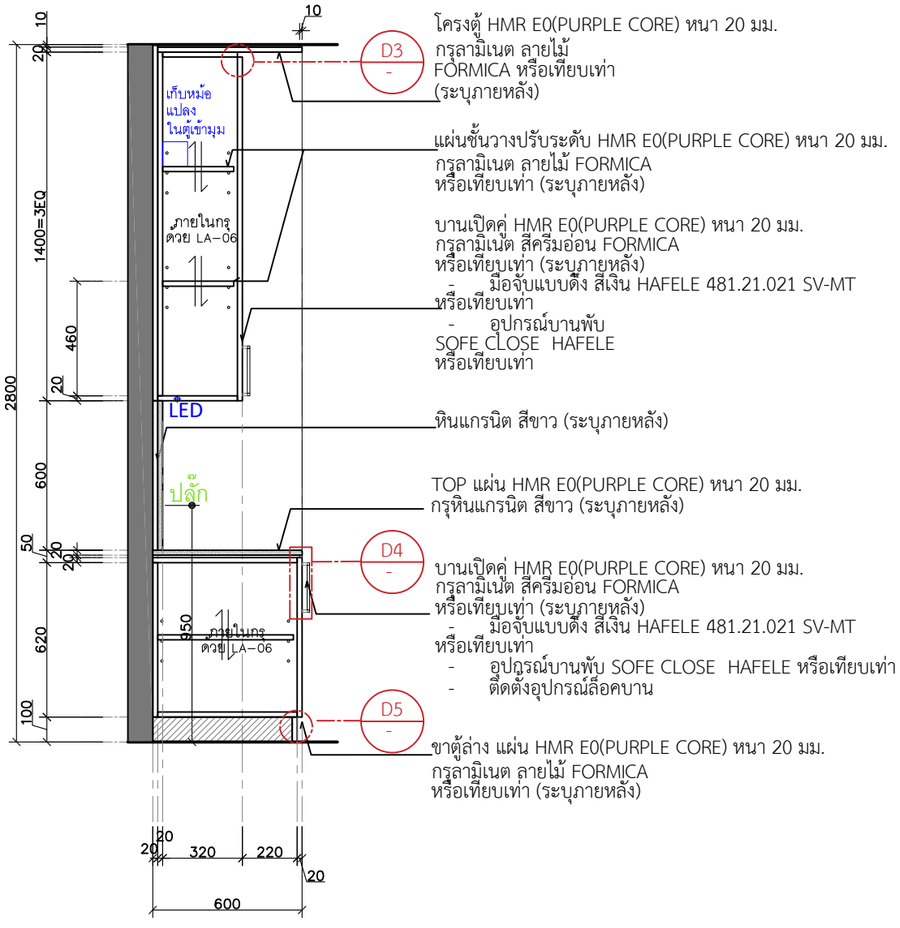

โครงตู้ HMR E0(PURPLE CORE) หนา 20 มม.
กรุลามิเนต ลายไม้
FORMICA หรือเทียบเท่า
(ระบุภายหลัง)

แผ่นชั้นวางปรับระดับ HMR E0(PURPLE CORE) หนา 20 มม.
กรุลามิเนต ลายไม้ FORMICA
หรือเทียบเท่า (ระบุภายหลัง)

บานเปิดคู่ HMR E0(PURPLE CORE) หนา 20 มม.
กรุลามิเนต สีครีมอ่อน FORMICA
หรือเทียบเท่า (ระบุภายหลัง)
- มือจับแบบดึง สีเงิน HAFELE 481.21.021 SV-MT
หรือเทียบเท่า
- อุปกรณ์บานพับ
SOFE CLOSE HAFELE
หรือเทียบเท่า

หินแกรนิต สีขาว (ระบุภายหลัง)

TOP แผ่น HMR E0(PURPLE CORE) หนา 20 มม.
กรุหินแกรนิต สีขาว (ระบุภายหลัง)

บานเปิดคู่ HMR E0(PURPLE CORE) หนา 20 มม.
กรุลามิเนต สีครีมอ่อน FORMICA
หรือเทียบเท่า (ระบุภายหลัง)
- มือจับแบบดึง สีเงิน HAFELE 481.21.021 SV-MT
หรือเทียบเท่า
- อุปกรณ์บานพับ SOFE CLOSE HAFELE หรือเทียบเท่า
- ติดตั้งอุปกรณ์ล็อคบาน

ขาตู้ล่าง แผ่น HMR E0(PURPLE CORE) หนา 20 มม.
กรุลามิเนต ลายไม้ FORMICA
หรือเทียบเท่า (ระบุภายหลัง)

แบบขยาย โต๊ะทำงาน
บริเวณห้องนอนใหญ่
SECTION 2
scale 1:25

SPACEMAN

PROJECT | SONIA HOUSE

LOCATION | REIGNWOOD PARK
LAMLUKKA, PATHUM THANI

ARCHITECT

INTERIOR DESIGNER | ปรัตถกร ประมุขกุล ภ-สน 1438

STRUCTURAL ENGINEER

TITLE | 2nd FLOOR
แบบขยาย โต๊ะทำงาน
SECTION

2026-06-18
ID3-03
1:25 @ A3

Note: SPACEMAN takes no responsibility for dimensions obtained by scaling from this drawing. If no dimension is shown the recipient must ascertain the dimension specifically from the architect or by site measurement and may not rely on the drawing. Supply of the drawing in digital form is solely for convenience and no reliance may be placed on any data in digital form. All data must be checked against hard copy. This drawing is issued for design intent only and should not be used for construction unless stated. This drawing is the property of SPACEMAN

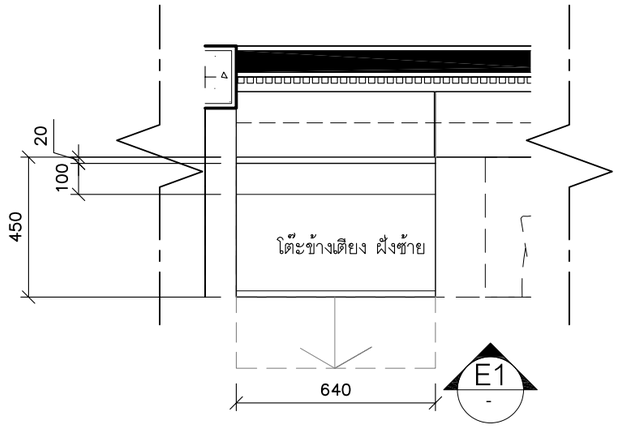

แบบขยาย โต๊ะข้างเตียง
บริเวณห้องนอนใหญ่
PLAN

scale 1:20

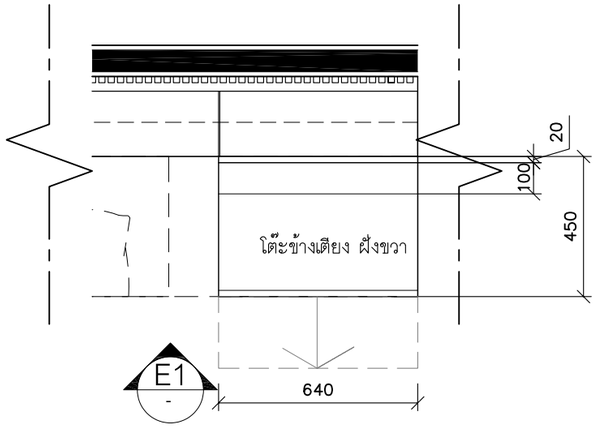

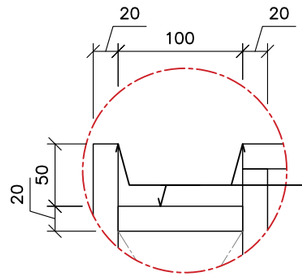

แผ่นติดตาย HMR E0
(PURPLE CORE) หนา 20 มม.
กรุลามิเนต ลายไม้ FORMICA
หรือเทียบเท่า (ระบุภายหลัง)

DETAIL 1

scale 1:5

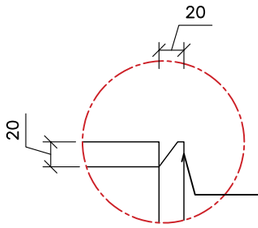

บานลิ้นชัก HMR E0
(PURPLE CORE) หนา 20 มม.
กรุลามิเนต ลายไม้ FORMICA
หรือเทียบเท่า (ระบุภายหลัง)

DETAIL 2

scale 1:5

แบบขยาย โต๊ะข้างเตียง
บริเวณห้องนอนใหญ่
ELEVATION 1

scale 1:20

แบบขยาย โต๊ะข้างเตียง (ภายใน)
บริเวณห้องนอนใหญ่
ELEVATION 1

scale 1:20

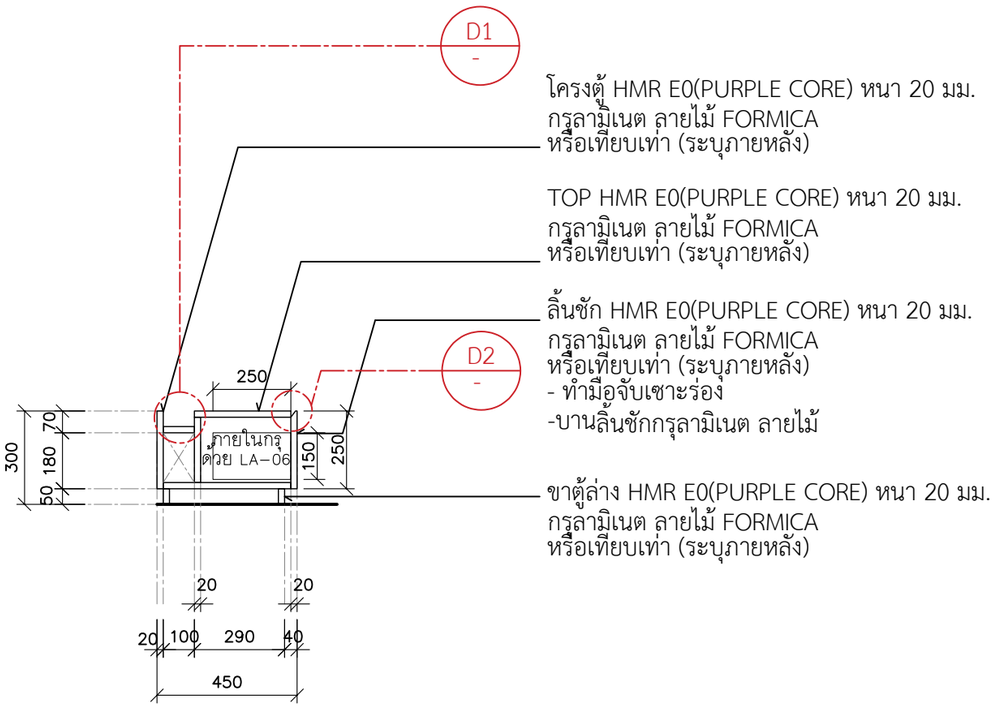

แบบขยาย โต๊ะข้างเตียง
บริเวณห้องนอนใหญ่
SECTION 1

scale 1:20

SPACEMAN

PROJECT: SONIA HOUSE

LOCATION: REIGNWOOD PARK
LAMLUKKA, PATHUM THANI

ARCHITECT:

INTERIOR DESIGNER: ปรัตถกร ประมุขกุล ภ-สน 1438

STRUCTURAL ENGINEER:

TITLE: 2nd FLOOR(บริเวณห้องนอนใหญ่)
แบบขยาย โต๊ะข้างเตียง
PLAN ,ELEVATION ,SECTION ,DETAIL

2026-06-25
ID3-04

Note: SPACEMAN takes no responsibility for dimensions obtained by scaling from this drawing. If no dimension is shown the recipient must ascertain the dimension specifically from the architect or by site measurement and may not rely on the drawing. Supply of the drawing in digital form is solely for convenience and no reliance may be placed on any data in digital form. All data must be checked against hard copy. This drawing is issued for design intent only and should not be used for construction unless stated. This drawing is the property of SPACEMAN

1:20 @ A3

*ผู้รับเหมาตรวจสอบคู่มือของอุปกรณ์ก่อนดำเนินการ

D2–01 / MASTER BEDROOM

ภายใน
MASTER BEDROOM

ภายนอก

ห้องแต่งตัว

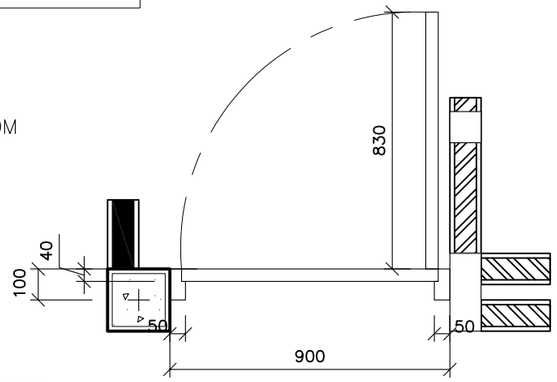

PLAN

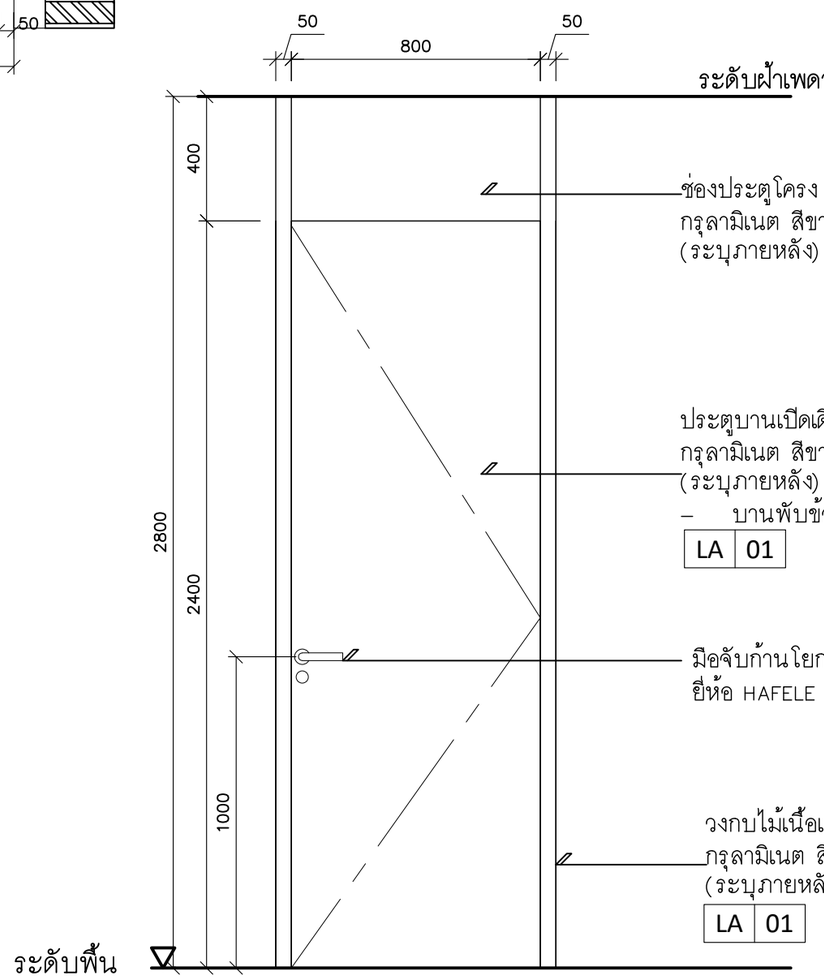

ภายนอก

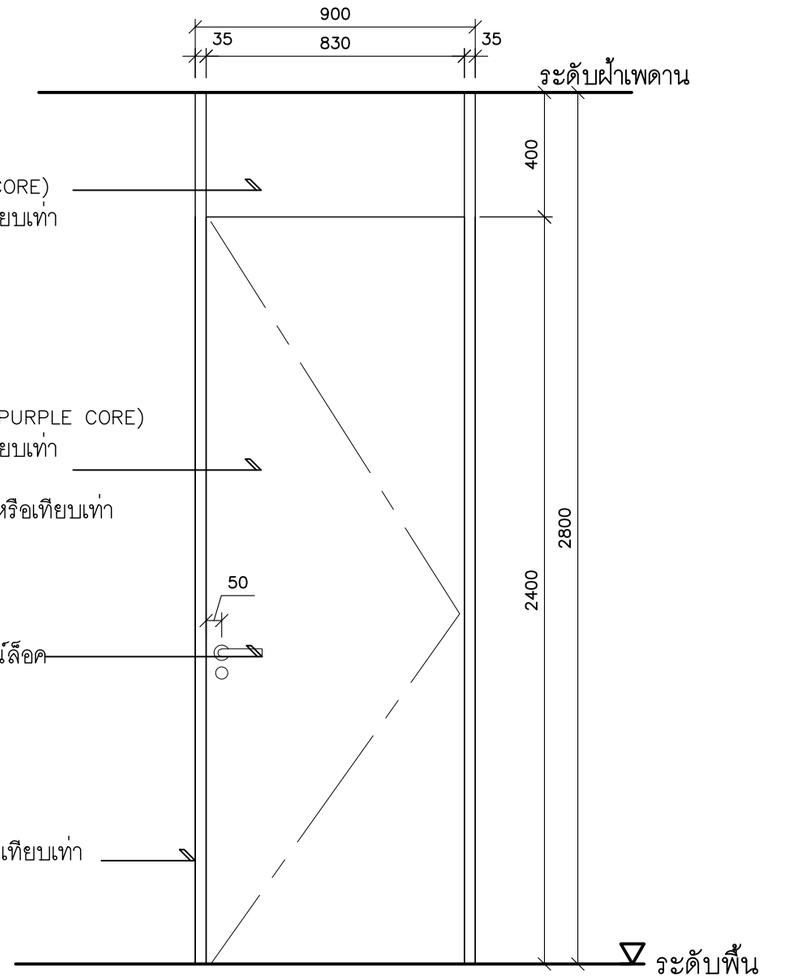

ภายใน

SPACEMAN	PROJECT SONIA HOUSE	LOCATION	ARCHITECT	INTERIOR DESIGNER ปรัตถกร ประมุขกุล ภ–สน 1438	STRUCTURAL ENGINEER	TITLE D2–01 ห้องนอนใหญ่ DOOR PLAN AND ELEVATION	2026–04–28	ID6–01	1:20 @ A3

Note: SPACEMAN takes no responsibility for dimensions obtained by scaling from this drawing. If no dimension is shown the recipient must ascertain the dimension specifically from the architect or by site measurement and may not rely on the drawing. Supply of the drawing in digital form is solely for convenience and no reliance may be placed on any data in digital form. All data must be checked against hard copy. This drawing is issued for design intent only and should not be used for construction unless stated. This drawing is the property of SPACEMAN

SONIA HOUSE

REIGNWOOD PARK

LAMLUKKA, PATHUM THANI

แบบขยายห้องแต่งตัว

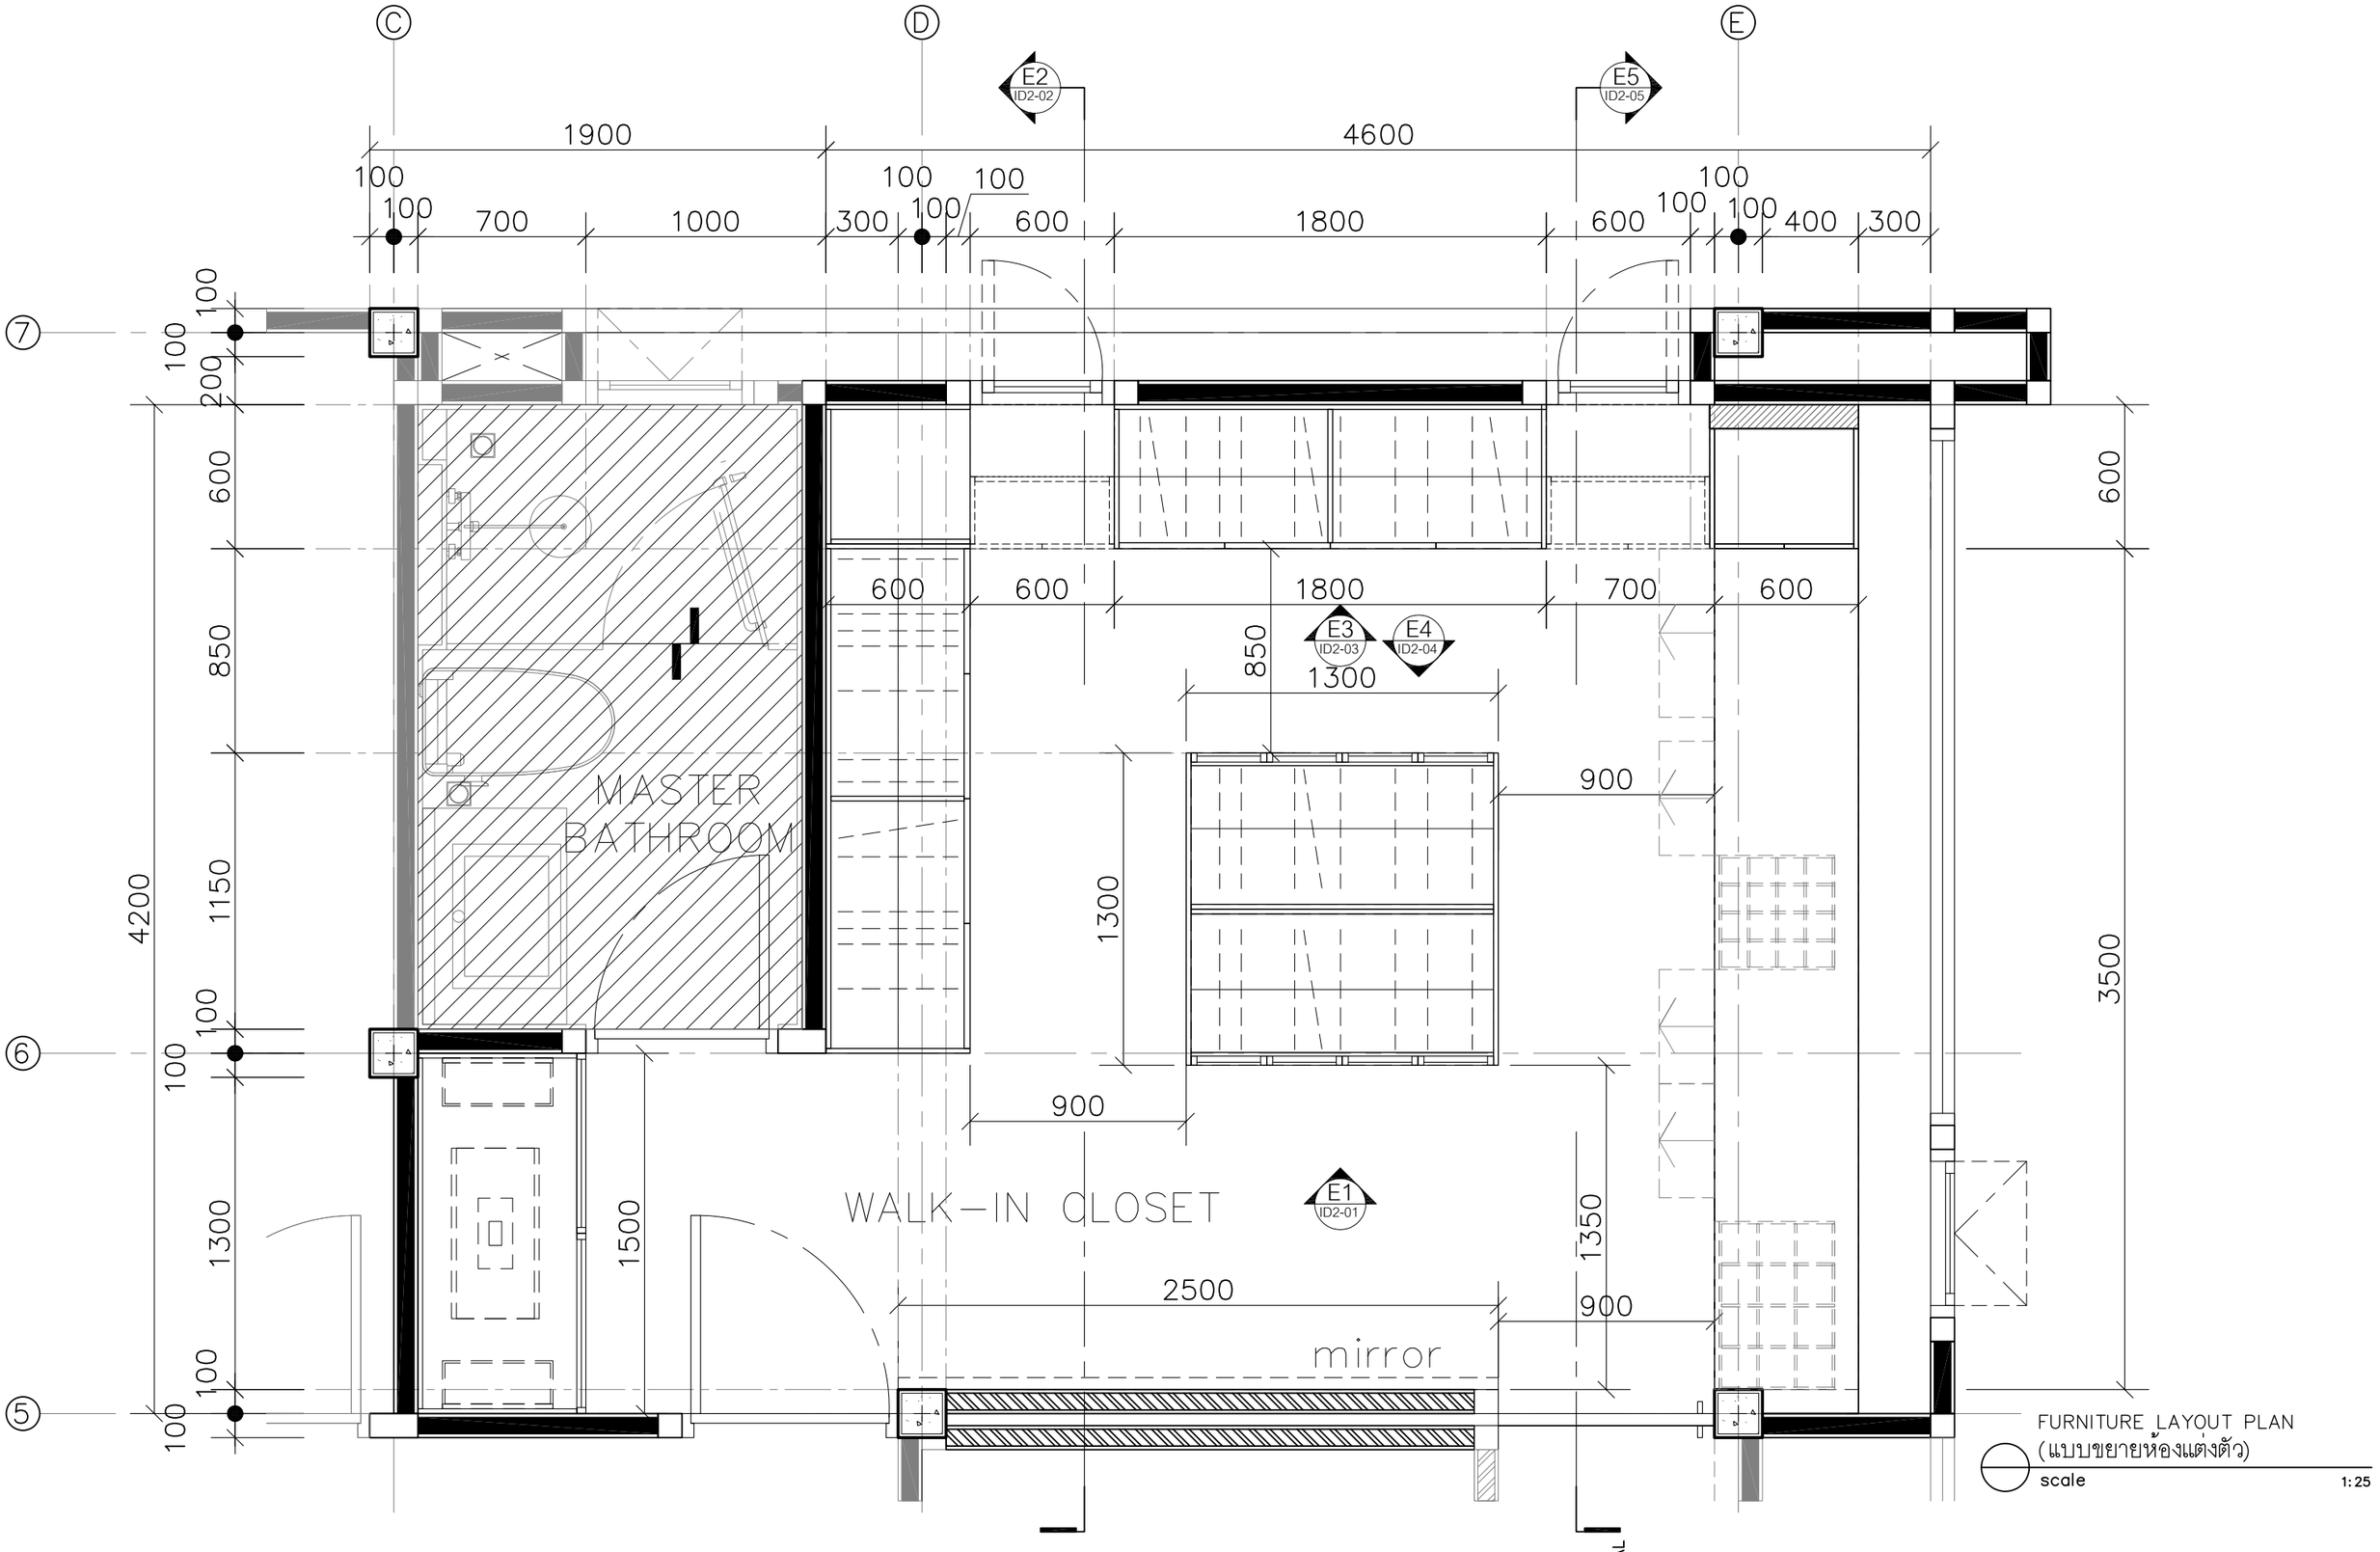

FURNITURE LAYOUT PLAN
(แบบขยายห้องแต่งตัว)
scale 1:25

SPACEMAN

PROJECT: SONIA HOUSE

LOCATION: REIGNWOOD PARK
LAMLUKKA, PATHUM THANI

ARCHITECT:

INTERIOR DESIGNER: ปรัตถกร ประมุขกุล ภ-สน 1438

STRUCTURAL ENGINEER:

TITLE: 2nd FLOOR
FURNITURE LAYOUT PLAN
(แบบขยายห้องแต่งตัว)

2026-06-18
ID1-01
1:25 @ A3

Note: SPACEMAN takes no responsibility for dimensions obtained by scaling from this drawing. If no dimension is shown the recipient must ascertain the dimension specifically from the architect or by site measurement and may not rely on the drawing. Supply of the drawing in digital form is solely for convenience and no reliance may be placed on any data in digital form. All data must be checked against hard copy. This drawing is issued for design intent only and should not be used for construction unless stated. This drawing is the property of SPACEMAN

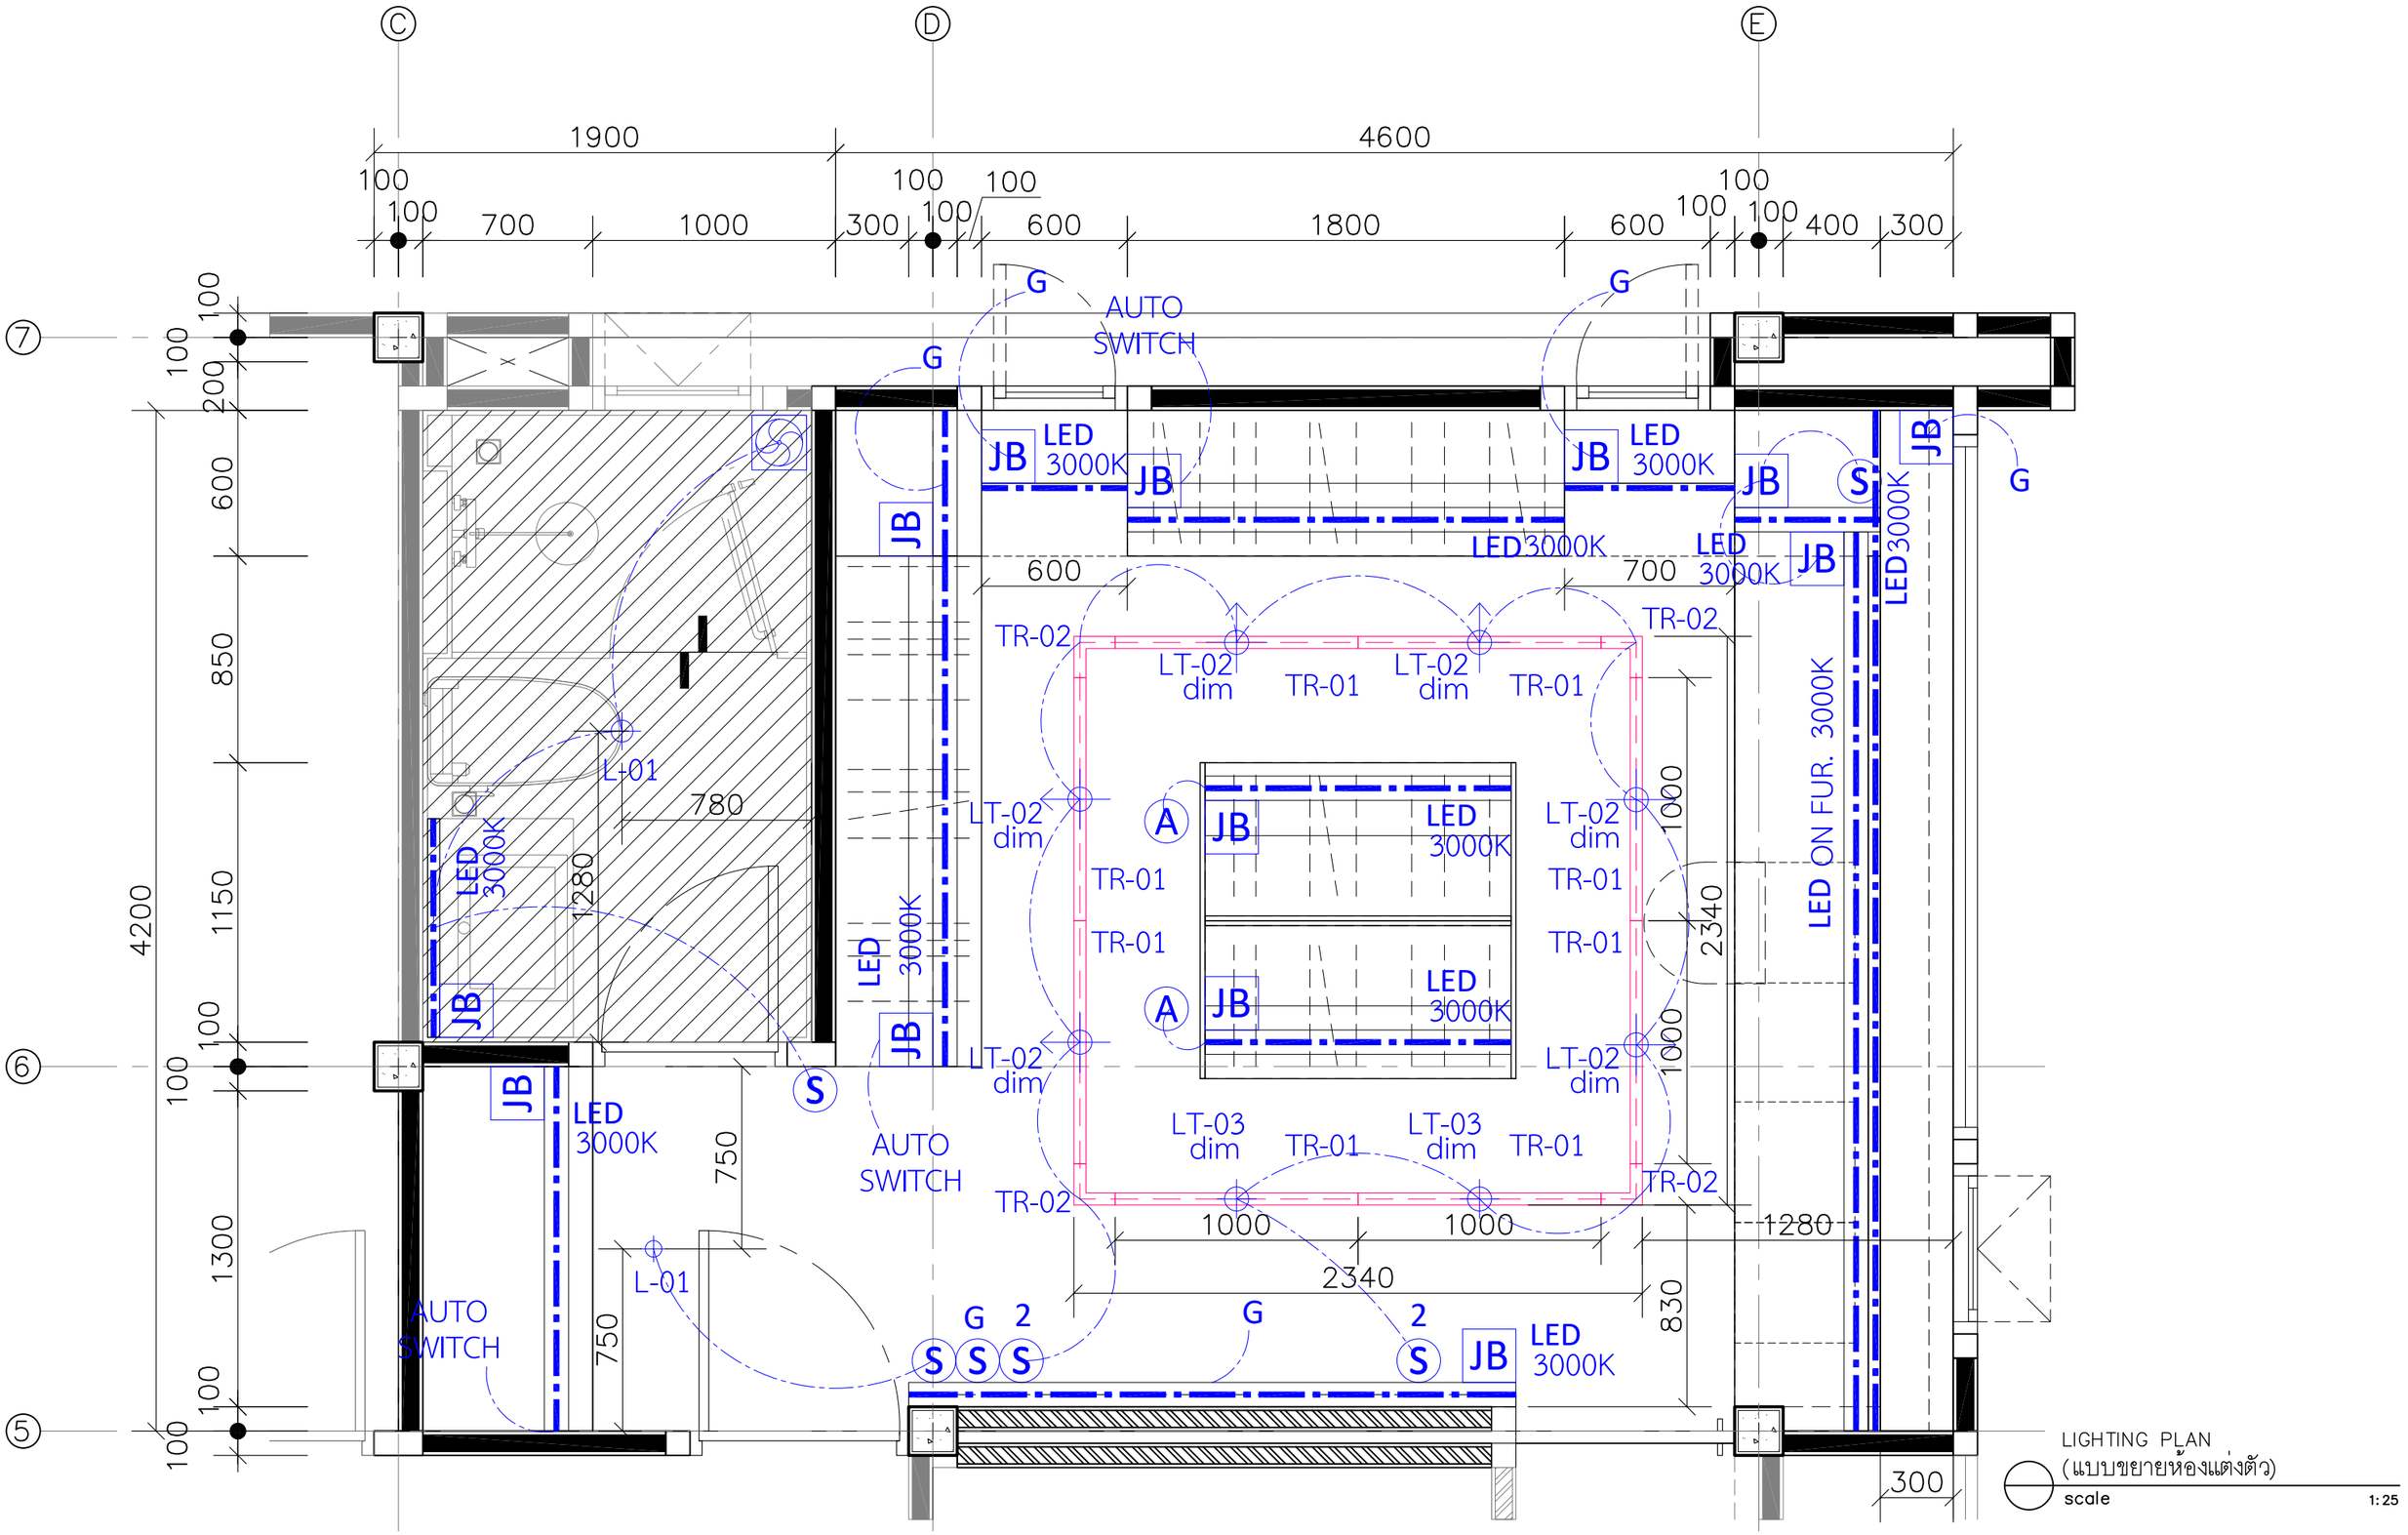

SPACEMAN

PROJECT: SONIA HOUSE

LOCATION: REIGNWOOD PARK
LAMLUKKA, PATHUM THANI

ARCHITECT

INTERIOR DESIGNER: ปรัตถกร ประมุขกุล ภ-สน 1438

STRUCTURAL ENGINEER

TITLE: 2nd FLOOR
LIGHTING PLAN
(แบบขยายห้องแต่งตัว)

2026-06-18
ID1-02
1:25 @ A3

Note: SPACEMAN takes no responsibility for dimensions obtained by scaling from this drawing. If no dimension is shown the recipient must ascertain the dimension specifically from the architect or by site measurement and may not rely on the drawing. Supply of the drawing in digital form is solely for convenience and no reliance may be placed on any data in digital form. All data must be checked against hard copy. This drawing is issued for design intent only and should not be used for construction unless stated. This drawing is the property of SPACEMAN

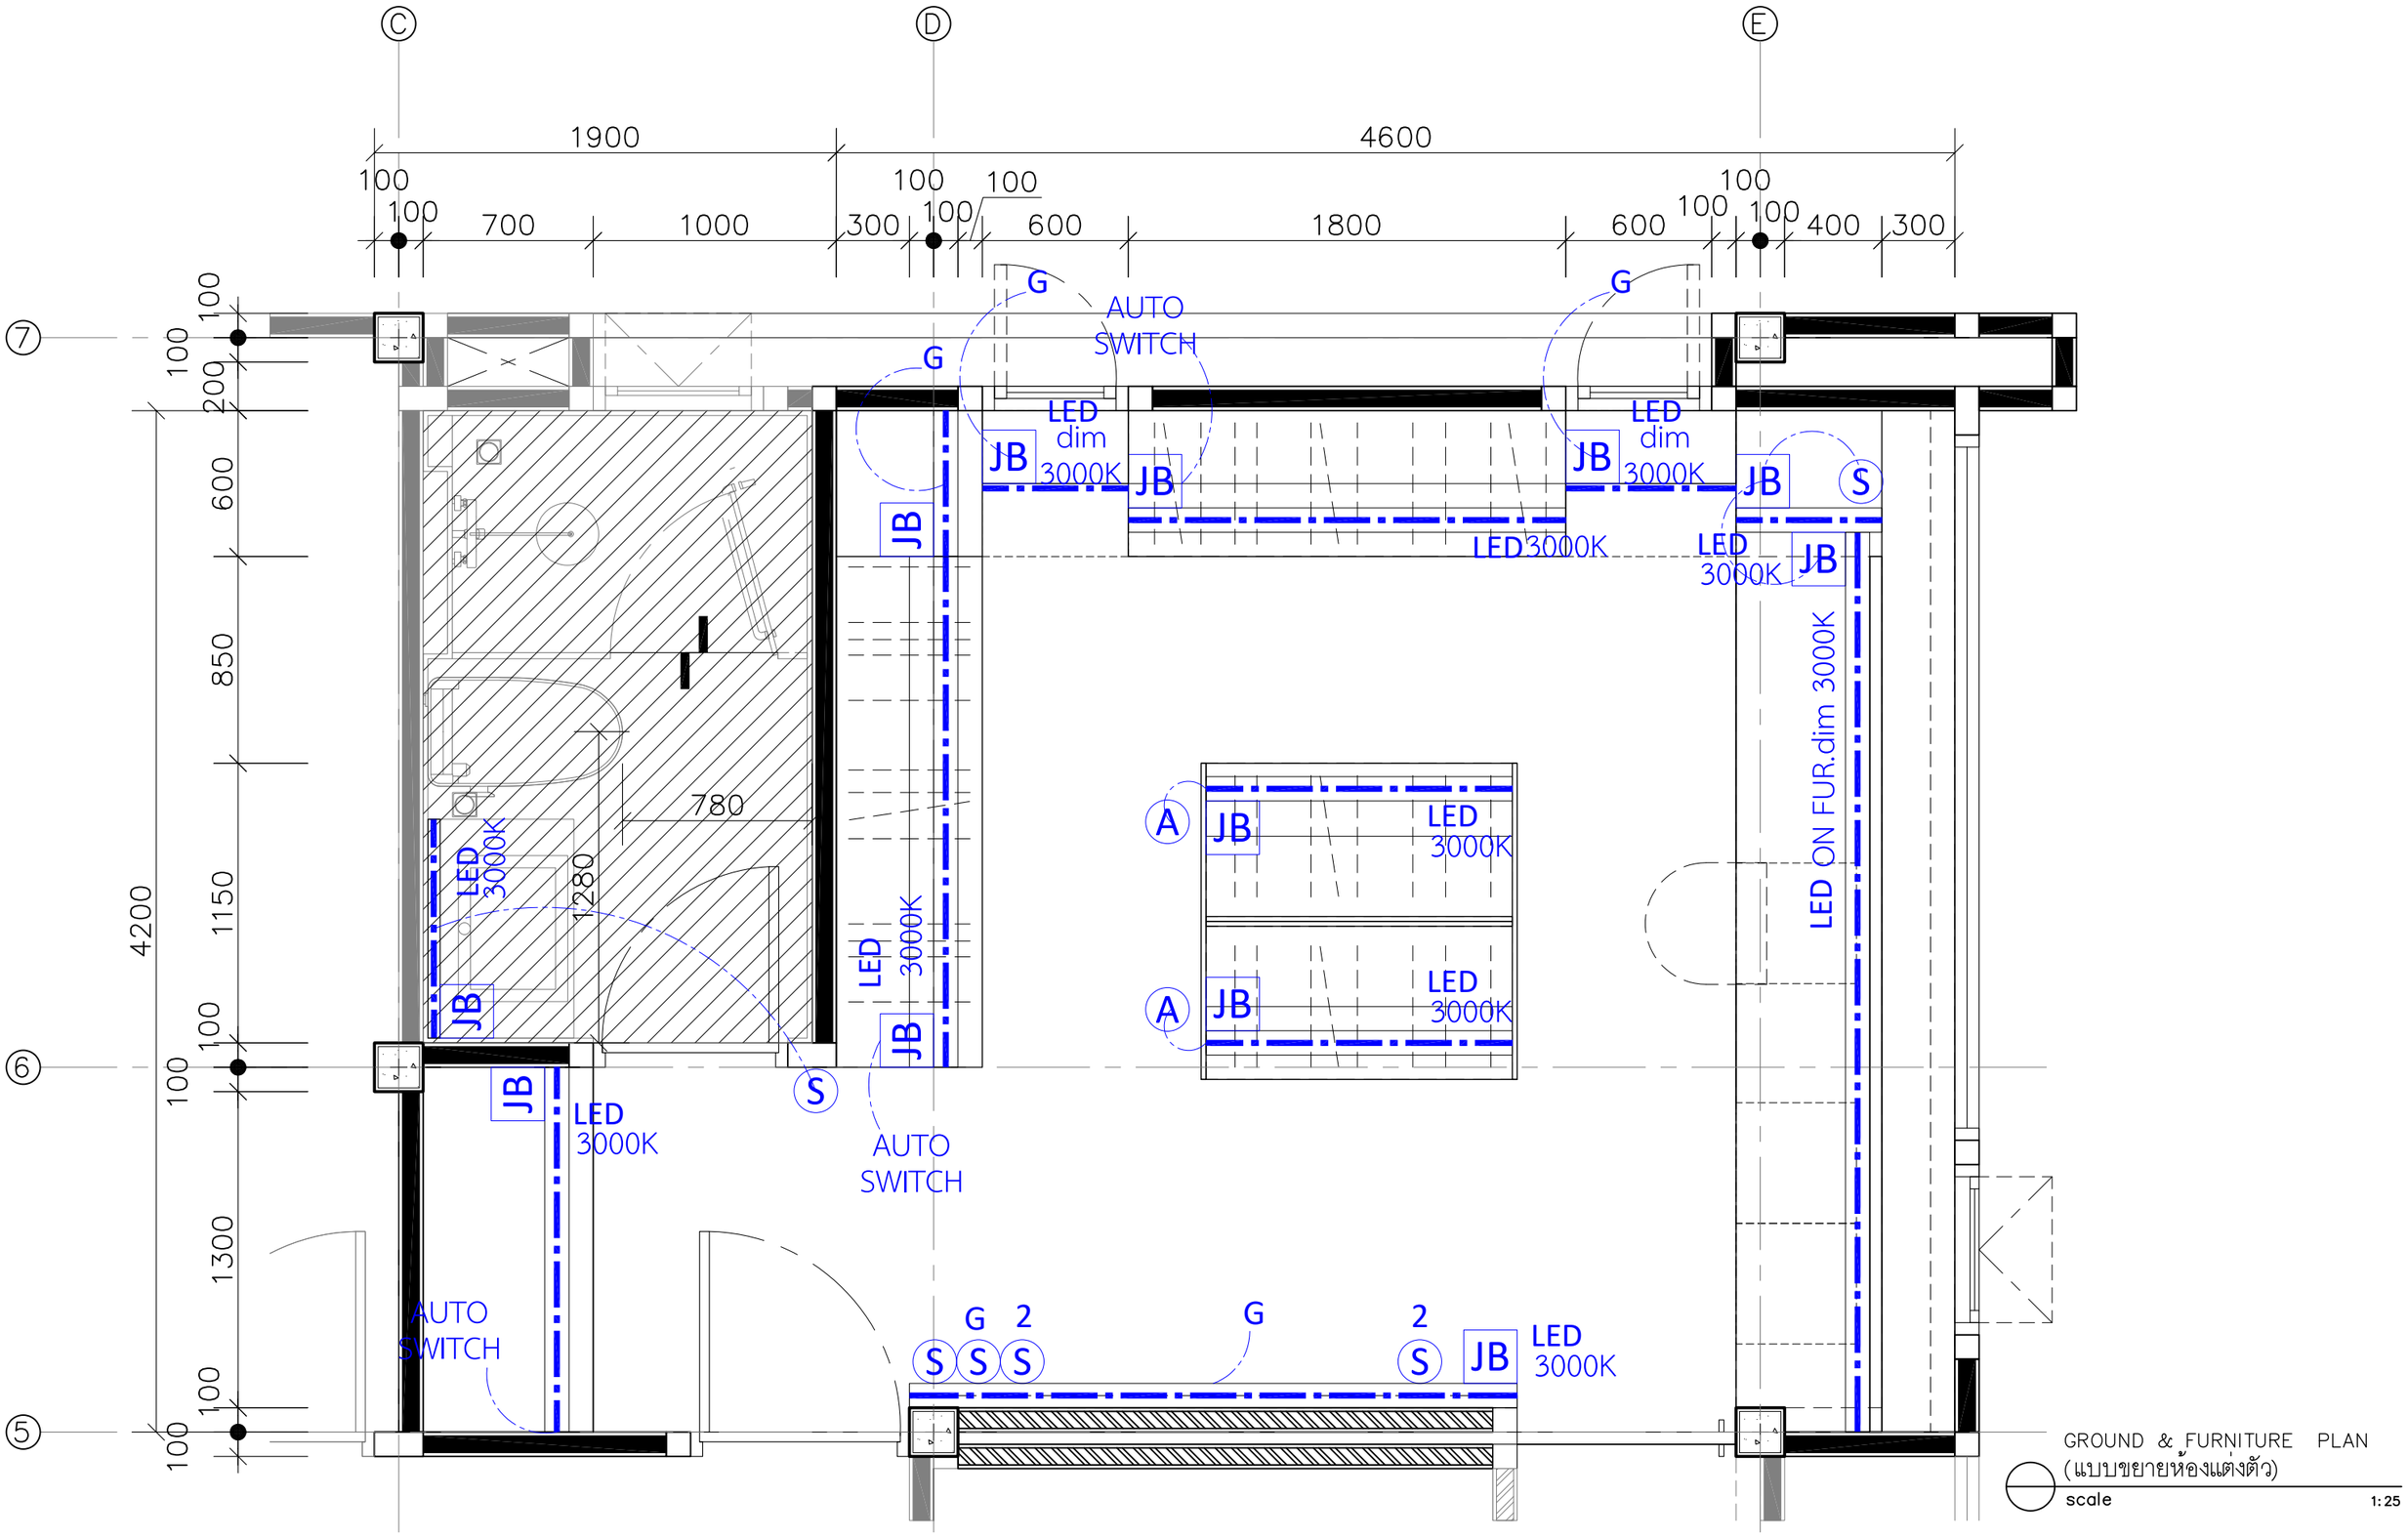

GROUND & FURNITURE PLAN
(แบบขยายห้องแต่งตัว)
scale 1:25

SPACEMAN

PROJECT | SONIA HOUSE

LOCATION | REIGNWOOD PARK
LAMLUKKA, PATHUM THANI

ARCHITECT

INTERIOR DESIGNER | ปรัตถกร ประมุขกุล ภ-สน 1438

STRUCTURAL ENGINEER

TITLE | 2nd FLOOR
LIGHTING PLAN
(แบบขยายห้องแต่งตัว)

2026-06-18
ID1-02
1:25 @ A3

Note: SPACEMAN takes no responsibility for dimensions obtained by scaling from this drawing. If no dimension is shown the recipient must ascertain the dimension specifically from the architect or by site measurement and may not rely on the drawing. Supply of the drawing in digital form is solely for convenience and no reliance may be placed on any data in digital form. All data must be checked against hard copy. This drawing is issued for design intent only and should not be used for construction unless stated. This drawing is the property of SPACEMAN

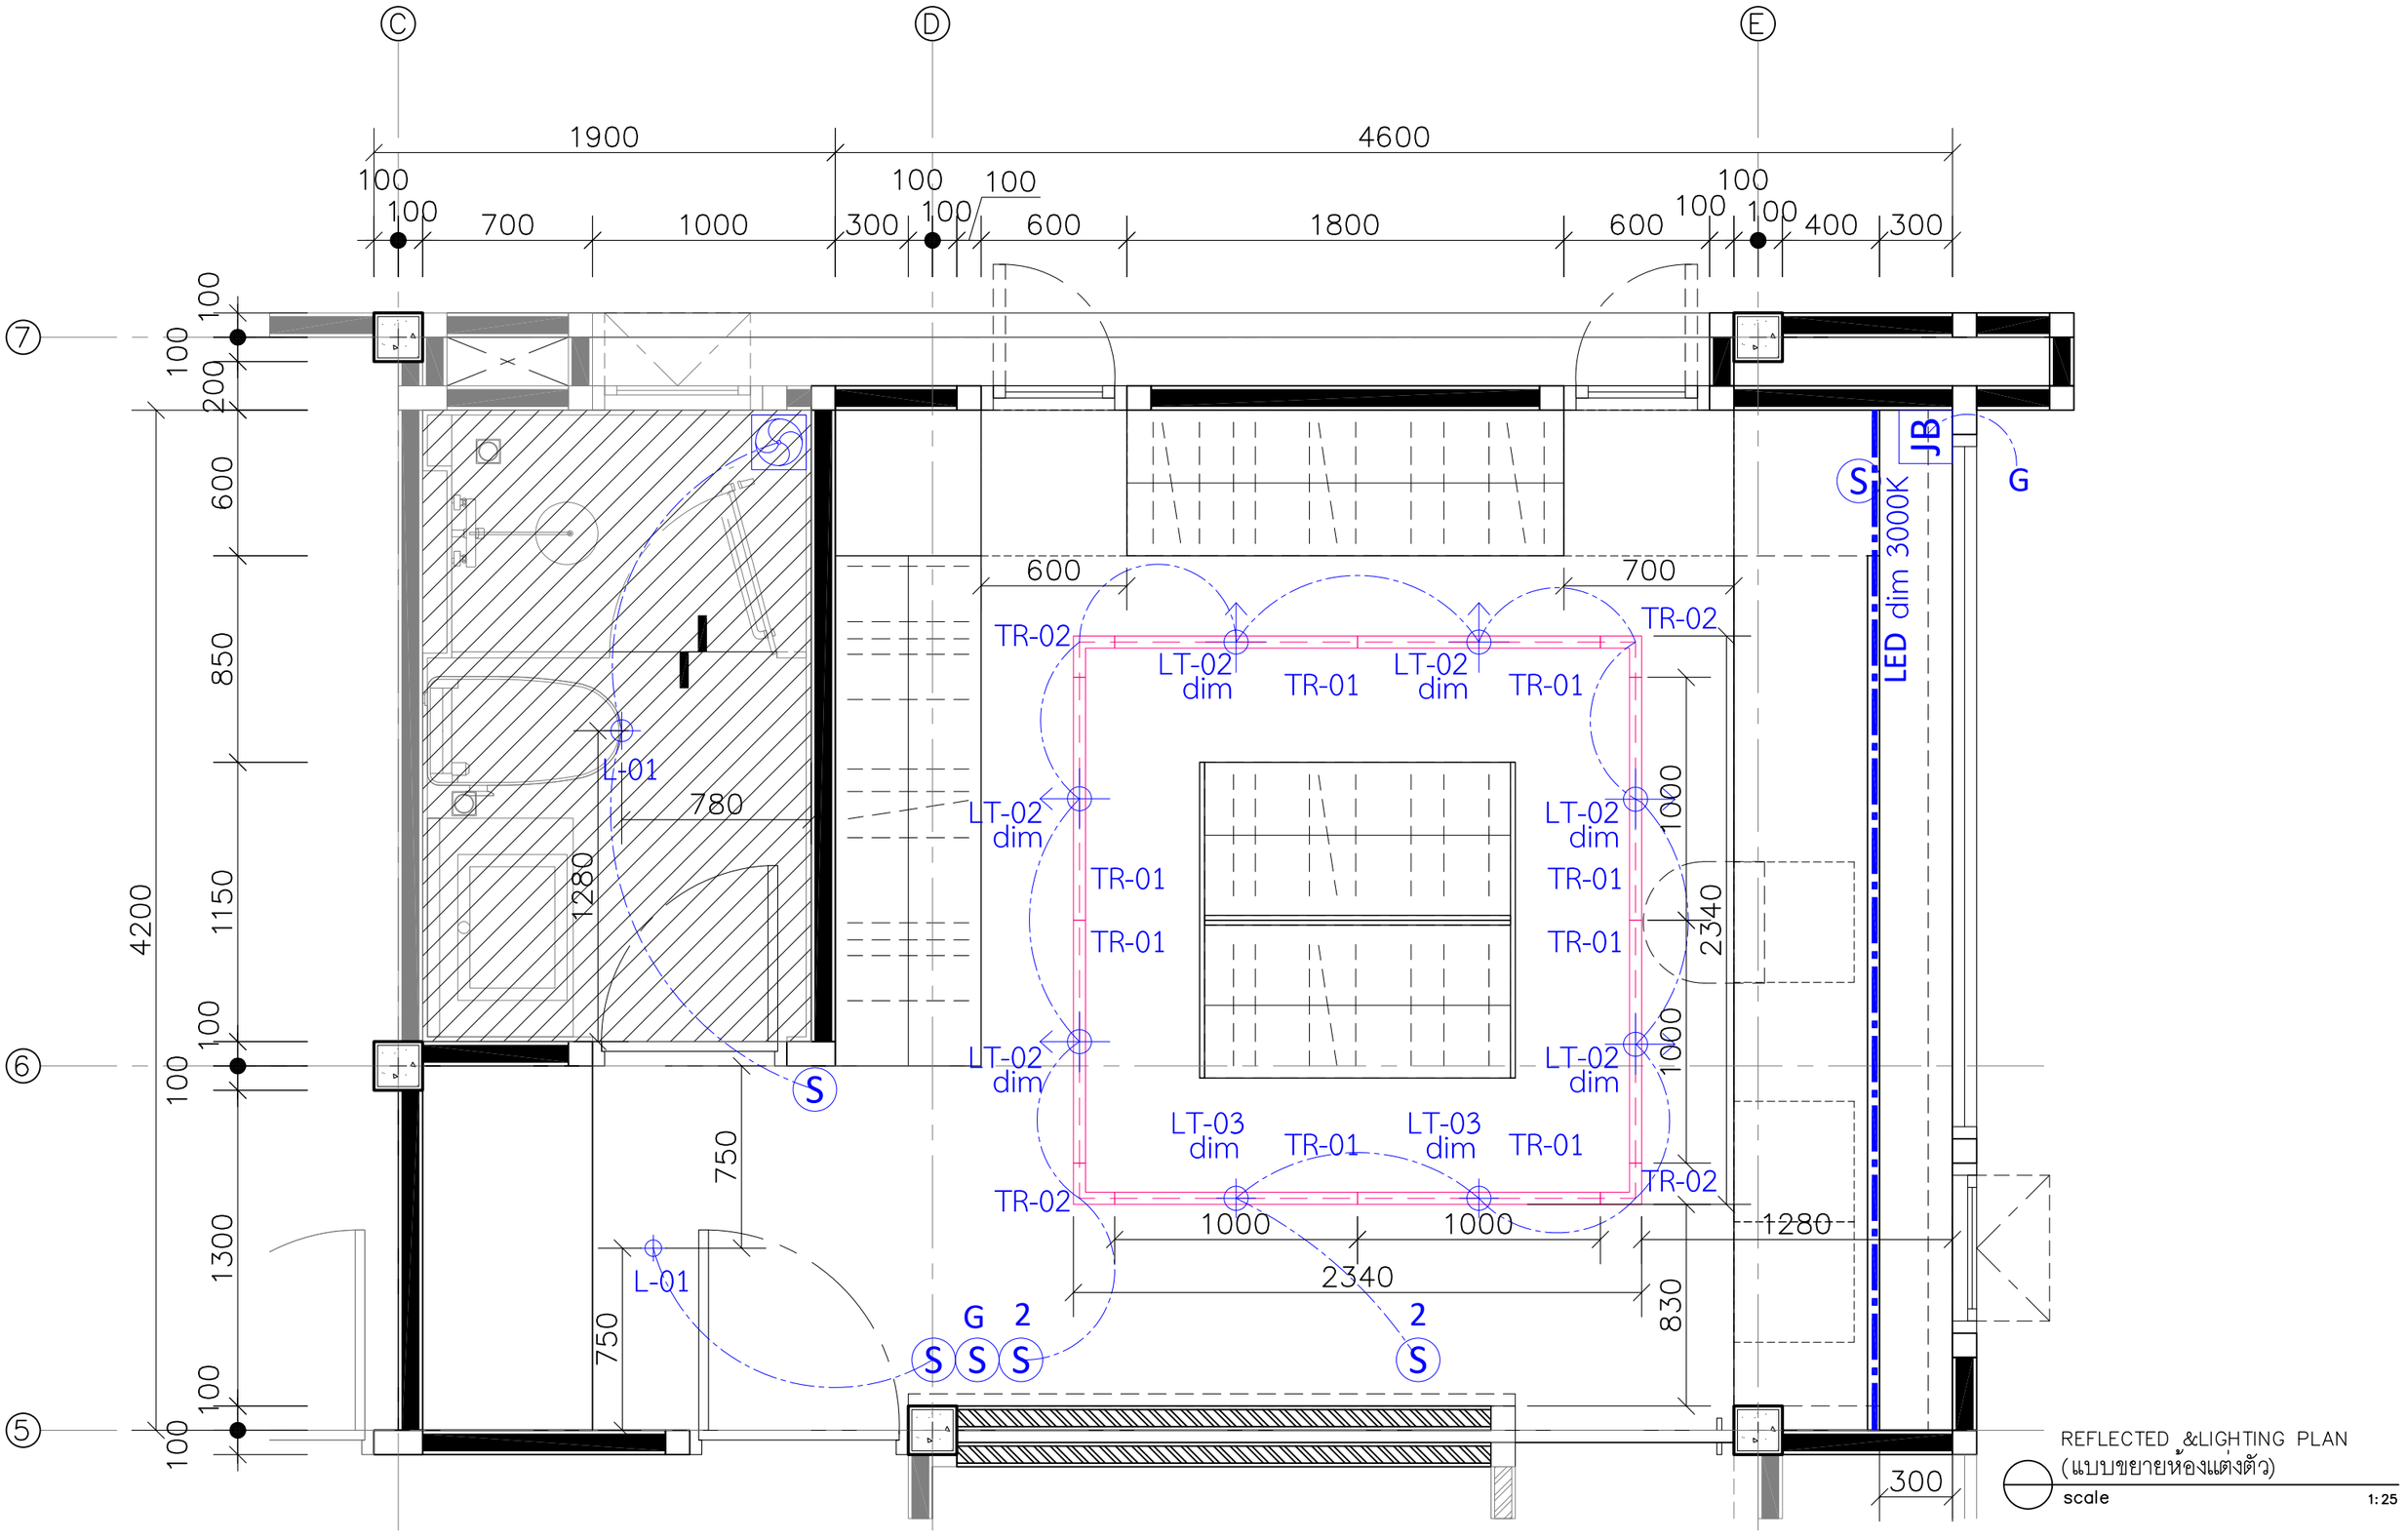

REFLECTED &LIGHTING PLAN
(แบบขยายห้องแต่งตัว)
scale 1:25

SPACEMAN

PROJECT: SONIA HOUSE

LOCATION: REIGNWOOD PARK
LAMLUKKA, PATHUM THANI

ARCHITECT:

INTERIOR DESIGNER: ปรัตถกร ประมุขกุล ภ-สน 1438

STRUCTURAL ENGINEER:

TITLE: 2nd FLOOR
LIGHTING PLAN
(แบบขยายห้องแต่งตัว)

2026-06-18
ID1-02
1:25 @ A3

Note: SPACEMAN takes no responsibility for dimensions obtained by scaling from this drawing. If no dimension is shown the recipient must ascertain the dimension specifically from the architect or by site measurement and may not rely on the drawing. Supply of the drawing in digital form is solely for convenience and no reliance may be placed on any data in digital form. All data must be checked against hard copy. This drawing is issued for design intent only and should not be used for construction unless stated. This drawing is the property of SPACEMAN

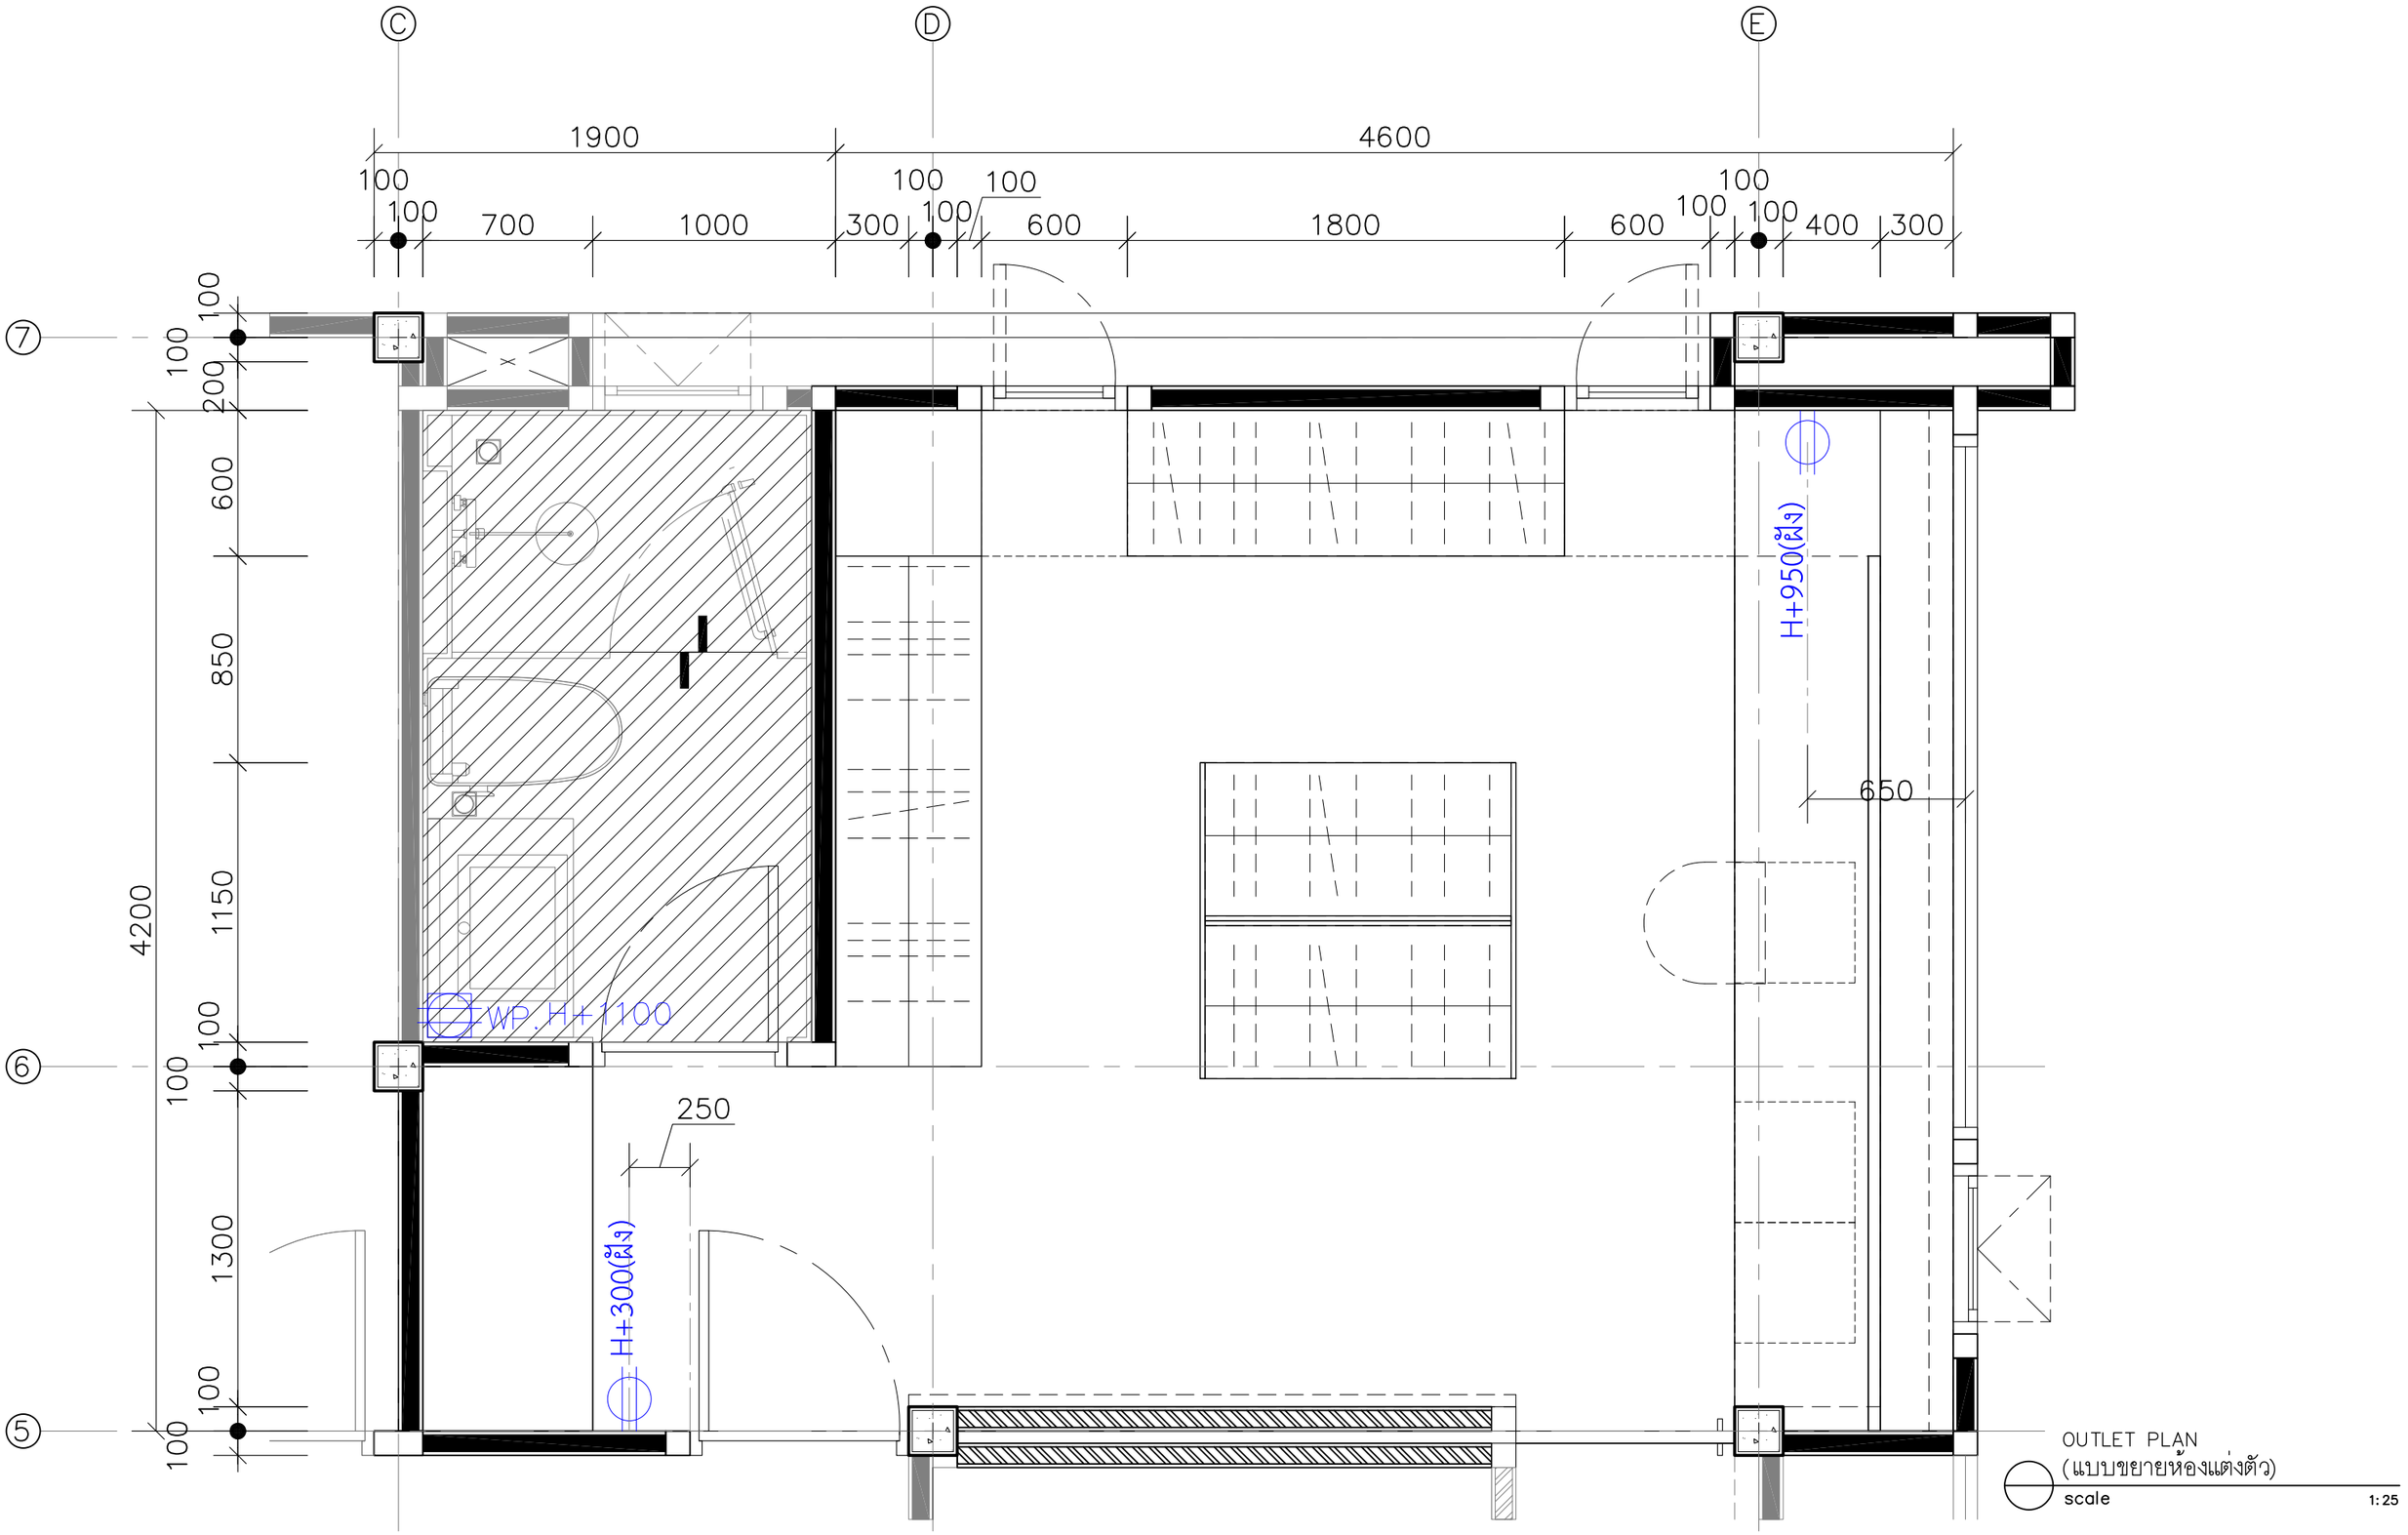

OUTLET PLAN
(แบบขยายห้องแต่งตัว)
scale 1:25

SPACEMAN

PROJECT: SONIA HOUSE

LOCATION: REIGNWOOD PARK
LAMLUKKA, PATHUM THANI

ARCHITECT:

INTERIOR DESIGNER: ปรัตถกร ประมุขกุล ภ-สน 1438

STRUCTURAL ENGINEER:

TITLE: 2nd FLOOR
OUTLET PLAN
(แบบขยายห้องแต่งตัว)

2026-06-18
ID1-03
1:25 @ A3

Note: SPACEMAN takes no responsibility for dimensions obtained by scaling from this drawing. If no dimension is shown the recipient must ascertain the dimension specifically from the architect or by site measurement and may not rely on the drawing. Supply of the drawing in digital form is solely for convenience and no reliance may be placed on any data in digital form. All data must be checked against hard copy. This drawing is issued for design intent only and should not be used for construction unless stated. This drawing is the property of SPACEMAN

WALL LIST

2 ผนังก่ออิฐฉาบปูน ทาสี ซุปเปอร์ชิลด์ สีน้ำอะคริลิก ชนิดกึ่งเงา สีขาว (ระบุเฉดสีภายหลัง)

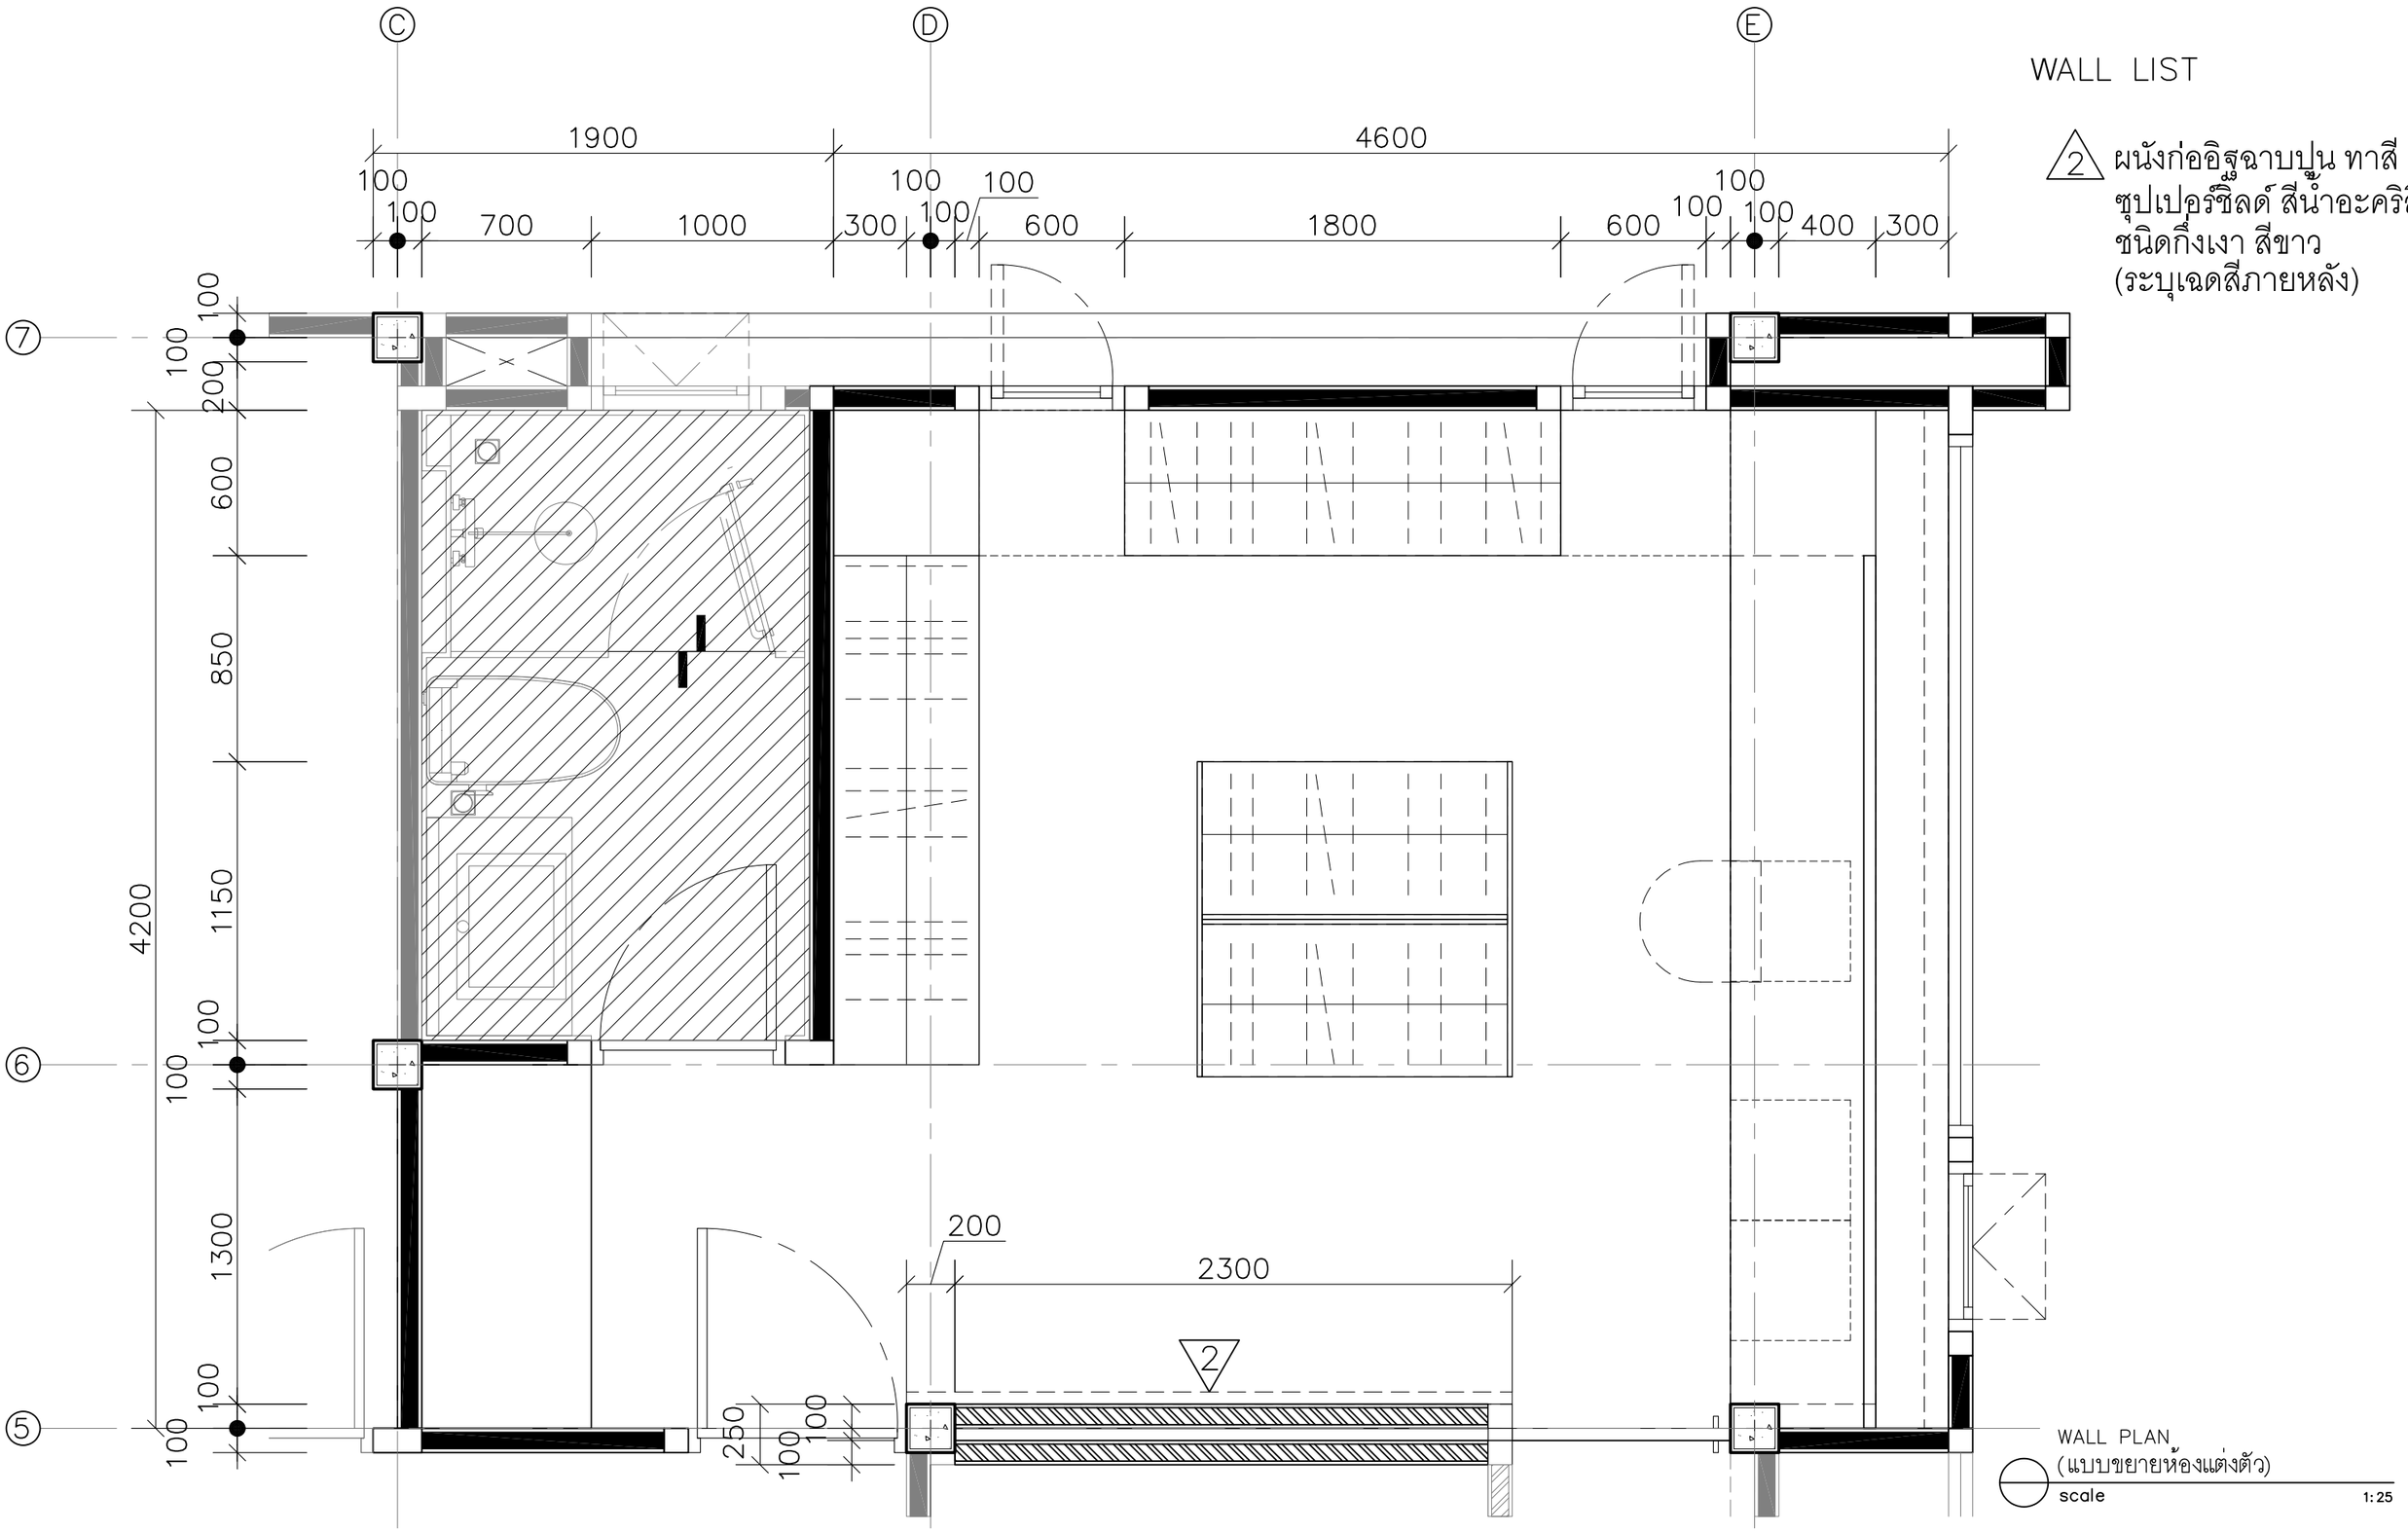

WALL PLAN
(แบบขยายห้องแต่งตัว)
scale 1:25

SPACEMAN	PROJECT: SONIA HOUSE	LOCATION: REIGNWOOD PARK LAMLUKKA, PATHUM THANI	ARCHITECT	INTERIOR DESIGNER: ปรัตถกร ประมุขกุล ภ-สน 1438	STRUCTURAL ENGINEER	TITLE: 2nd FLOOR FURNITURE LAYOUT PLAN (แบบขยายห้องแต่งตัว)	2026-06-18 ID1-04

Note: SPACEMAN takes no responsibility for dimensions obtained by scaling from this drawing. If no dimension is shown the recipient must ascertain the dimension specifically from the architect or by site measurement and may not rely on the drawing. Supply of the drawing in digital form is solely for convenience and no reliance may be placed on any data in digital form. All data must be checked against hard copy. This drawing is issued for design intent only and should not be used for construction unless stated. This drawing is the property of SPACEMAN

1:25 @ A3

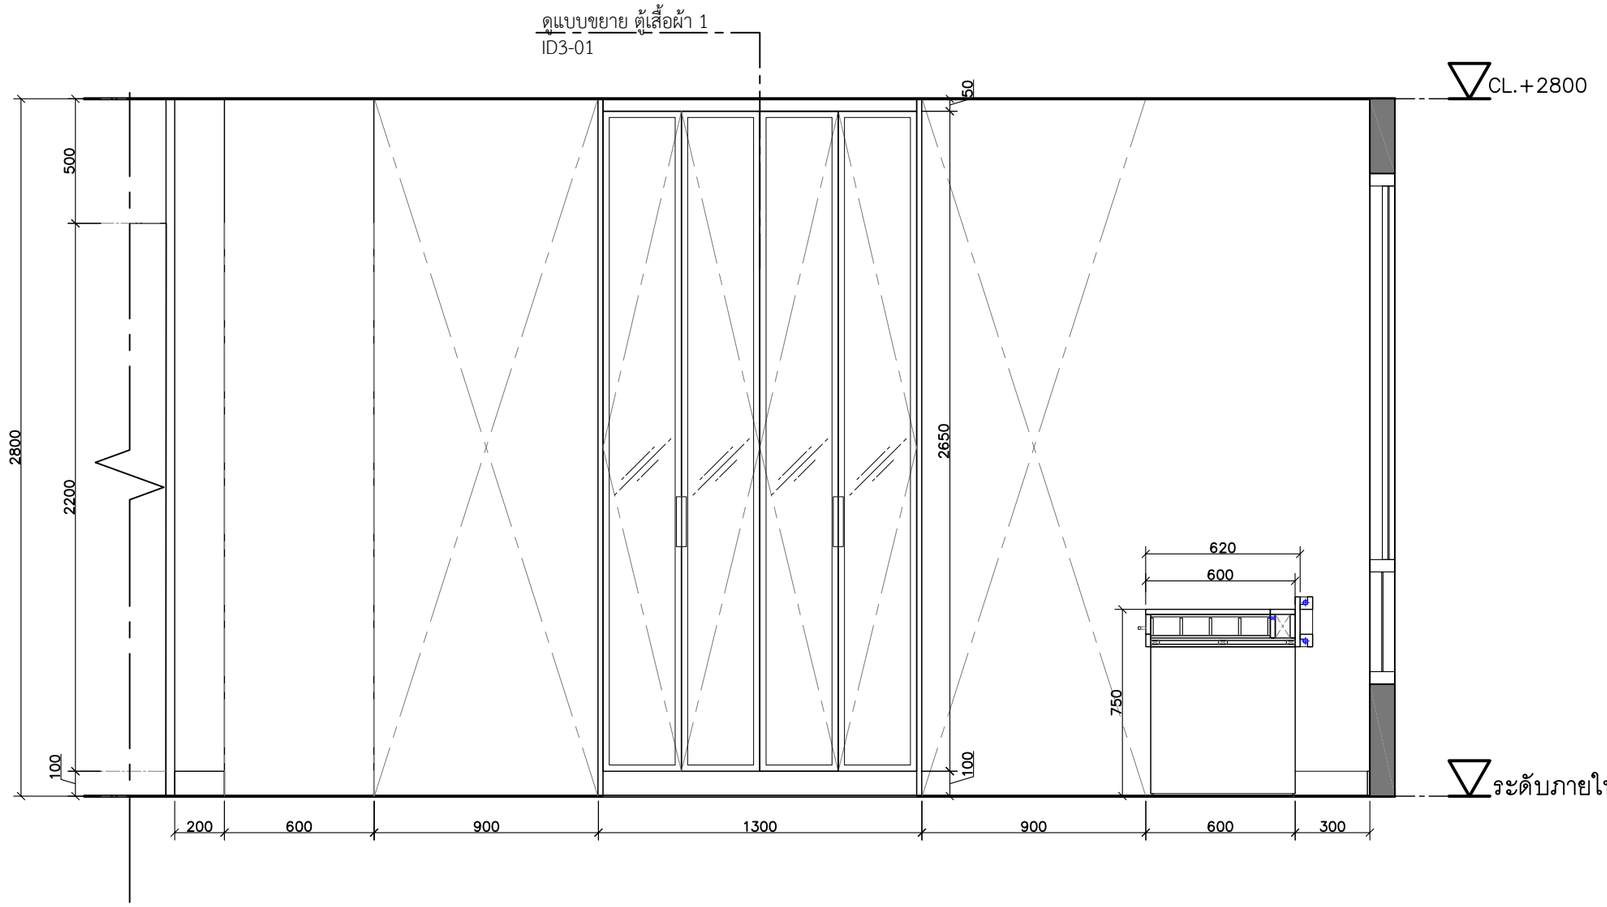

บริเวณ ห้องแต่งตัว
ELEVATION 1

scale 1:25

SPACEMAN	PROJECT: SONIA HOUSE	LOCATION: REIGNWOOD PARK LAMLUKKA, PATHUM THANI	ARCHITECT	INTERIOR DESIGNER: ปรัตถกร ประมุขกุล ภ-สน 1438	STRUCTURAL ENGINEER	TITLE: 2nd FLOOR ELEVATION (แบบขยายบริเวณ ห้องแต่งตัว)	2026-06-18 ID2-01

Note: SPACEMAN takes no responsibility for dimensions obtained by scaling from this drawing. If no dimension is shown the recipient must ascertain the dimension specifically from the architect or by site measurement and may not rely on the drawing. Supply of the drawing in digital form is solely for convenience and no reliance may be placed on any data in digital form. All data must be checked against hard copy. This drawing is issued for design intent only and should not be used for construction unless stated. This drawing is the property of SPACEMAN

1:25 @ A3

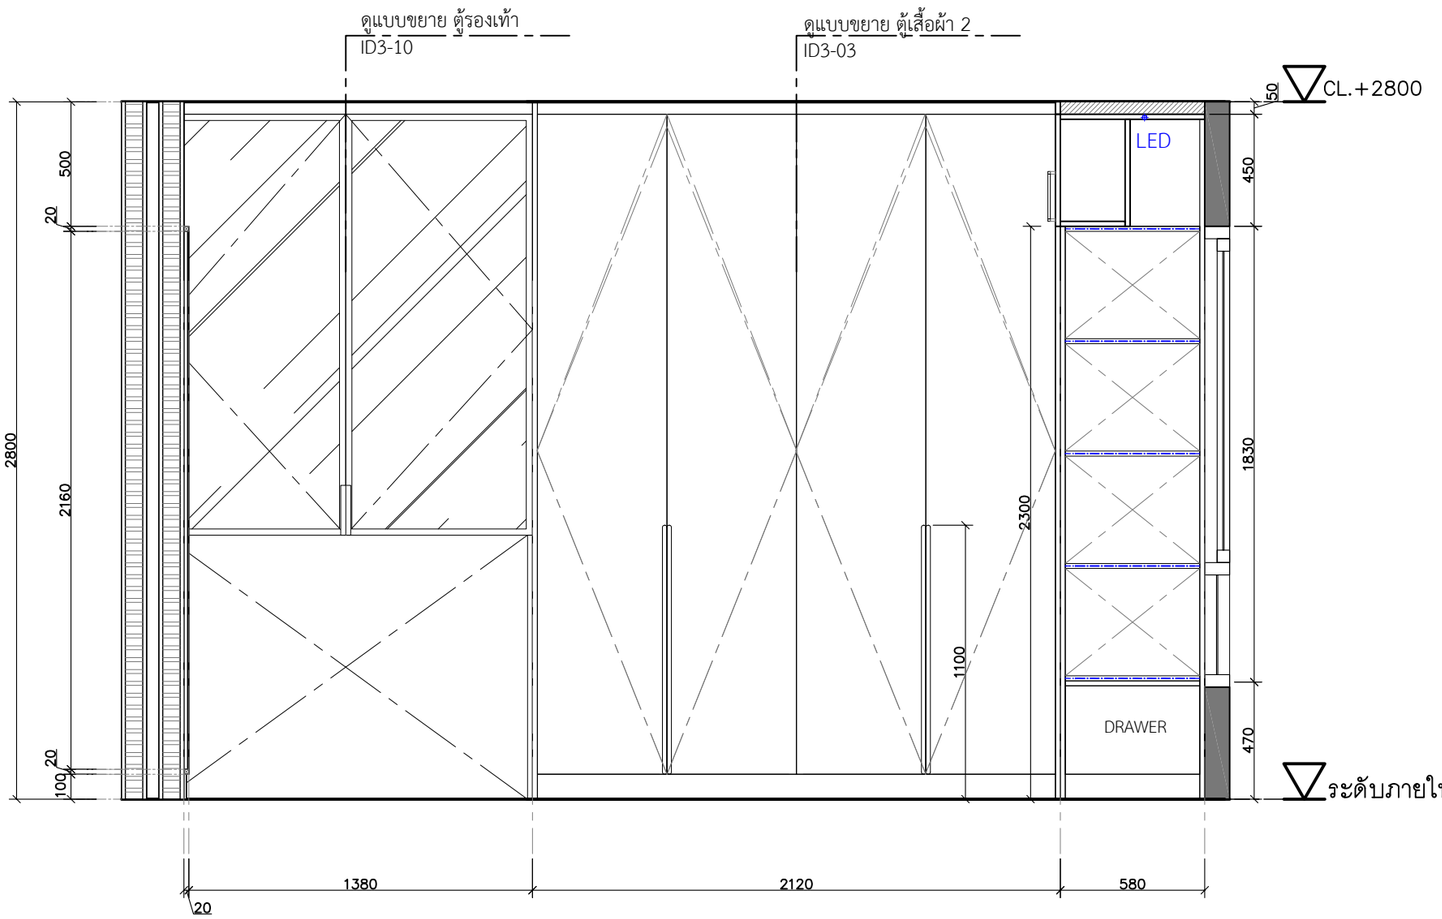

บริเวณ ห้องแต่งตัว
ELEVATION 2

scale 1:25

SPACEMAN

PROJECT | SONIA HOUSE

LOCATION | REIGNWOOD PARK
LAMLUKKA, PATHUM THANI

ARCHITECT |

INTERIOR DESIGNER | ปรัตถกร ประมุขกุล ภ-สน 1438

STRUCTURAL ENGINEER |

TITLE | 2nd FLOOR
ELEVATION
(แบบขยายบริเวณ ห้องแต่งตัว)

2026-06-18
ID2-02

1:25 @ A3

Note: SPACEMAN takes no responsibility for dimensions obtained by scaling from this drawing. If no dimension is shown the recipient must ascertain the dimension specifically from the architect or by site measurement and may not rely on the drawing. Supply of the drawing in digital form is solely for convenience and no reliance may be placed on any data in digital form. All data must be checked against hard copy. This drawing is issued for design intent only and should not be used for construction unless stated. This drawing is the property of SPACEMAN

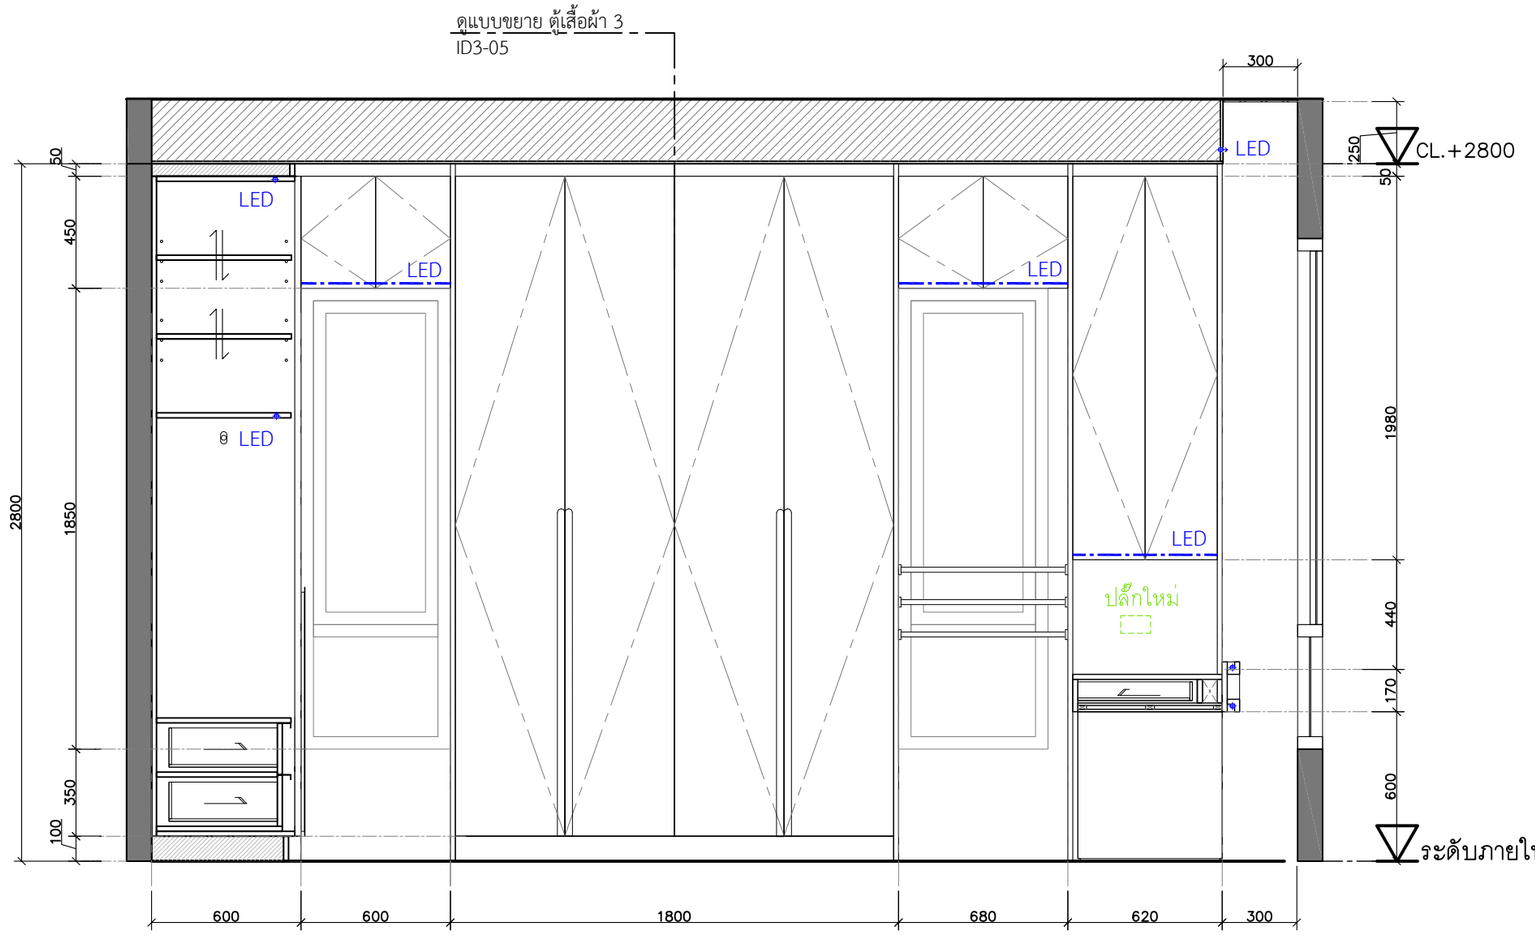

บริเวณ ห้องแต่งตัว
ELEVATION 3

scale 1:25

SPACEMAN

PROJECT | SONIA HOUSE

LOCATION | REIGNWOOD PARK
LAMLUKKA, PATHUM THANI

ARCHITECT |

INTERIOR DESIGNER | ปรัตถกร ประมุขกุล ภ-สน 1438

STRUCTURAL ENGINEER |

TITLE | 2nd FLOOR
ELEVATION
(แบบขยายบริเวณ ห้องแต่งตัว)

2026-06-18
ID2-03

1:25 @ A3

Note: SPACEMAN takes no responsibility for dimensions obtained by scaling from this drawing. If no dimension is shown the recipient must ascertain the dimension specifically from the architect or by site measurement and may not rely on the drawing. Supply of the drawing in digital form is solely for convenience and no reliance may be placed on any data in digital form. All data must be checked against hard copy. This drawing is issued for design intent only and should not be used for construction unless stated. This drawing is the property of SPACEMAN

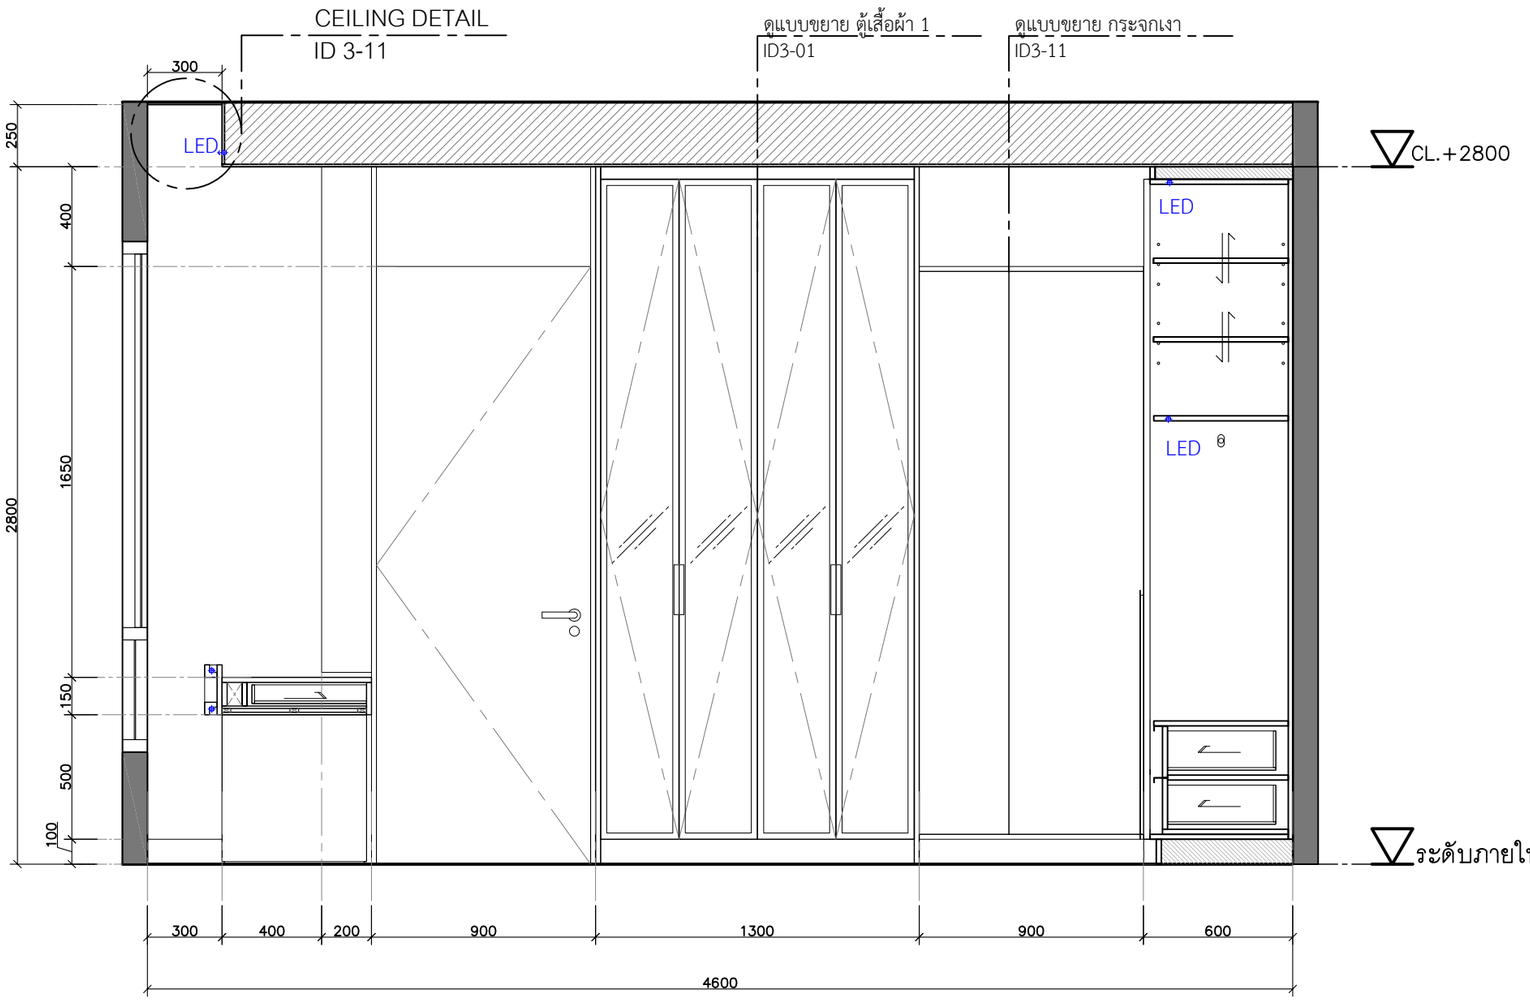

บริเวณ ห้องแต่งตัว
ELEVATION 4

scale 1:25

SPACEMAN

PROJECT | SONIA HOUSE

LOCATION | REIGNWOOD PARK
LAMLUKKA, PATHUM THANI

ARCHITECT |

INTERIOR DESIGNER | ปรัตถกร ประมุขกุล ภ-สน 1438

STRUCTURAL ENGINEER |

TITLE | 2nd FLOOR
ELEVATION
(แบบขยายบริเวณ ห้องแต่งตัว)

2026-06-18
ID2-04

1:25 @ A3

Note: SPACEMAN takes no responsibility for dimensions obtained by scaling from this drawing. If no dimension is shown the recipient must ascertain the dimension specifically from the architect or by site measurement and may not rely on the drawing. Supply of the drawing in digital form is solely for convenience and no reliance may be placed on any data in digital form. All data must be checked against hard copy. This drawing is issued for design intent only and should not be used for construction unless stated. This drawing is the property of SPACEMAN

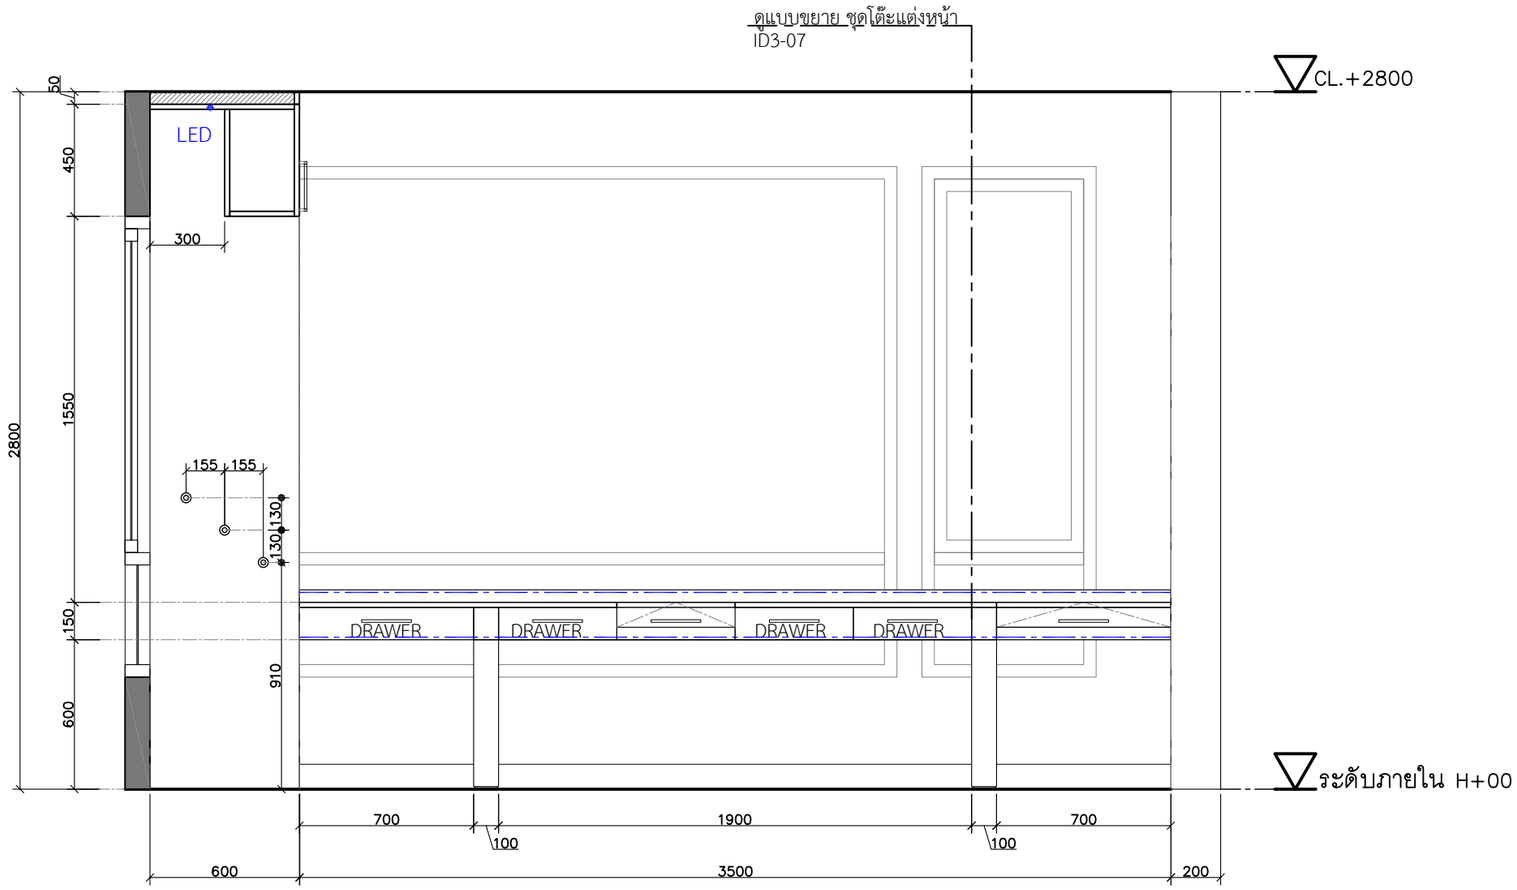

บริเวณ ห้องแต่งตัว
ELEVATION 5

scale 1:25

SPACEMAN

PROJECT | SONIA HOUSE

LOCATION | REIGNWOOD PARK
LAMLUKKA, PATHUM THANI

ARCHITECT |

INTERIOR DESIGNER | ปรัตถกร ประมุขกุล ภ-สน 1438

STRUCTURAL ENGINEER |

TITLE | 2nd FLOOR
ELEVATION
(แบบขยายบริเวณ ห้องแต่งตัว)

2026-06-18
ID2-05
1:25 @ A3

Note: SPACEMAN takes no responsibility for dimensions obtained by scaling from this drawing. If no dimension is shown the recipient must ascertain the dimension specifically from the architect or by site measurement and may not rely on the drawing. Supply of the drawing in digital form is solely for convenience and no reliance may be placed on any data in digital form. All data must be checked against hard copy. This drawing is issued for design intent only and should not be used for construction unless stated. This drawing is the property of SPACEMAN

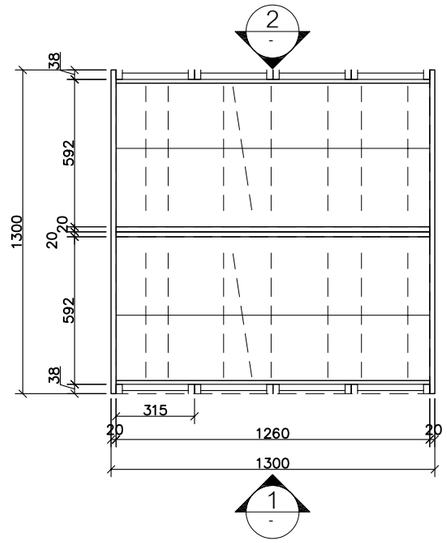

แบบขยาย ตู้เสื้อผ้า 1
บริเวณโซนห้องแต่งตัว
PLAN

scale 1:25

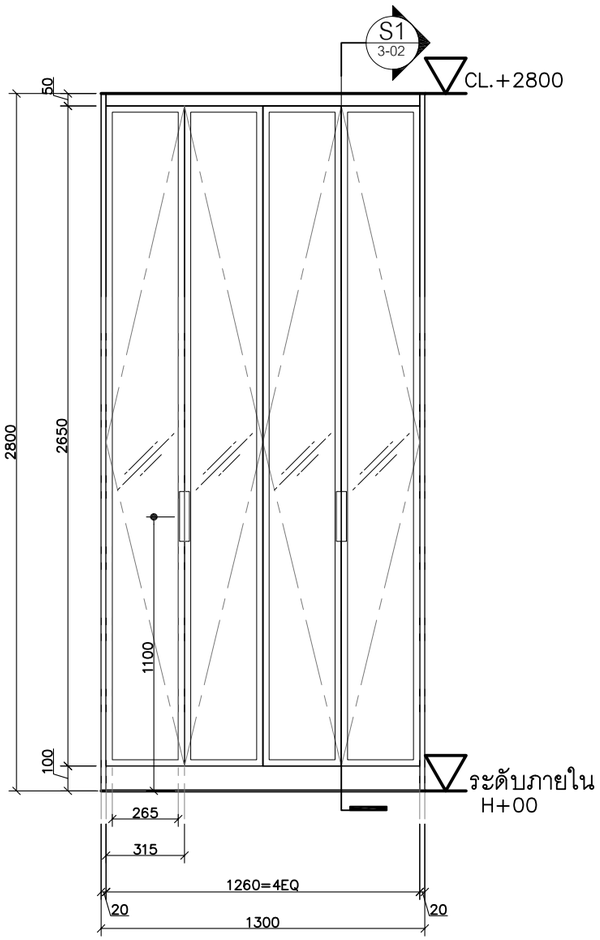

แบบขยาย ตู้เสื้อผ้า 1
บริเวณโซนห้องแต่งตัว
ELEVATION 1

scale 1:25

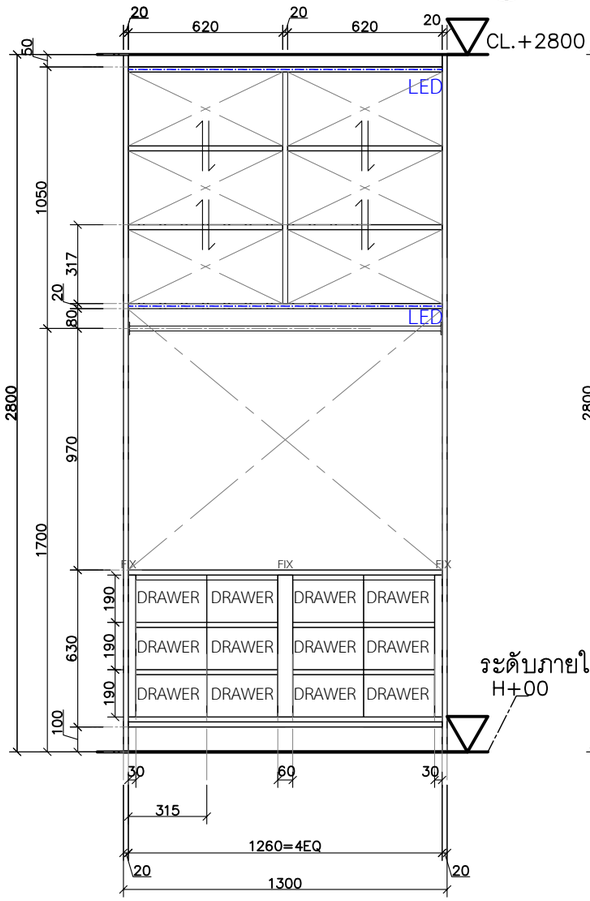

แบบขยาย ตู้เสื้อผ้า 1 (ภายใน)
บริเวณโซนห้องแต่งตัว
ELEVATION 1

scale 1:25

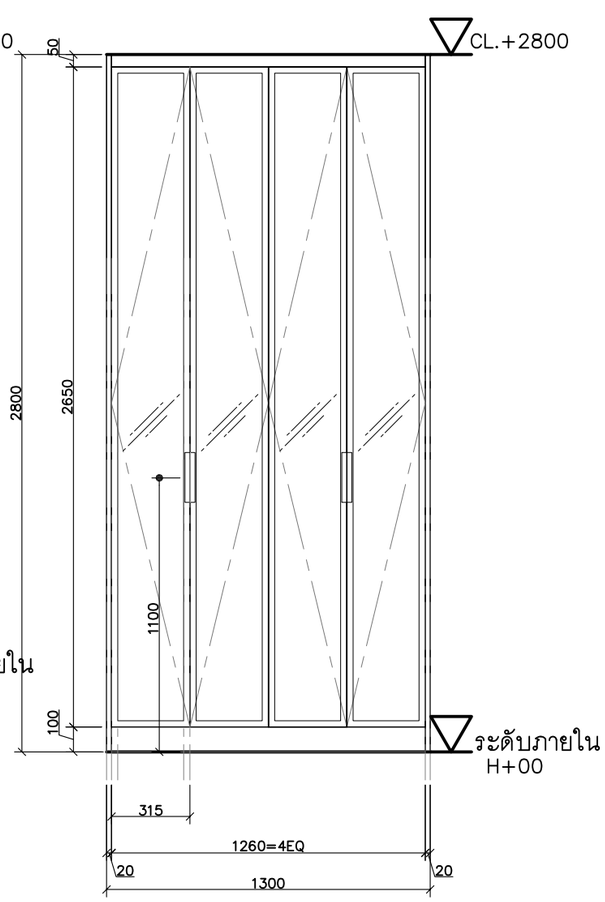

แบบขยาย ตู้เสื้อผ้า 1
บริเวณโซนห้องแต่งตัว
ELEVATION 2

scale 1:25

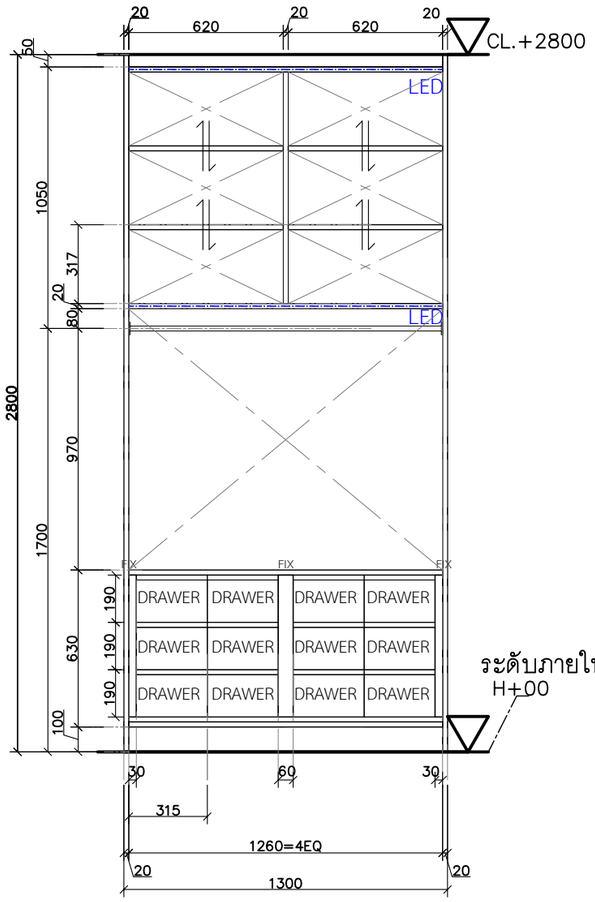

แบบขยาย ตู้เสื้อผ้า 1 (ภายใน)
บริเวณโซนห้องแต่งตัว
ELEVATION 2

scale 1:25

SPACEMAN

PROJECT | SONIA HOUSE

LOCATION | REIGNWOOD PARK
LAMLUKKA, PATHUM THANI

ARCHITECT |

INTERIOR DESIGNER | ปรัตถกร ประมุขกุล ภ-สน 1438

STRUCTURAL ENGINEER |

TITLE | 2nd FLOOR
แบบขยาย ตู้เสื้อผ้า 1
ELEVATION

2026-06-18
ID3-01
1:25 @ A3

Note: SPACEMAN takes no responsibility for dimensions obtained by scaling from this drawing. If no dimension is shown the recipient must ascertain the dimension specifically from the architect or by site measurement and may not rely on the drawing. Supply of the drawing in digital form is solely for convenience and no reliance may be placed on any data in digital form. All data must be checked against hard copy. This drawing is issued for design intent only and should not be used for construction unless stated. This drawing is the property of SPACEMAN

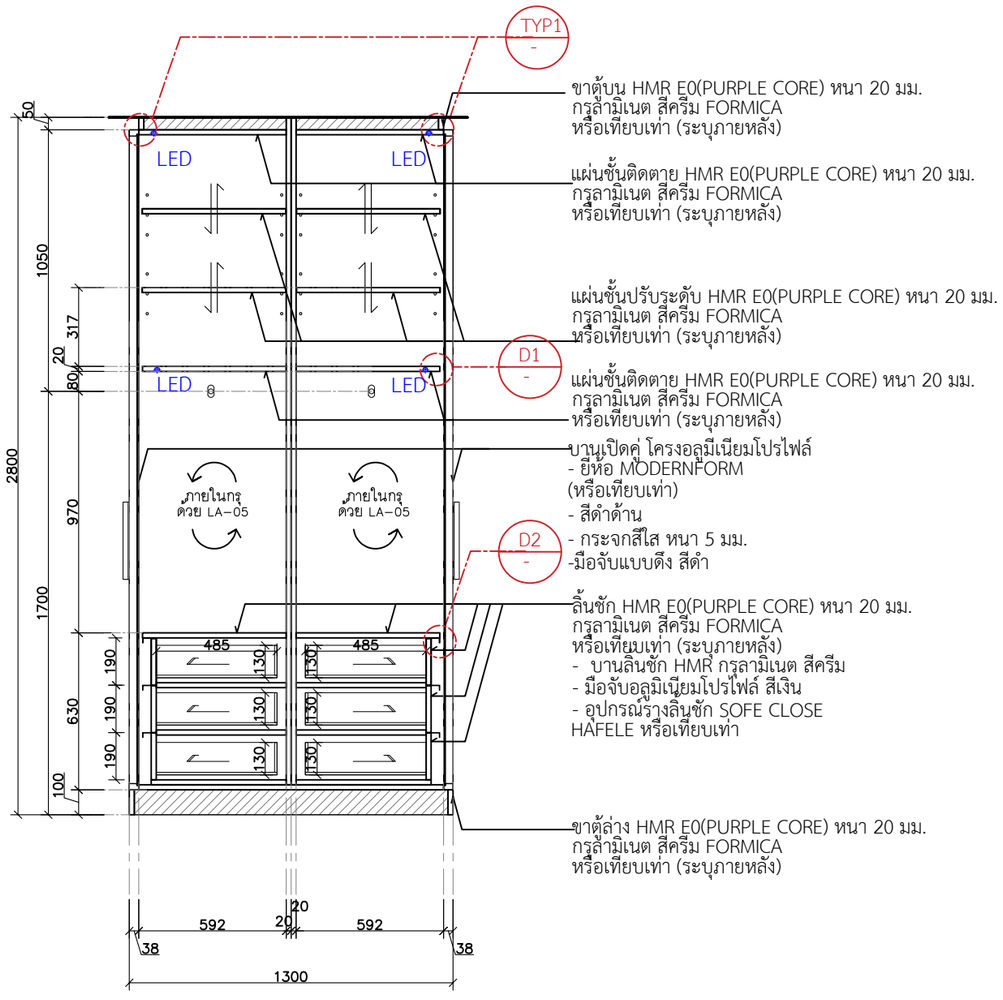

แบบขยาย ตู้เสื้อผ้า 1
บริเวณโซนห้องแต่งตัว
SECTION 1

scale 1:25

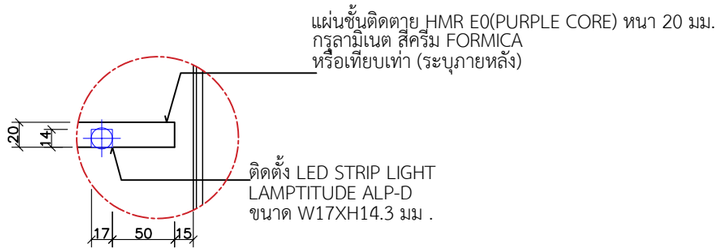

DETAIL 1

scale 1:5

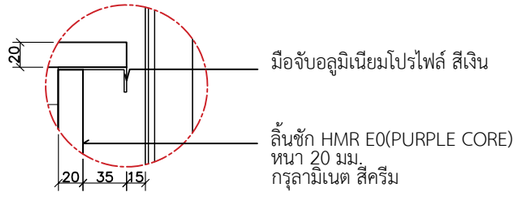

DETAIL 2

scale 1:5

SPACEMAN

PROJECT: SONIA HOUSE

LOCATION: REIGNWOOD PARK
LAMLUKKA, PATHUM THANI

ARCHITECT:

INTERIOR DESIGNER: ปรัตถกร ประมุขกุล ภ-สน 1438

STRUCTURAL ENGINEER:

TITLE: 2nd FLOOR
แบบขยาย ตู้เสื้อผ้า 1
ELEVATION

2026-06-18
ID3-02

1:25 @ A3

Note: SPACEMAN takes no responsibility for dimensions obtained by scaling from this drawing. If no dimension is shown the recipient must ascertain the dimension specifically from the architect or by site measurement and may not rely on the drawing. Supply of the drawing in digital form is solely for convenience and no reliance may be placed on any data in digital form. All data must be checked against hard copy. This drawing is issued for design intent only and should not be used for construction unless stated. This drawing is the property of SPACEMAN

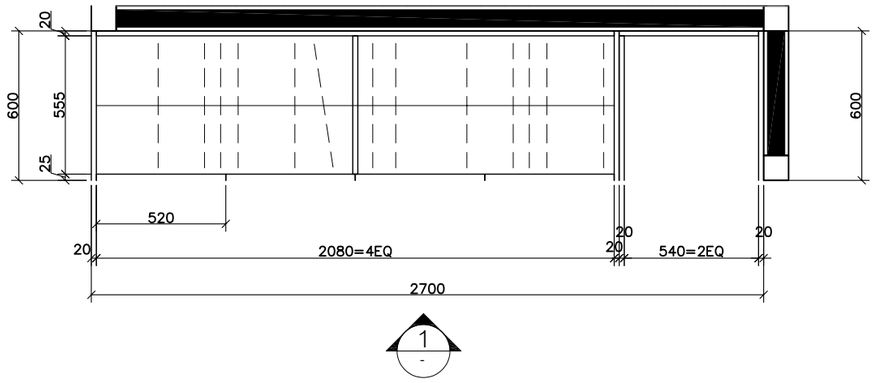

แบบขยาย ตู้เสื้อผ้า 2
บริเวณโซนห้องแต่งตัว
PLAN

scale 1:25

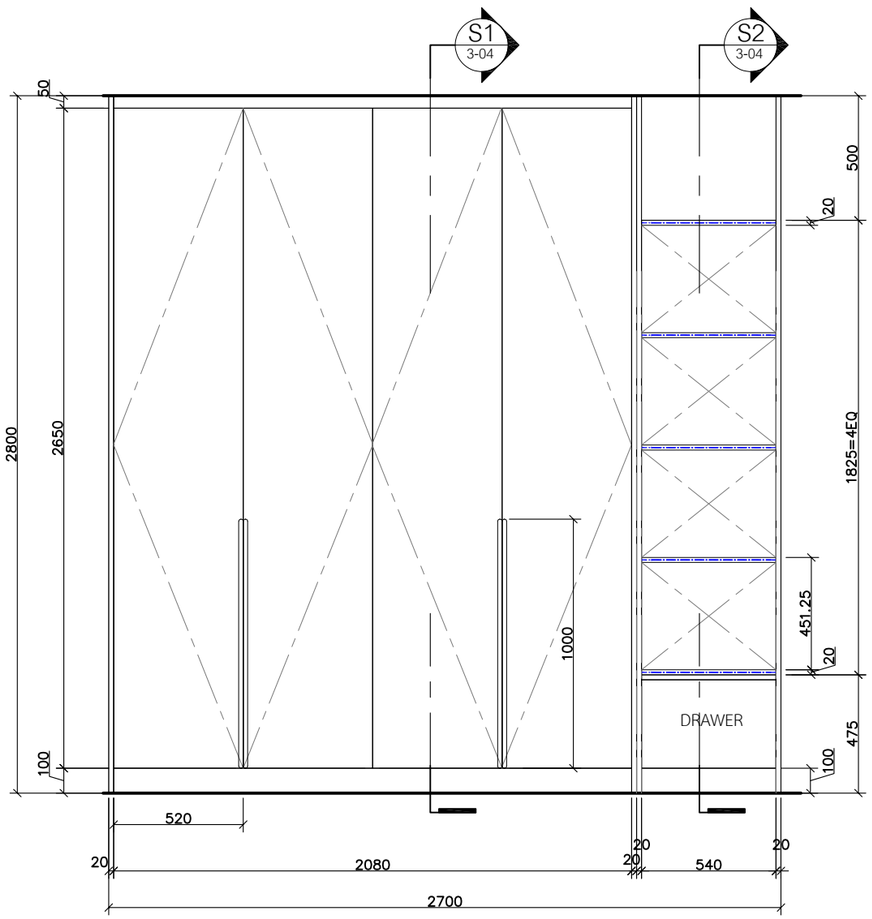

แบบขยาย ตู้เสื้อผ้า 2
บริเวณโซนห้องแต่งตัว
ELEVATION 1

scale 1:25

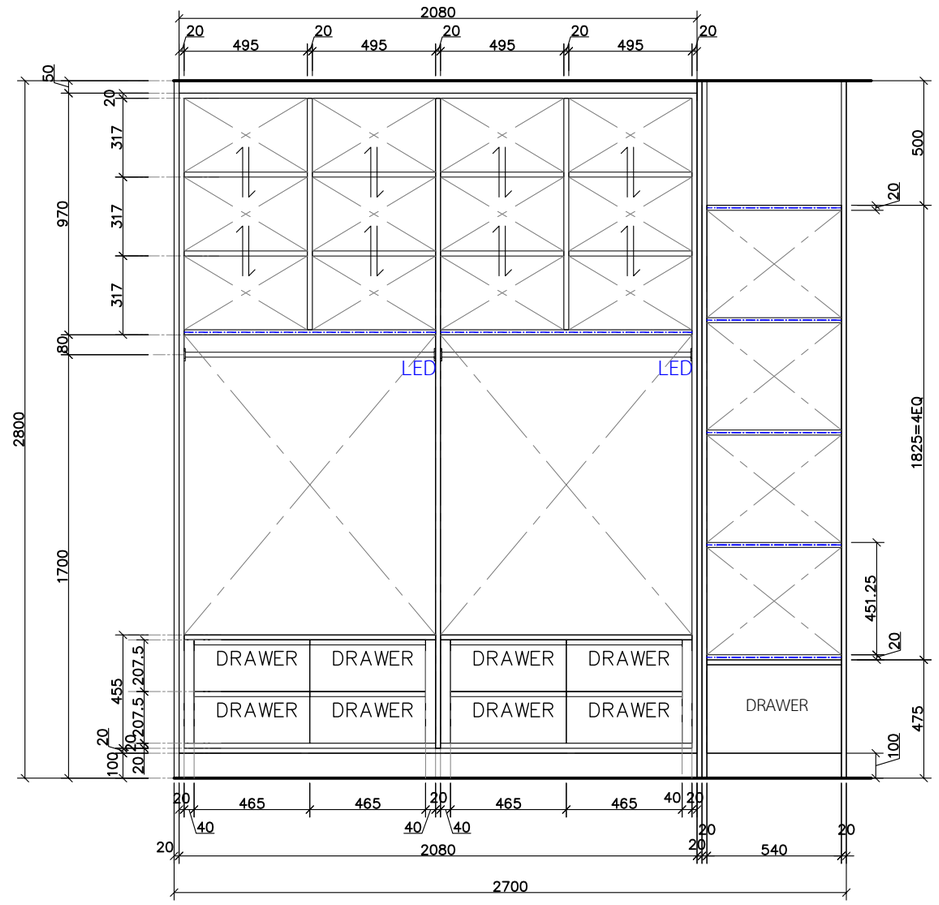

แบบขยาย ตู้เสื้อผ้า 2 (ภายใน)
บริเวณโซนห้องแต่งตัว
ELEVATION 1

scale 1:25

SPACEMAN

PROJECT SONIA HOUSE

LOCATION REIGNWOOD PARK
LAMLUKKA, PATHUM THANI

ARCHITECT

INTERIOR DESIGNER ปรัตถกร ประมุขกุล ภ-สน 1438

STRUCTURAL ENGINEER

TITLE 2nd FLOOR
แบบขยาย ตู้เสื้อผ้า 2
ELEVATION

2026-06-18
ID3-03

1:25 @ A3

Note: SPACEMAN takes no responsibility for dimensions obtained by scaling from this drawing. If no dimension is shown the recipient must ascertain the dimension specifically from the architect or by site measurement and may not rely on the drawing. Supply of the drawing in digital form is solely for convenience and no reliance may be placed on any data in digital form. All data must be checked against hard copy. This drawing is issued for design intent only and should not be used for construction unless stated. This drawing is the property of SPACEMAN

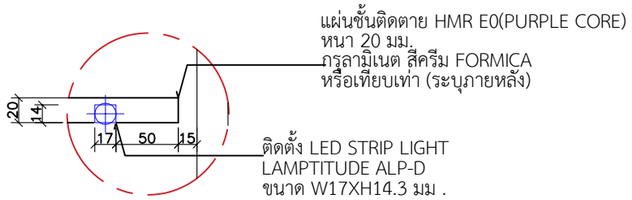

DETAIL 1

scale 1:5

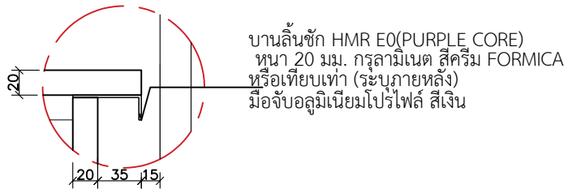

DETAIL 2

scale 1:5

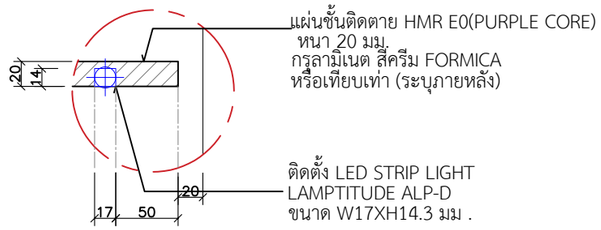

DETAIL 3

scale 1:5

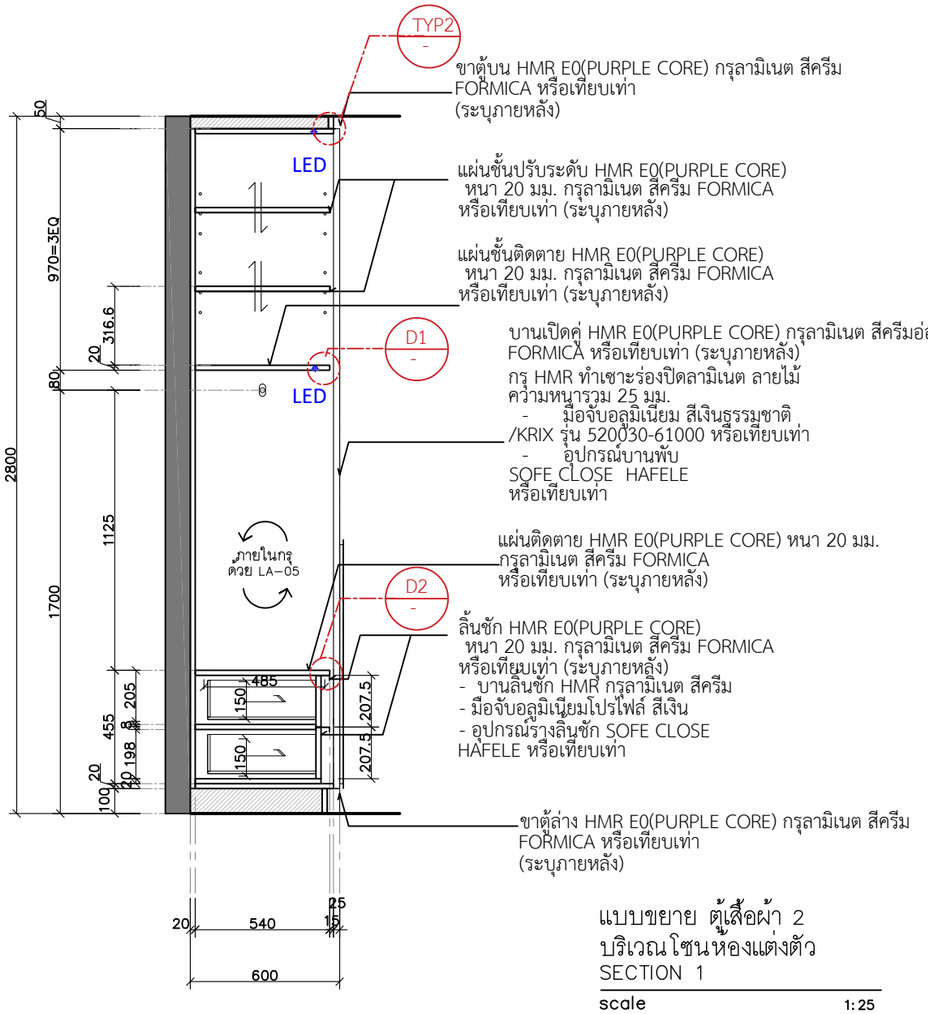

แบบขยาย ตู้เสื้อผ้า 2
บริเวณโซนห้องแต่งตัว
SECTION 1

scale 1:25

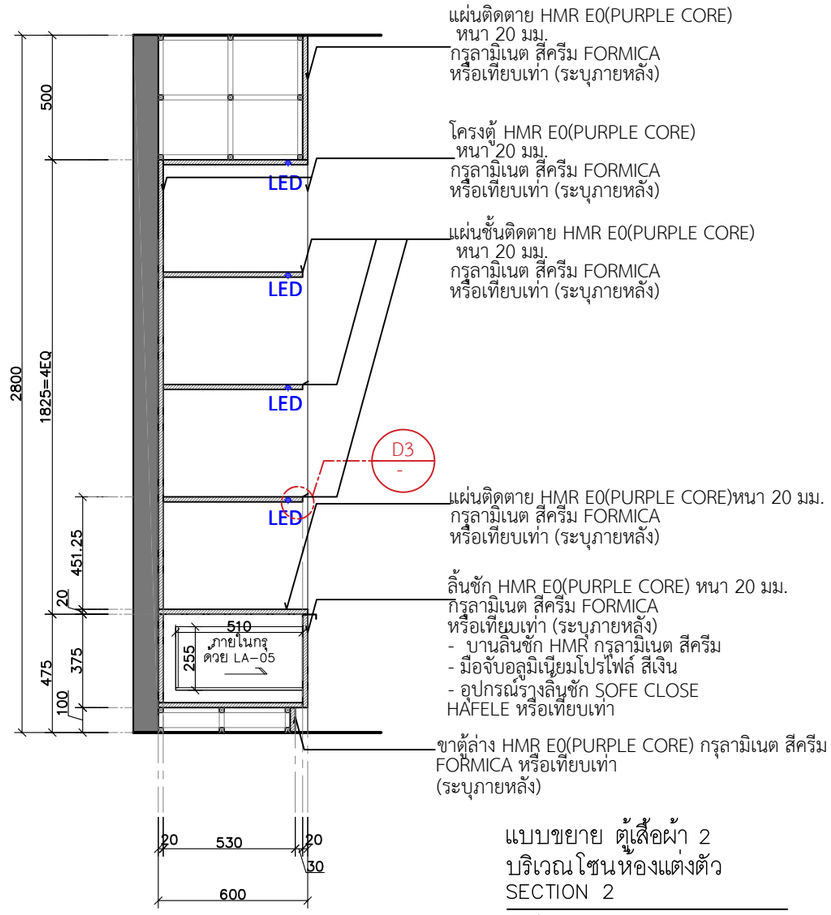

แบบขยาย ตู้เสื้อผ้า 2
บริเวณโซนห้องแต่งตัว
SECTION 2

scale 1:25

SPACEMAN

PROJECT SONIA HOUSE

LOCATION REIGNWOOD PARK
LAMLUKKA, PATHUM THANI

ARCHITECT

INTERIOR DESIGNER ปรัตถกร ประมุขกุล ภ-ส น 1438

STRUCTURAL ENGINEER

TITLE 2nd FLOOR
แบบขยาย ตู้เสื้อผ้า 2
SECTION

2026-06-18
ID3-04
1:25 @ A3

Note: SPACEMAN takes no responsibility for dimensions obtained by scaling from this drawing. If no dimension is shown the recipient must ascertain the dimension specifically from the architect or by site measurement and may not rely on the drawing. Supply of the drawing in digital form is solely for convenience and no reliance may be placed on any data in digital form. All data must be checked against hard copy. This drawing is issued for design intent only and should not be used for construction unless stated. This drawing is the property of SPACEMAN

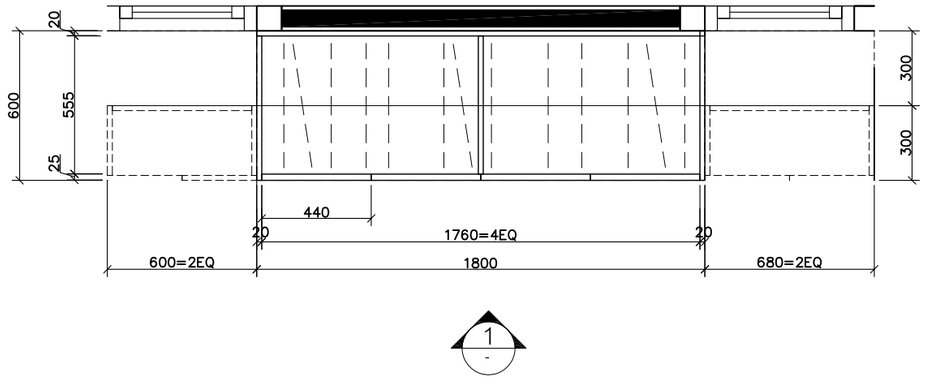

1
-

แบบขยาย ตู้เสื้อผ้า 3
บริเวณโซนห้องแต่งตัว
PLAN

scale 1:25

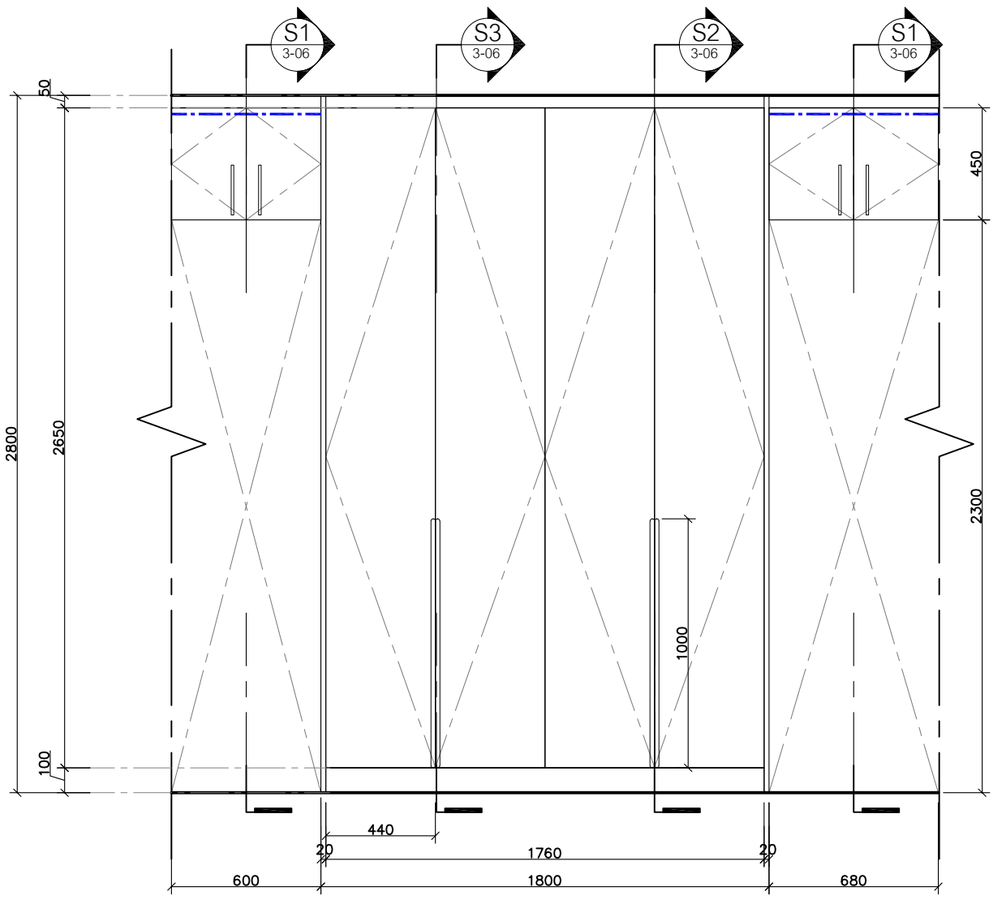

แบบขยาย ตู้เสื้อผ้า 3
บริเวณโซนห้องแต่งตัว
ELEVATION 1

scale 1:25

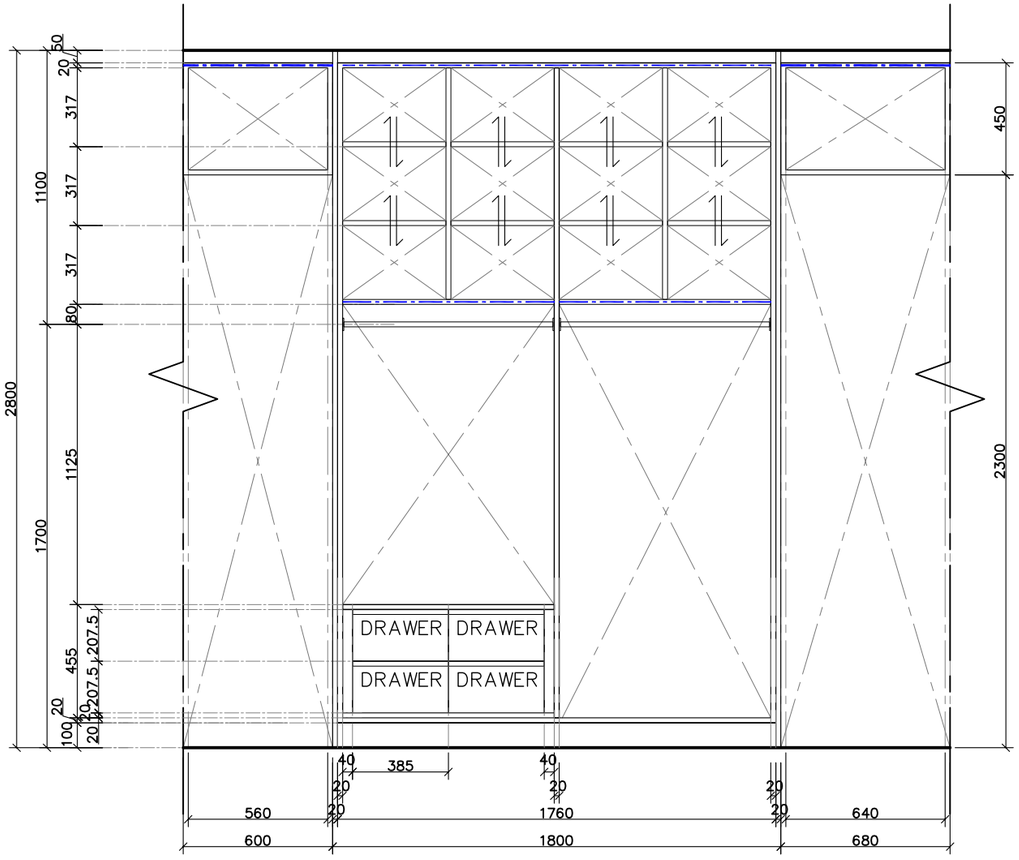

แบบขยาย ตู้เสื้อผ้า 3 (ภายใน)
บริเวณโซนห้องแต่งตัว
ELEVATION 1

scale 1:25

SPACEMAN

PROJECT: SONIA HOUSE

LOCATION: REIGNWOOD PARK
LAMLUKKA, PATHUM THANI

ARCHITECT:

INTERIOR DESIGNER: ปรัตถกร ประมุขกุล ภ-สน 1438

STRUCTURAL ENGINEER:

TITLE: 2nd FLOOR
แบบขยาย ตู้เสื้อผ้า 3
ELEVATION

2026-06-18
ID3-05

1:25 @ A3

Note: SPACEMAN takes no responsibility for dimensions obtained by scaling from this drawing. If no dimension is shown the recipient must ascertain the dimension specifically from the architect or by site measurement and may not rely on the drawing. Supply of the drawing in digital form is solely for convenience and no reliance may be placed on any data in digital form. All data must be checked against hard copy. This drawing is issued for design intent only and should not be used for construction unless stated. This drawing is the property of SPACEMAN

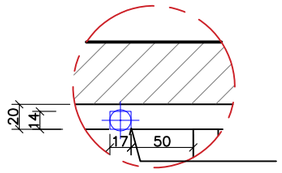

ติดตั้ง LED STRIP LIGHT
LAMPTITUDE ALP-D
ขนาด W17XH14.3 มม .

DETAIL 1
scale 1:5

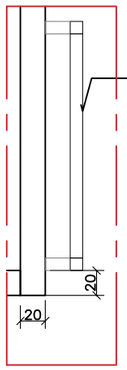

บานเปิดคู่ HMR E0(PURPLE CORE)
หนา 20 มม. กรุลามิเนต สีครีม
FORMICA หรือเทียบเท่า (ระบุภายหลัง)
มือจับแบบดึง สีเงิน
HAFELE 481.21.021 SV-MT
หรือเทียบเท่า

DETAIL 2
scale 1:5

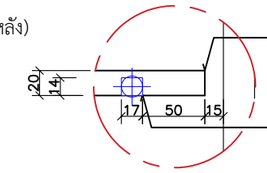

แผ่นชั้นติดตาย HMR E0(PURPLE CORE)
หนา 20 มม.
กรุลามิเนต สีครีม FORMICA
หรือเทียบเท่า (ระบุภายหลัง)

ติดตั้ง LED STRIP LIGHT
LAMPTITUDE ALP-D
ขนาด W17XH14.3 มม .

DETAIL 3
scale 1:5

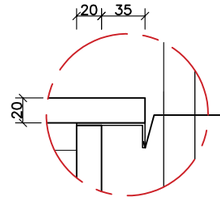

บานลิ้นชัก HMR E0(PURPLE CORE)
หนา 20 มม.
กรุลามิเนต สีครีม FORMICA
หรือเทียบเท่า (ระบุภายหลัง)
มือจับอลูมิเนียมโปรไฟล์ สีเงิน

DETAIL 4
scale 1:5

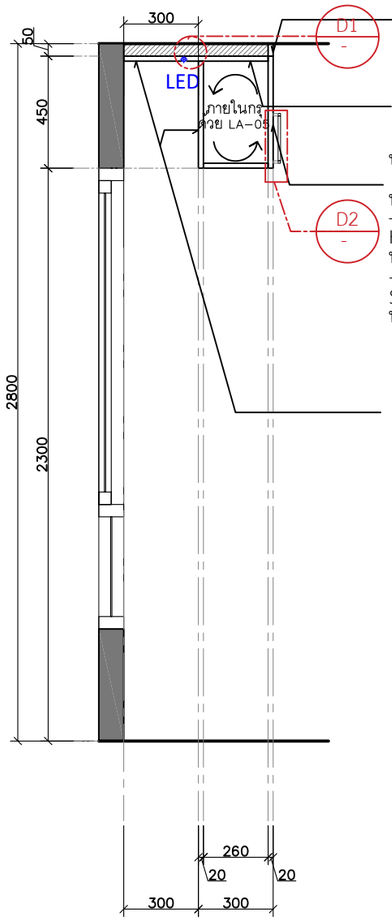

ขาตู้บน HMR E0(PURPLE CORE)
หน้า 20 มม. กรุลามิเนต สีครีม FORMICA
หรือเทียบเท่า (ระบุภายหลัง)

โครงตู้ HMR E0(PURPLE CORE)
หนา 20 มม. กรุลามิเนต สีครีม FORMICA
หรือเทียบเท่า (ระบุภายหลัง)

บานเปิดคู่ HMR E0(PURPLE CORE)
หนา 20 มม. กรุลามิเนต สีครีม FORMICA
หรือเทียบเท่า (ระบุภายหลัง)
- มือจับแบบดึง สีเงิน
HAFELE 481.21.021 SV-MT
หรือเทียบเท่า
- อุปกรณ์บานพับ
SOFE CLOSE HAFELE
หรือเทียบเท่า

แผ่นติดตาย HMR E0(PURPLE CORE)
หนา 20 มม. กรุลามิเนต สีครีม FORMICA
หรือเทียบเท่า (ระบุภายหลัง)

แบบขยาย ตู้เสื้อผ้า 3
บริเวณโซนห้องแต่งตัว
SECTION 1
scale 1:25

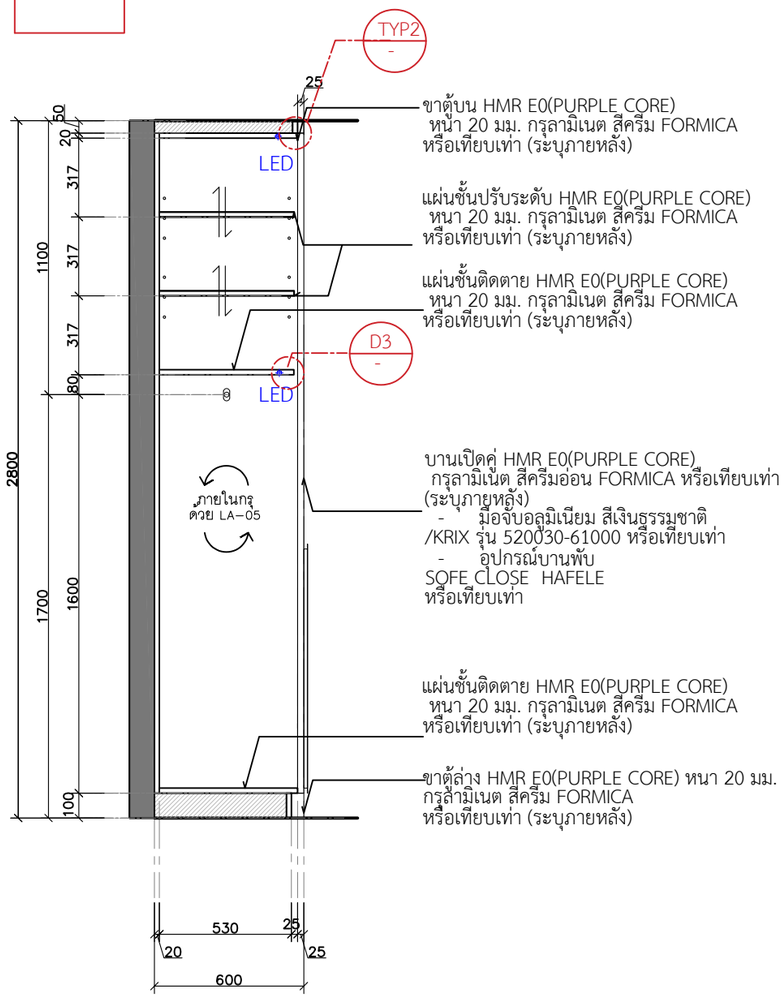

ขาตู้บน HMR E0(PURPLE CORE)
หน้า 20 มม. กรุลามิเนต สีครีม FORMICA
หรือเทียบเท่า (ระบุภายหลัง)

แผ่นชั้นปรับระดับ HMR E0(PURPLE CORE)
หนา 20 มม. กรุลามิเนต สีครีม FORMICA
หรือเทียบเท่า (ระบุภายหลัง)

แผ่นชั้นติดตาย HMR E0(PURPLE CORE)
หนา 20 มม. กรุลามิเนต สีครีม FORMICA
หรือเทียบเท่า (ระบุภายหลัง)

บานเปิดคู่ HMR E0(PURPLE CORE)
กรุลามิเนต สีครีมอ่อน FORMICA หรือเทียบเท่า
(ระบุภายหลัง)
- มือจับอลูมิเนียม สีเงินธรรมชาติ
/KRIX รุ่น 520030-61000 หรือเทียบเท่า
- อุปกรณ์บานพับ
SOFE CLOSE HAFELE
หรือเทียบเท่า

แผ่นชั้นติดตาย HMR E0(PURPLE CORE)
หนา 20 มม. กรุลามิเนต สีครีม FORMICA
หรือเทียบเท่า (ระบุภายหลัง)

ขาตู้ล่าง HMR E0(PURPLE CORE) หนา 20 มม.
กรุลามิเนต สีครีม FORMICA
หรือเทียบเท่า (ระบุภายหลัง)

แบบขยาย ตู้เสื้อผ้า 3
บริเวณโซนห้องแต่งตัว
SECTION 2
scale 1:25

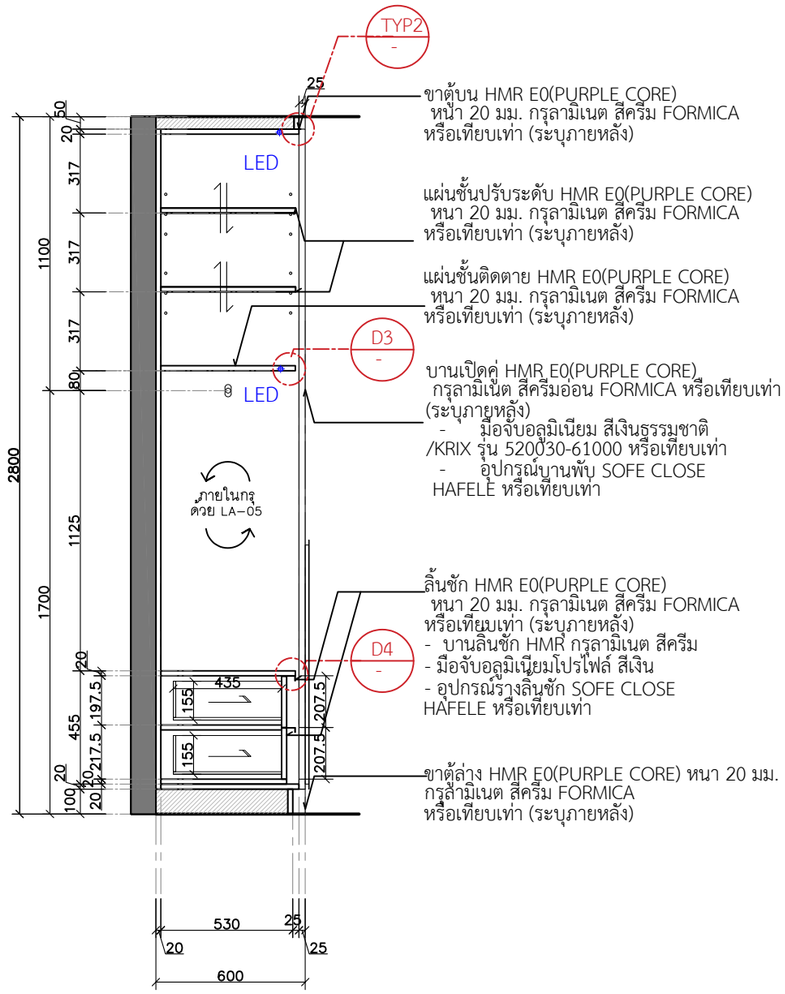

ขาตู้บน HMR E0(PURPLE CORE)
หน้า 20 มม. กรุลามิเนต สีครีม FORMICA
หรือเทียบเท่า (ระบุภายหลัง)

แผ่นชั้นปรับระดับ HMR E0(PURPLE CORE)
หนา 20 มม. กรุลามิเนต สีครีม FORMICA
หรือเทียบเท่า (ระบุภายหลัง)

แผ่นชั้นติดตาย HMR E0(PURPLE CORE)
หนา 20 มม. กรุลามิเนต สีครีม FORMICA
หรือเทียบเท่า (ระบุภายหลัง)

บานเปิดคู่ HMR E0(PURPLE CORE)
กรุลามิเนต สีครีมอ่อน FORMICA หรือเทียบเท่า
(ระบุภายหลัง)
- มือจับอลูมิเนียม สีเงินธรรมชาติ
/KRIX รุ่น 520030-61000 หรือเทียบเท่า
- อุปกรณ์บานพับ SOFE CLOSE
HAFELE หรือเทียบเท่า

ลิ้นชัก HMR E0(PURPLE CORE)
หนา 20 มม. กรุลามิเนต สีครีม FORMICA
หรือเทียบเท่า (ระบุภายหลัง)
- บานลิ้นชัก HMR กรุลามิเนต สีครีม
- มือจับอลูมิเนียมโปรไฟล์ สีเงิน
- อุปกรณ์รางลิ้นชัก SOFE CLOSE
HAFELE หรือเทียบเท่า

ขาตู้ล่าง HMR E0(PURPLE CORE) หนา 20 มม.
กรุลามิเนต สีครีม FORMICA
หรือเทียบเท่า (ระบุภายหลัง)

แบบขยาย ตู้เสื้อผ้า 3
บริเวณโซนห้องแต่งตัว
SECTION 3
scale 1:25

SPACEMAN

PROJECT: SONIA HOUSE

LOCATION: REIGNWOOD PARK
LAMLUKKA, PATHUM THANI

ARCHITECT:

INTERIOR DESIGNER: ปรัตถกร ประมุขกุล ภ-สน 1438

STRUCTURAL ENGINEER:

TITLE: 2nd FLOOR
แบบขยาย ตู้เสื้อผ้า 3
ELEVATION

2026-06-18
ID3-06
1:25 @ A3

Note: SPACEMAN takes no responsibility for dimensions obtained by scaling from this drawing. If no dimension is shown the recipient must ascertain the dimension specifically from the architect or by site measurement and may not rely on the drawing. Supply of the drawing in digital form is solely for convenience and no reliance may be placed on any data in digital form. All data must be checked against hard copy. This drawing is issued for design intent only and should not be used for construction unless stated. This drawing is the property of SPACEMAN

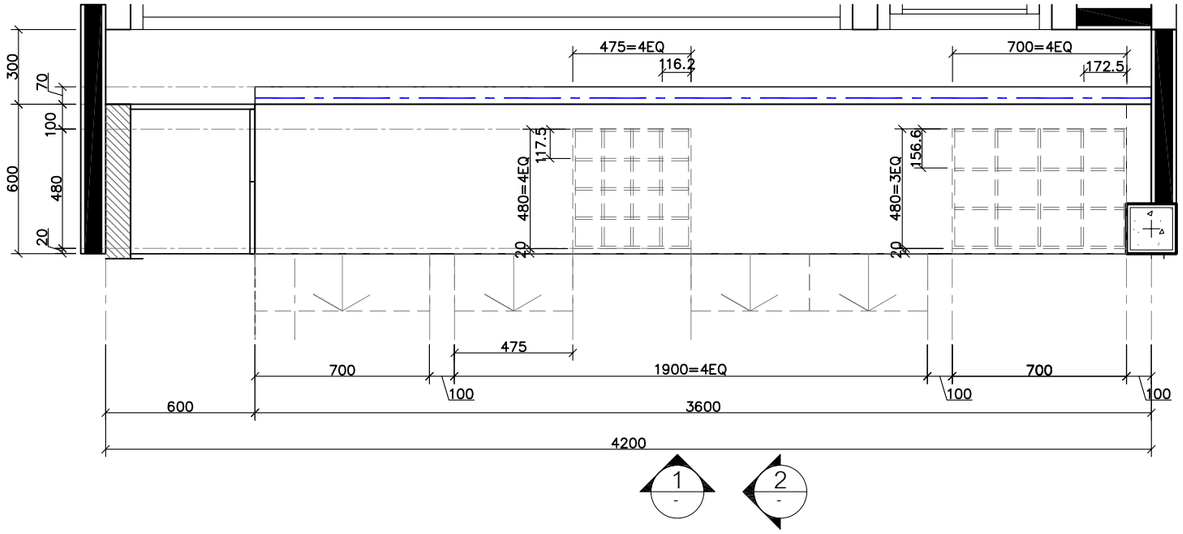

แบบขยาย โต๊ะแต่งหน้า
บริเวณโซนห้องแต่งตัว
PLAN

scale 1:25

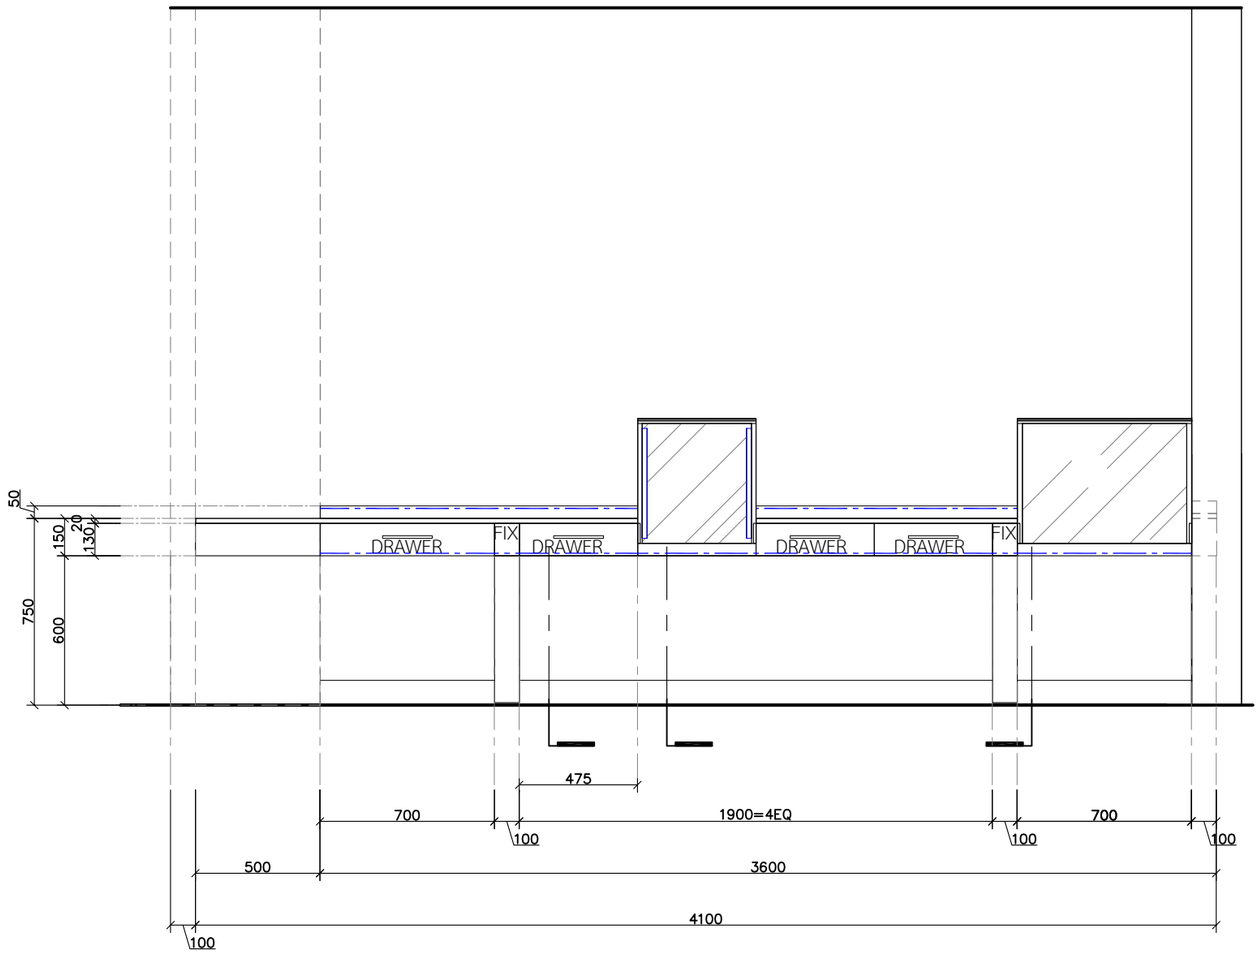

แบบขยาย โต๊ะแต่งหน้า
บริเวณโซนห้องแต่งตัว
ELEVATION 1

scale 1:25

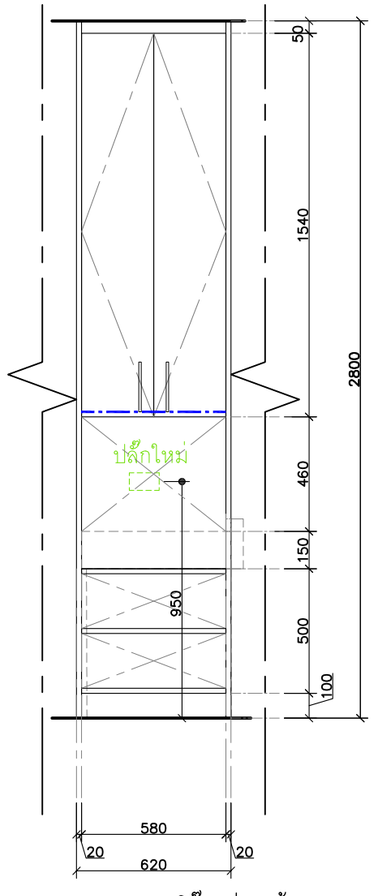

แบบขยาย โต๊ะแต่งหน้า
บริเวณโซนห้องแต่งตัว
ELEVATION 2

scale 1:25

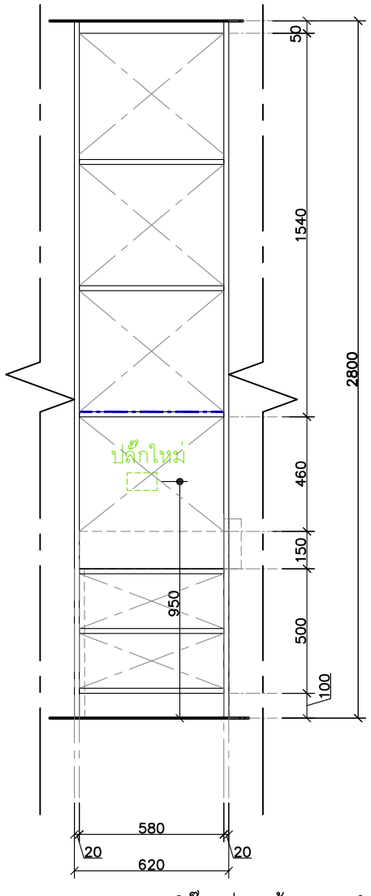

แบบขยาย โต๊ะแต่งหน้า (ภายใน)
บริเวณโซนห้องแต่งตัว
ELEVATION 2

scale 1:25

SPACEMAN

PROJECT: SONIA HOUSE

LOCATION: REIGNWOOD PARK
LAMLUKKA, PATHUM THANI

ARCHITECT:

INTERIOR DESIGNER: ปรัตถกร ประมุขกุล ภ-สน 1438

STRUCTURAL ENGINEER:

TITLE: 2nd FLOOR
แบบขยาย โต๊ะแต่งหน้า
PLAN ,ELEVATION

2026-06-18
ID3-07
1:25 @ A3

Note: SPACEMAN takes no responsibility for dimensions obtained by scaling from this drawing. If no dimension is shown the recipient must ascertain the dimension specifically from the architect or by site measurement and may not rely on the drawing. Supply of the drawing in digital form is solely for convenience and no reliance may be placed on any data in digital form. All data must be checked against hard copy. This drawing is issued for design intent only and should not be used for construction unless stated. This drawing is the property of SPACEMAN

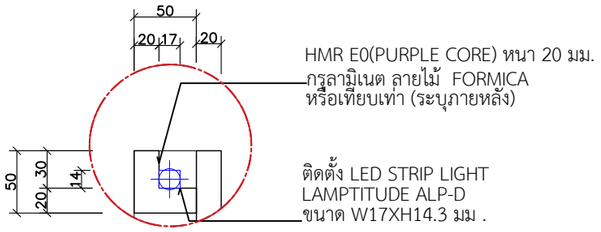

DETAIL 1

scale 1:5

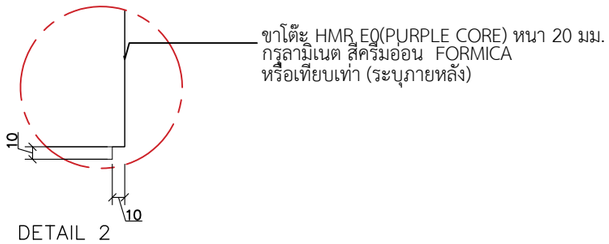

DETAIL 2

scale 1:5

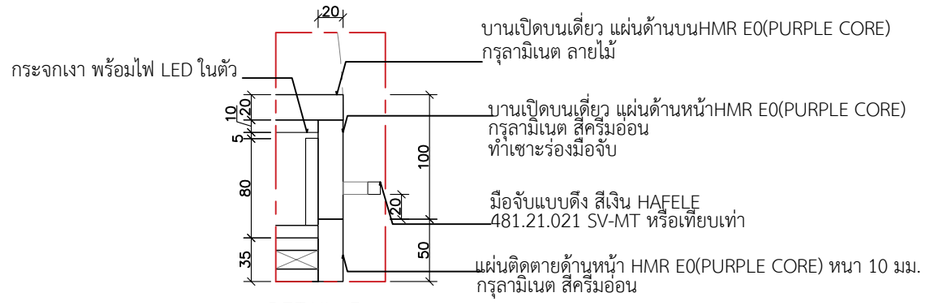

DETAIL 3

scale 1:5

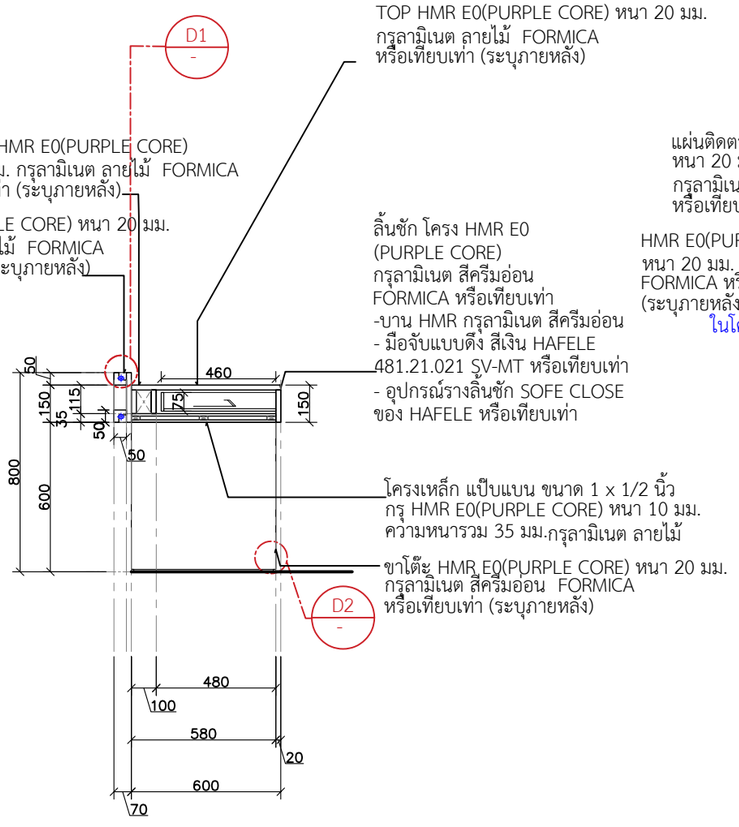

แบบขยาย โต๊ะแต่งหน้า
บริเวณโซนห้องแต่งตัว
SECTION 1

scale 1:25

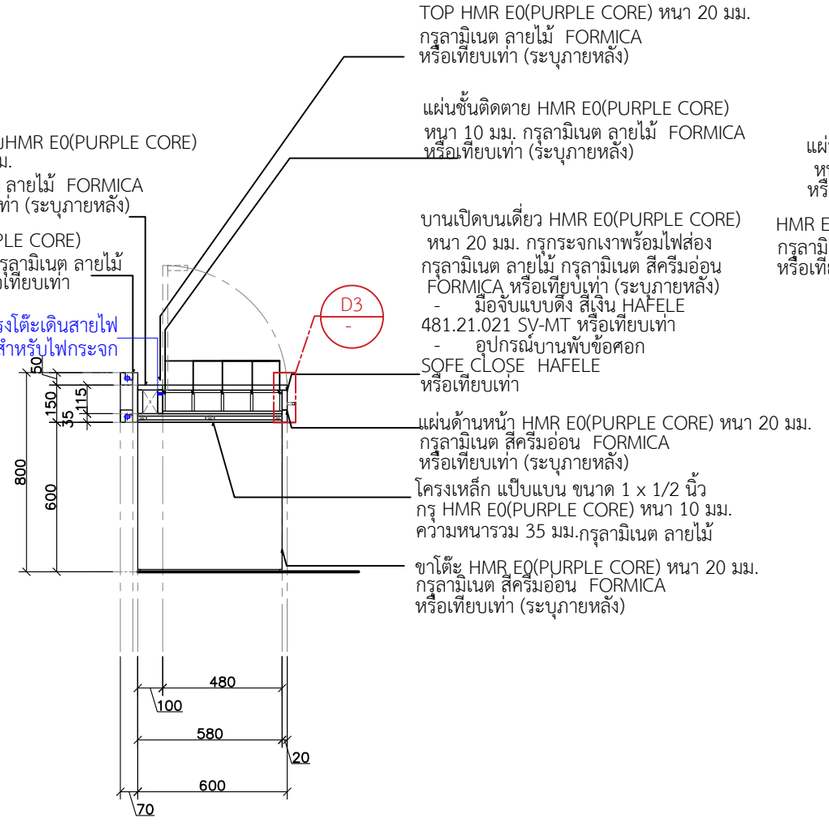

แบบขยาย โต๊ะแต่งหน้า
บริเวณโซนห้องแต่งตัว
SECTION 2

scale 1:25

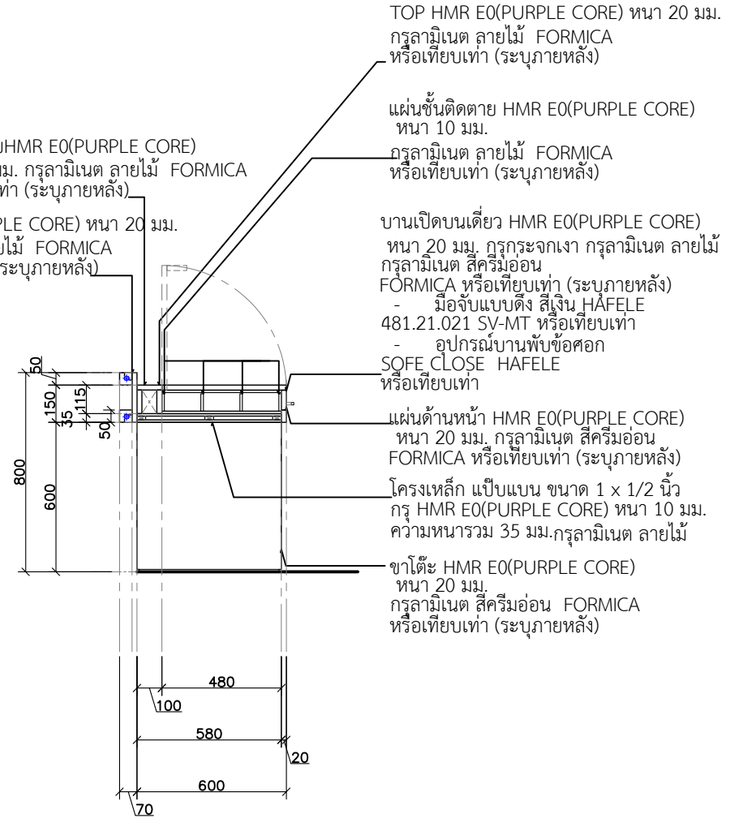

แบบขยาย โต๊ะแต่งหน้า
บริเวณโซนห้องแต่งตัว
SECTION 3

scale 1:25

SPACEMAN

PROJECT: SONIA HOUSE

LOCATION: REIGNWOOD PARK
LAMLUKKA, PATHUM THANI

ARCHITECT

INTERIOR DESIGNER: ปรัตถกร ประมุขกุล ภ-สน 1438

STRUCTURAL ENGINEER

TITLE: 2nd FLOOR
แบบขยาย โต๊ะแต่งหน้า
SECTION

2026-06-18
ID3-08
1:25 @ A3

Note: SPACEMAN takes no responsibility for dimensions obtained by scaling from this drawing. If no dimension is shown the recipient must ascertain the dimension specifically from the architect or by site measurement and may not rely on the drawing. Supply of the drawing in digital form is solely for convenience and no reliance may be placed on any data in digital form. All data must be checked against hard copy. This drawing is issued for design intent only and should not be used for construction unless stated. This drawing is the property of SPACEMAN

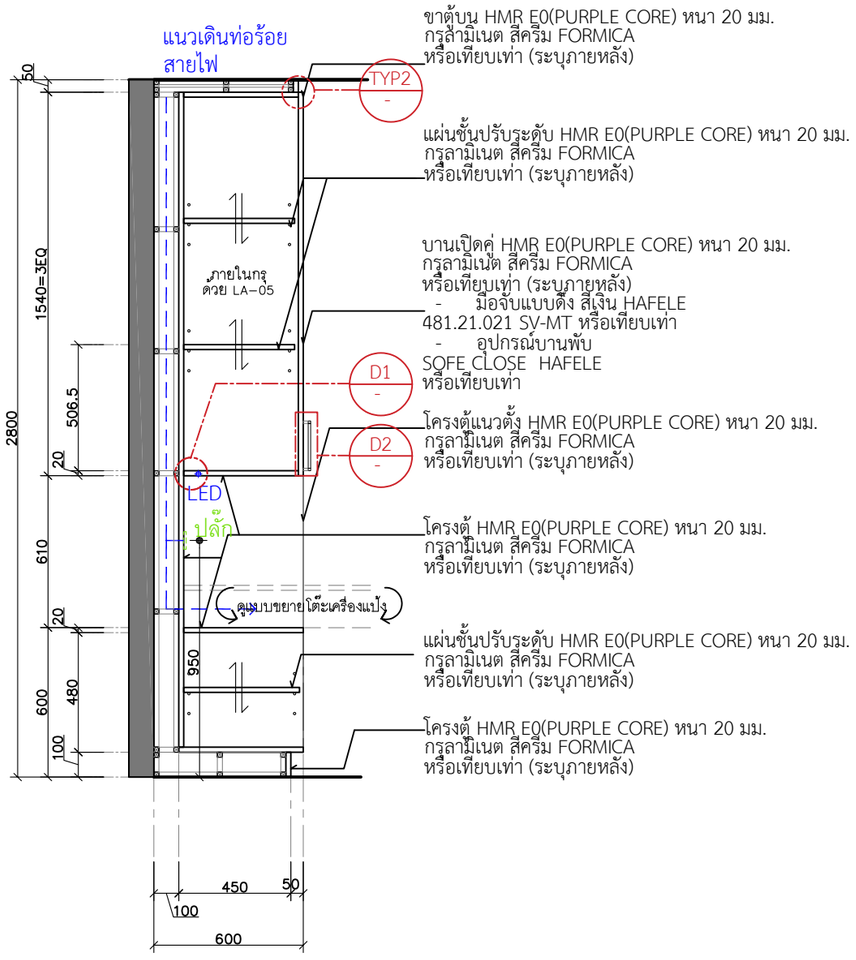

แบบขยาย โต๊ะแต่งหน้า
บริเวณโซนห้องแต่งตัว
SECTION 3
scale 1:25

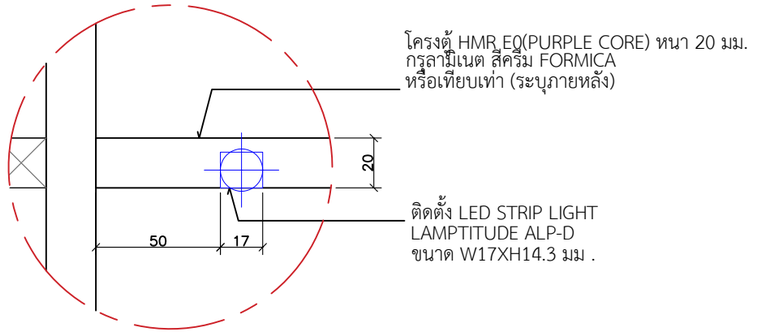

DETAIL 1
scale 1:2.5

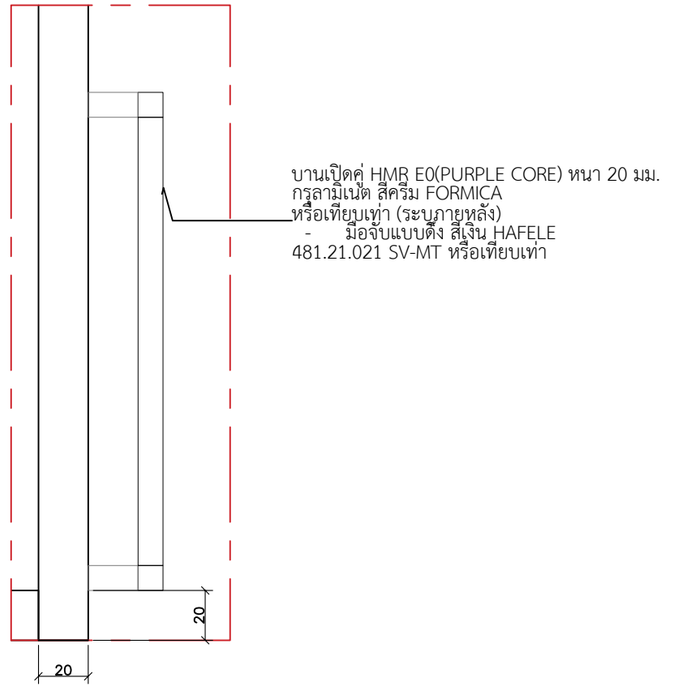

DETAIL 2
scale 1:2.5

SPACEMAN

PROJECT: SONIA HOUSE
LOCATION: REIGNWOOD PARK
LAMLUKKA, PATHUM THANI
ARCHITECT:
INTERIOR DESIGNER: ปรัตถกร ประมุขกุล ภ-ส น 1438
STRUCTURAL ENGINEER:

TITLE: 2nd FLOOR
แบบขยาย โต๊ะแต่งหน้า
SECTION

2026-06-18
ID3-09
1:25 @ A3

Note: SPACEMAN takes no responsibility for dimensions obtained by scaling from this drawing. If no dimension is shown the recipient must ascertain the dimension specifically from the architect or by site measurement and may not rely on the drawing. Supply of the drawing in digital form is solely for convenience and no reliance may be placed on any data in digital form. All data must be checked against hard copy. This drawing is issued for design intent only and should not be used for construction unless stated. This drawing is the property of SPACEMAN

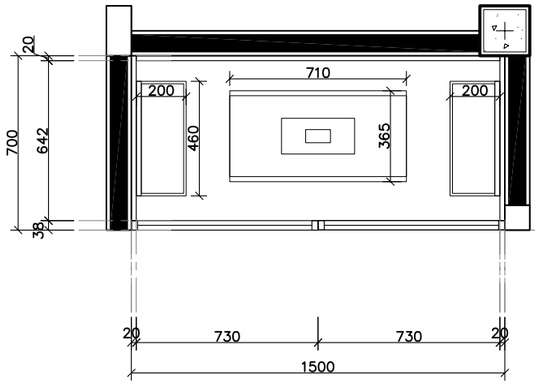

1

แบบขยายตู้รองเท้า
บริเวณห้องแต่งตัว
PLAN

scale 1:25

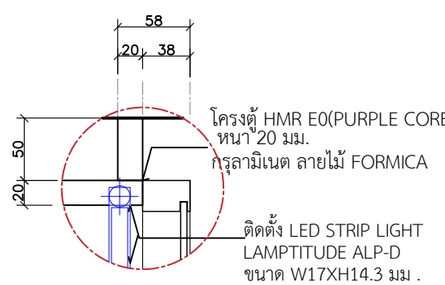

DETAIL 1

scale 1:5

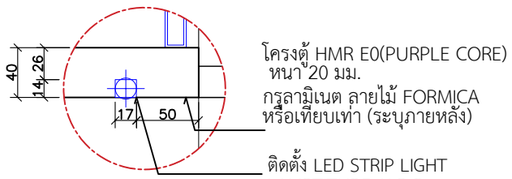

DETAIL 2

scale 1:5

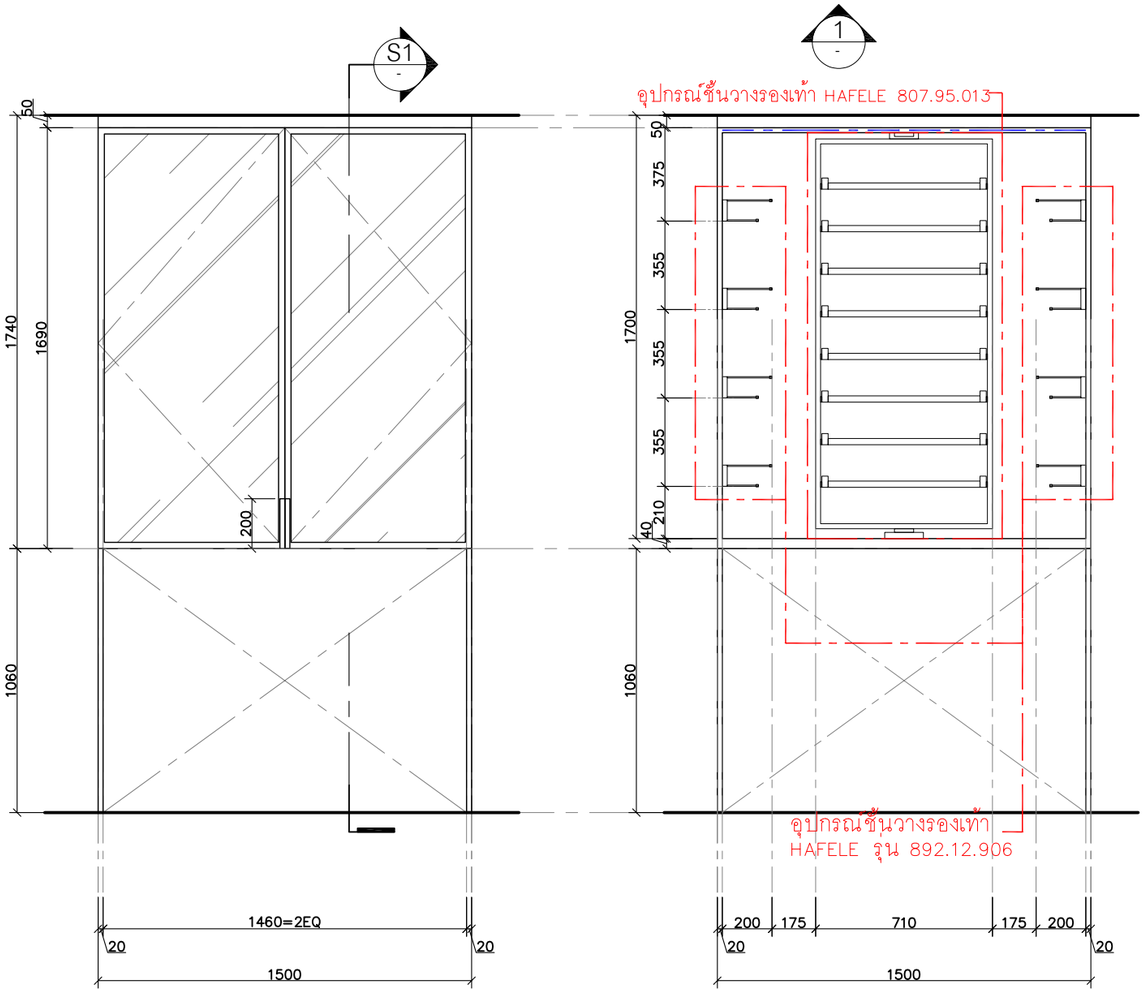

แบบขยายตู้รองเท้า
บริเวณห้องแต่งตัว
ELEVATION 1

scale 1:25

แบบขยายตู้รองเท้า (ภายใน)
บริเวณห้องแต่งตัว
ELEVATION 1

scale 1:25

อุปกรณ์ชั้นวางรองเท้า

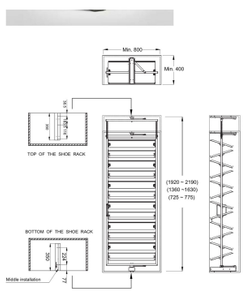

- การติดตั้ง: ยึดด้วยสกรูที่ฐานตู้และด้านบนตู้
- ความกว้างภายในตู้อย่างน้อย: 800 มม.
- ความสูงของภายในตู้: 725-2,190 มม.
- ความลึกภายในตู้อย่างน้อย 400 มม.
- ความสามารถในการรับน้ำหนัก: สูงสุด 4 กก./ชั้นวาง

อุปกรณ์

เฟรมแขวน	1 ชุด
รางแบบคิ้งออก บนและล่าง	1 ชุด
ชั้นวาง	4 หรือ 8 หรือ 12 ชั้น
ชุดสกรูสำหรับติดตั้ง	1 ชุด

คู่มือการติดตั้ง

Dim. (WxDxH) mm ขนาด (กxลxส) มม.	Shelves pcs. จำนวนชั้น ชั้น	Pairs of shoes วางรองเท้า คู่	Cat. No. รหัสสินค้า
710x365x775	4	12	807.95.022
710x365x1,630	8	24	807.95.013
710x365x2,190	12	36	807.95.023

Packing: 1 set
ขนาดบรรจุ: 1 ชุด

รูปภาพประกอบ สำหรับ อุปกรณ์ชั้นวาง
รองเท้า HAFELE 807.95.013 /.HAFELE

Shoe rack, continuously adjustable
ชั้นวางรองเท้า สามารถปรับระดับอย่างต่อเนื่องได้

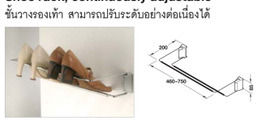

- Material: Steel rail, plastic screw-on parts
- Finish: Chrome plated
- Installation: Screw fixing to wall or wall rail

- วัสดุ: ชั้นเหล็ก ส่วนยึดสกรูพลาสติก
- สี: สีโครม
- การติดตั้ง: ติดตั้งที่กำแพงด้วยสกรูหรือราวแขวนผนัง

Width mm ความกว้าง มม.	Cat. No. รหัสสินค้า
460–750	892.12.906

Packing: 1 or 6 pcs.
ขนาดบรรจุ: 1 หรือ 6 ชิ้น

รูปภาพประกอบ สำหรับ อุปกรณ์ชั้นวาง
รองเท้า HAFELE 892.12.906 /.HAFELE

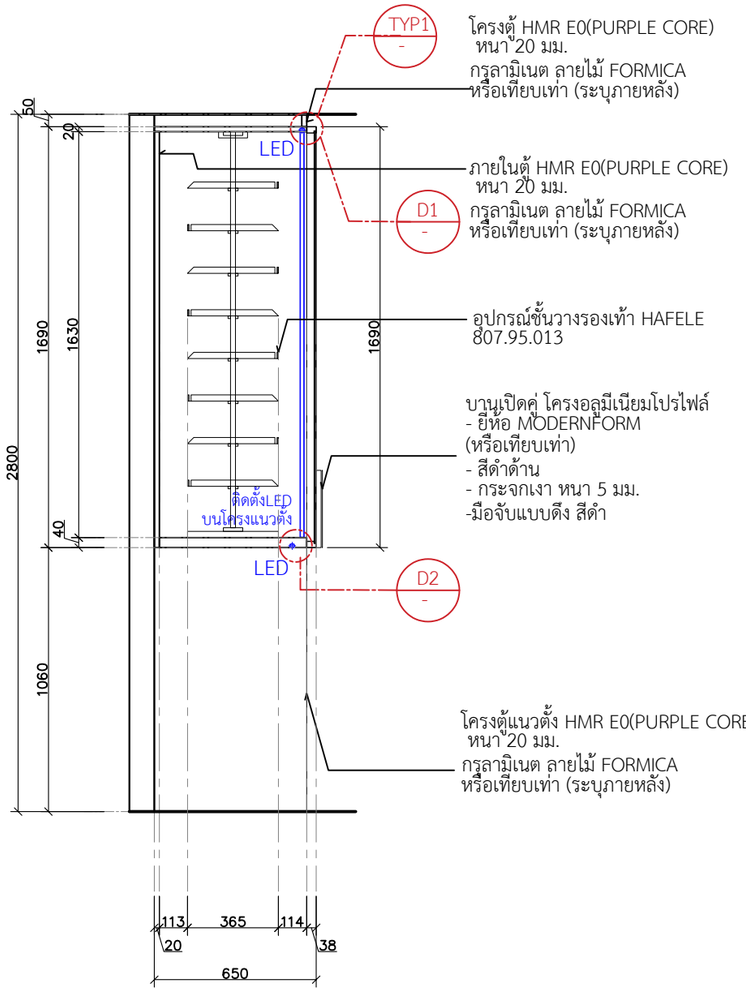

แบบขยายตู้รองเท้า
บริเวณห้องแต่งตัว
SECTION 1

scale 1:25

SPACEMAN

PROJECT SONIA HOUSE

LOCATION REIGNWOOD PARK
LAMLUKKA, PATHUM THANI

ARCHITECT

INTERIOR DESIGNER ปรัตถกร ประมุขกุล ภ–สน 1438

STRUCTURAL ENGINEER

TITLE 2nd FLOOR
แบบขยายตู้รองเท้า
ELEVATION 01

2026–02–04
ID3–10

1:25 @ A3

Note: SPACEMAN takes no responsibility for dimensions obtained by scaling from this drawing. If no dimension is shown the recipient must ascertain the dimension specifically from the architect or by site measurement and may not rely on the drawing. Supply of the drawing in digital form is solely for convenience and no reliance may be placed on any data in digital form. All data must be checked against hard copy. This drawing is issued for design intent only and should not be used for construction unless stated. This drawing is the property of SPACEMAN

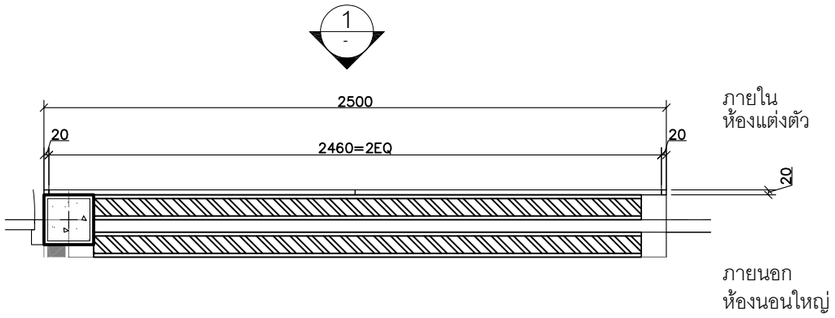

แบบขยาย กระจกเงา

บริเวณห้องแต่งตัว
PLAN

scale 1:25

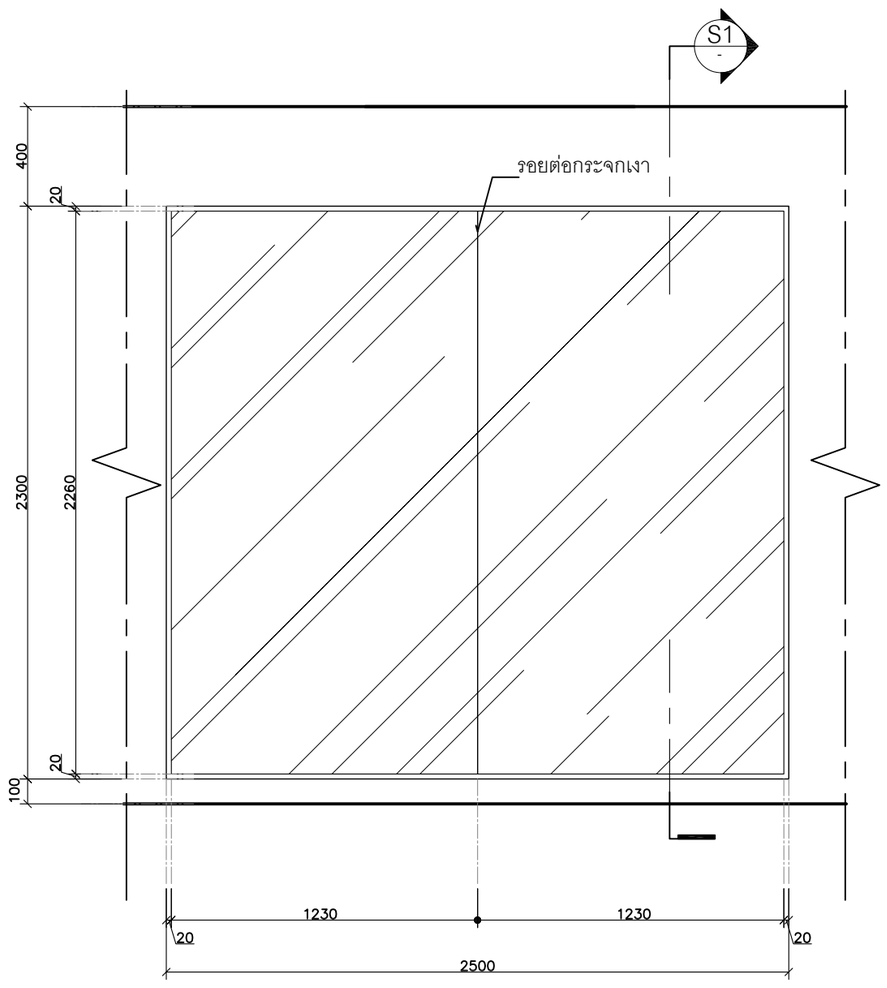

แบบขยาย กระจกเงา

บริเวณห้องแต่งตัว
ELEVATION 1

scale 1:25

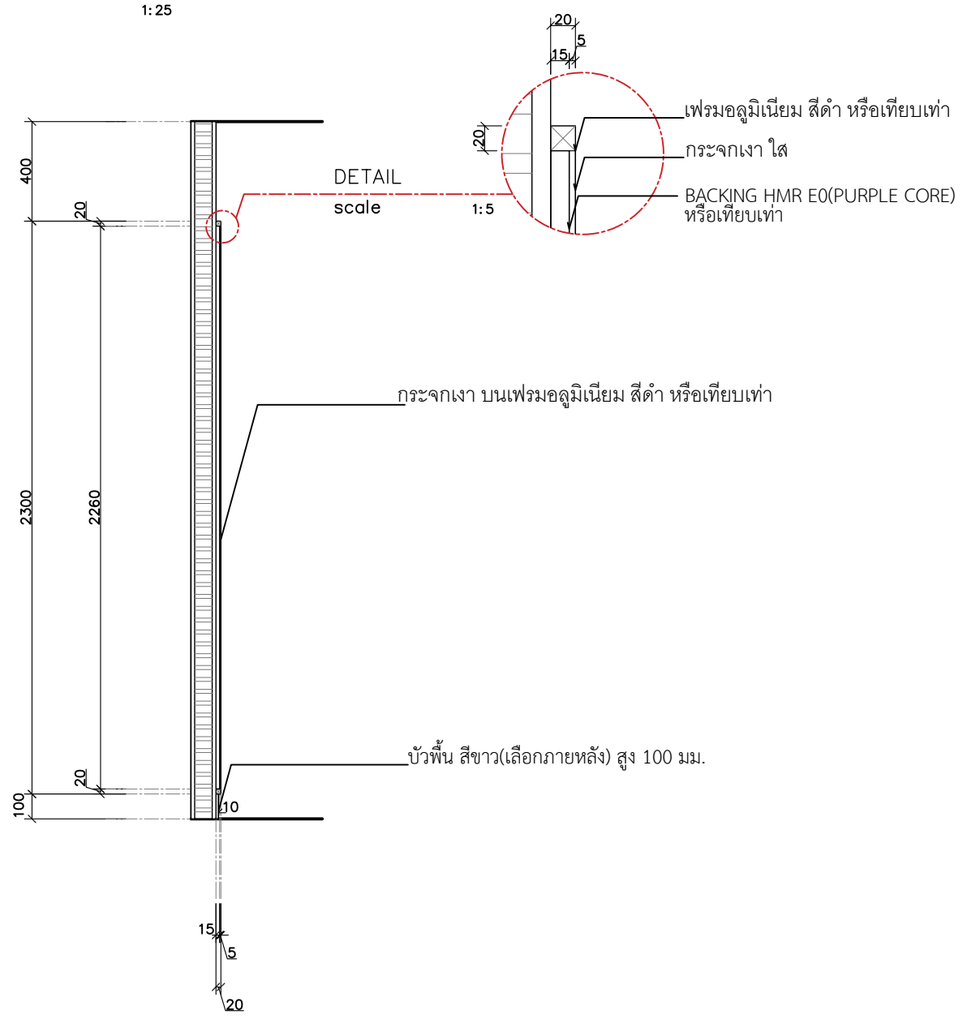

แบบขยาย กระจกเงา

บริเวณห้องแต่งตัว
SECTION 1

scale 1:25

SPACEMAN

PROJECT: SONIA HOUSE

LOCATION: REIGNWOOD PARK
LAMLUKKA, PATHUM THANI

ARCHITECT:

INTERIOR DESIGNER: ปรัตถกร ประมุขกุล ภ-สน 1438

STRUCTURAL ENGINEER:

TITLE: 2nd FLOOR (บริเวณห้องแต่งตัว)
แบบขยาย กระจกเงา
PLAN ,ELEVATION ,SECTION

2026-02-04
ID3-11

1:25 @ A3

Note: SPACEMAN takes no responsibility for dimensions obtained by scaling from this drawing. If no dimension is shown the recipient must ascertain the dimension specifically from the architect or by site measurement and may not rely on the drawing. Supply of the drawing in digital form is solely for convenience and no reliance may be placed on any data in digital form. All data must be checked against hard copy. This drawing is issued for design intent only and should not be used for construction unless stated. This drawing is the property of SPACEMAN

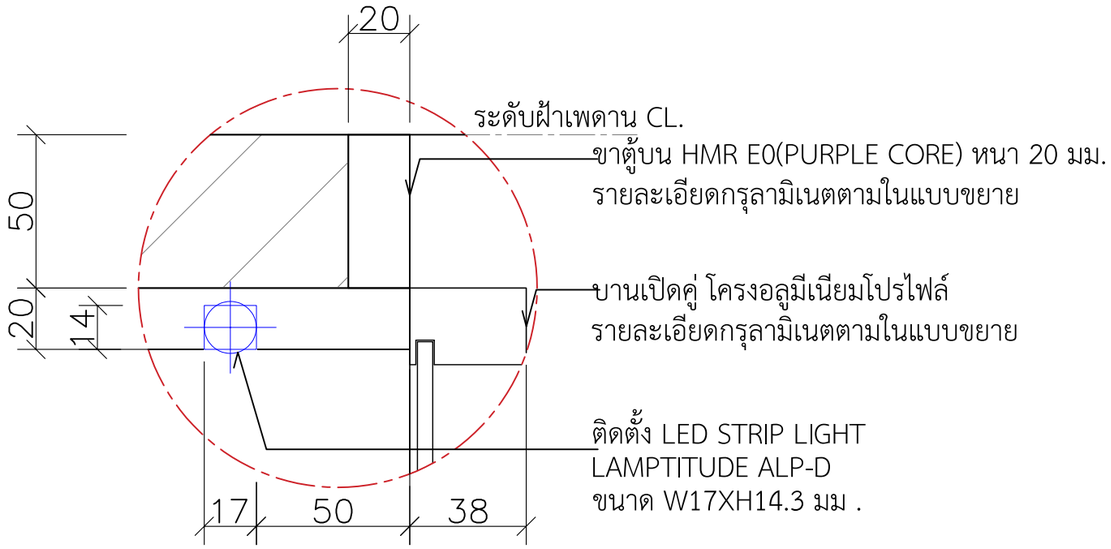

TYPICAL DETAIL 1
IN SCALE 1:2

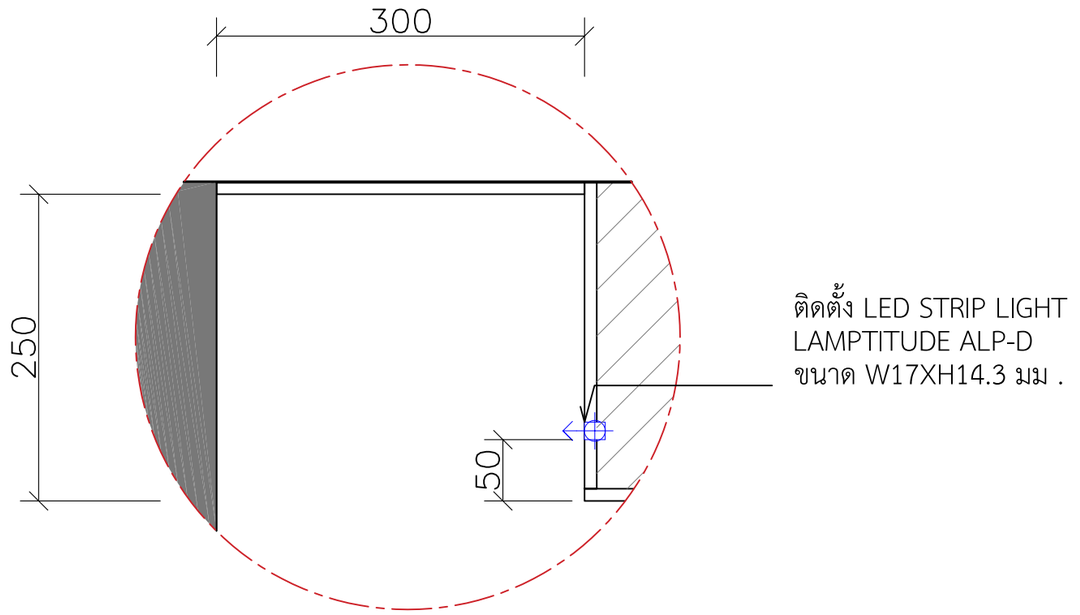

CEILING DETAIL
IN SCALE 1:5

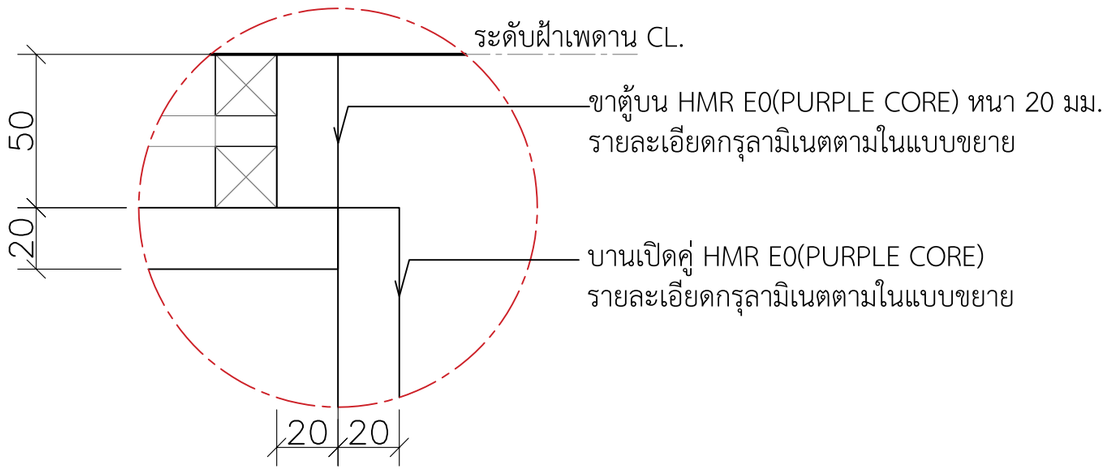

TYPICAL DETAIL 2
IN SCALE 1:2

SPACEMAN

PROJECT: SONIA HOUSE
LOCATION: LAMLUKKA, PATHUM THANI
ARCHITECT:
INTERIOR DESIGNER: ปรัตถกร ประมุขกุล ภ-สน 1438
STRUCTURAL ENGINEER:
TITLE: 2nd FLOOR แบบขยายบริเวณ ห้องแต่งตัว DETAIL
2026-05-26
ID3-12
1:10 @ A3

Note: SPACEMAN takes no responsibility for dimensions obtained by scaling from this drawing. If no dimension is shown the recipient must ascertain the dimension specifically from the architect or by site measurement and may not rely on the drawing. Supply of the drawing in digital form is solely for convenience and no reliance may be placed on any data in digital form. All data must be checked against hard copy. This drawing is issued for design intent only and should not be used for construction unless stated. This drawing is the property of SPACEMAN

SONIA HOUSE

REIGNWOOD PARK

LAMLUKKA, PATHUM THANI

แบบขยายห้องนอน 2

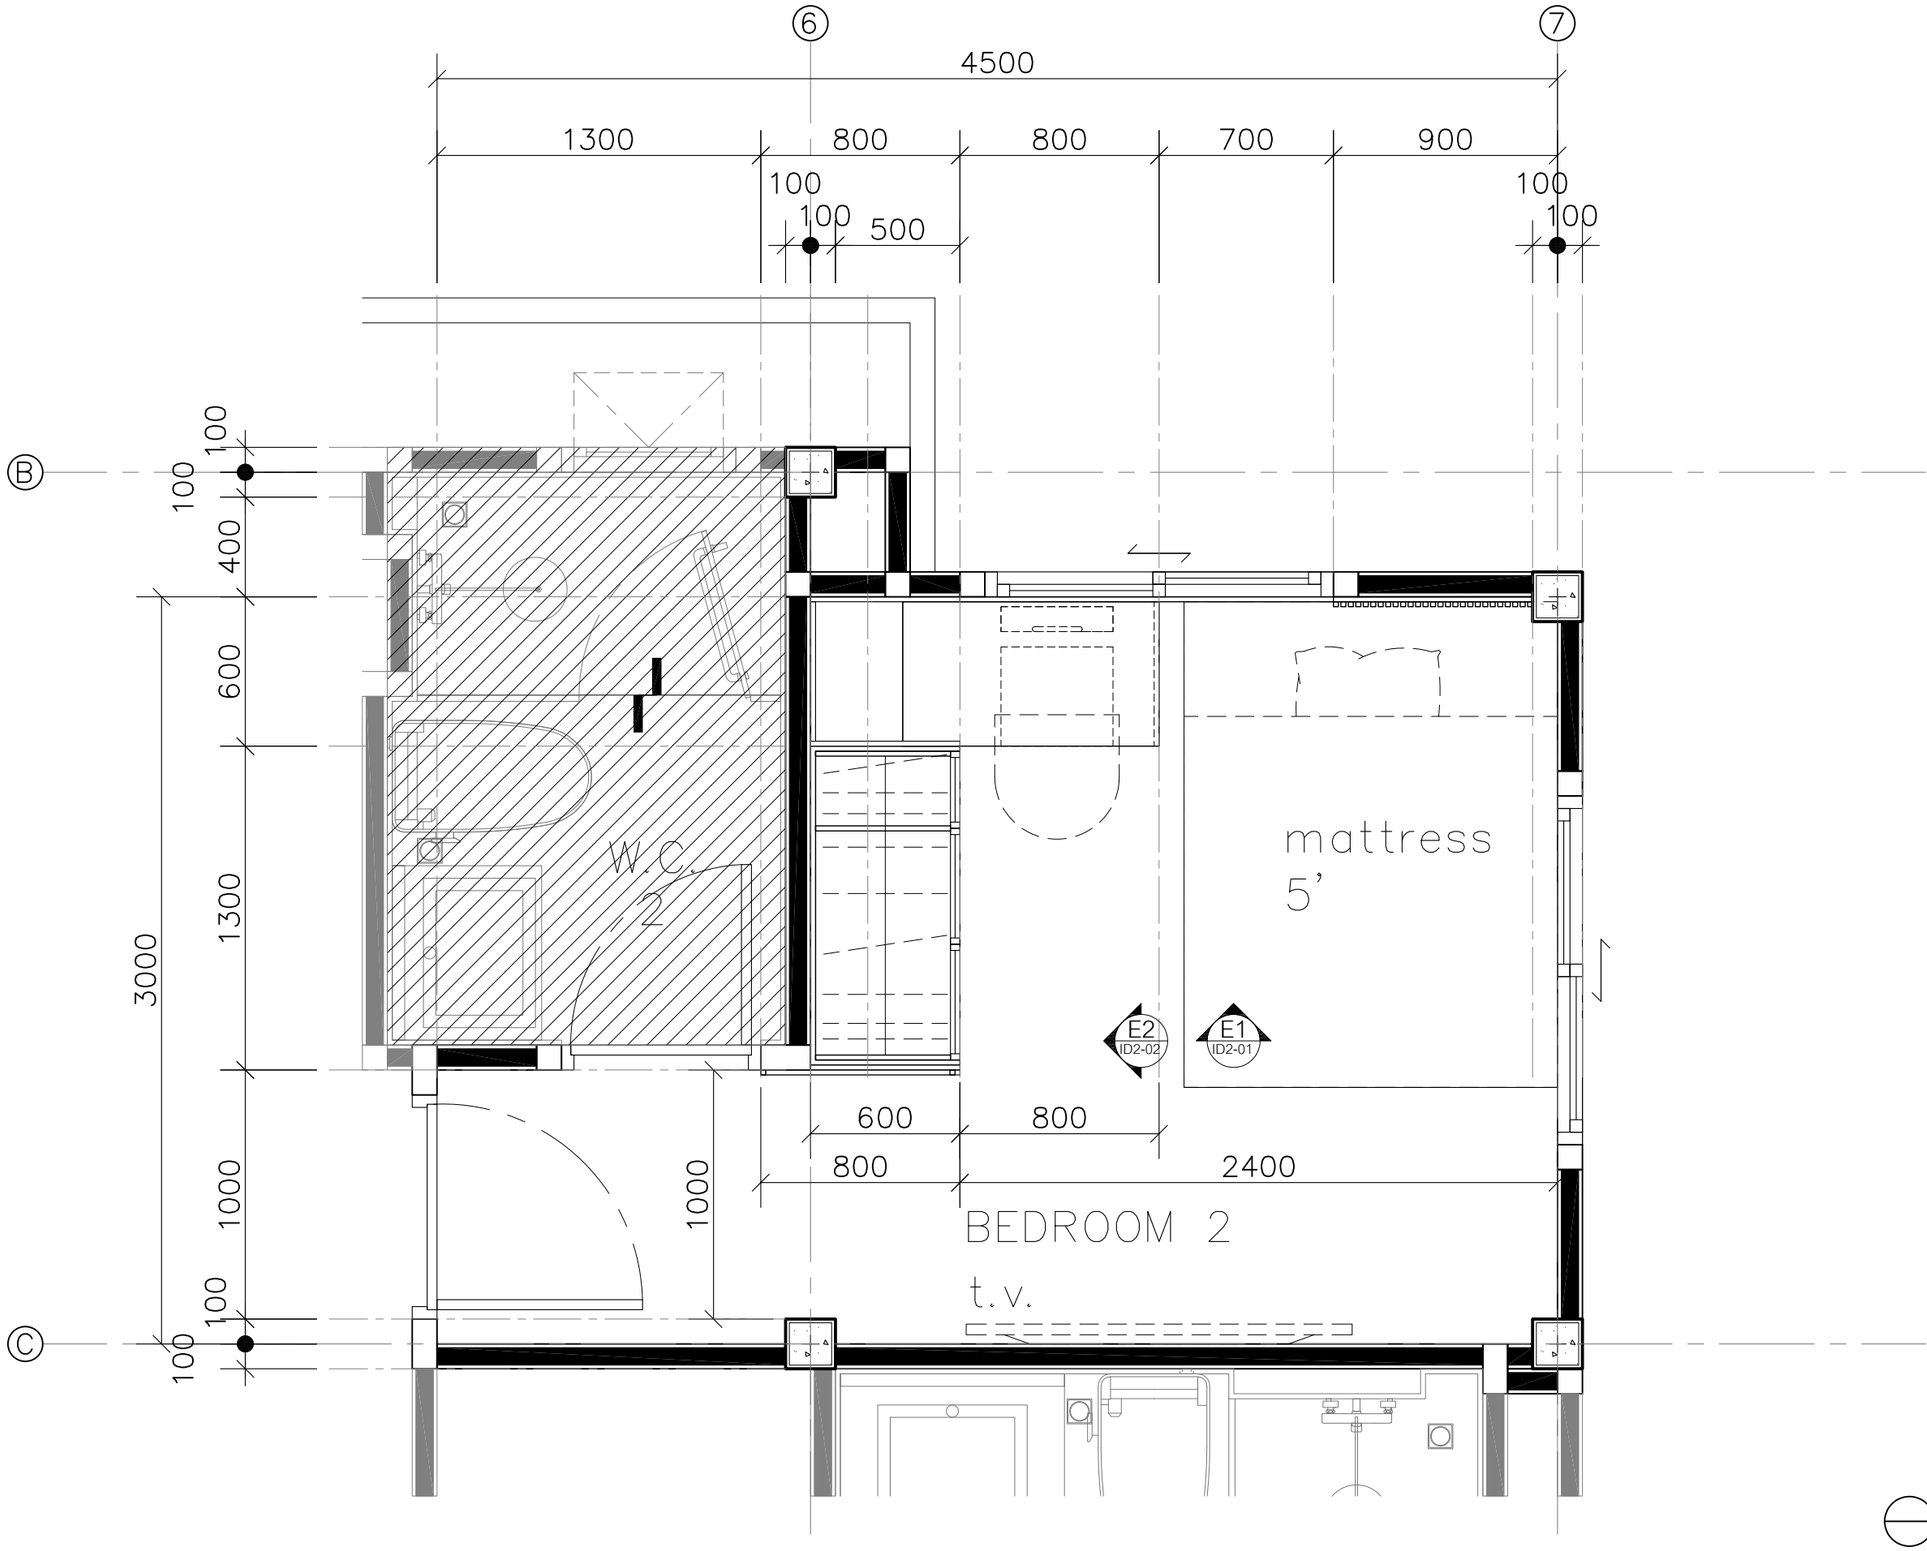

FURNITURE LAYOUT PLAN
(แบบขยายห้องนอน 2)
scale 1:25

SPACEMAN

PROJECT: SONIA HOUSE

LOCATION: REIGNWOOD PARK
LAMLUKKA, PATHUM THANI

ARCHITECT:

INTERIOR DESIGNER: ปรัตถกร ประมุขกุล ภ-สน 1438

STRUCTURAL ENGINEER:

TITLE: 2nd FLOOR
FURNITURE LAYOUT PLAN
(แบบขยายห้องนอน 2)

2026-06-18
ID1-01
1:25 @ A3

Note: SPACEMAN takes no responsibility for dimensions obtained by scaling from this drawing. If no dimension is shown the recipient must ascertain the dimension specifically from the architect or by site measurement and may not rely on the drawing. Supply of the drawing in digital form is solely for convenience and no reliance may be placed on any data in digital form. All data must be checked against hard copy. This drawing is issued for design intent only and should not be used for construction unless stated. This drawing is the property of SPACEMAN

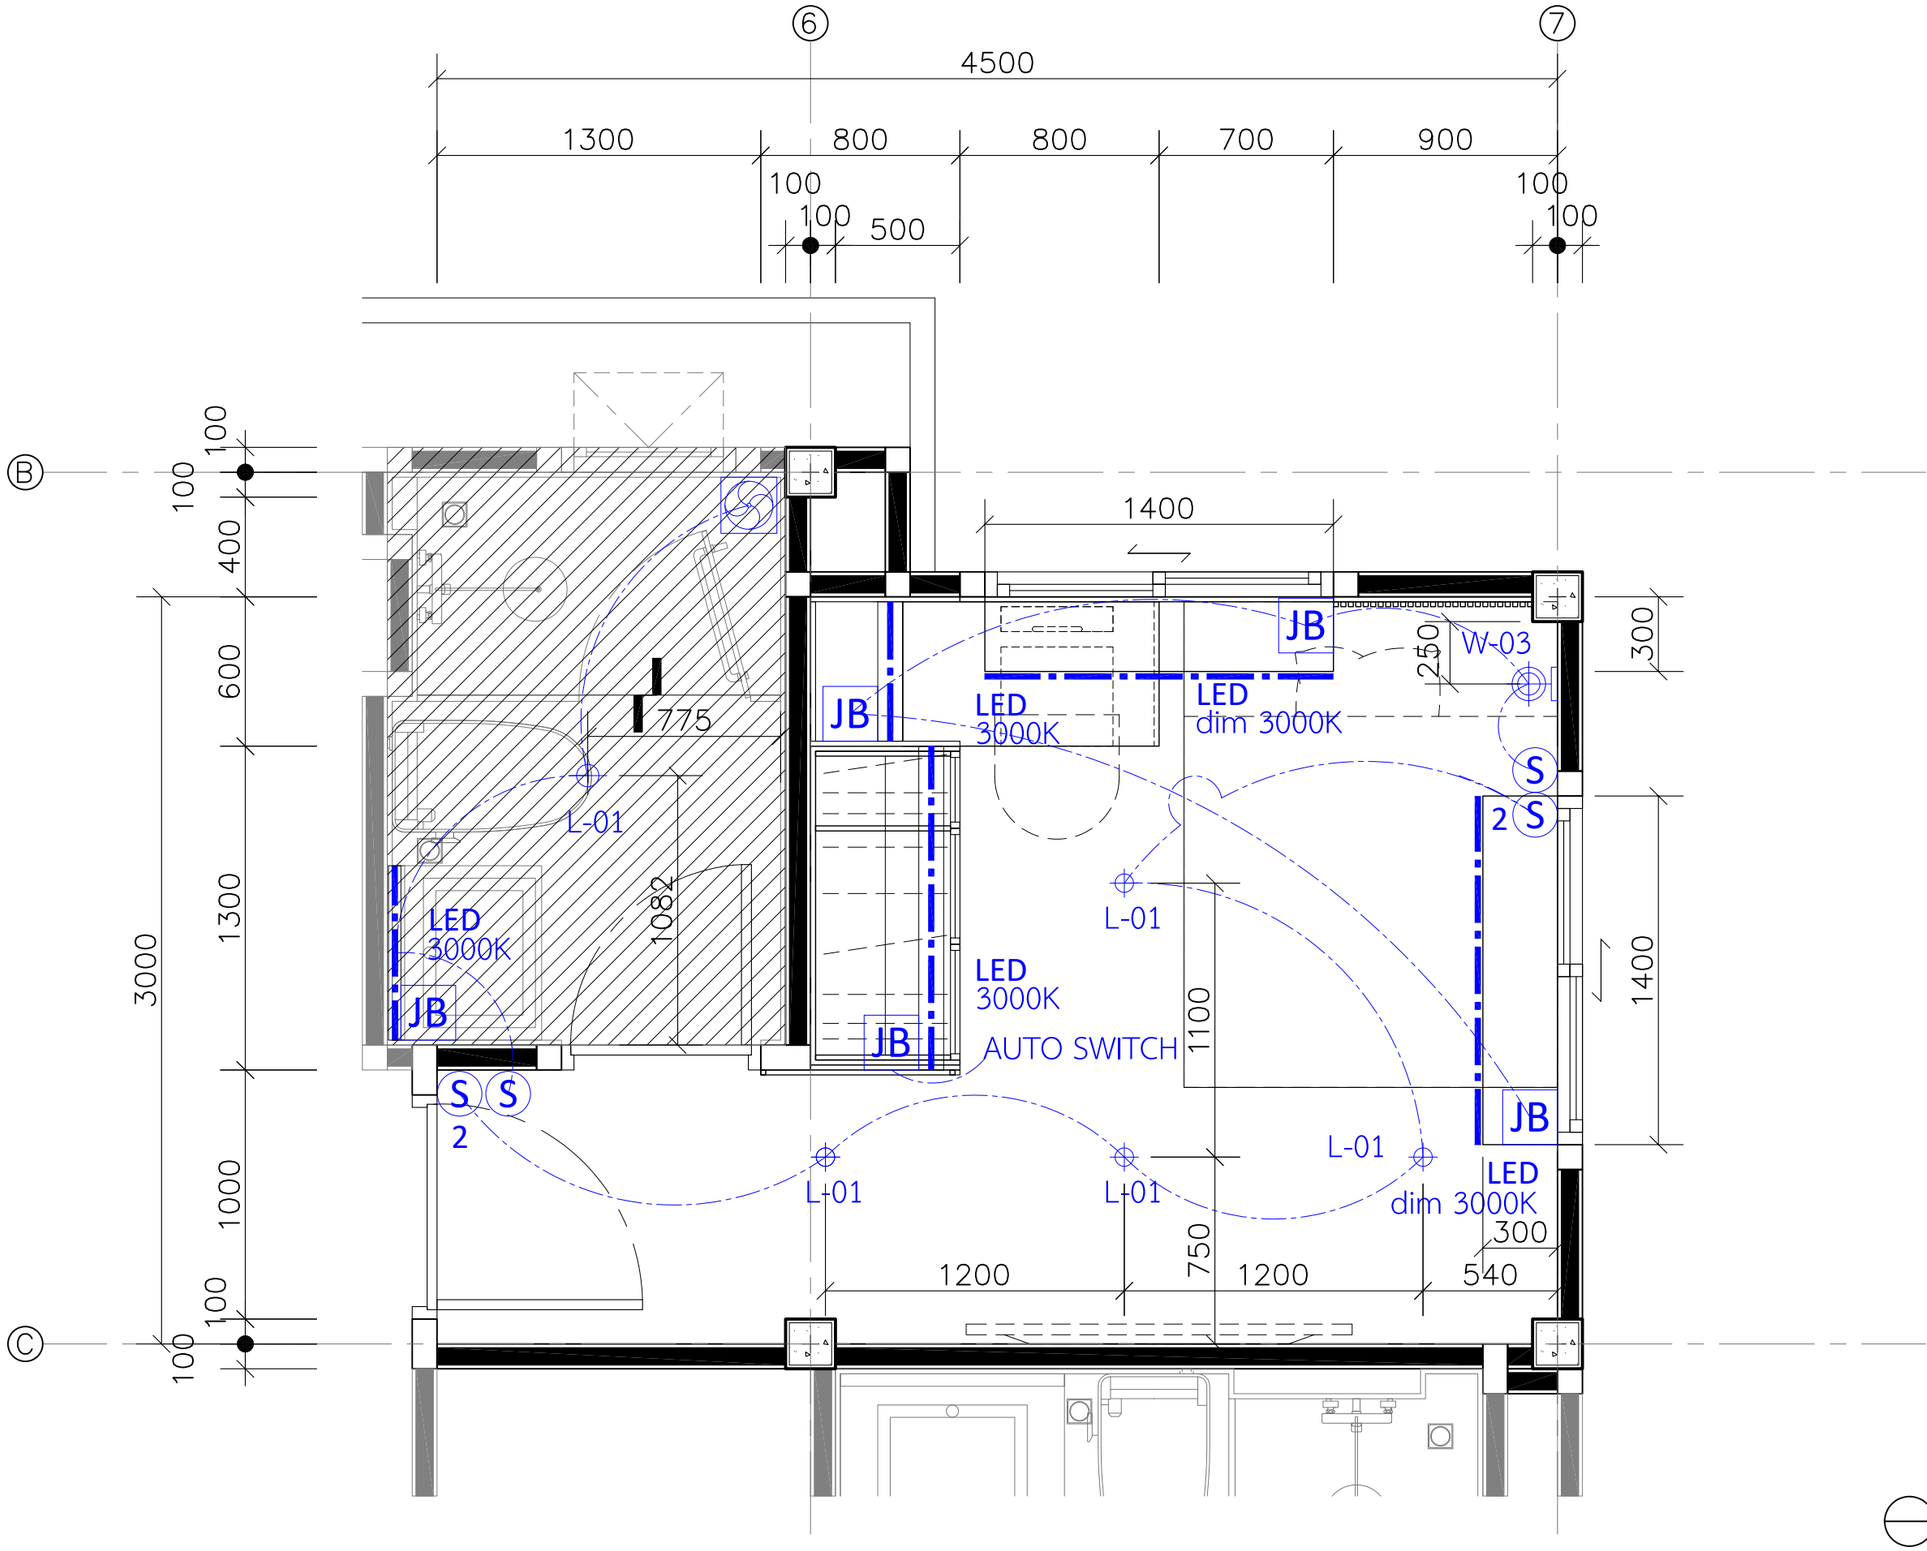

LIGHTING PLAN
(แบบขยายห้องนอน 2)
scale 1:25

SPACEMAN

PROJECT | SONIA HOUSE

LOCATION | REIGNWOOD PARK
LAMLUKKA, PATHUM THANI

ARCHITECT

INTERIOR DESIGNER | ปรัตถกร ประมุขกุล ภ-สน 1438

STRUCTURAL ENGINEER

TITLE | 2nd FLOOR
LIGHTING PLAN PLAN
(แบบขยายห้องนอน 2)

2026-06-18
ID1-02
1:25 @ A3

Note: SPACEMAN takes no responsibility for dimensions obtained by scaling from this drawing. If no dimension is shown the recipient must ascertain the dimension specifically from the architect or by site measurement and may not rely on the drawing. Supply of the drawing in digital form is solely for convenience and no reliance may be placed on any data in digital form. All data must be checked against hard copy. This drawing is issued for design intent only and should not be used for construction unless stated. This drawing is the property of SPACEMAN

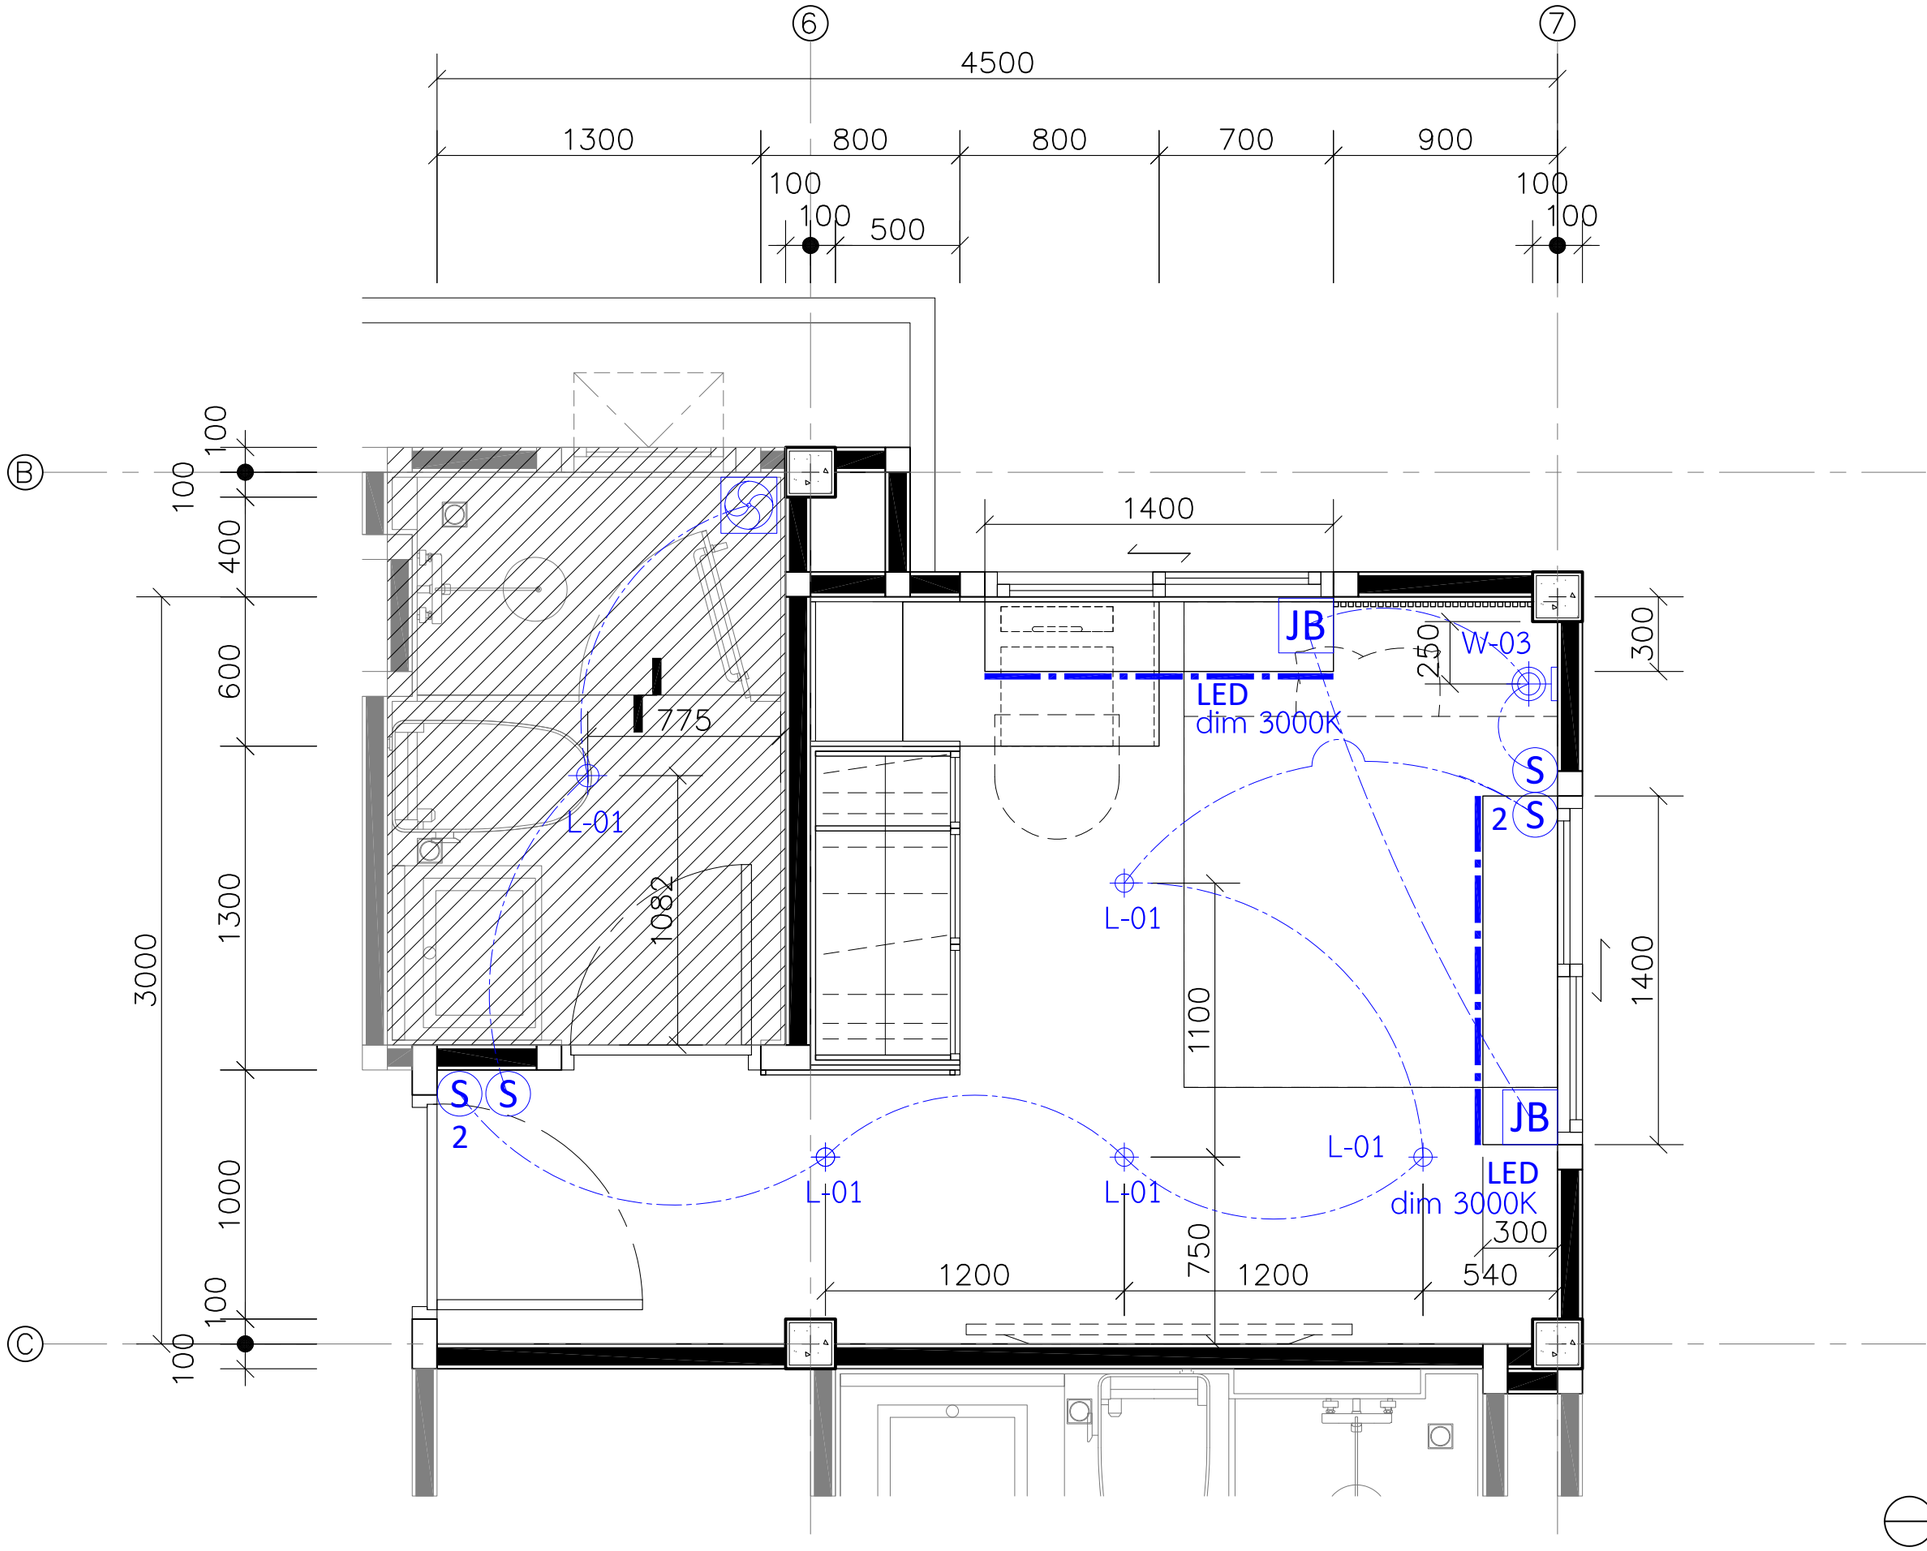

REFLECTED &LIGHTING PLAN
(แบบขยายห้องนอน 2)
scale 1:25

SPACEMAN

PROJECT | SONIA HOUSE

LOCATION | REIGNWOOD PARK
LAMLUKKA, PATHUM THANI

ARCHITECT

INTERIOR DESIGNER | ปรัตถกร ประมุขกุล ภ-สน 1438

STRUCTURAL ENGINEER

TITLE | 2nd FLOOR
LIGHTING PLAN PLAN
(แบบขยายห้องนอน 2)

2026-06-18
ID1-02
1:25 @ A3

Note: SPACEMAN takes no responsibility for dimensions obtained by scaling from this drawing. If no dimension is shown the recipient must ascertain the dimension specifically from the architect or by site measurement and may not rely on the drawing. Supply of the drawing in digital form is solely for convenience and no reliance may be placed on any data in digital form. All data must be checked against hard copy. This drawing is issued for design intent only and should not be used for construction unless stated. This drawing is the property of SPACEMAN

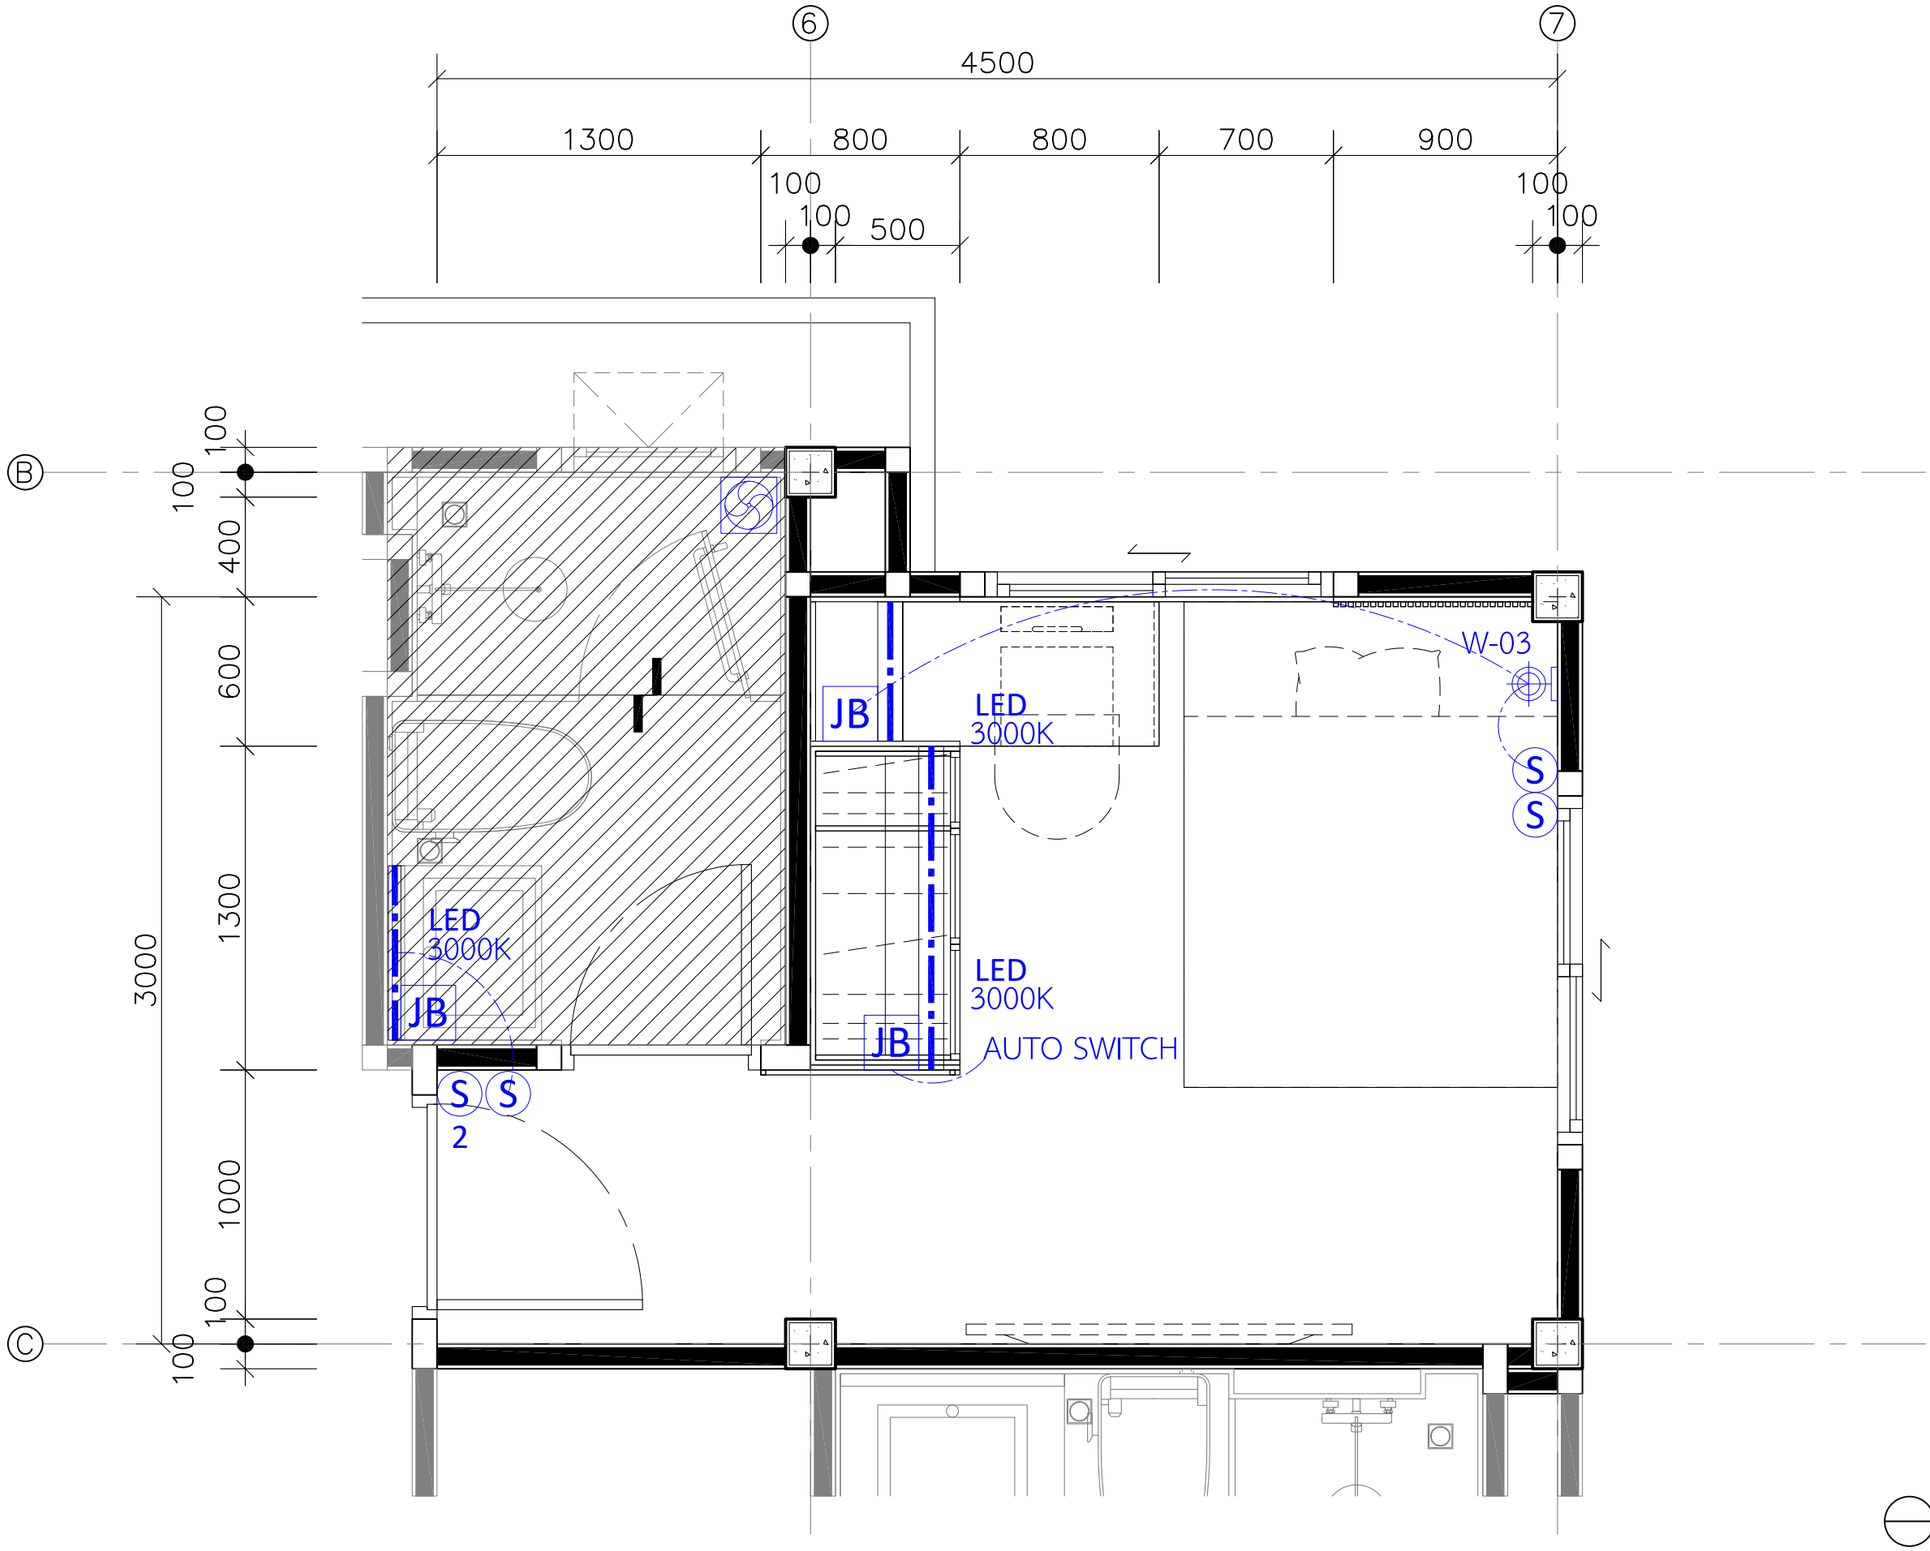

GROUND & FURNITURE PLAN
(แบบขยายห้องนอน 2)
scale 1:25

SPACEMAN

PROJECT | SONIA HOUSE

LOCATION | REIGNWOOD PARK
LAMLUKKA, PATHUM THANI

ARCHITECT |

INTERIOR DESIGNER | ปรัตถกร ประมุขกุล ภ-สน 1438

STRUCTURAL ENGINEER |

TITLE | 2nd FLOOR
LIGHTING PLAN PLAN
(แบบขยายห้องนอน 2)

2026-06-18
ID1-02
1:25 @ A3

Note: SPACEMAN takes no responsibility for dimensions obtained by scaling from this drawing. If no dimension is shown the recipient must ascertain the dimension specifically from the architect or by site measurement and may not rely on the drawing. Supply of the drawing in digital form is solely for convenience and no reliance may be placed on any data in digital form. All data must be checked against hard copy. This drawing is issued for design intent only and should not be used for construction unless stated. This drawing is the property of SPACEMAN

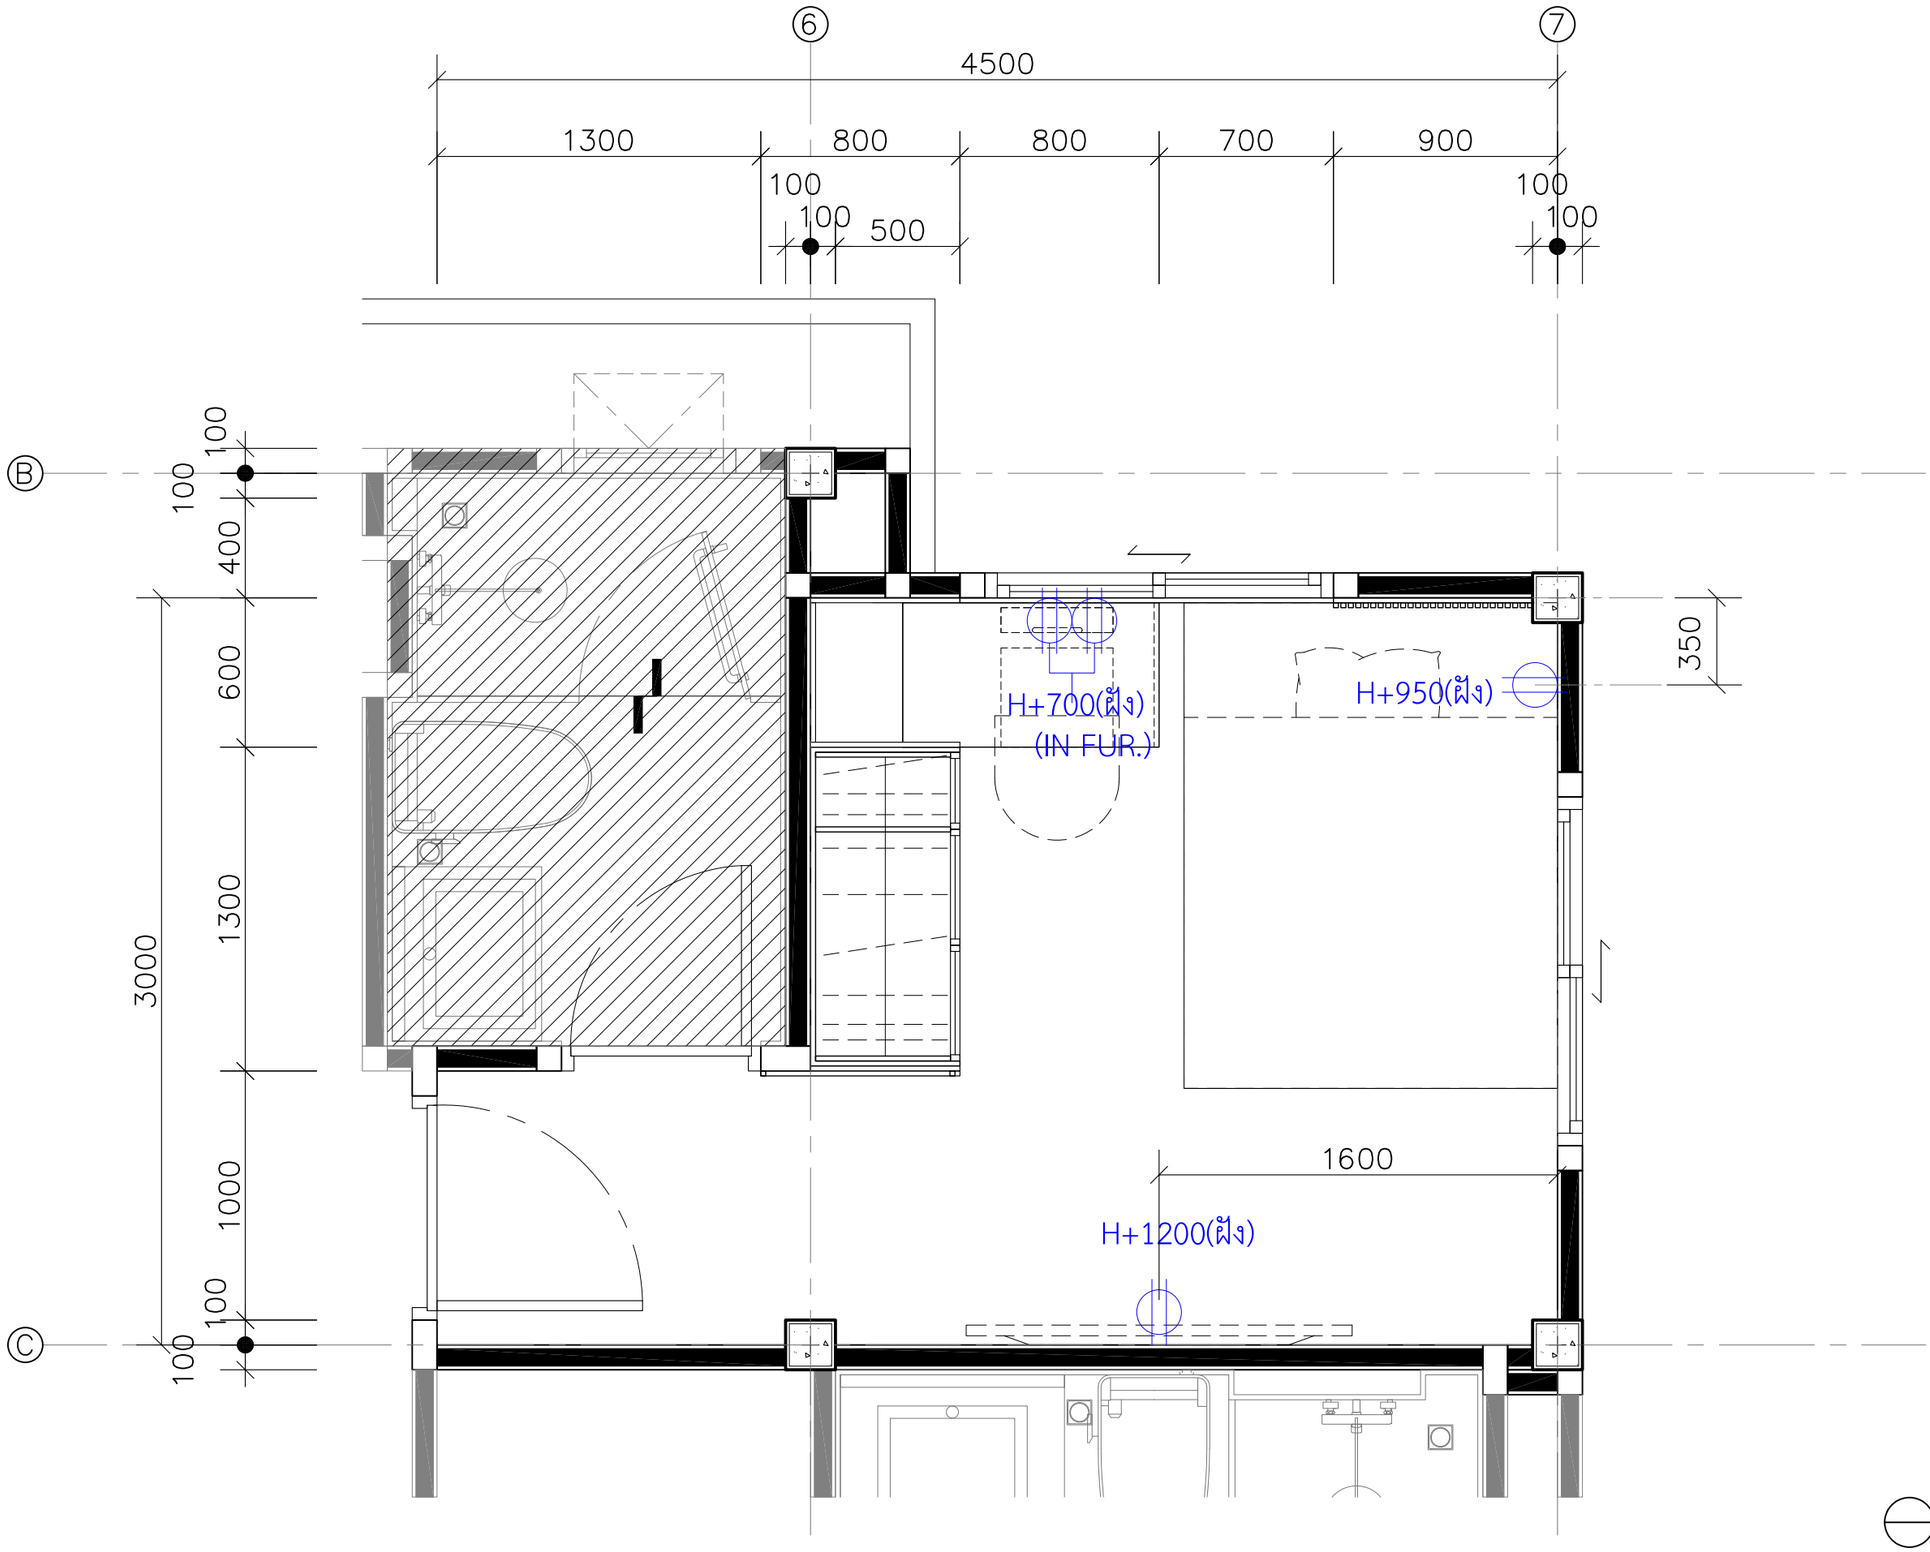

OUTLET PLAN
(แบบขยายห้องนอน 2)
scale 1:25

SPACEMAN

PROJECT | SONIA HOUSE

LOCATION | REIGNWOOD PARK
LAMLUKKA, PATHUM THANI

ARCHITECT

INTERIOR DESIGNER | ปรัตถกร ประมุขกุล ภ-สน 1438

STRUCTURAL ENGINEER

TITLE | 2nd FLOOR
OUTLET PLAN
(แบบขยายห้องนอน 2)

2026-06-18
ID1-03
1:25 @ A3

Note: SPACEMAN takes no responsibility for dimensions obtained by scaling from this drawing. If no dimension is shown the recipient must ascertain the dimension specifically from the architect or by site measurement and may not rely on the drawing. Supply of the drawing in digital form is solely for convenience and no reliance may be placed on any data in digital form. All data must be checked against hard copy. This drawing is issued for design intent only and should not be used for construction unless stated. This drawing is the property of SPACEMAN

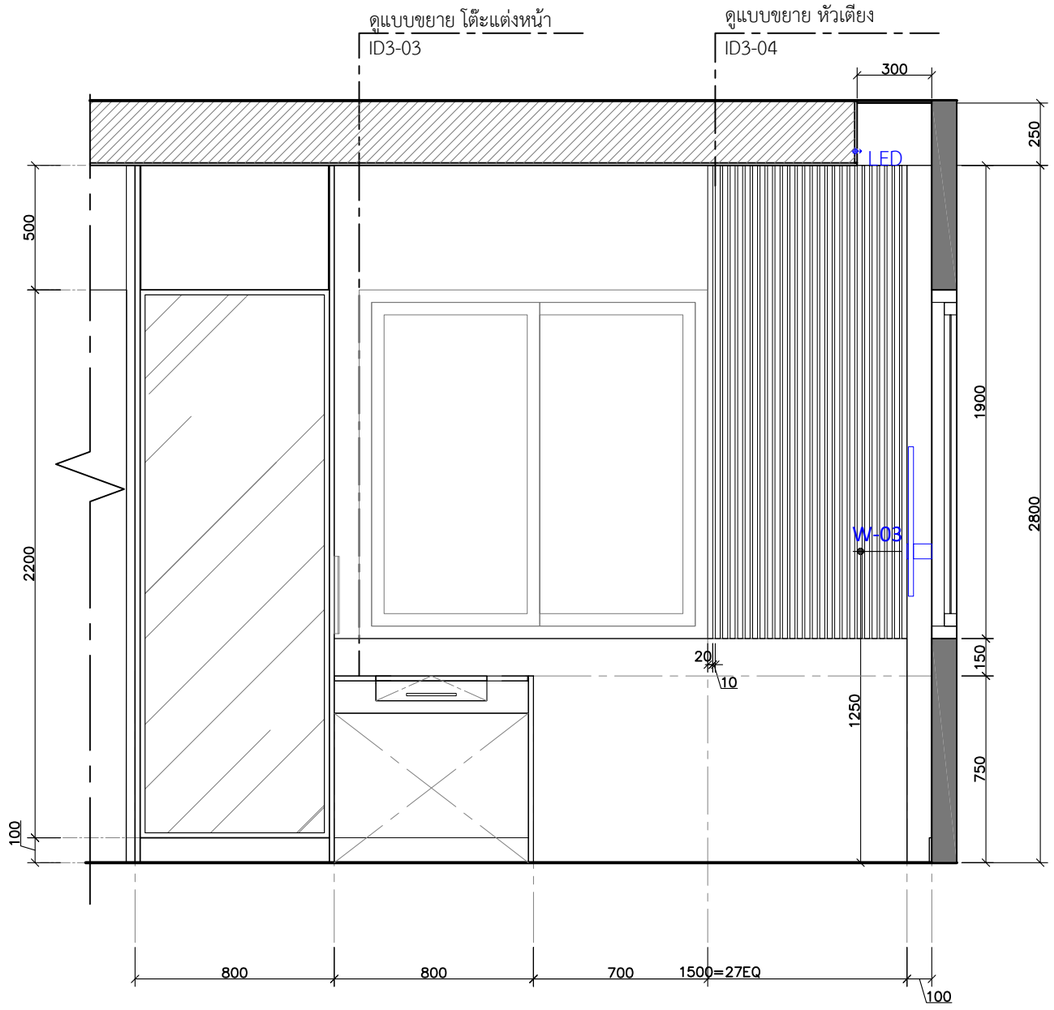

บริเวณ ห้องนอน 2
ELEVATION 1
scale 1:25

SPACEMAN

PROJECT | SONIA HOUSE

LOCATION | REIGNWOOD PARK
LAMLUKKA, PATHUM THANI

ARCHITECT |

INTERIOR DESIGNER | ปรัตถกร ประมุขกุล ภ-สน 1438

STRUCTURAL ENGINEER |

TITLE | 2nd FLOOR
ELEVATION
(แบบขยายบริเวณห้องนอน 2)

2026-06-18
ID2-01

1:25 @ A3

Note: SPACEMAN takes no responsibility for dimensions obtained by scaling from this drawing. If no dimension is shown the recipient must ascertain the dimension specifically from the architect or by site measurement and may not rely on the drawing. Supply of the drawing in digital form is solely for convenience and no reliance may be placed on any data in digital form. All data must be checked against hard copy. This drawing is issued for design intent only and should not be used for construction unless stated. This drawing is the property of SPACEMAN

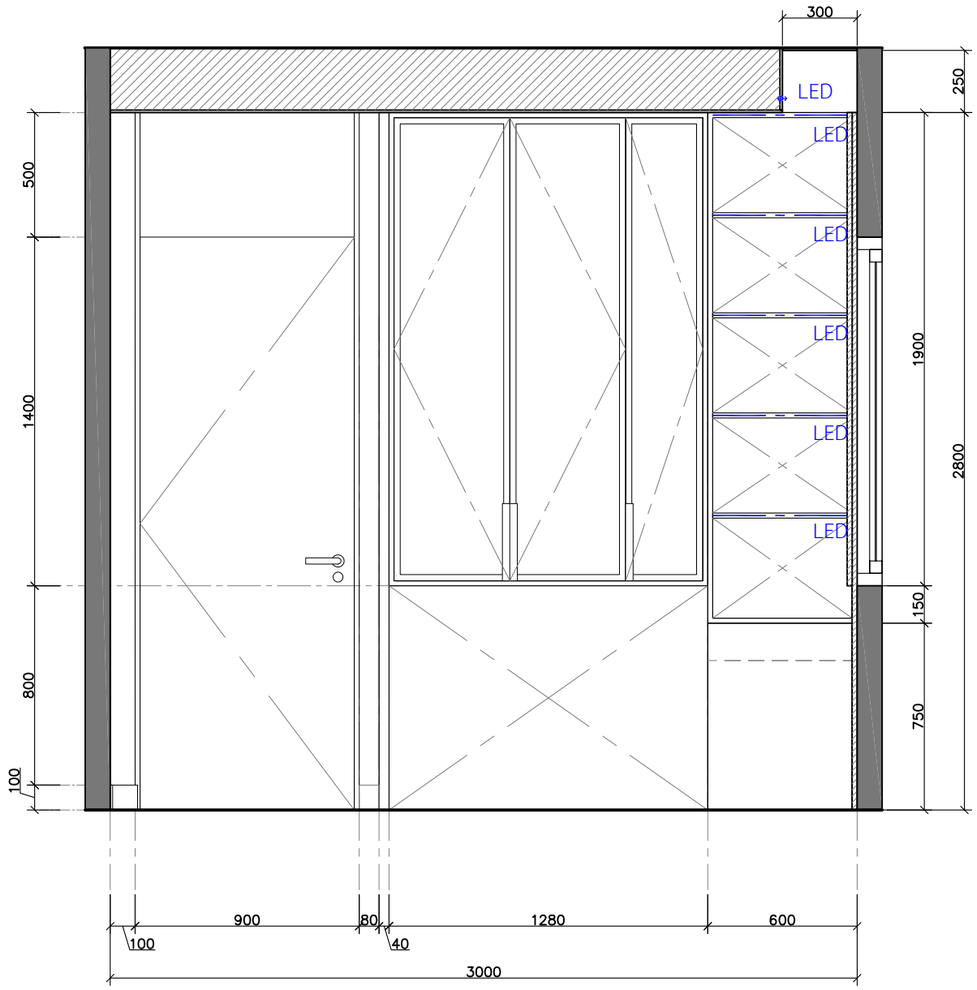

บริเวณ ห้องนอน 2
ELEVATION 2

scale 1:25

SPACEMAN

PROJECT | SONIA HOUSE

LOCATION | REIGNWOOD PARK
LAMLUKKA, PATHUM THANI

ARCHITECT

INTERIOR DESIGNER | ปรัตถกร ประมุขกุล ภ-สน 1438

STRUCTURAL ENGINEER

TITLE | 2nd FLOOR
ELEVATION
(แบบขยายบริเวณห้องนอน 2)

2026-06-18
ID2-02

1:25 @ A3

Note: SPACEMAN takes no responsibility for dimensions obtained by scaling from this drawing. If no dimension is shown the recipient must ascertain the dimension specifically from the architect or by site measurement and may not rely on the drawing. Supply of the drawing in digital form is solely for convenience and no reliance may be placed on any data in digital form. All data must be checked against hard copy. This drawing is issued for design intent only and should not be used for construction unless stated. This drawing is the property of SPACEMAN

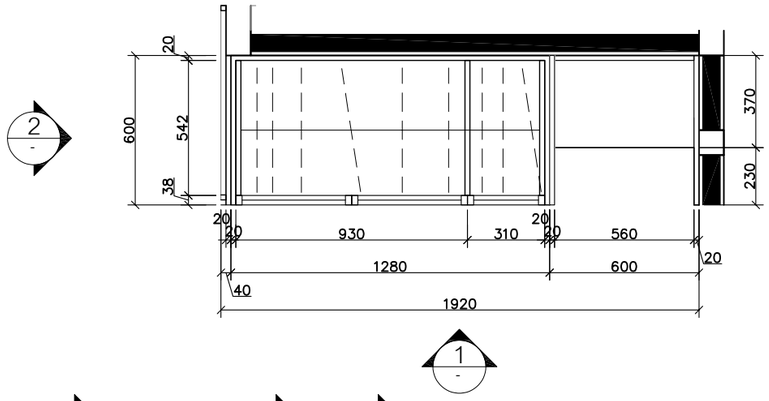

แบบขยาย ตู้เสื้อผ้า
บริเวณ ห้องนอน 2
PLAN

scale 1:25

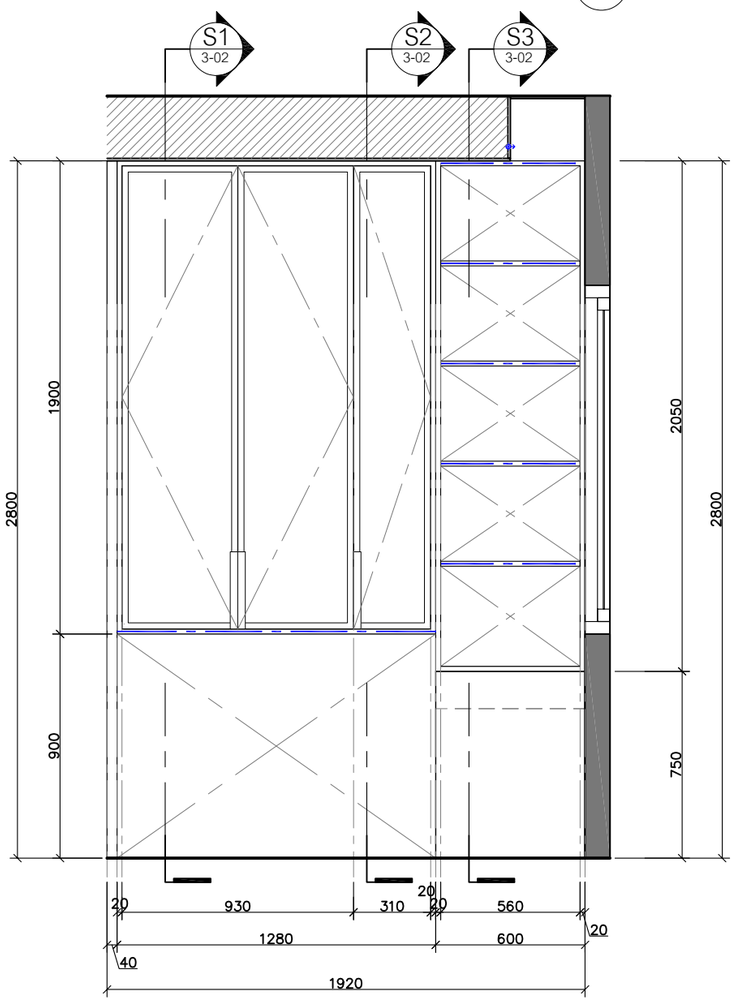

แบบขยาย ตู้เสื้อผ้า
บริเวณ ห้องนอน 2
ELEVATION 1

scale 1:25

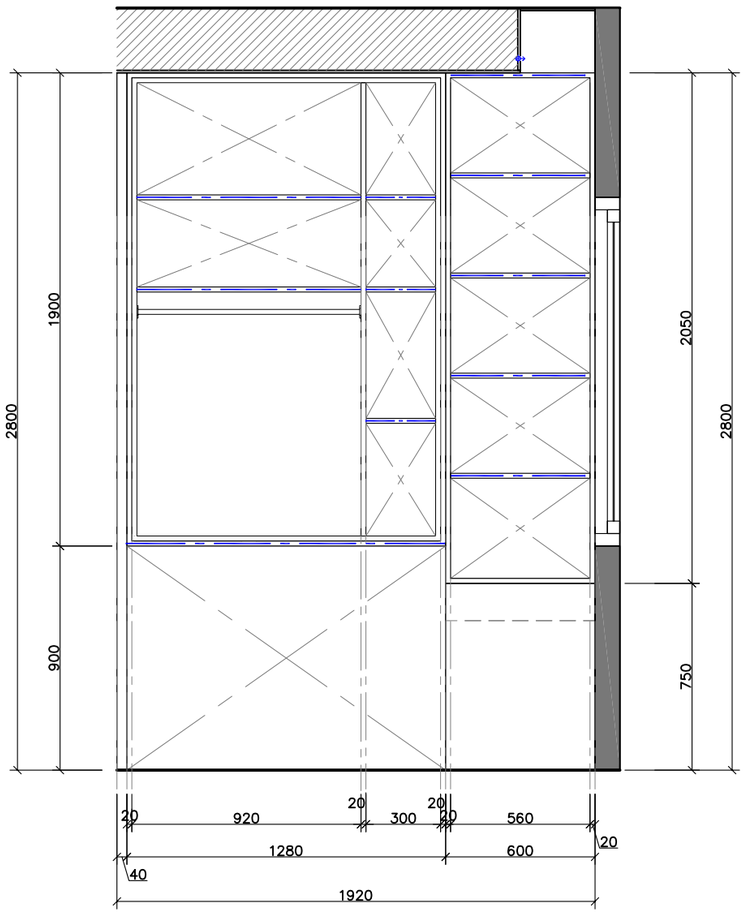

แบบขยาย ตู้เสื้อผ้า (ภายใน)
บริเวณ ห้องนอน 2
ELEVATION 1

scale 1:25

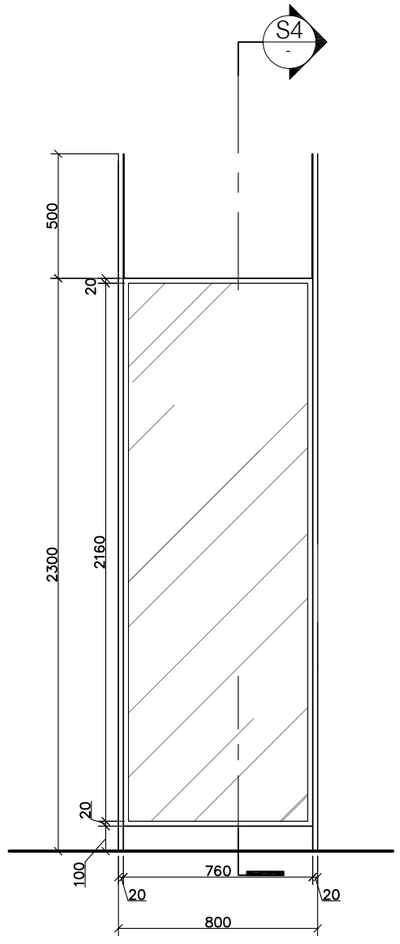

แบบขยาย กระจก
บริเวณ ห้องนอน 2
ELEVATION 1

scale 1:25

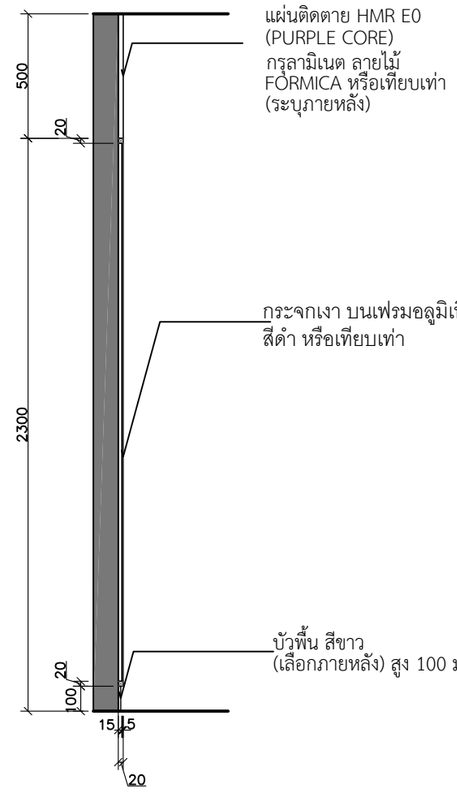

แบบขยาย กระจก
บริเวณ ห้องนอน 2
SECTION 4

scale 1:25

SPACEMAN

PROJECT: SONIA HOUSE

LOCATION: REIGNWOOD PARK
LAMLUKKA, PATHUM THANI

ARCHITECT:

INTERIOR DESIGNER: ปรัตถกร ประมุขกุล ภ-สน 1438

STRUCTURAL ENGINEER:

TITLE: 2nd FLOOR
ELEVATION
แบบขยาย ตู้เสื้อผ้า

2026-06-18
ID3-01

1:25 @ A3

Note: SPACEMAN takes no responsibility for dimensions obtained by scaling from this drawing. If no dimension is shown the recipient must ascertain the dimension specifically from the architect or by site measurement and may not rely on the drawing. Supply of the drawing in digital form is solely for convenience and no reliance may be placed on any data in digital form. All data must be checked against hard copy. This drawing is issued for design intent only and should not be used for construction unless stated. This drawing is the property of SPACEMAN

DETAIL 1

scale 1:5

DETAIL 2

scale 1:5

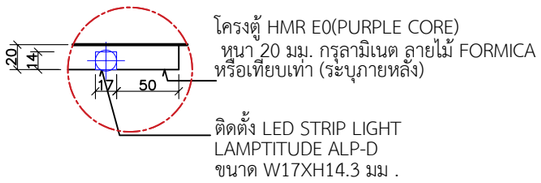

DETAIL 3

scale 1:5

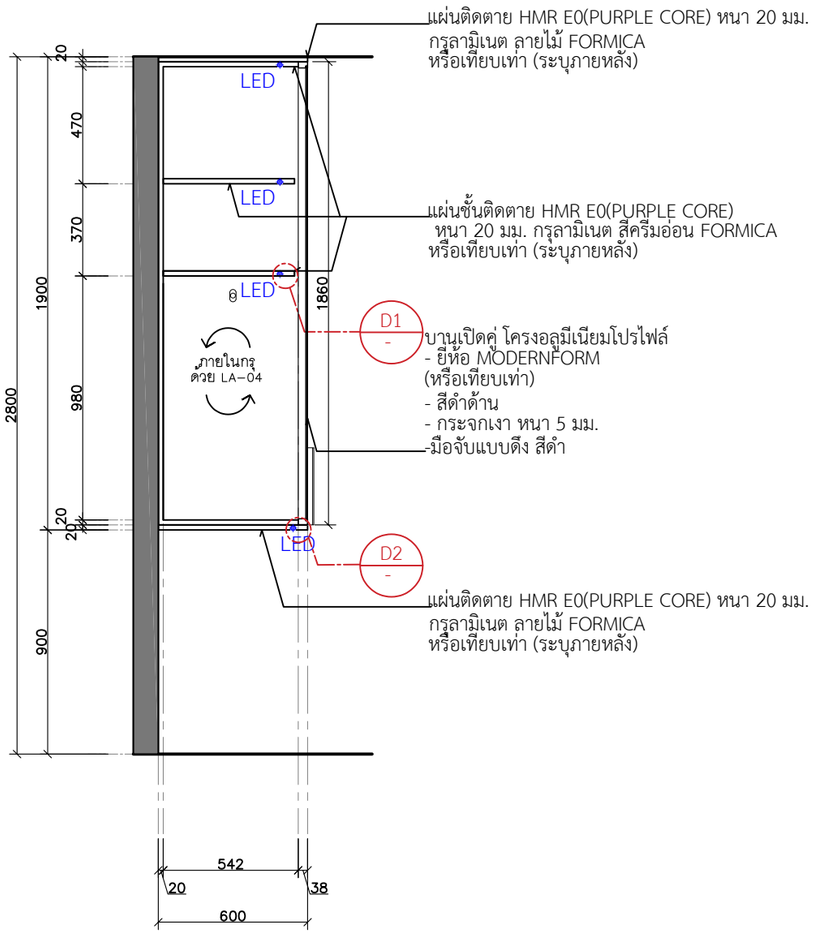

แบบขยาย ตู้เสื้อผ้า
บริเวณ ห้องนอน 2
SECTION 1

scale 1:25

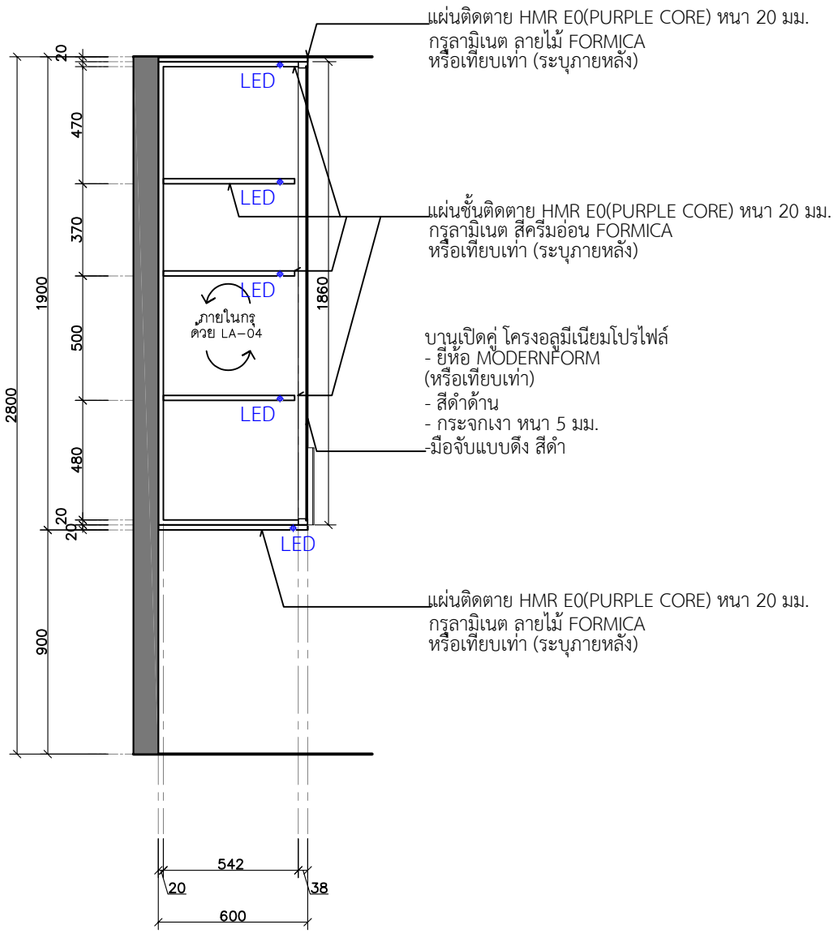

แบบขยาย ตู้เสื้อผ้า
บริเวณ ห้องนอน 2
SECTION2

scale 1:25

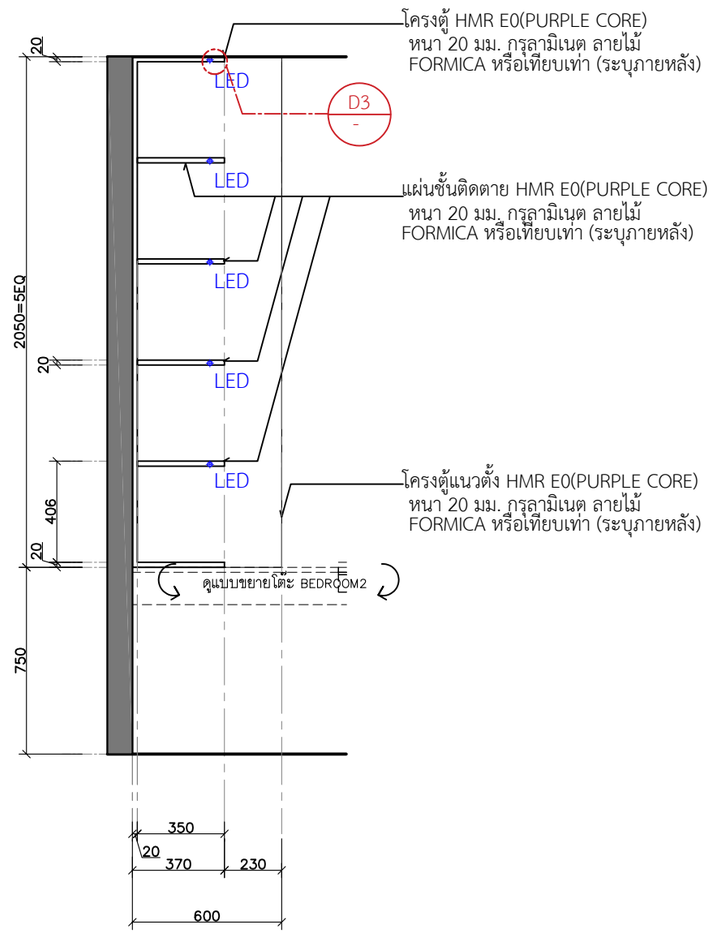

แบบขยาย ตู้เสื้อผ้า
บริเวณ ห้องนอน 2
SECTION 3

scale 1:25

SPACEMAN

PROJECT | SONIA HOUSE

LOCATION | REIGNWOOD PARK
LAMLUKKA, PATHUM THANI

ARCHITECT

INTERIOR DESIGNER | ปรัตถกร ประมุขกุล ภ-สน 1438

STRUCTURAL ENGINEER

TITLE | 2nd FLOOR
SECTION
แบบขยาย ตู้เสื้อผ้า

2026-06-18
ID3-02

1:25 @ A3

Note: SPACEMAN takes no responsibility for dimensions obtained by scaling from this drawing. If no dimension is shown the recipient must ascertain the dimension specifically from the architect or by site measurement and may not rely on the drawing. Supply of the drawing in digital form is solely for convenience and no reliance may be placed on any data in digital form. All data must be checked against hard copy. This drawing is issued for design intent only and should not be used for construction unless stated. This drawing is the property of SPACEMAN

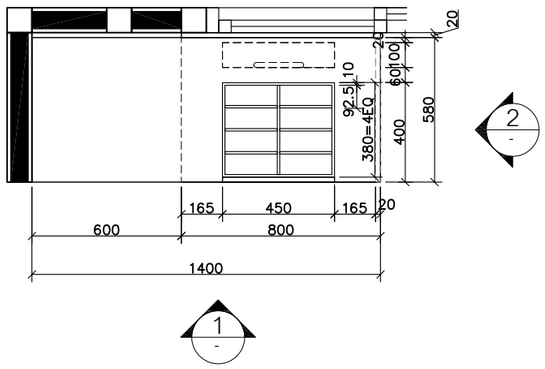

แบบขยาย โต๊ะแต่งหน้า
บริเวณ ห้องนอน 2
PLAN
scale 1:25

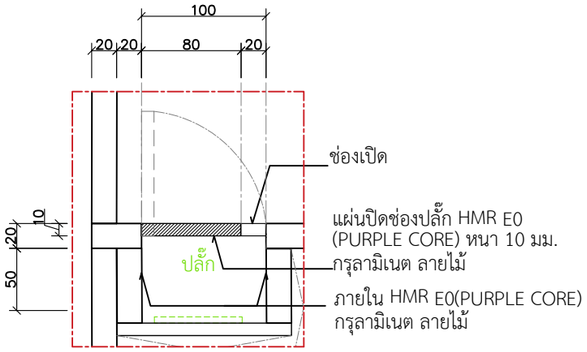

DETAIL 2
scale 1:5

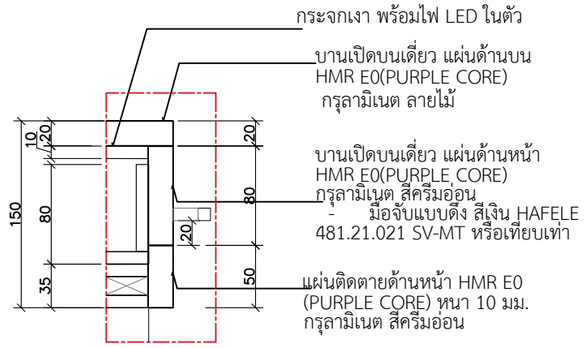

DETAIL 1
scale 1:5

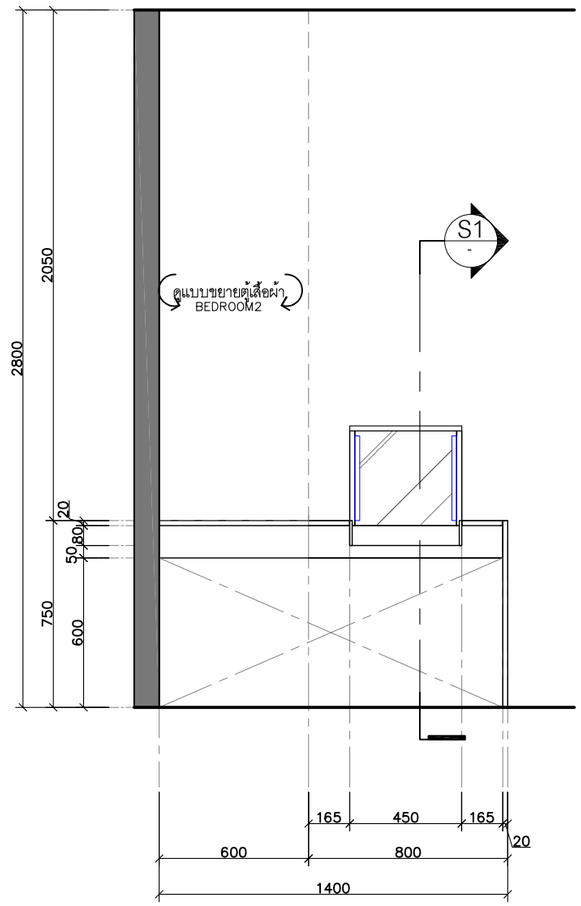

แบบขยาย โต๊ะแต่งหน้า
บริเวณ ห้องนอน 2
ELEVATION 1
scale 1:25

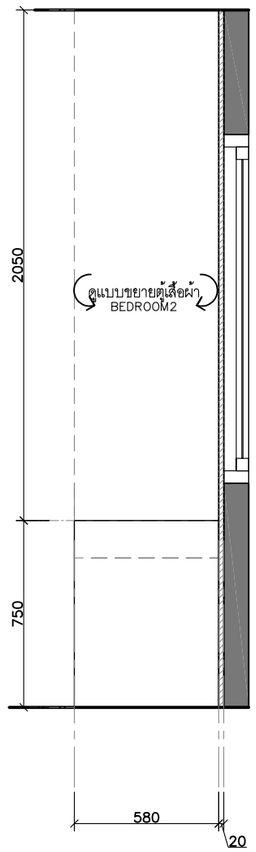

แบบขยาย โต๊ะแต่งหน้า
บริเวณ ห้องนอน 2
ELEVATION 2
scale 1:25

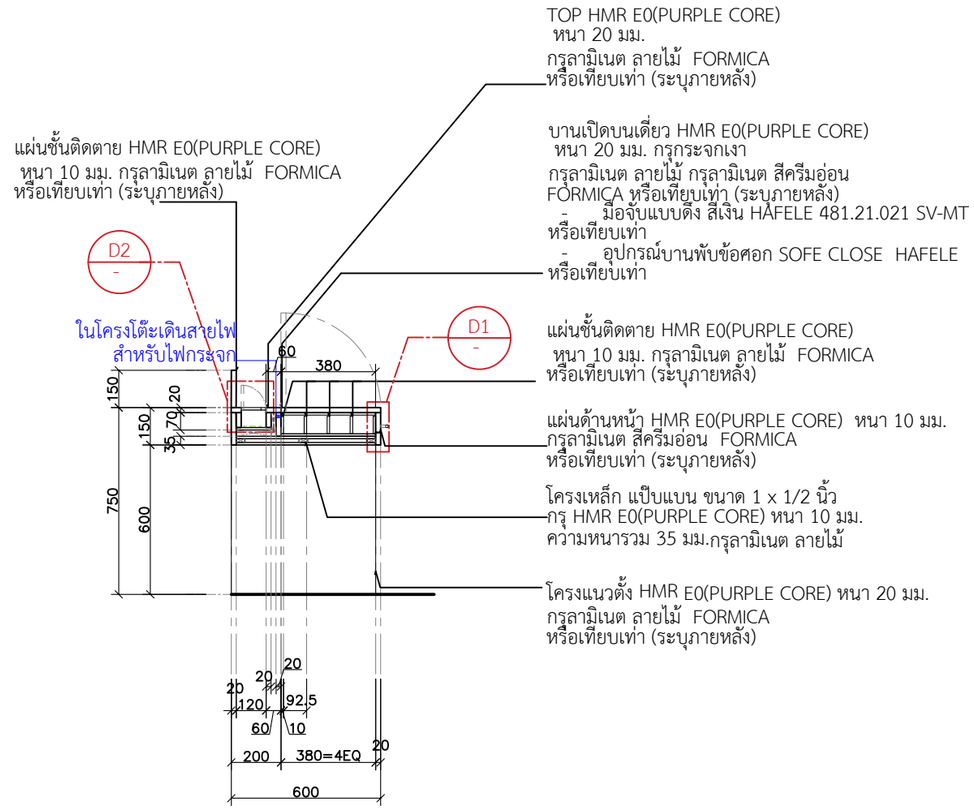

แบบขยาย โต๊ะแต่งหน้า
บริเวณ ห้องนอน 2
SECTION 1
scale 1:25

SPACEMAN

PROJECT: SONIA HOUSE
LOCATION: REIGNWOOD PARK
LAMLUKKA, PATHUM THANI
ARCHITECT:
INTERIOR DESIGNER: ปรัตถกร ประมุขกุล ภ-สน 1438
STRUCTURAL ENGINEER:
TITLE: 2nd FLOOR
ELEVATION
แบบขยาย โต๊ะแต่งหน้า

2026-06-18
ID3-03
1:25 @ A3

Note: SPACEMAN takes no responsibility for dimensions obtained by scaling from this drawing. If no dimension is shown the recipient must ascertain the dimension specifically from the architect or by site measurement and may not rely on the drawing. Supply of the drawing in digital form is solely for convenience and no reliance may be placed on any data in digital form. All data must be checked against hard copy. This drawing is issued for design intent only and should not be used for construction unless stated. This drawing is the property of SPACEMAN

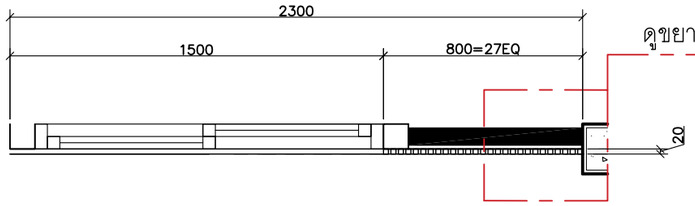

ดูขยาย PLAN DETAIL

แบบขยาย หัวเตียง
บริเวณ ห้องนอน 2
PLAN
scale 1:25

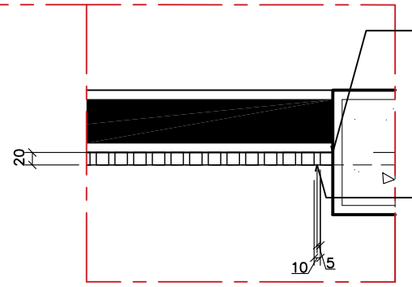

ระแนง HMR E0(PURPLE CORE)
ขนาด 20x20 มม. กรุลามิเนต ลายไม้ หรือเทียบเท่า
เว้นช่องห่าง 10มม.
(ระบุภายหลัง)

หัวเตียง โครง HMR E0(PURPLE CORE)
กรุลามิเนต ลายไม้หรือเทียบเท่า (ระบุภายหลัง)

PLAN DETAIL
scale 1:10

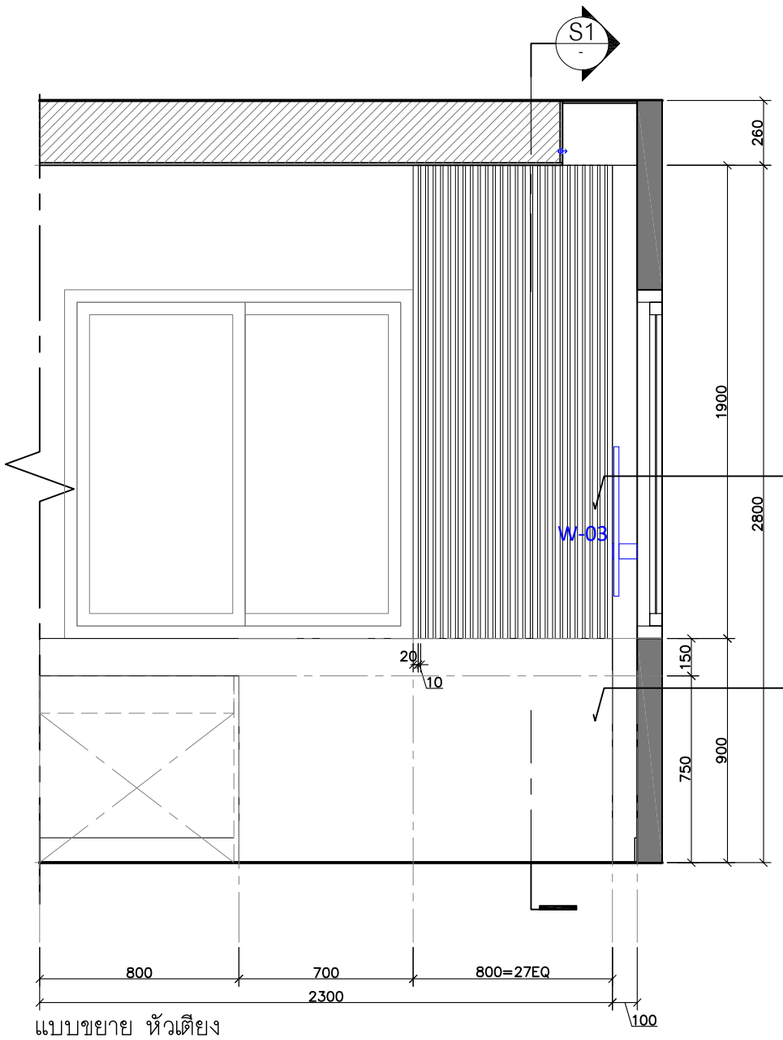

ระแนง HMR E0(PURPLE CORE)
ขนาด 20x20 มม. กรุลามิเนต ลายไม้ หรือเทียบเท่า
เว้นช่องห่าง 10มม.
(ระบุภายหลัง)

หัวเตียง โครง HMR E0(PURPLE CORE)
กรุลามิเนต ลายไม้หรือเทียบเท่า (ระบุภายหลัง)

แบบขยาย หัวเตียง
บริเวณ ห้องนอน 2
ELEVATION 1
scale 1:25

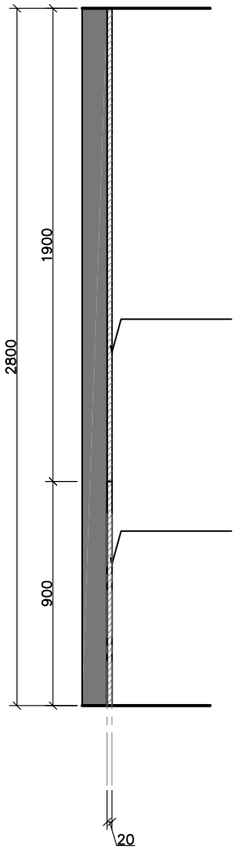

ระแนง HMR E0(PURPLE CORE)
ขนาด 20x20 มม. กรุลามิเนต ลายไม้ หรือเทียบเท่า
เว้นช่องห่าง 10มม.
(ระบุภายหลัง)

หัวเตียง โครง HMR E0(PURPLE CORE)
กรุลามิเนต ลายไม้หรือเทียบเท่า (ระบุภายหลัง)

แบบขยาย หัวเตียง
บริเวณ ห้องนอน 2
SECTION 1
scale 1:25

SPACEMAN

PROJECT | SONIA HOUSE
LOCATION | REIGNWOOD PARK
LAMLUKKA, PATHUM THANI
ARCHITECT |
INTERIOR DESIGNER | ปรัตถกร ประมุขกุล ภ-สน 1438
STRUCTURAL ENGINEER |
TITLE | 2nd FLOOR (ห้องนอน 2)
PLAN ,ELEVATION ,SECTION
แบบขยาย หัวเตียง

2026-06-18
ID3-04
1:25 @ A3

Note: SPACEMAN takes no responsibility for dimensions obtained by scaling from this drawing. If no dimension is shown the recipient must ascertain the dimension specifically from the architect or by site measurement and may not rely on the drawing. Supply of the drawing in digital form is solely for convenience and no reliance may be placed on any data in digital form. All data must be checked against hard copy. This drawing is issued for design intent only and should not be used for construction unless stated. This drawing is the property of SPACEMAN

SONIA HOUSE

REIGNWOOD PARK

LAMLUKKA, PATHUM THANI

แบบขยายห้องนอน 3

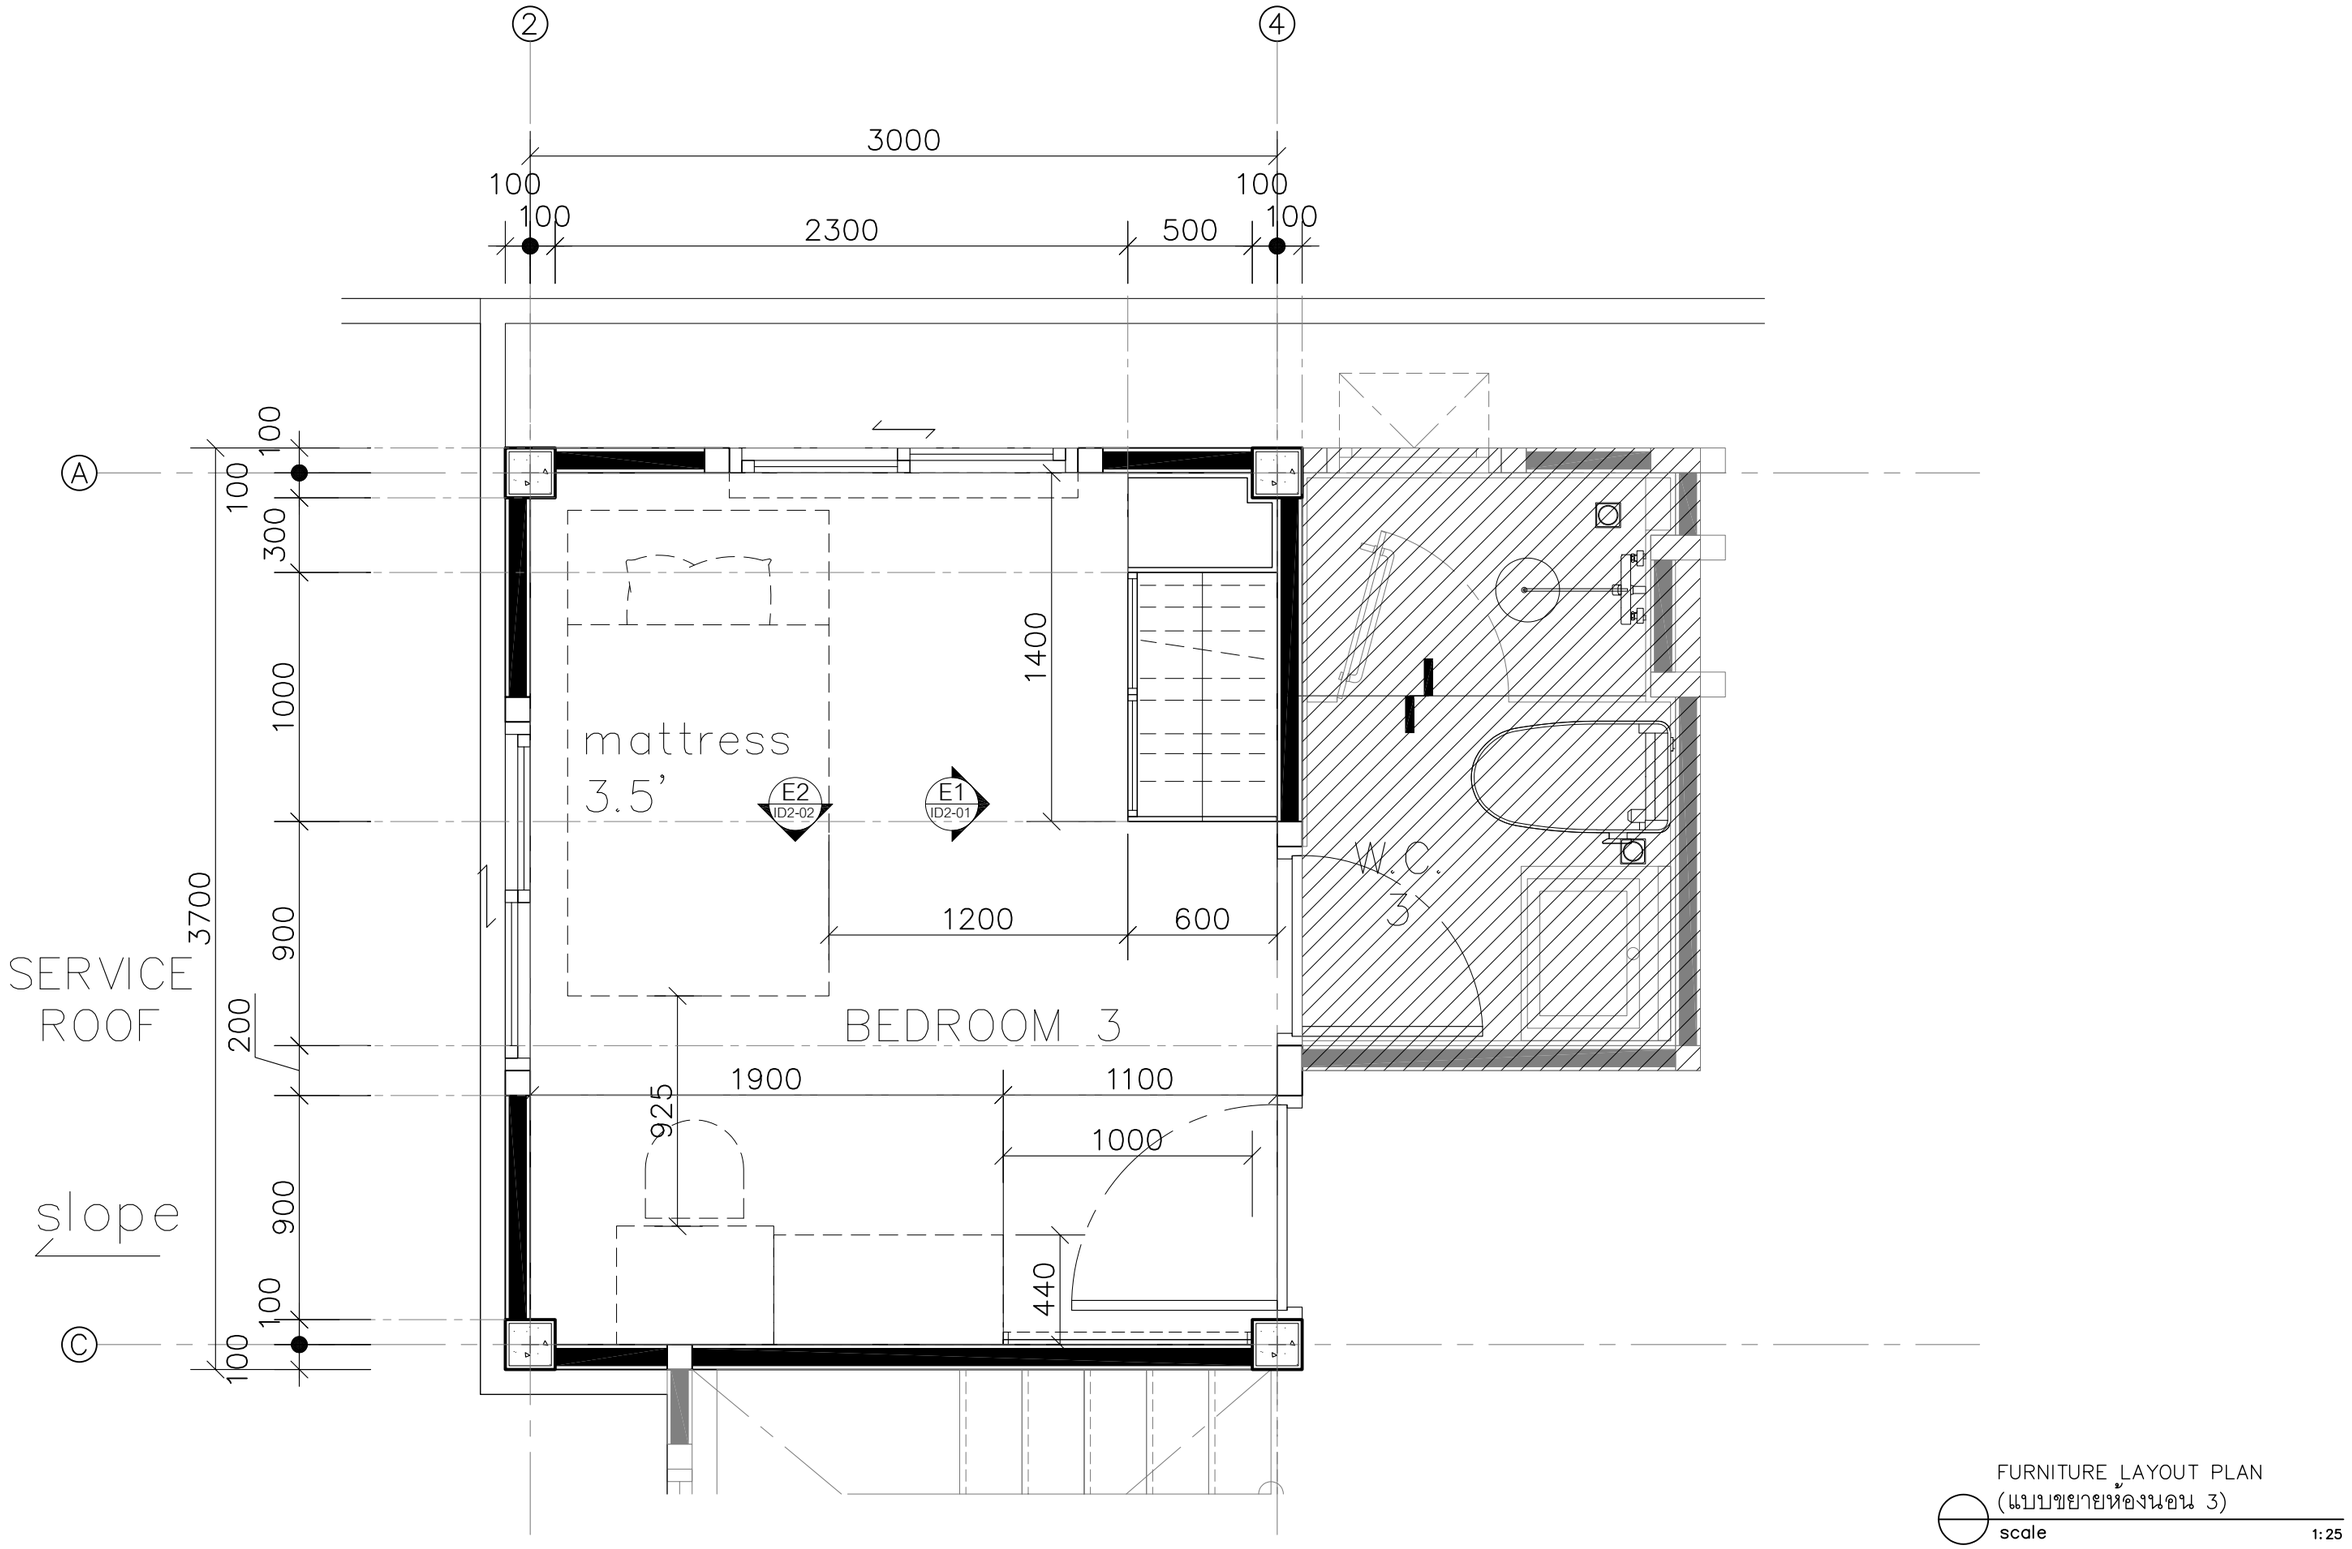

FURNITURE LAYOUT PLAN
(แบบขยายห้องนอน 3)
scale 1:25

SPACEMAN

PROJECT: SONIA HOUSE

LOCATION: REIGNWOOD PARK
LAMLUKKA, PATHUM THANI

ARCHITECT:

INTERIOR DESIGNER: ปรัตถกร ประมุขกุล ภ-สน 1438

STRUCTURAL ENGINEER:

TITLE: 2nd FLOOR
FURNITURE LAYOUT PLAN
(แบบขยายห้องนอน 3)

2026-06-18
ID1-01
1:25 @ A3

Note: SPACEMAN takes no responsibility for dimensions obtained by scaling from this drawing. If no dimension is shown the recipient must ascertain the dimension specifically from the architect or by site measurement and may not rely on the drawing. Supply of the drawing in digital form is solely for convenience and no reliance may be placed on any data in digital form. All data must be checked against hard copy. This drawing is issued for design intent only and should not be used for construction unless stated. This drawing is the property of SPACEMAN

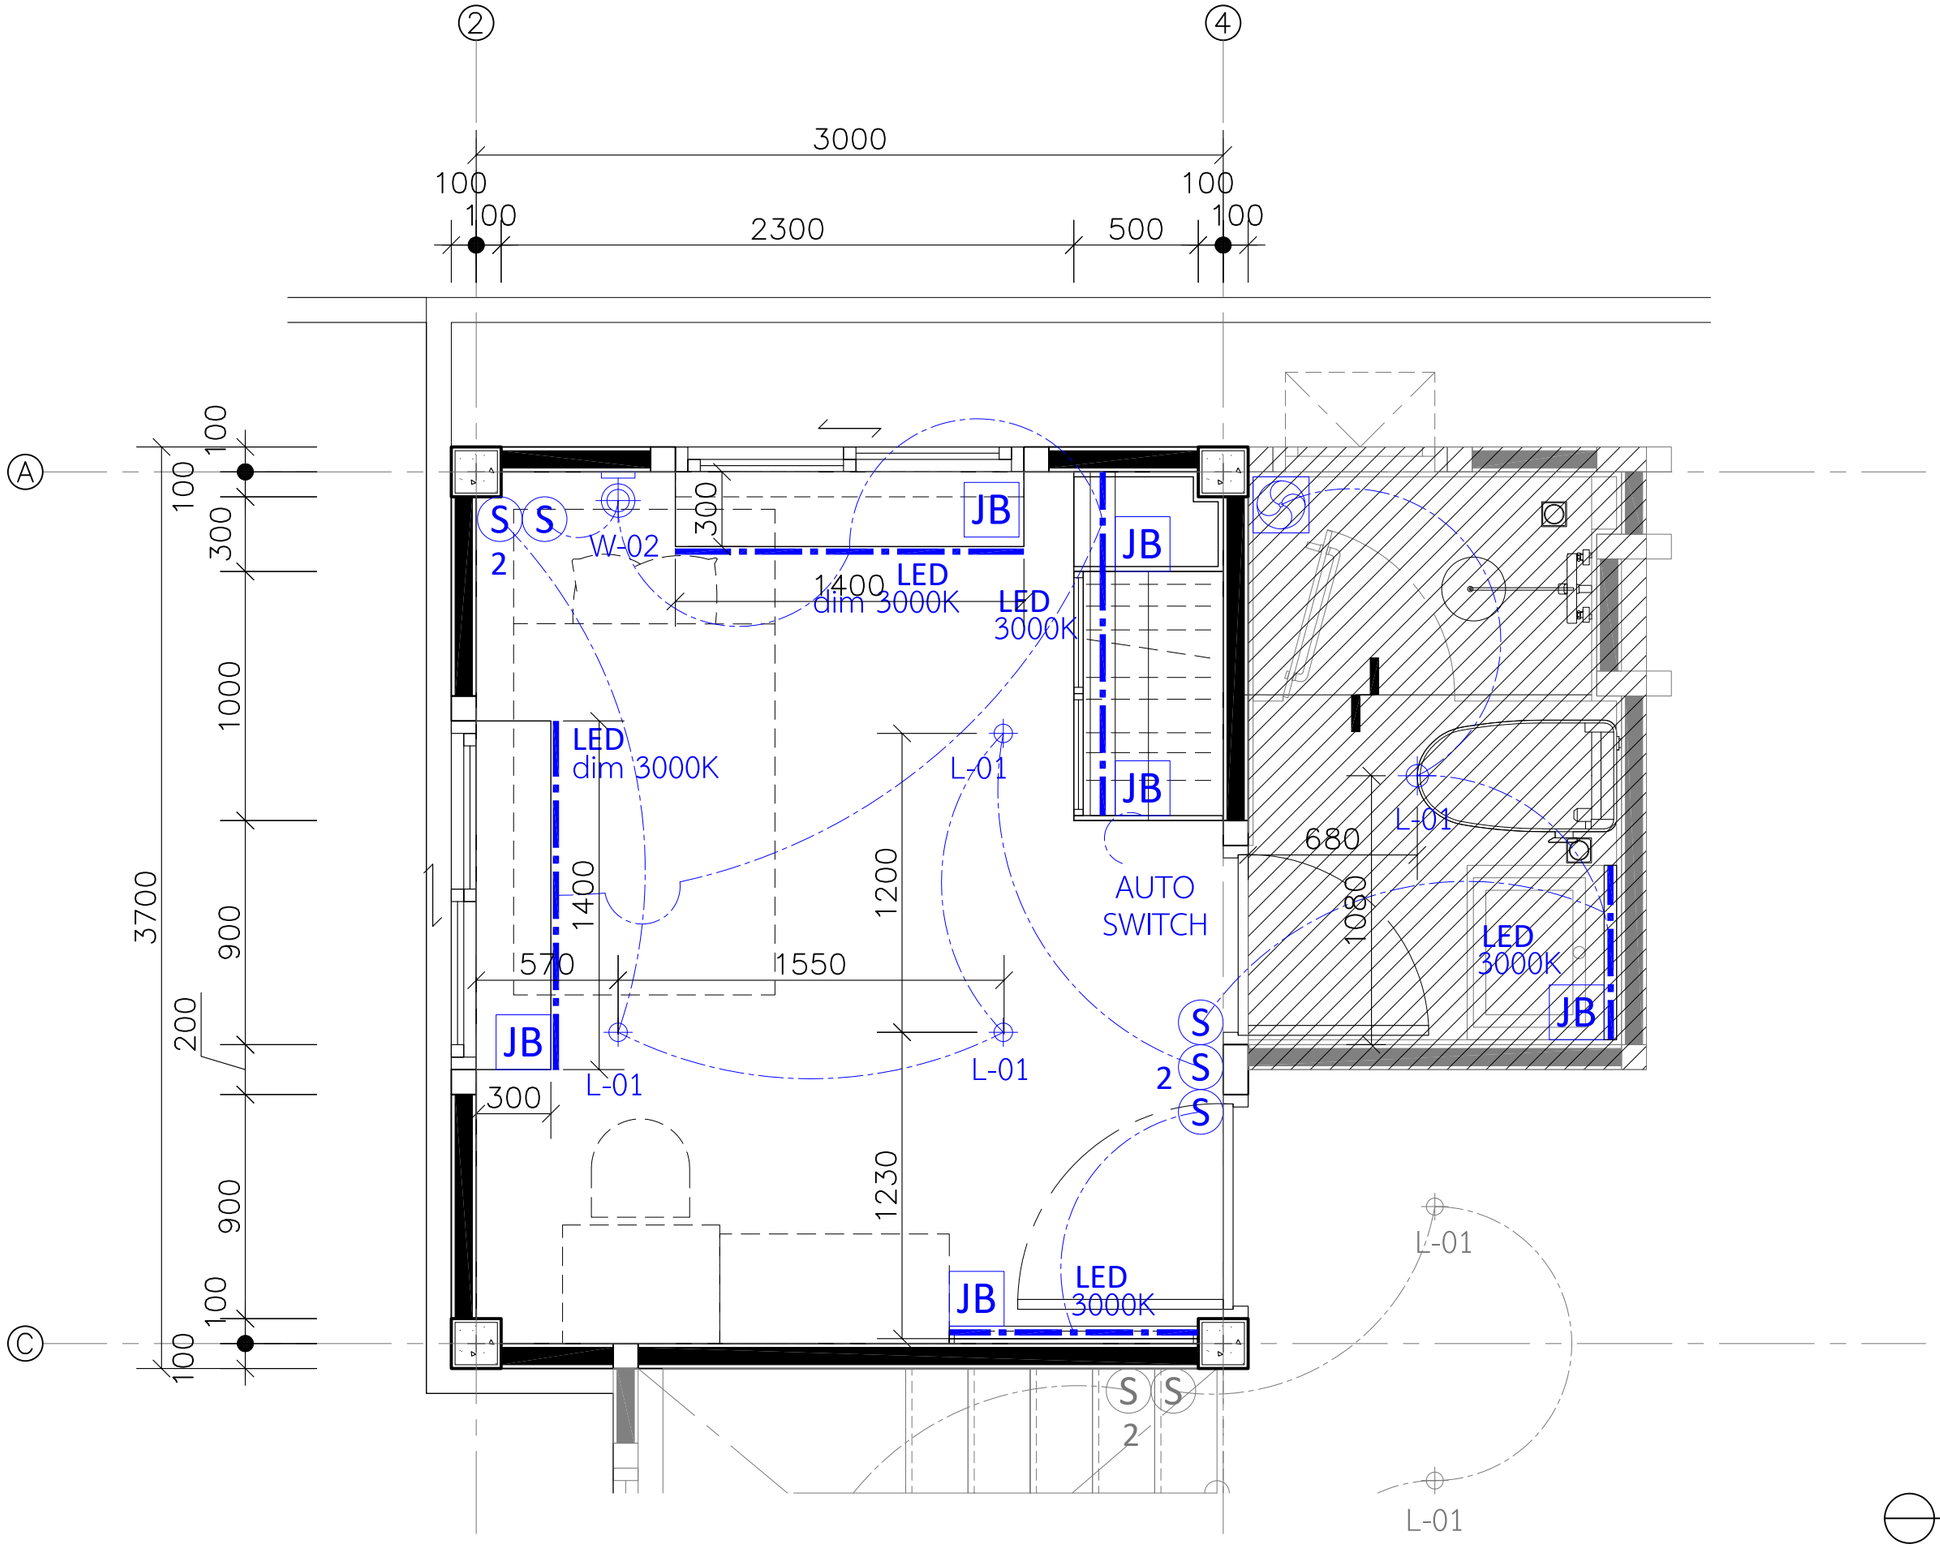

LIGHTING PLAN
(แบบขยายห้องนอน 3)
scale 1:25

SPACEMAN

PROJECT: SONIA HOUSE

LOCATION: REIGNWOOD PARK
LAMLUKKA, PATHUM THANI

ARCHITECT

INTERIOR DESIGNER: ปรัตถกร ประมุขกุล ภ-สน 1438

STRUCTURAL ENGINEER

TITLE: 2nd FLOOR
LIGHTING PLAN
(แบบขยายห้องนอน 3)

2026-06-18
ID1-02

1:25 @ A3

Note: SPACEMAN takes no responsibility for dimensions obtained by scaling from this drawing. If no dimension is shown the recipient must ascertain the dimension specifically from the architect or by site measurement and may not rely on the drawing. Supply of the drawing in digital form is solely for convenience and no reliance may be placed on any data in digital form. All data must be checked against hard copy. This drawing is issued for design intent only and should not be used for construction unless stated. This drawing is the property of SPACEMAN

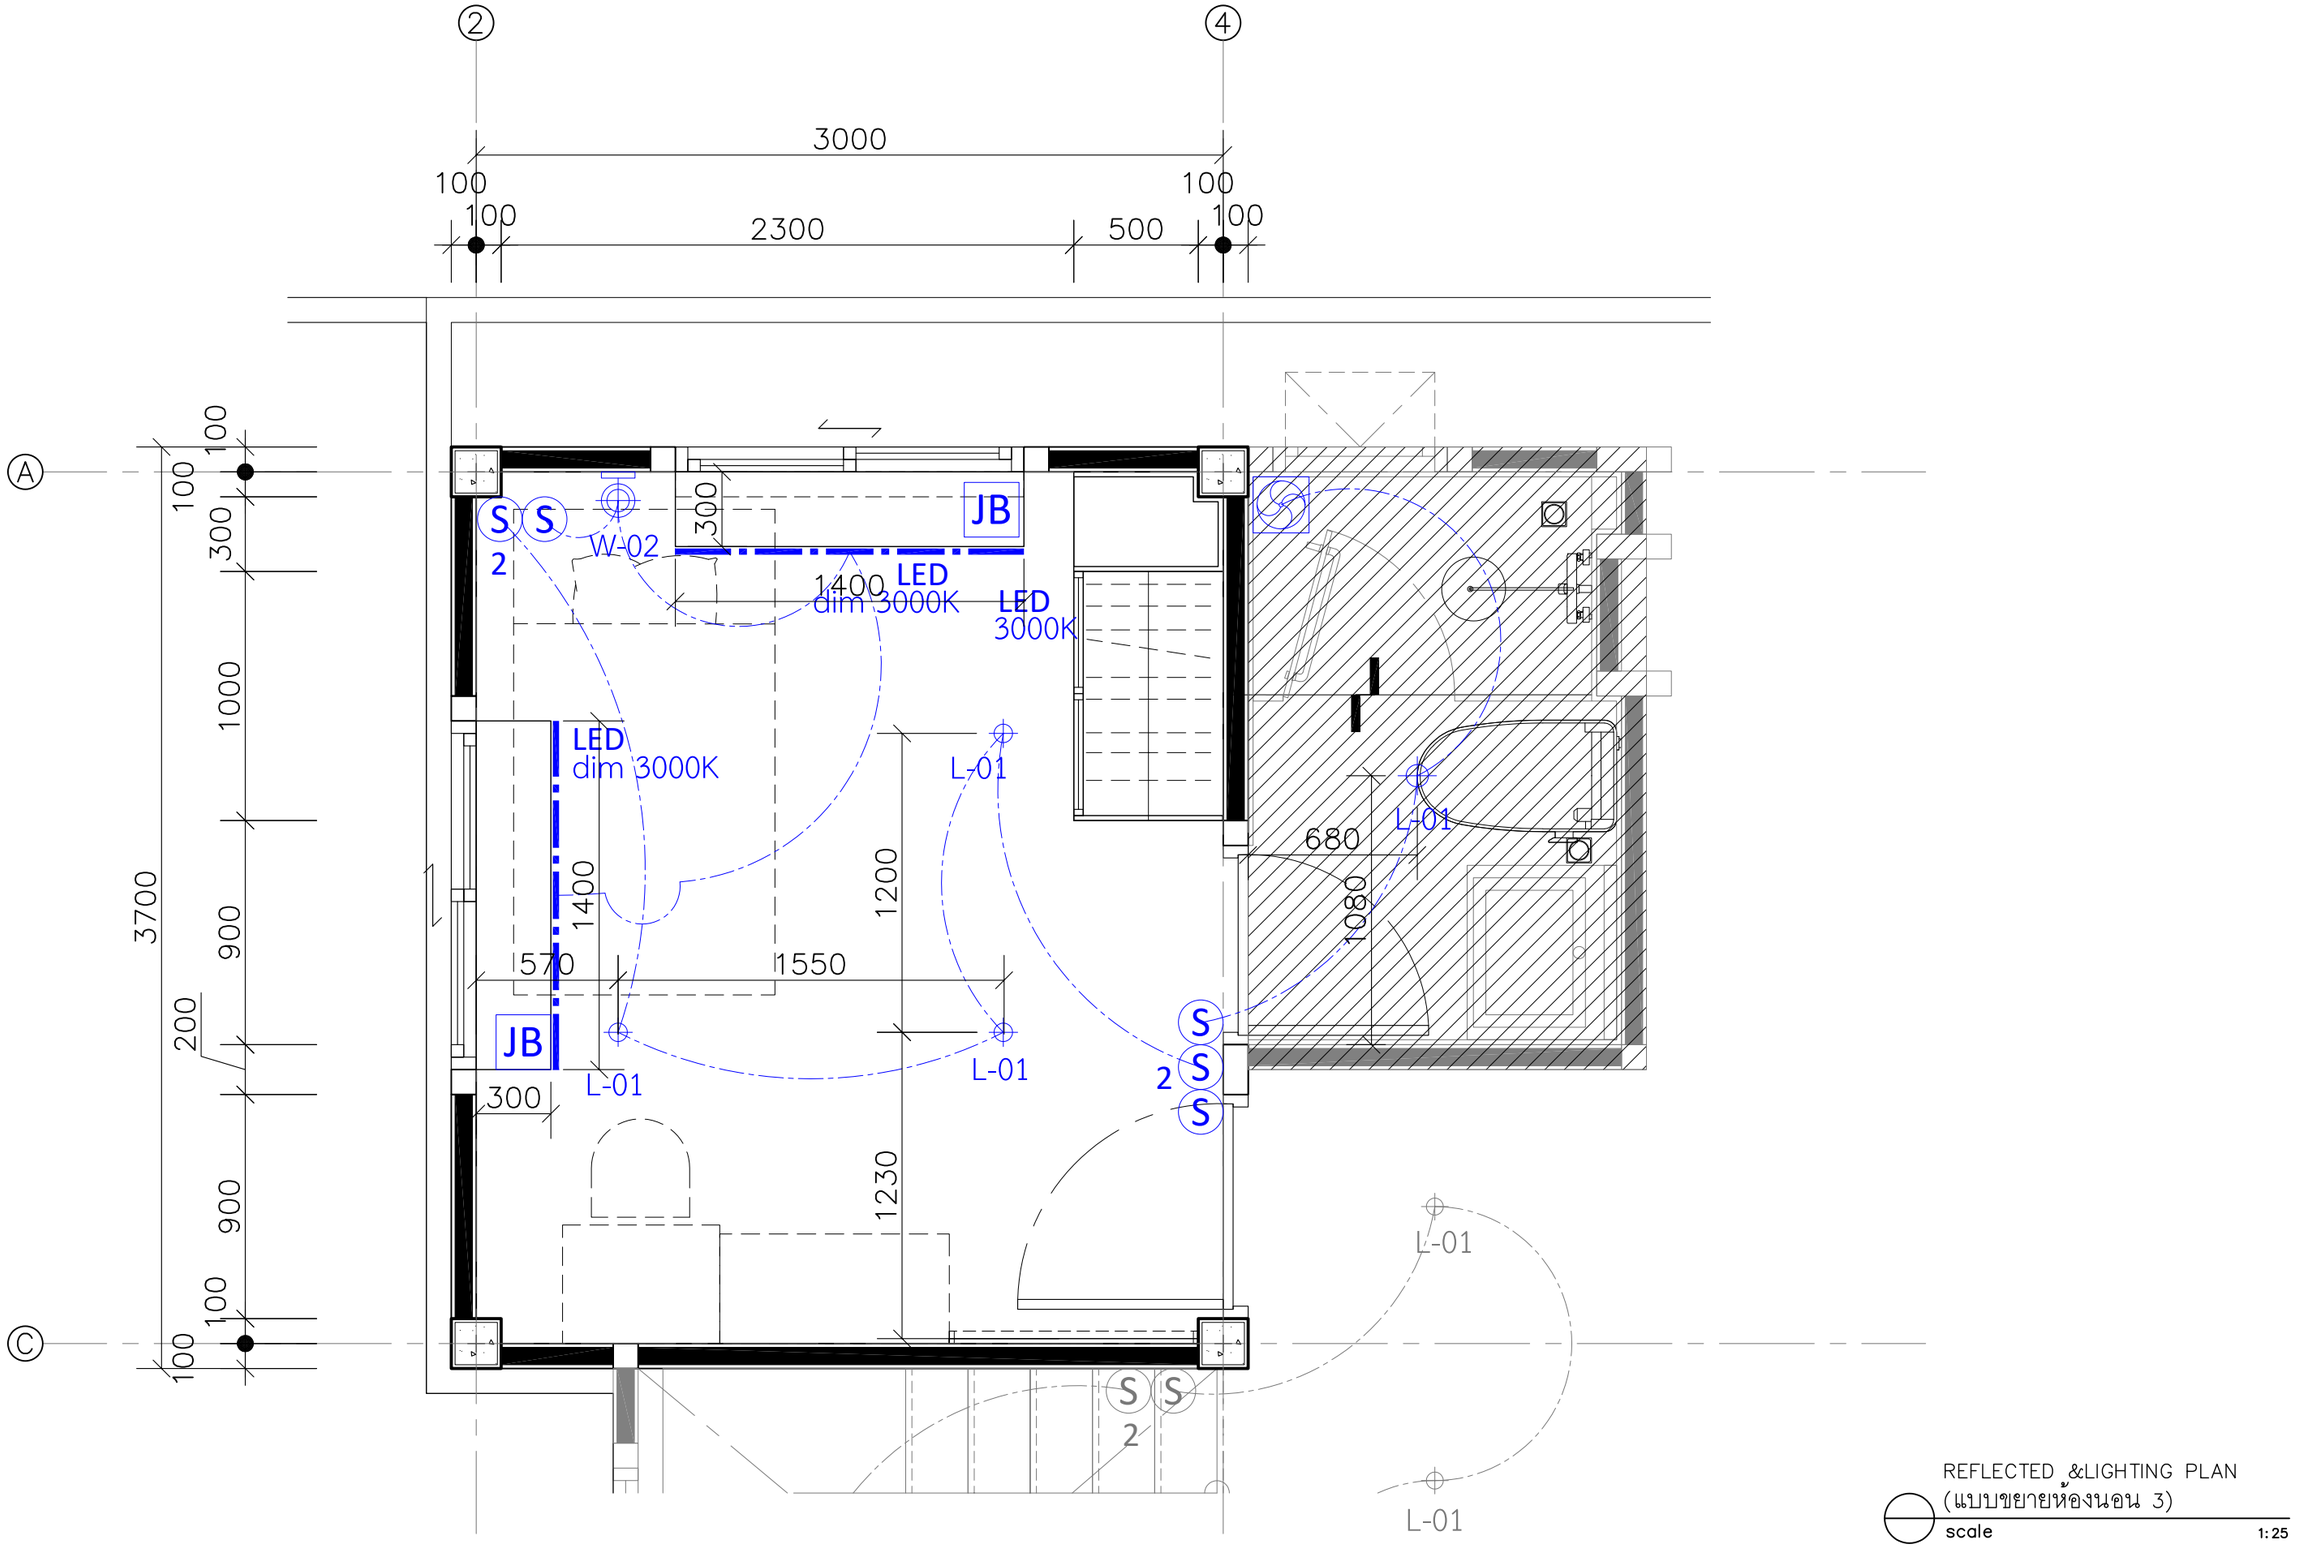

REFLECTED &LIGHTING PLAN
(แบบขยายห้องนอน 3)
scale 1:25

SPACEMAN	PROJECT: SONIA HOUSE	LOCATION: REIGNWOOD PARK LAMLUKKA, PATHUM THANI	ARCHITECT	INTERIOR DESIGNER: ปรัตถกร ประมุขกุล ภ-สน 1438	STRUCTURAL ENGINEER	TITLE: 2nd FLOOR LIGHTING PLAN (แบบขยายห้องนอน 3)	2026-06-18 ID1-02

Note: SPACEMAN takes no responsibility for dimensions obtained by scaling from this drawing. If no dimension is shown the recipient must ascertain the dimension specifically from the architect or by site measurement and may not rely on the drawing. Supply of the drawing in digital form is solely for convenience and no reliance may be placed on any data in digital form. All data must be checked against hard copy. This drawing is issued for design intent only and should not be used for construction unless stated. This drawing is the property of SPACEMAN

1:25 @ A3

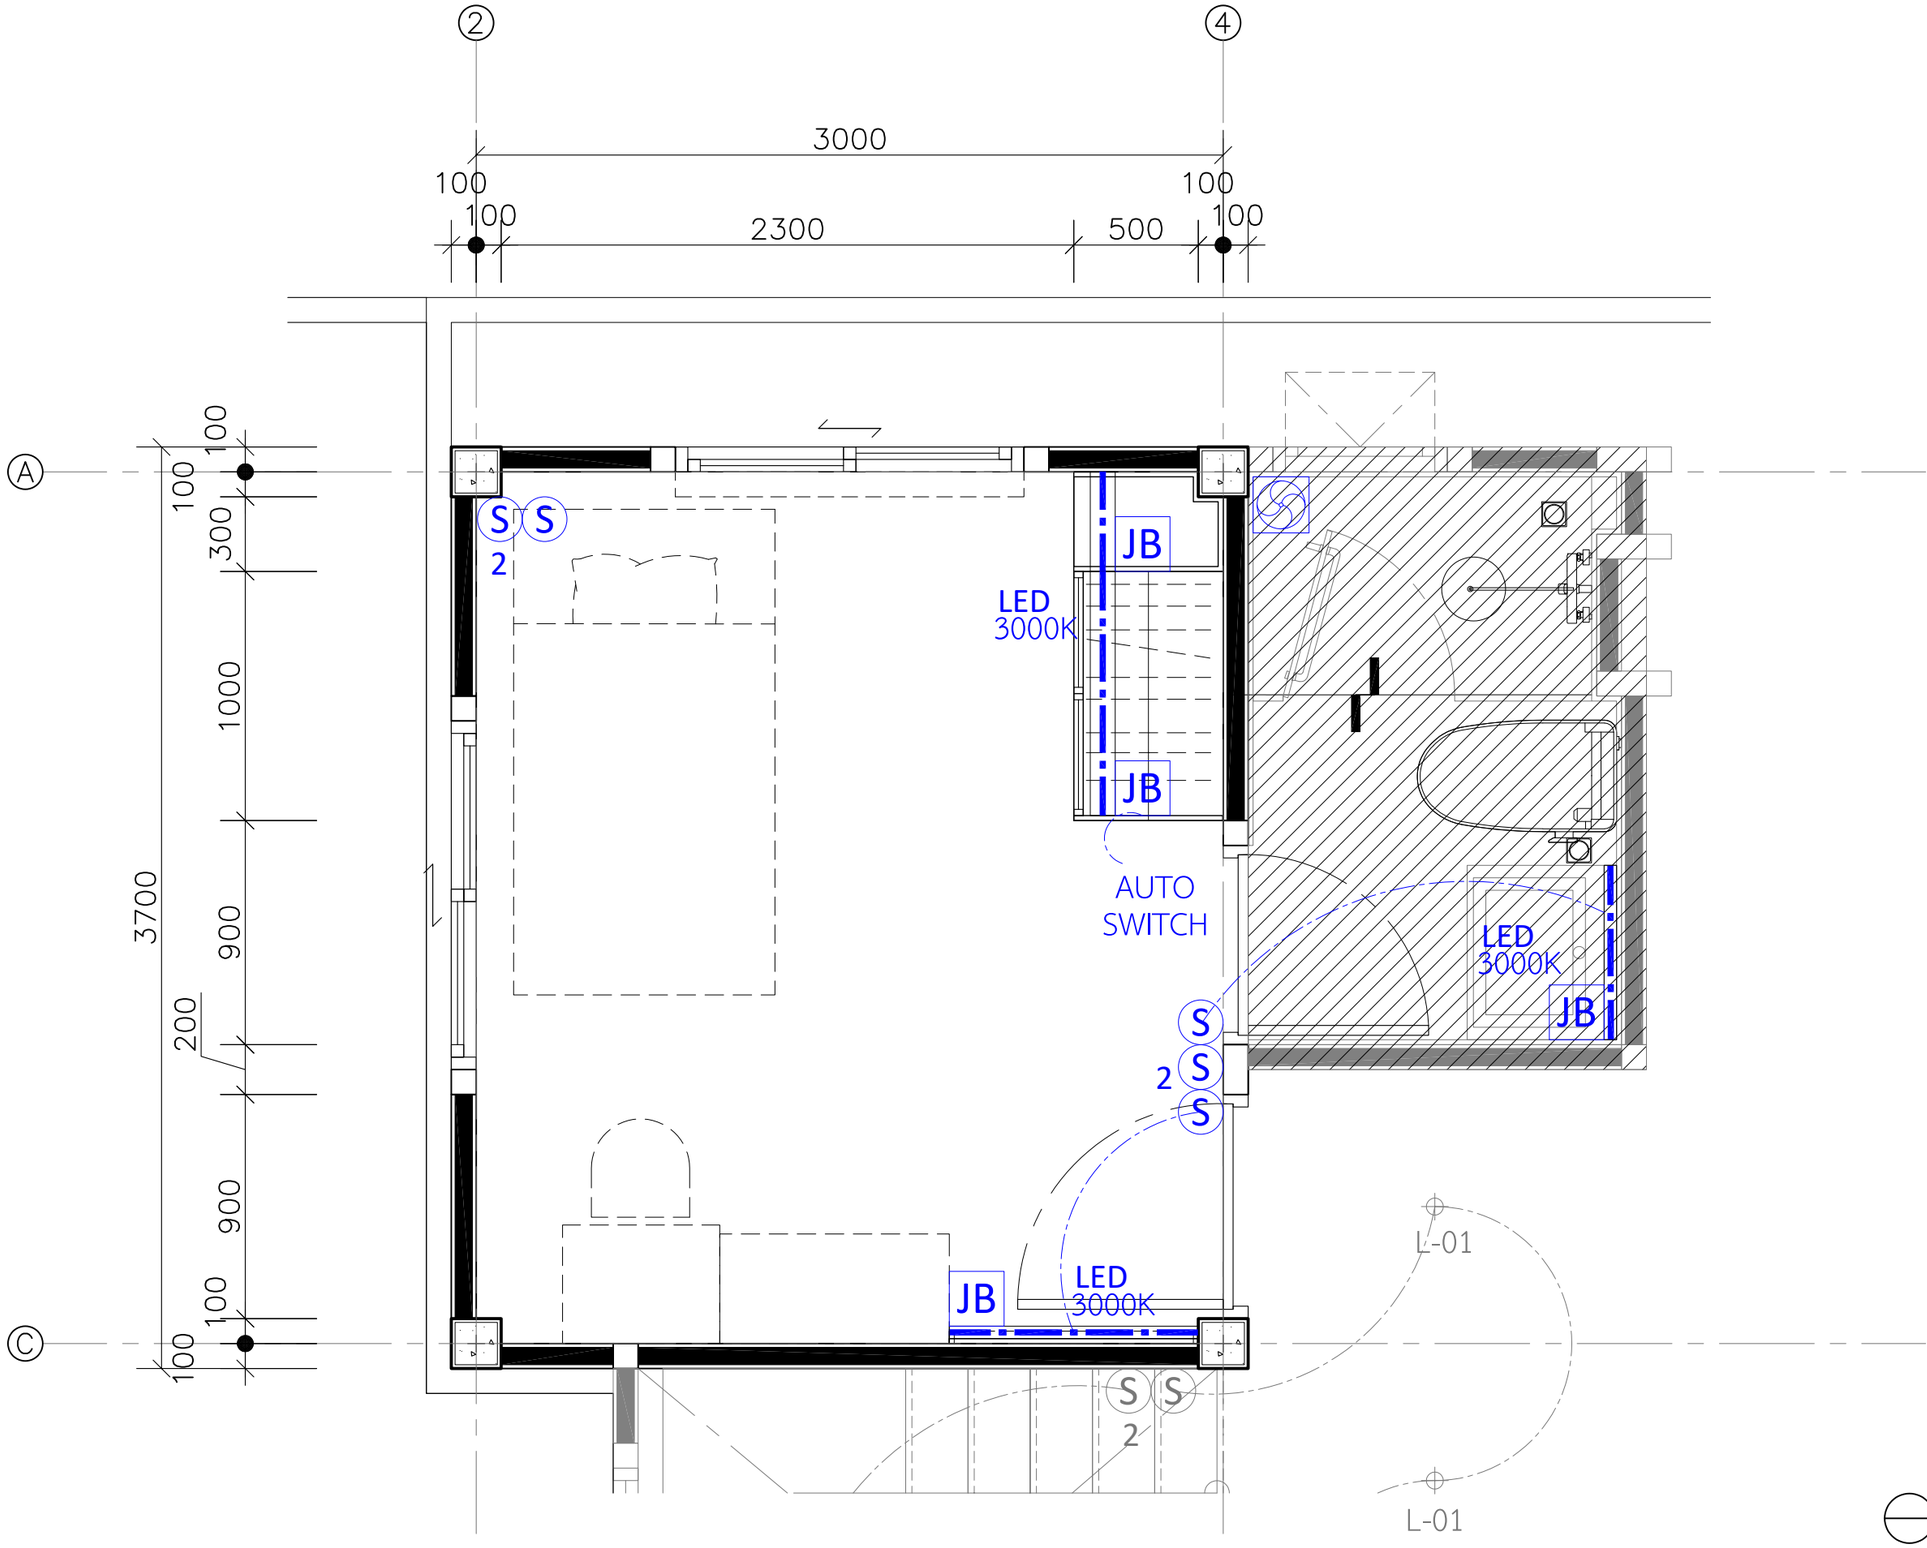

GROUND & FURNITURE PLAN
(แบบขยายห้องนอน 3)
scale 1:25

SPACEMAN

PROJECT | SONIA HOUSE

LOCATION | REIGNWOOD PARK
LAMLUKKA, PATHUM THANI

ARCHITECT

INTERIOR DESIGNER | ปรัตถกร ประมุขกุล ภ-สน 1438

STRUCTURAL ENGINEER

TITLE | 2nd FLOOR
LIGHTING PLAN
(แบบขยายห้องนอน 3)

2026-06-18
ID1-02
1:25 @ A3

Note: SPACEMAN takes no responsibility for dimensions obtained by scaling from this drawing. If no dimension is shown the recipient must ascertain the dimension specifically from the architect or by site measurement and may not rely on the drawing. Supply of the drawing in digital form is solely for convenience and no reliance may be placed on any data in digital form. All data must be checked against hard copy. This drawing is issued for design intent only and should not be used for construction unless stated. This drawing is the property of SPACEMAN

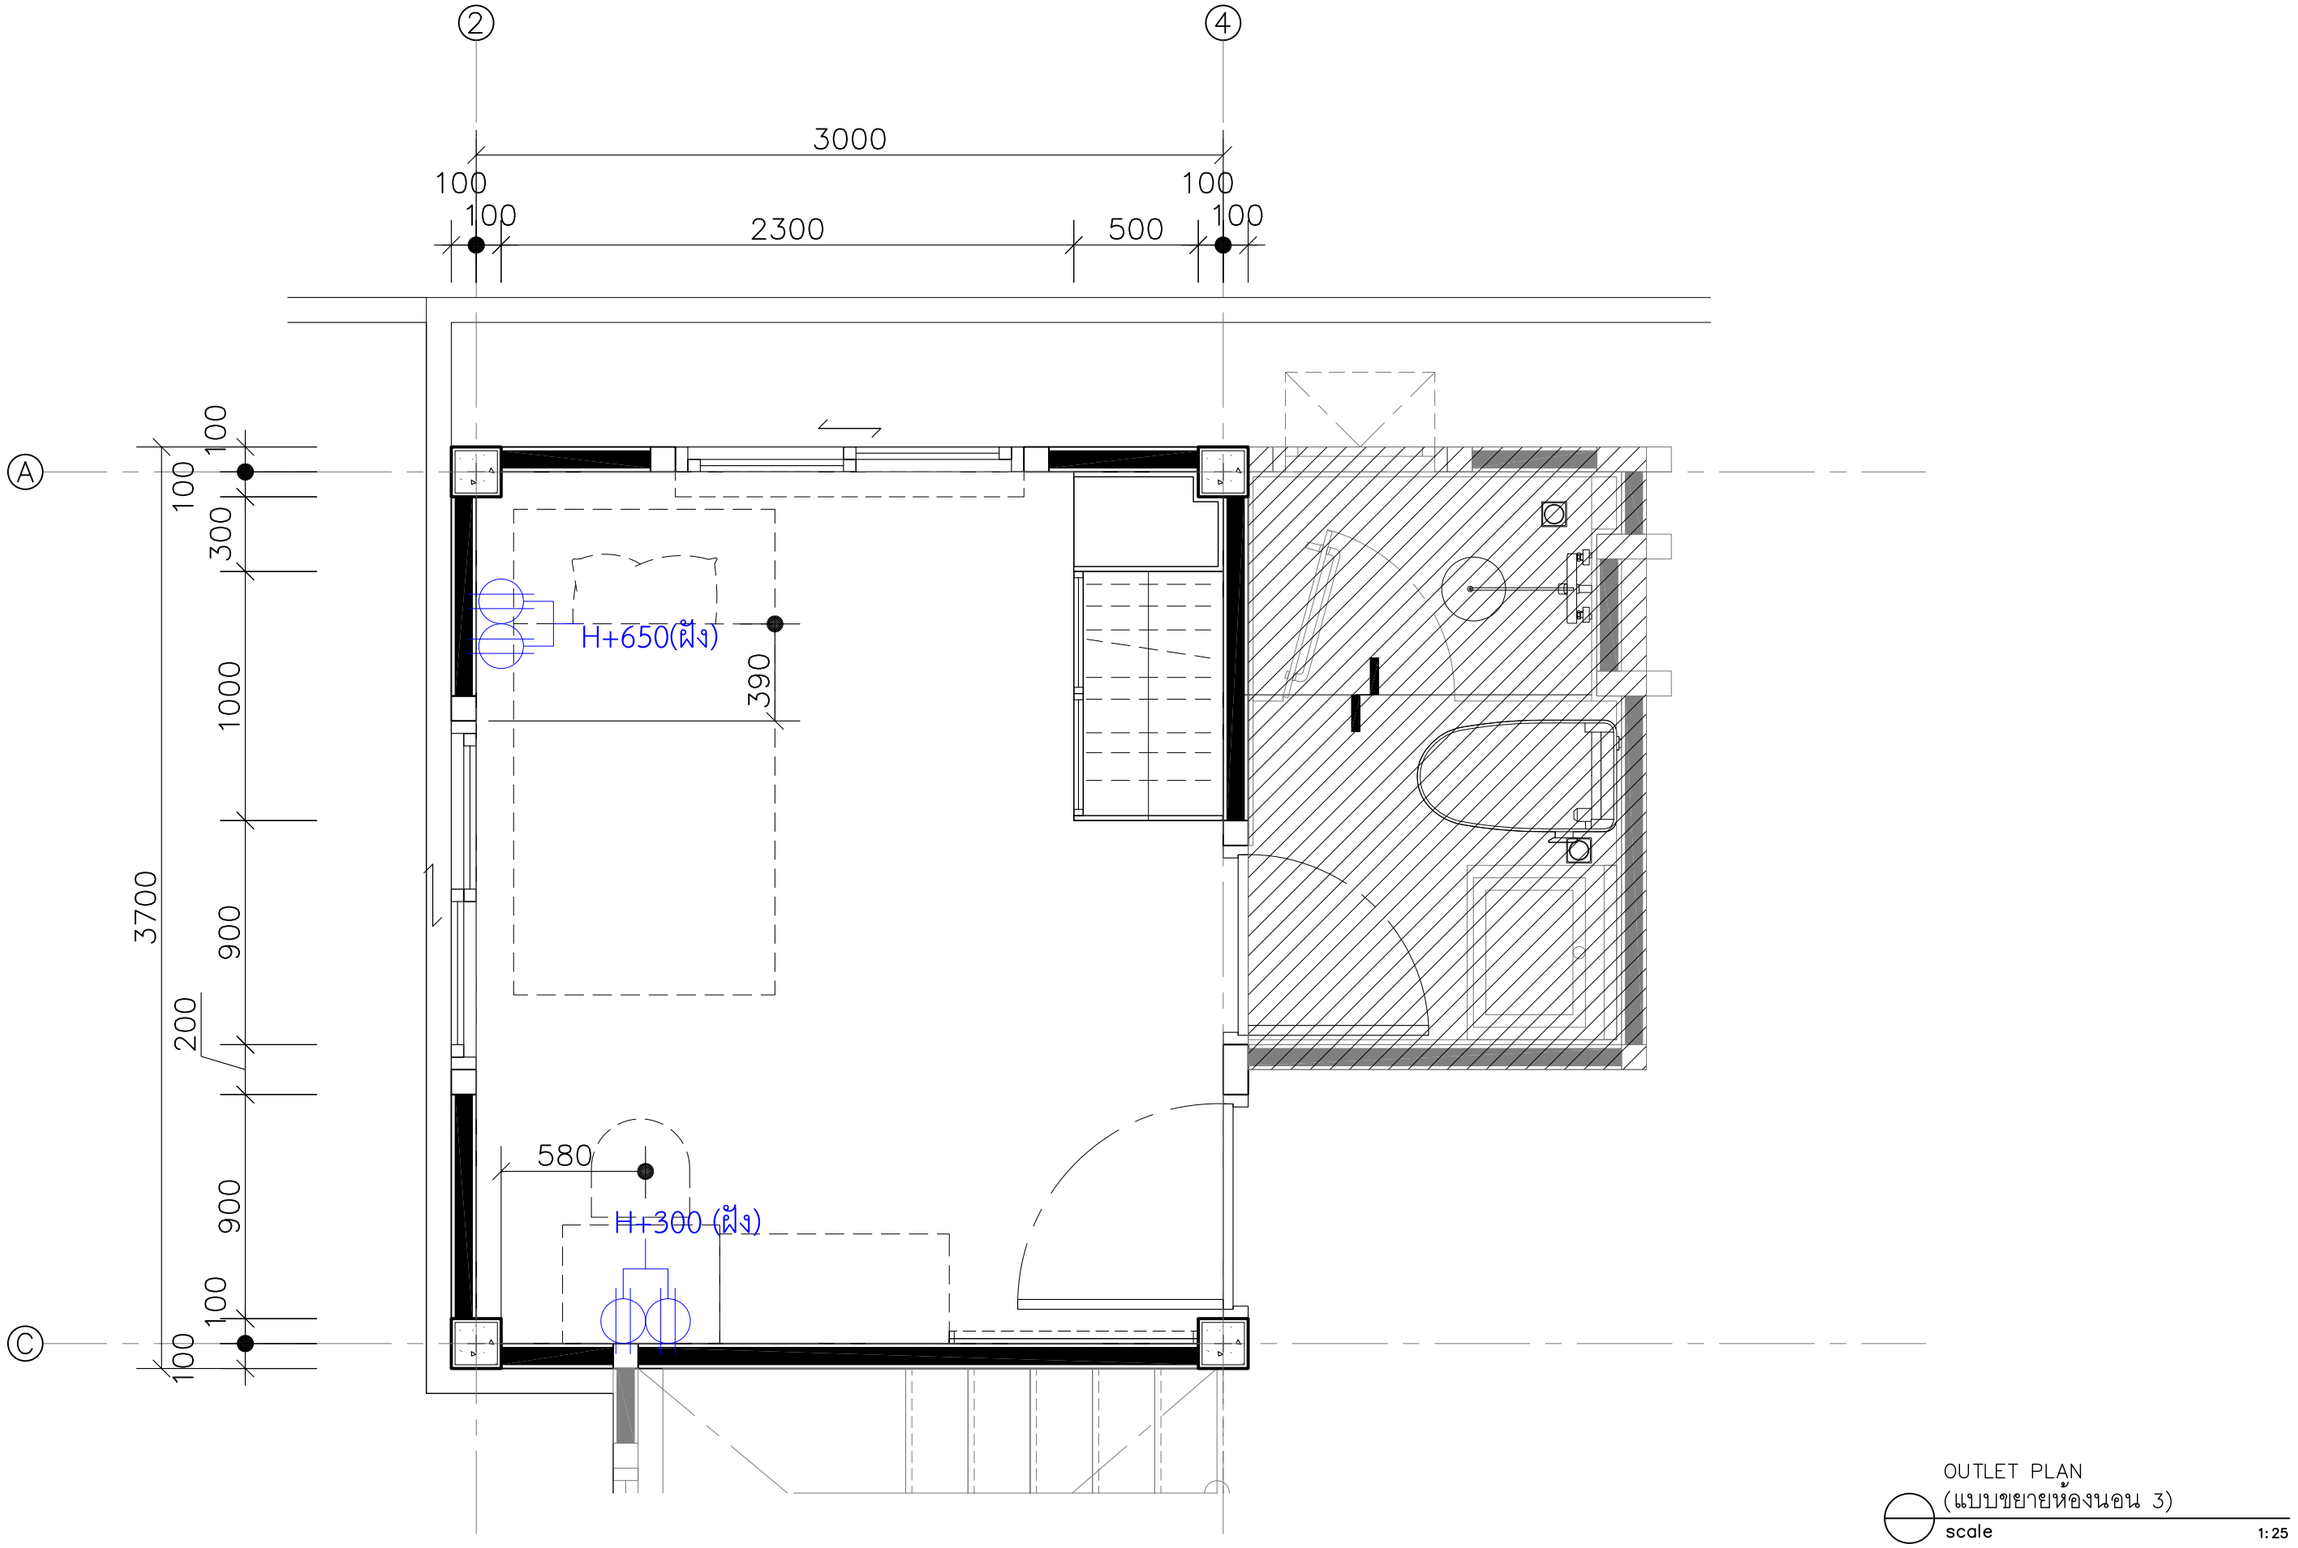

OUTLET PLAN
(แบบขยายห้องนอน 3)
scale 1:25

SPACEMAN

PROJECT | SONIA HOUSE

LOCATION | REIGNWOOD PARK
LAMLUKKA, PATHUM THANI

ARCHITECT |

INTERIOR DESIGNER | ปรัตถกร ประมุขกุล ภ-สน 1438

STRUCTURAL ENGINEER |

TITLE | 2nd FLOOR
OUTLET PLAN
(แบบขยายห้องนอน 3)

2026-06-18
ID1-03
1:25 @ A3

Note: SPACEMAN takes no responsibility for dimensions obtained by scaling from this drawing. If no dimension is shown the recipient must ascertain the dimension specifically from the architect or by site measurement and may not rely on the drawing. Supply of the drawing in digital form is solely for convenience and no reliance may be placed on any data in digital form. All data must be checked against hard copy. This drawing is issued for design intent only and should not be used for construction unless stated. This drawing is the property of SPACEMAN

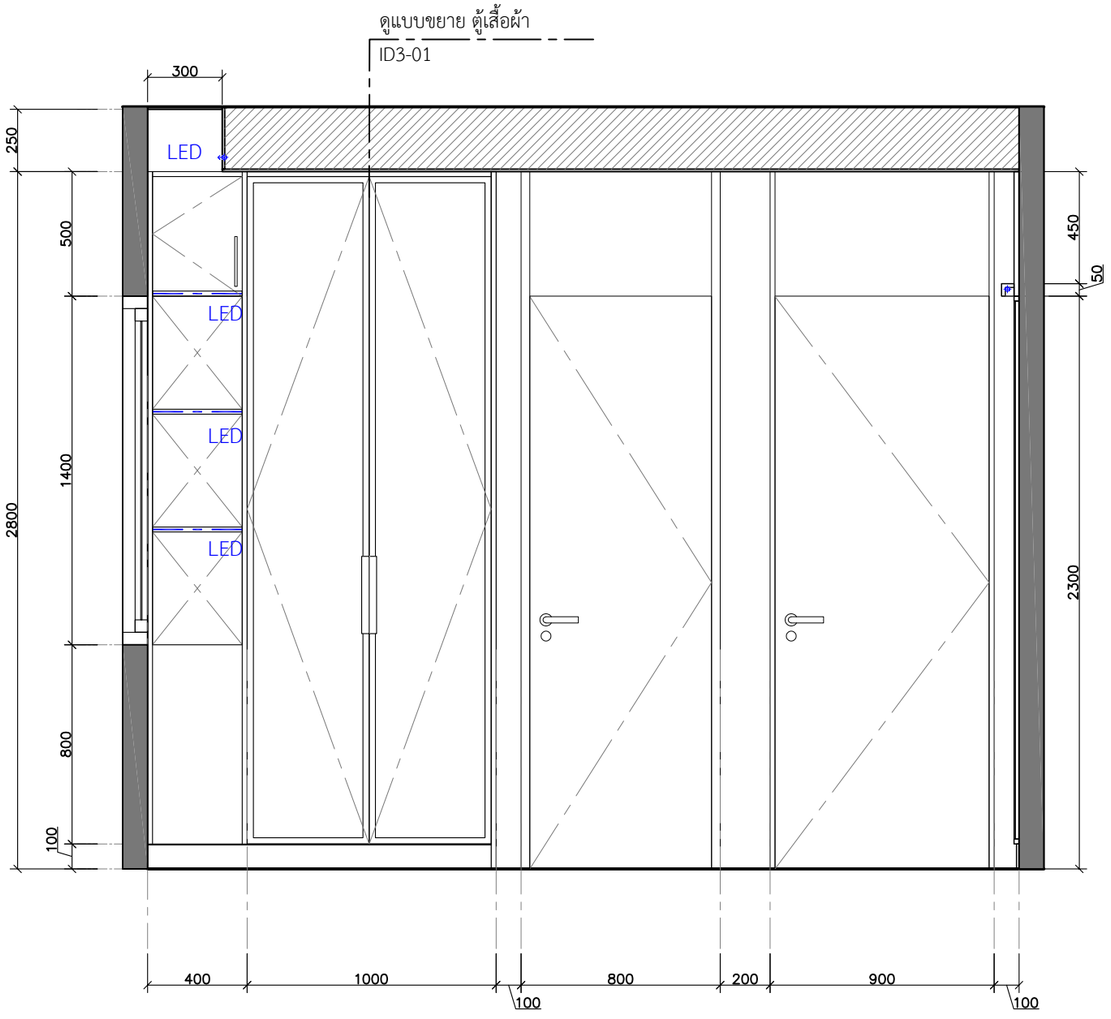

บริเวณ ห้องนอน 3
ELEVATION 1
scale 1:25

SPACEMAN

PROJECT | SONIA HOUSE

LOCATION | REIGNWOOD PARK
LAMLUKKA, PATHUM THANI

ARCHITECT |

INTERIOR DESIGNER | ปรัตถกร ประมุขกุล ภ-ศน 1438

STRUCTURAL ENGINEER |

TITLE | 2nd FLOOR
ELEVATION
(แบบขยายบริเวณห้องนอน 3)

2026-06-18
ID2-01
1:25 @ A3

Note: SPACEMAN takes no responsibility for dimensions obtained by scaling from this drawing. If no dimension is shown the recipient must ascertain the dimension specifically from the architect or by site measurement and may not rely on the drawing. Supply of the drawing in digital form is solely for convenience and no reliance may be placed on any data in digital form. All data must be checked against hard copy. This drawing is issued for design intent only and should not be used for construction unless stated. This drawing is the property of SPACEMAN

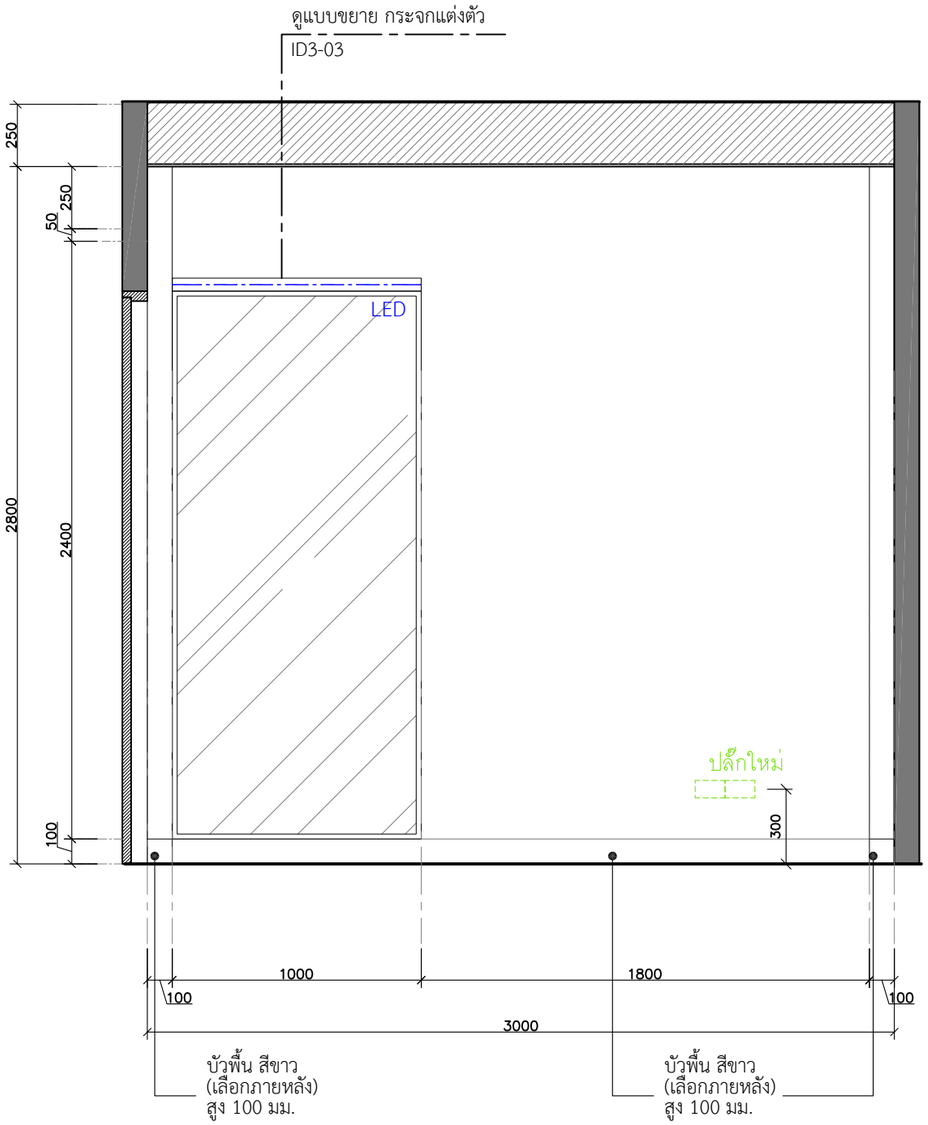

บริเวณ ห้องนอน 3
ELEVATION 2

scale 1:25

SPACEMAN

PROJECT: SONIA HOUSE

LOCATION: REIGNWOOD PARK
LAMLUKKA, PATHUM THANI

ARCHITECT:

INTERIOR DESIGNER: ปรัตถกร ประมุขกุล ภ-สน 1438

STRUCTURAL ENGINEER:

TITLE: 2nd FLOOR
ELEVATION
(แบบขยายบริเวณห้องนอน 3)

2026-06-18
ID2-02
1:25 @ A3

Note: SPACEMAN takes no responsibility for dimensions obtained by scaling from this drawing. If no dimension is shown the recipient must ascertain the dimension specifically from the architect or by site measurement and may not rely on the drawing. Supply of the drawing in digital form is solely for convenience and no reliance may be placed on any data in digital form. All data must be checked against hard copy. This drawing is issued for design intent only and should not be used for construction unless stated. This drawing is the property of SPACEMAN

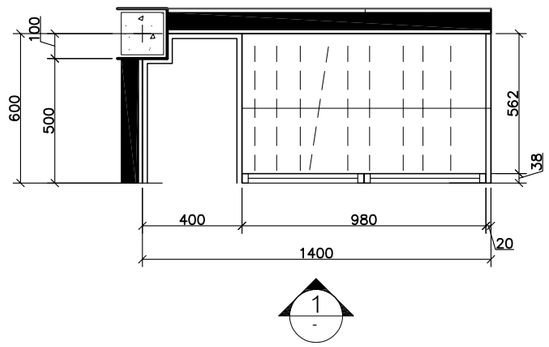

แบบขยาย ตู้เสื้อผ้า
บริเวณ ห้องนอน 3
PLAN

scale 1:25

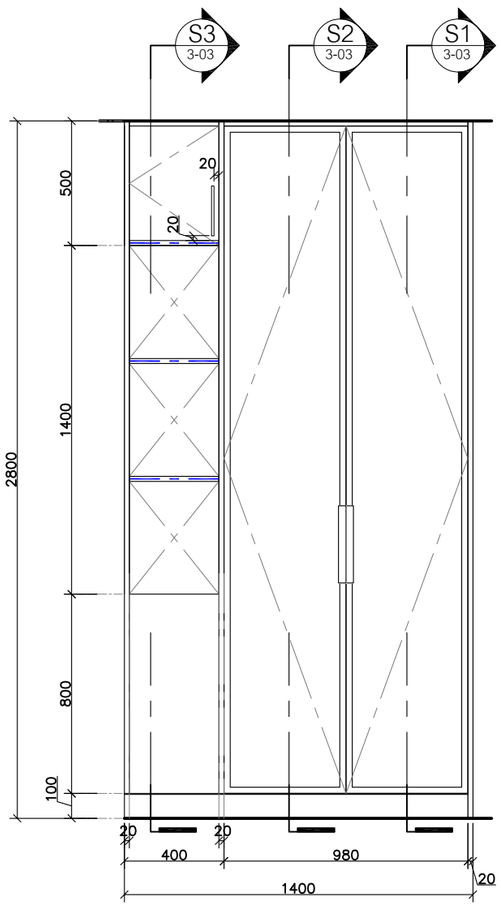

แบบขยาย ตู้เสื้อผ้า
บริเวณ ห้องนอน 3
ELEVATION 1

scale 1:25

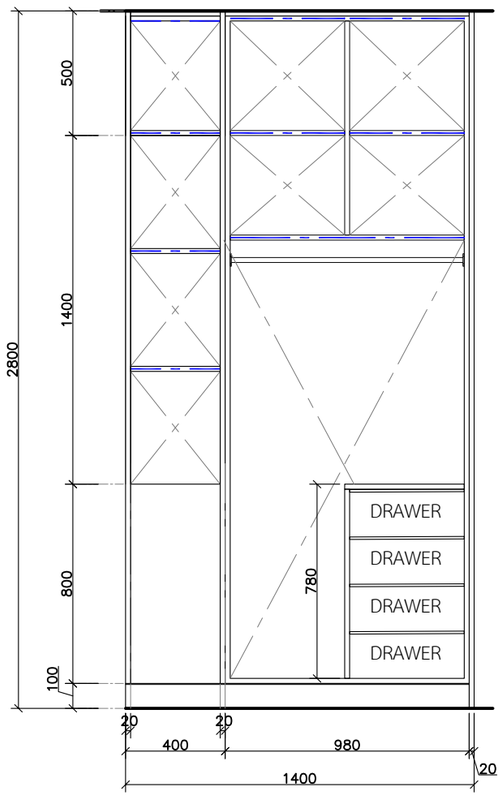

แบบขยาย ตู้เสื้อผ้า (ภายใน)
บริเวณ ห้องนอน 3
ELEVATION 1

scale 1:25

SPACEMAN

PROJECT | SONIA HOUSE

LOCATION | REIGNWOOD PARK
LAMLUKKA, PATHUM THANI

ARCHITECT

INTERIOR DESIGNER | ปรัตถกร ประมุขกุล ภ-สน 1438

STRUCTURAL ENGINEER

TITLE | 2nd FLOOR
PLAN ,ELEVATION
แบบขยายตู้เสื้อผ้า

2026-06-18
ID3-01

Note: SPACEMAN takes no responsibility for dimensions obtained by scaling from this drawing. If no dimension is shown the recipient must ascertain the dimension specifically from the architect or by site measurement and may not rely on the drawing. Supply of the drawing in digital form is solely for convenience and no reliance may be placed on any data in digital form. All data must be checked against hard copy. This drawing is issued for design intent only and should not be used for construction unless stated. This drawing is the property of SPACEMAN

1:25 @ A3

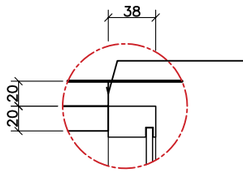

DETAIL 1

scale 1:5

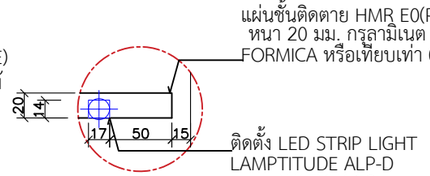

DETAIL 2

scale 1:5

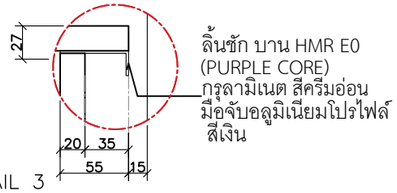

DETAIL 3

scale 1:5

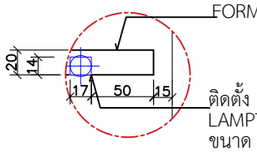

DETAIL 4

scale 1:5

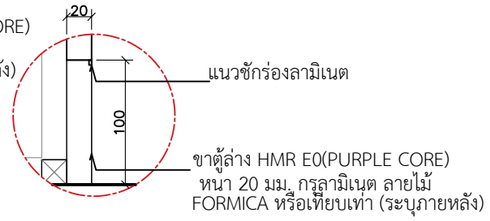

DETAIL 5

scale 1:5

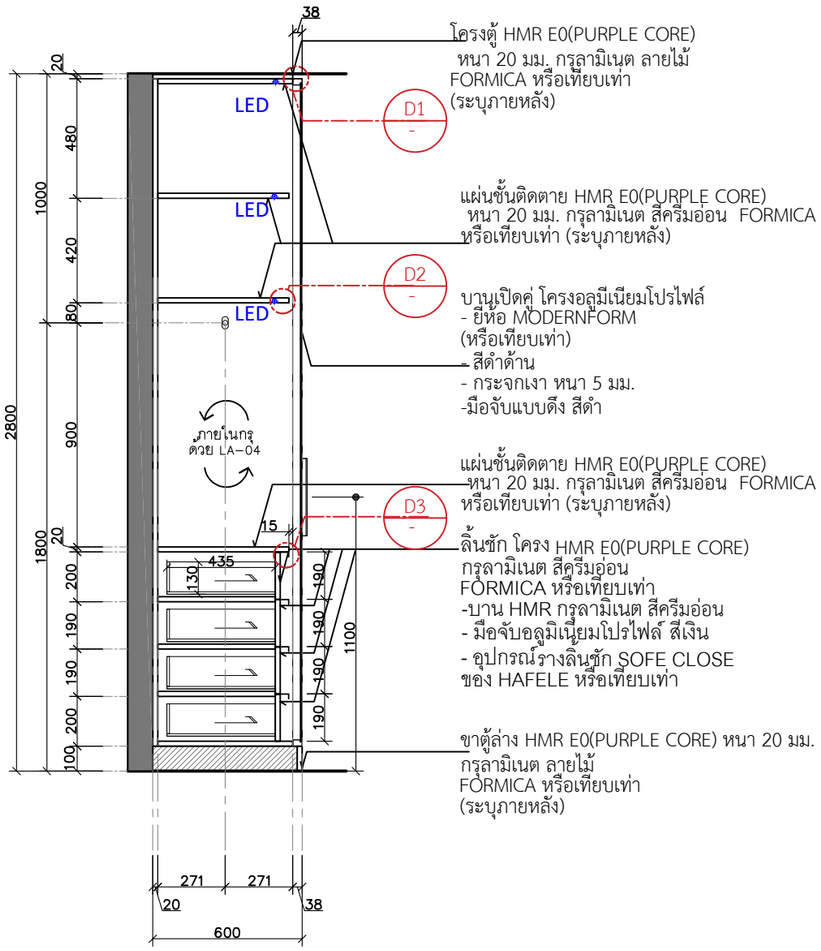

แบบขยาย ตู้เสื้อผ้า
บริเวณ ห้องนอน 3
SECTION 1

scale 1:25

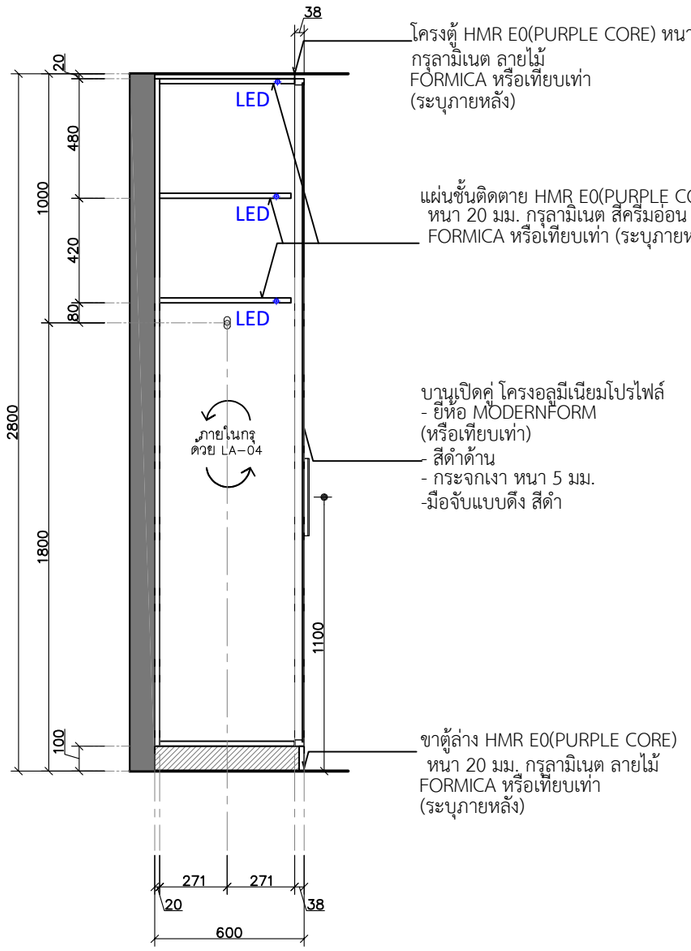

แบบขยาย ตู้เสื้อผ้า
บริเวณ ห้องนอน 3
SECTION 2

scale 1:25

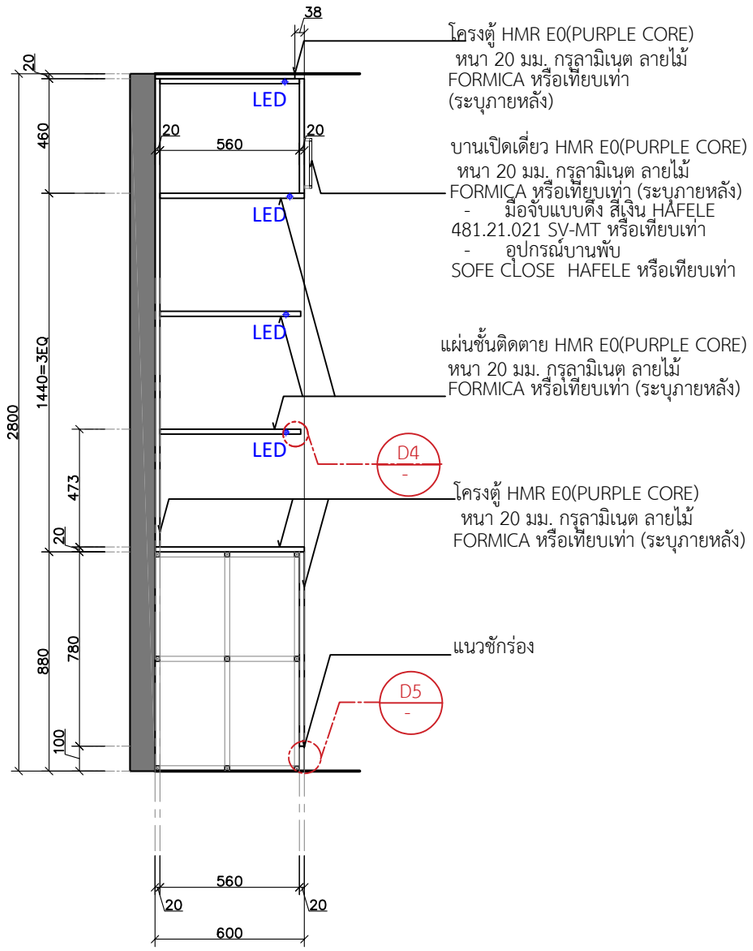

แบบขยาย ตู้เสื้อผ้า
บริเวณ ห้องนอน 3
SECTION 3

scale 1:25

SPACEMAN

PROJECT SONIA HOUSE

LOCATION REIGNWOOD PARK
LAMLUKKA, PATHUM THANI

ARCHITECT

INTERIOR DESIGNER ปรัตถกร ประมุขกุล ภ-สน 1438

STRUCTURAL ENGINEER

TITLE 2nd FLOOR
SECTION
แบบขยาย ตู้เสื้อผ้า

2026-06-18
ID3-02

1:25 @ A3

Note: SPACEMAN takes no responsibility for dimensions obtained by scaling from this drawing. If no dimension is shown the recipient must ascertain the dimension specifically from the architect or by site measurement and may not rely on the drawing. Supply of the drawing in digital form is solely for convenience and no reliance may be placed on any data in digital form. All data must be checked against hard copy. This drawing is issued for design intent only and should not be used for construction unless stated. This drawing is the property of SPACEMAN

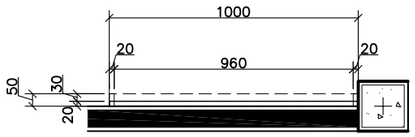

ภายใน
ห้องนอน 3

แบบขยาย กระจกเงา
บริเวณ ห้องนอน 3
PLAN

scale 1:25

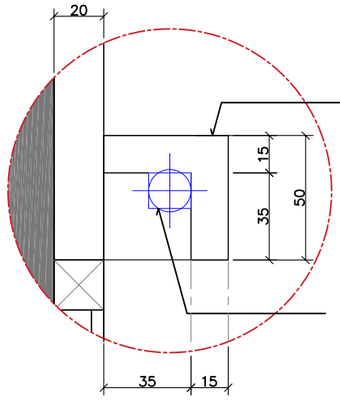

แผ่น HMR E0(PURPLE CORE)กรุลามิเนต ลายไม้ FORMICA หรือเทียบเท่า
(ระบุภายหลัง) ติดตั้งไฟเส้น STRIPLIGHT

ติดตั้ง LED STRIP LIGHT
LAMPTITUDE ALP-D
ขนาด W17XH14.3 มม .

DETAIL 1

scale 1:2.5

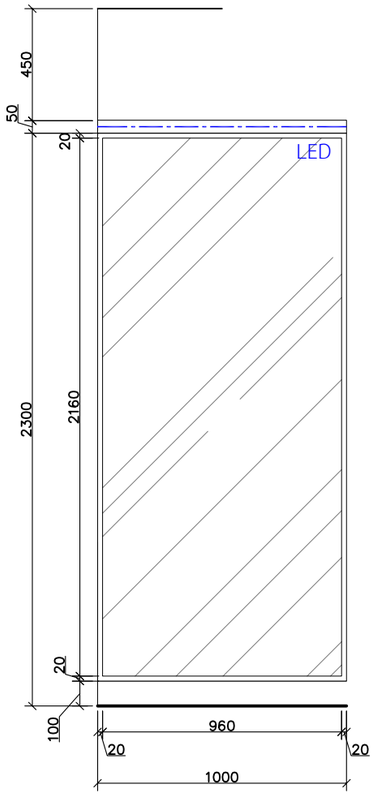

แบบขยาย กระจกเงา
บริเวณ ห้องนอน 3
ELEVATION 1

scale 1:25

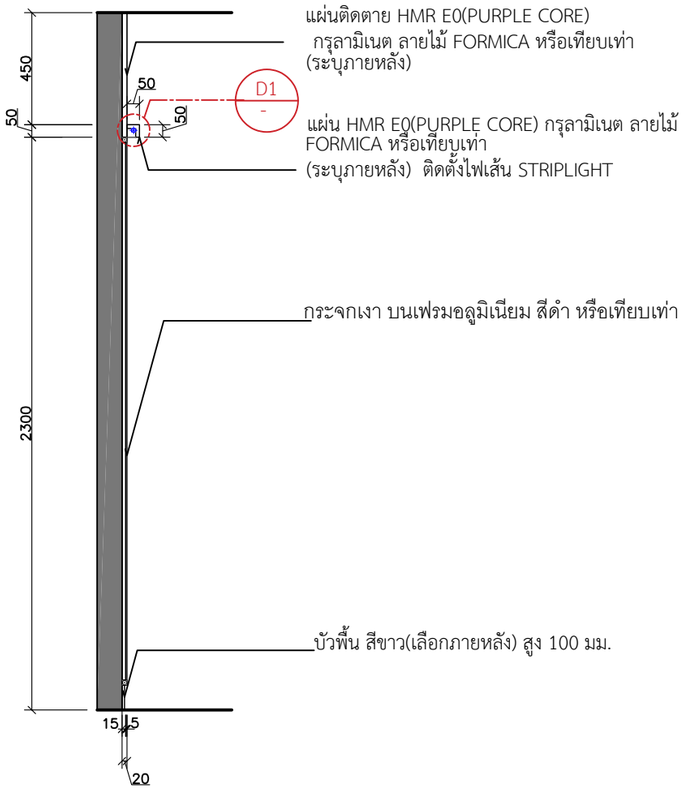

แผ่นติดตาย HMR E0(PURPLE CORE)
กรุลามิเนต ลายไม้ FORMICA หรือเทียบเท่า
(ระบุภายหลัง)

แผ่น HMR E0(PURPLE CORE) กรุลามิเนต ลายไม้ FORMICA หรือเทียบเท่า
(ระบุภายหลัง) ติดตั้งไฟเส้น STRIPLIGHT

กระจกเงา บนเฟรมอลูมิเนียม สีดำ หรือเทียบเท่า

บัวพื้น สีขาว(เลือกภายหลัง) สูง 100 มม.

แบบขยาย กระจกเงา
บริเวณ ห้องนอน 3
SECTION 1

scale 1:25

SPACEMAN

PROJECT: SONIA HOUSE

LOCATION: REIGNWOOD PARK
LAMLUKKA, PATHUM THANI

ARCHITECT:

INTERIOR DESIGNER: ปรัตถกร ประมุขกุล ภ-สน 1438

STRUCTURAL ENGINEER:

TITLE: 2nd FLOOR
SECTION
แบบขยาย กระจกเงา

2026-06-18
ID3-03

1:25 @ A3

Note: SPACEMAN takes no responsibility for dimensions obtained by scaling from this drawing. If no dimension is shown the recipient must ascertain the dimension specifically from the architect or by site measurement and may not rely on the drawing. Supply of the drawing in digital form is solely for convenience and no reliance may be placed on any data in digital form. All data must be checked against hard copy. This drawing is issued for design intent only and should not be used for construction unless stated. This drawing is the property of SPACEMAN